FED. ROAD DIST. NO.	STATE	PROJ. NO.	FISCAL YEAR	SHEET NO.	TOTAL SHEETS
HAWAII	HAW.	440A-01-80M	1980	1	6

INDEX TO DRAWINGS

SHEET NO.	DESCRIPTION
1	TITLE SHEET
2	TYPICAL SECTIONS, GEN. NOTES & RECONSTRUCTION SCHEDULE
3-4	PLANS
5-6	STANDARD DETAILS

STATE OF HAWAII

DEPARTMENT OF TRANSPORTATION
HIGHWAYS DIVISION
"AS BUILT"
PLANS FOR

KAUMALAPAU HIGHWAY IMPROVEMENTS

PROJECT NO. 440A-01-80M

DISTRICT OF LANAI
ISLAND OF LANAI

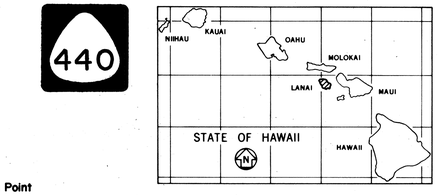

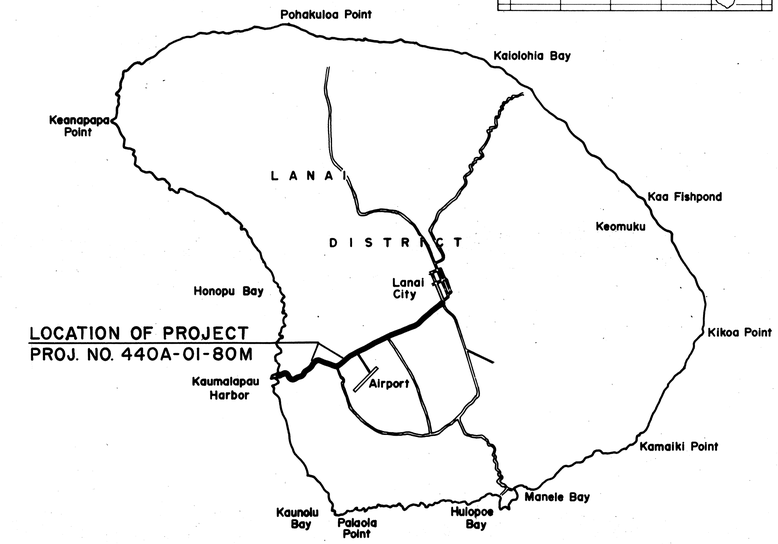

N

2 0 2 4
SCALE IN MILES

FEDERAL AID PROJECTS PREVIOUSLY CONSTRUCTED OR UNDER CONSTRUCTION

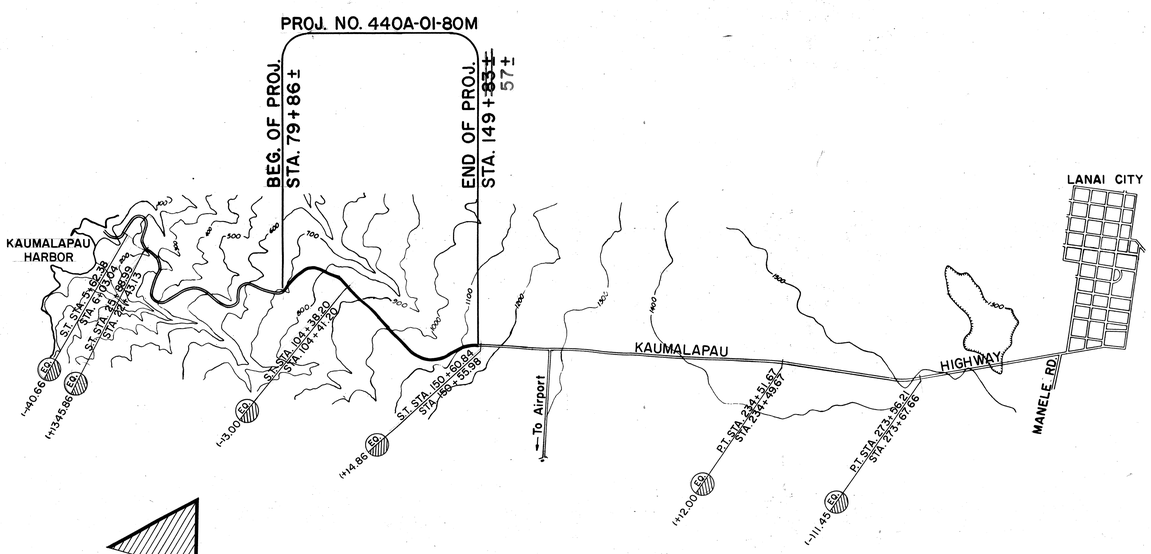

LAYOUT PLAN

GROSS LENGTH OF PROJECT 1.32~~8~~0 MILES
NET LENGTH OF PROJECT 1.32~~8~~0 MILES

2 0 2 4
SCALE IN THOUSAND FEET

ALL CHANGES MADE DURING CONSTRUCTION HAVE BEEN NOTED IN RED ON THESE TRACINGS AND CHECKED BY

Raymond Saito — RESIDENT ENGINEER
2-6-81 — DATE

DEPARTMENT OF TRANSPORTATION
STATE OF HAWAII
APPROVED:
Ryokichi Higashionna — DIR. OF TRANSPORTATION
May 8, 1980 — DATE

R. Tsuzuki — DESIGNED BY
R. Tsuzuki — P. S. & E. BY
548-2456 — PHONE
May, 1980 — DATE