FED. ROAD DIST. NO.	STATE	FED. AID PROJ. NO.	FISCAL YEAR	SHEET NO.	TOTAL SHEETS
HAWAII	HAW.	RS-0440(2)	1986	1	9

INDEX TO DRAWINGS

SHEET NO.	DESCRIPTION
1	TITLE SHEET
2	TYPICAL SECTIONS, ESTIMATED QUANTITIES & GENERAL NOTES
3-9	STANDARD DETAILS

440

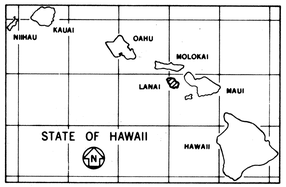

STATE OF HAWAII
DEPARTMENT OF TRANSPORTATION
HIGHWAYS DIVISION

"AS-BUILT"

PLANS FOR

KAUMALAPAU HIGHWAY RESURFACING

Kaumalapau Harbor towards Lanai City

FEDERAL AID PROJECT NO. RS-0440(2)

DISTRICT OF LANAI
ISLAND OF LANAI

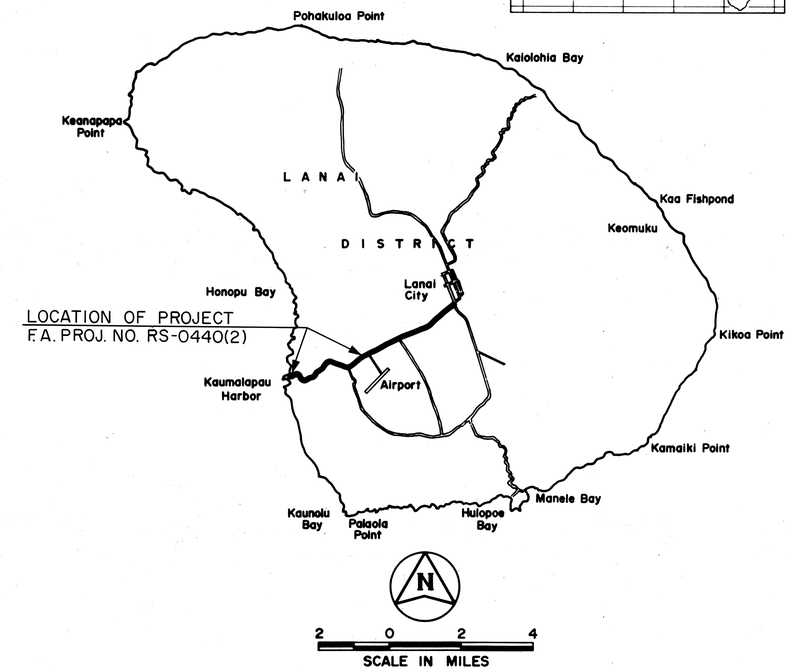

FEDERAL AID PROJECTS PREVIOUSLY CONSTRUCTED OR UNDER CONSTRUCTION

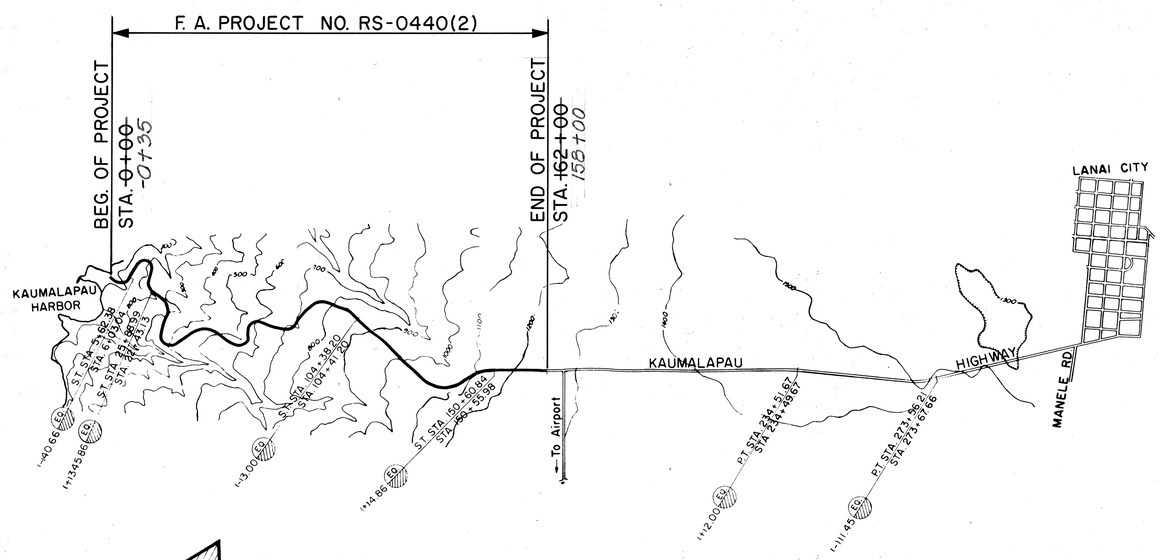

LAYOUT OF PROJECT

2 0 2 4 6 8
SCALE IN THOUSAND FEET

LENGTH OF PROJECT . . . . . 3.07 MILES

DESIGN DESIGNATION

CURRENT ADT (1985)	550
DESIGN ADT (1995)	700
DHV	100
D	55/45
T	23.5%
V	45 MPH

CHANGES MADE DURING CONSTRUCTION HAVE BEEN NOTED ON THESE PLANS AND CHECKED BY:

Michael Dunega — RESIDENT ENGINEER — 9/14/88 DATE

UNIT "C"	R. SIAROT	548-7537	SEPT. 1985
DESIGNED BY	P. S. & E. BY	PHONE	DATE

DEPARTMENT OF TRANSPORTATION
STATE OF HAWAII

APPROVED:

Cheryl D. Soon — DIR. OF TRANSPORTATION — 10/17/85 DATE