FED. ROAD DIST. NO.	STATE	PROJ. NO.	FISCAL YEAR	SHEET NO.	TOTAL SHEETS
HAWAII	HAW.	440A-01-88M 440B-01-88M	1988	1	5

INDEX TO DRAWINGS

SHEET NO.	DESCRIPTION
1	TITLE SHEET
2	STANDARD PLANS SUMMARY
3	TYPICAL SECTION, GENERAL
	NOTES, PAVEMENT MARKING &
	SIGN SUMMARY (LANAI AIRPORT
	ROAD)
4	TYPICAL SECTION, GENERAL
	NOTES, PAVEMENT MARKING &
	SIGN SUMMARY (MANELE ROAD)
5	TRAFFIC LEGEND, NOTES &
	DETAILS

STATE OF HAWAII

DEPARTMENT OF TRANSPORTATION
HIGHWAYS DIVISION

"AS-BUILT"
PLANS FOR

LANAI AIRPORT ROAD RESURFACING
KAUMALAPAU HIGHWAY TO AIRPORT
PROJECT NO. 440A-01-88M

AND

MANELE ROAD RESURFACING
KAUMALAPAU HIGHWAY TOWARD MANELE BAY
PROJECT NO. 440B-01-88M

DISTRICT OF LANAI
ISLAND OF LANAI

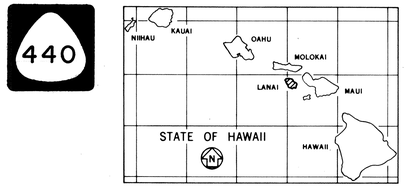

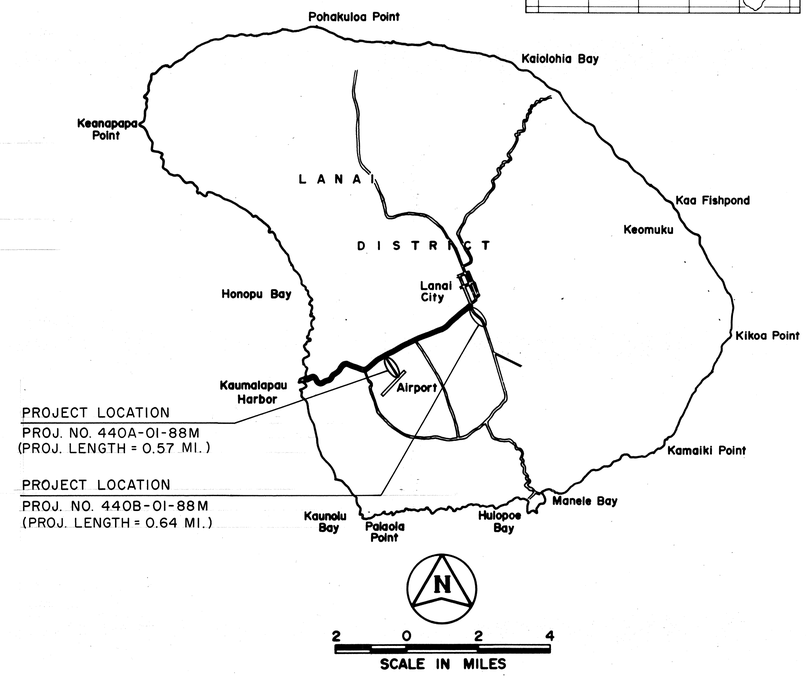

FEDERAL AID PROJECTS PREVIOUSLY CONSTRUCTED OR UNDER CONSTRUCTION

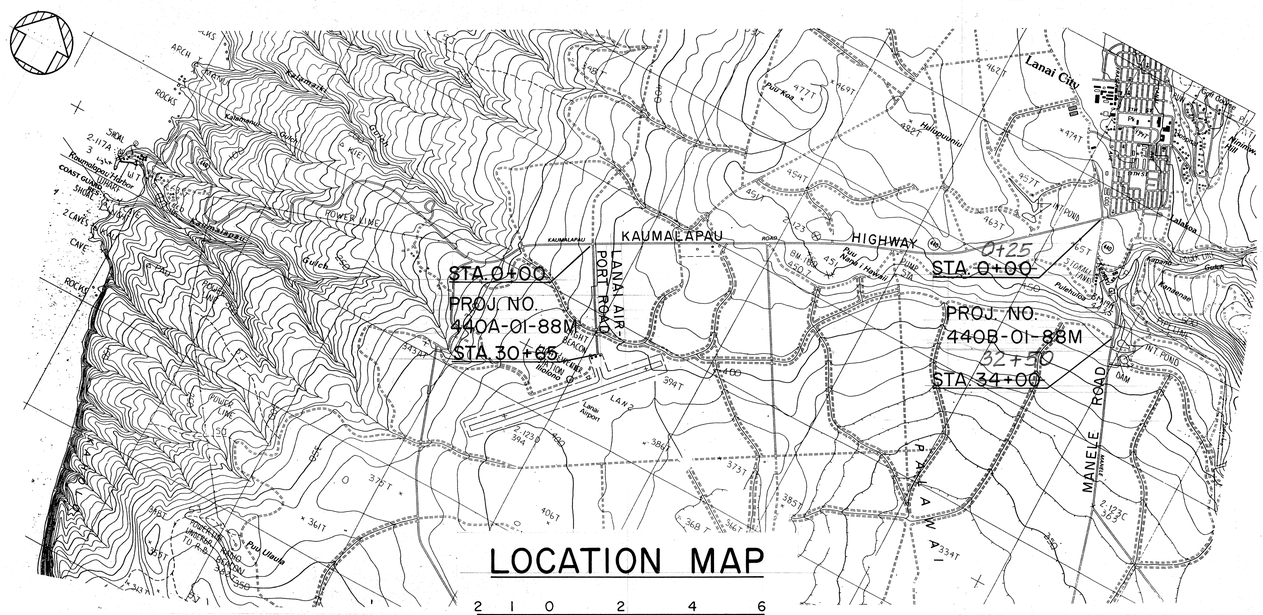

LOCATION MAP

CHANGES MADE DURING CONSTRUCTION HAVE BEEN NOTED ON THESE PLANS AND CHECKED BY:

RESIDENT ENGINEER — DATE 9/9/88

DEPARTMENT OF TRANSPORTATION
STATE OF HAWAII
APPROVED:
DIR. OF TRANSPORTATION — DATE 5/8/87

MAUI DISTRICT — DESIGNED BY
A. TAKESHITA — P. S. & E. BY
548-7537 — PHONE
JULY, 1987 — DATE