FED. ROAD DIST. NO.	STATE	PROJ. NO.	FISCAL YEAR	SHEET NO.	TOTAL SHEETS
HAWAII	HAW.	440A-01-90M	1990	1	5

INDEX TO DRAWINGS

SHEET NO.	DESCRIPTION
1	TITLE SHEET
2	STANDARD PLAN SUMMARY
3	TYPICAL SECTION & GEN. NOTES
4-5	PLAN SHEET

STATE OF HAWAII

DEPARTMENT OF TRANSPORTATION

HIGHWAYS DIVISION

HONOLULU, HAWAII

"AS BUILT"

PLANS FOR

KAUMALAPAU HIGHWAY SHOULDER PAVING

KAUMALAPAU HARBOR TOWARDS LANAI CITY

PROJECT NO. 440A-01-90M

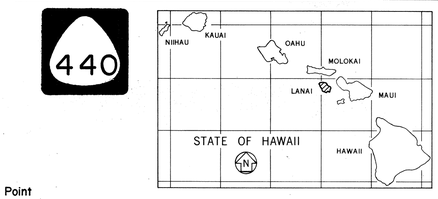

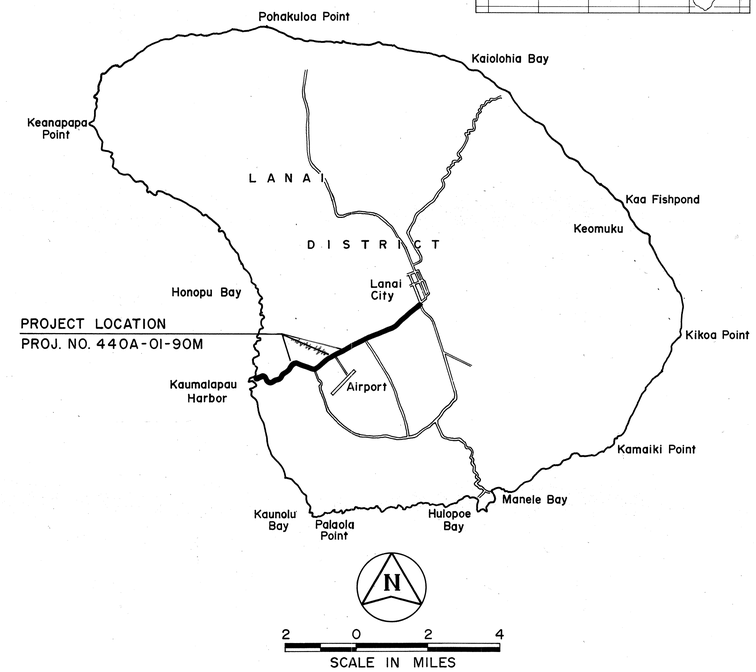

DISTRICT OF LANAI
ISLAND OF LANAI

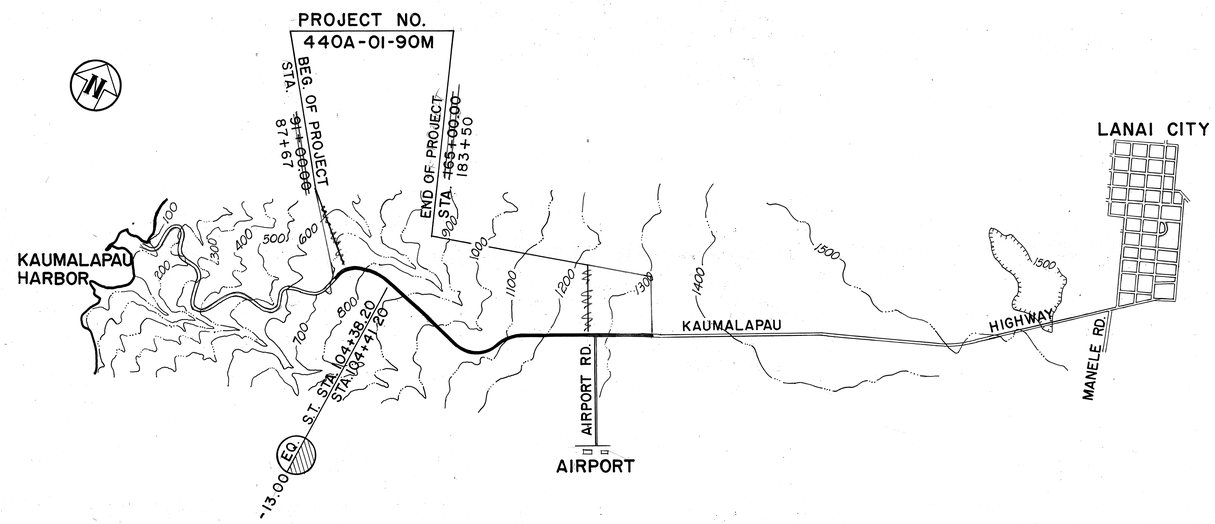

LAYOUT OF PROJECT

2 0 2 4 6 8

SCALE IN THOUSAND FEET

LENGTH OF PROJECT NO. 440A-01-90M ~~1.40~~ MILES
1.81

FEDERAL AID PROJECTS PREVIOUSLY CONSTRUCTED OR UNDER CONSTRUCTION

PROJECT NO. 440A-01-90M
MILE POST ~~1.78~~ 1.72 TO MILE POST ~~3.18~~ 3.53

CHANGES MADE DURING CONSTRUCTION HAVE BEEN INCORPORATED ON THESE PLANS EXCEPT CHANGES IN THE ORIGINAL THEORETICAL QUANTITIES. FOR ACTUAL QUANTITIES, REFER TO PROJECT LEDGER AND/OR COMPUTATION BOOK.

Piniaris — 1/17/92
RESIDENT ENGINEER — DATE

DEPARTMENT OF TRANSPORTATION
STATE OF HAWAII
APPROVED:
Chiyoji Fujimoto — 5/22/90
DIR. OF TRANSPORTATION — DATE

HWY-M	R. TAKAESU	548-4125	MAY, 1990
DESIGNED BY	P. S. & E. BY	PHONE	DATE

DD-A-2-9

1