FED. ROAD DIST. NO.	STATE	PROJ. NO.	FISCAL YEAR	SHEET NO.	TOTAL SHEETS
HAWAII	HAW.	440A-01-96M	1996	1	10

INDEX TO DRAWINGS	
SHEET NO.	DESCRIPTION
1	TITLE SHEET
2	STANDARD PLANS SUMMARY
3	GENERAL NOTES AND LEGEND
4	TYPICAL SECTIONS
5	PAVEMENT MARKINGS LEGEND, DETAILS AND NOTES
6 – 9	ROADWAY AND SIGNING PLANS
10	MISCELLANEOUS SUMMARIES

STATE OF HAWAII

DEPARTMENT OF TRANSPORTATION

HIGHWAYS DIVISION

HONOLULU, HAWAII

"AS-BUILT"

PLANS FOR

KAUMALAPAU HIGHWAY SHOULDER PAVING

VICINITY OF AIRPORT TOWARDS LANAI CITY

PROJECT NO. 440A-01-96M

DISTRICT OF LANAI

ISLAND OF LANAI

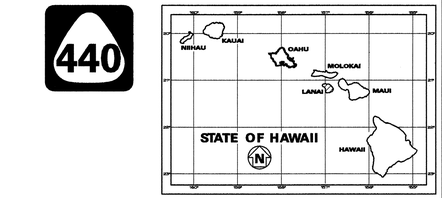

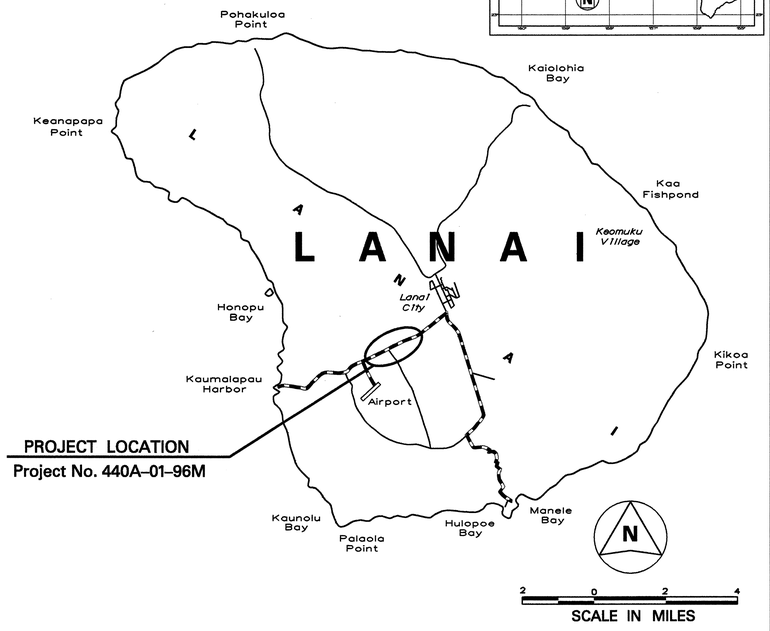

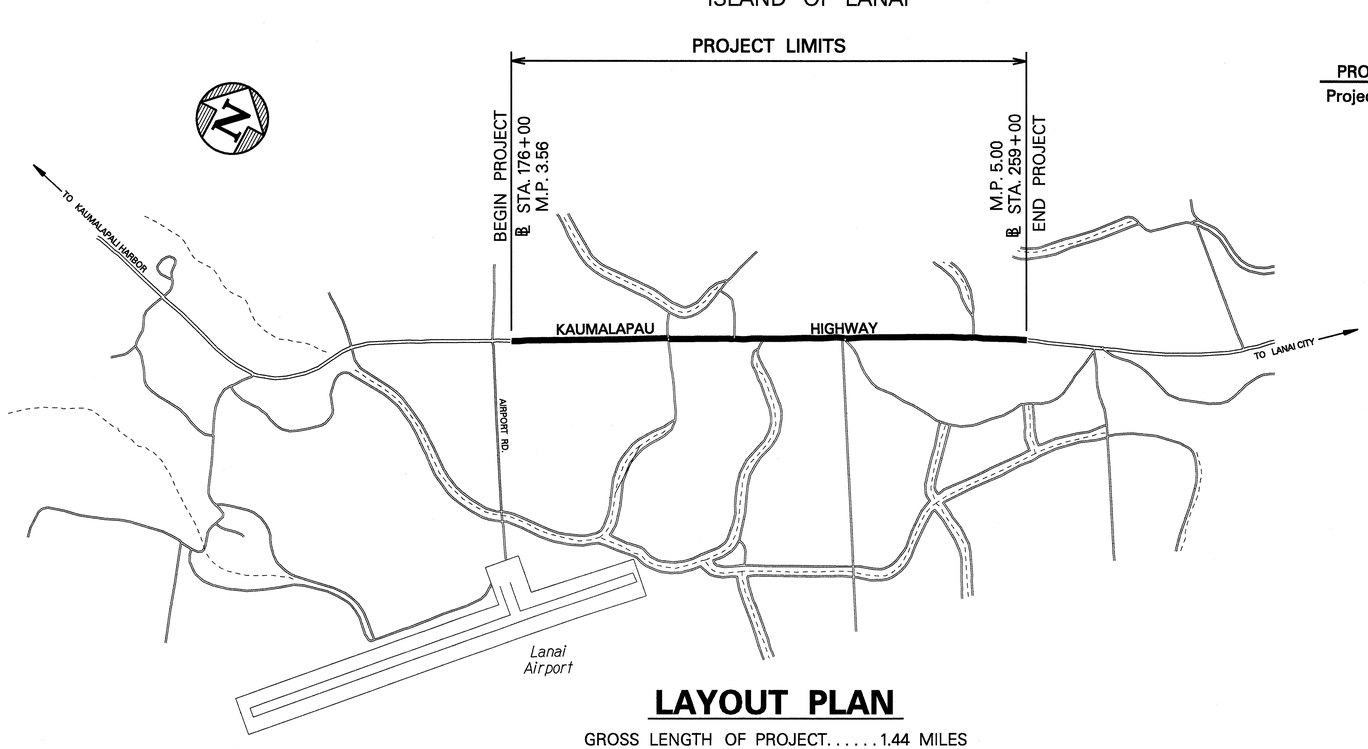

LAYOUT PLAN

GROSS LENGTH OF PROJECT.....1.44 MILES

NET LENGTH OF PROJECT.....1.44 MILES

1 0 1 2 3

SCALE IN THOUSAND FEET

FEDERAL AID PROJECTS PREVIOUSLY CONSTRUCTED OR UNDER CONSTRUCTION

MILE POST 3.56 TO MILE POST 5.00

CHANGES MADE DURING CONSTRUCTION HAVE BEEN INCORPORATED ON THESE PLANS EXCEPT CHANGES IN THE ORIGINAL THEORETICAL QUANTITIES. FOR ACTUAL QUANTITIES, REFER TO PROJECT LEDGER AND/OR COMPUTATION BOOK.

Glenn C. Ryland 11-16-98

RESIDENT ENGINEER DATE

DEPARTMENT OF TRANSPORTATION STATE OF HAWAII	
APPROVED: Kazu Hayashida	5/7/96
DIR. OF TRANSPORTATION	DATE

HWY-M DESIGNED BY

R. HIRONAKA P. S. & E. BY

587-2250 PHONE

APRIL, 1996 DATE

2kmpmtstd.dgn log/n: george subdir:_2kmp