INDEX TO DRAWINGS	
SHEET NO.	DESCRIPTION
1	TITLE SHEET
2	STANDARD PLANS SUMMARY
3	GENERAL NOTES, LEGEND AND TYPICAL SECTIONS
4 – 6	ROADWAY PLAN
7	PAVEMENT MARKING LEGEND, DETAILS AND NOTES
8 – 10	PAVEMENT MARKING AND SIGNING PLAN
11	MISCELLANEOUS SUMMARIES

FED. ROAD DIST. NO.	STATE	PROJ. NO.	FISCAL YEAR	SHEET NO.	TOTAL SHEETS
HAWAII	HAW.	440A-01-01M	2001	1	11

STATE OF HAWAII

DEPARTMENT OF TRANSPORTATION

HIGHWAYS DIVISION

HONOLULU, HAWAII

"AS-BUILT"

PLANS FOR

KAUMALAPAU HIGHWAY RESURFACING

VICINITY OF AIRPORT TOWARDS LANAI CITY

PROJECT NO. 440A-01-01M

DISTRICT OF LANAI

ISLAND OF LANAI

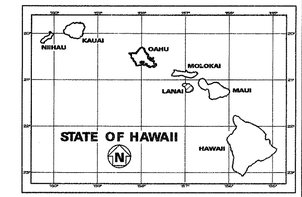

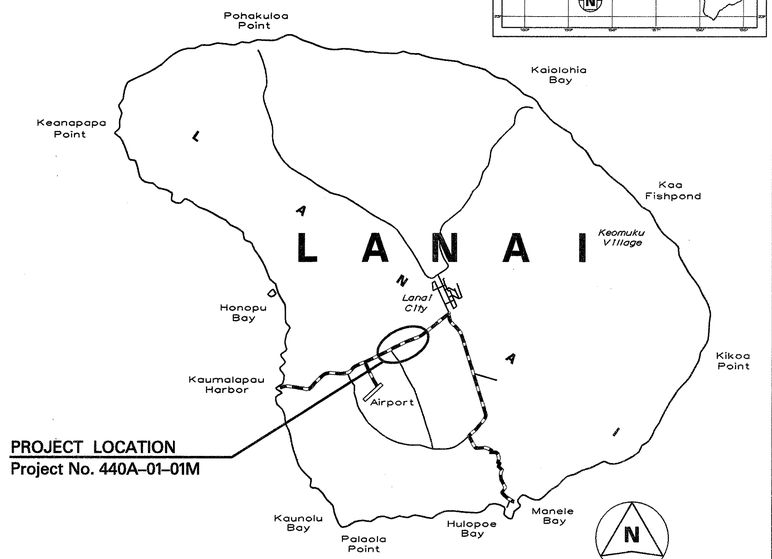

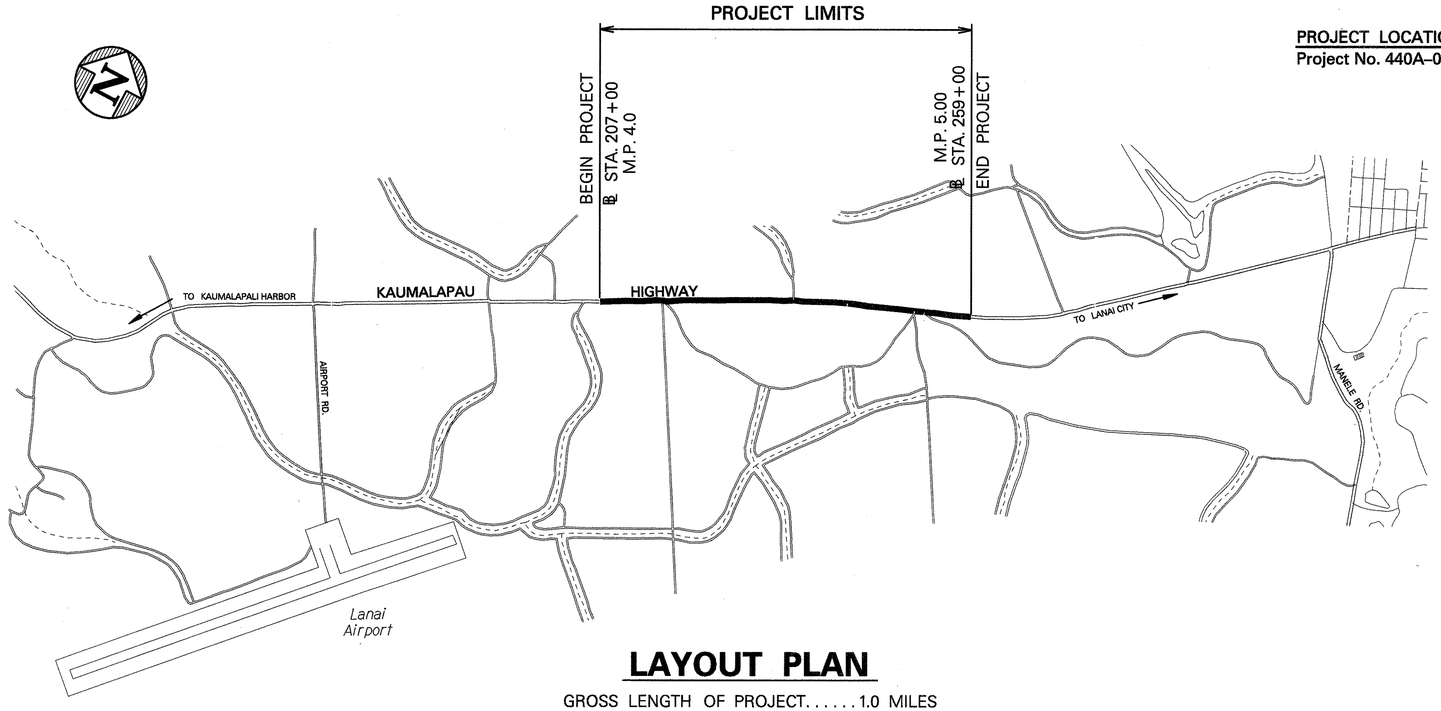

LAYOUT PLAN

GROSS LENGTH OF PROJECT.....1.0 MILES

NET LENGTH OF PROJECT.....1.0 MILES

1 0 1 2 3

SCALE IN THOUSAND FEET

FEDERAL AID PROJECTS PREVIOUSLY CONSTRUCTED OR UNDER CONSTRUCTION

MILE POST 4.0 TO MILE POST 5.00

NO SIGNIFICANT CHANGES WERE MADE DURING CONSTRUCTION ON THESE PLANS EXCEPT CHANGES IN THE ORIGINAL THEORETICAL QUANTITIES. FOR ACTUAL QUANTITIES, REFER TO PROJECT LEDGER AND/OR COMPUTATION BOOK.

Charlene Ahuyong (acting) 12/4/07
RESIDENCY ENGINEER — DATE

DEPARTMENT OF TRANSPORTATION
STATE OF HAWAII

APPROVED:

Wayne Nagasheda 12/5/00
DIR. OF TRANSPORTATION — DATE

HWY-M — DESIGNED BY

PAUL M. CHUNG — P. S. & E. BY

873-3535 — PHONE

AUG. 2000 — DATE

6xmpmtsht.dgn /teddy