FED. ROAD DIST. NO.	STATE	PROJ. NO.	FISCAL YEAR	SHEET NO.	TOTAL SHEETS
HAWAII	HAW.	HWY-M-03-08M	2008	1	22

450 460

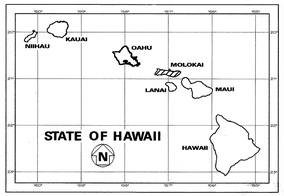

INDEX TO DRAWINGS	
SHEET NO.	DESCRIPTION
1	TITLE SHEET
2	STANDARD PLANS SUMMARY
3	PAVEMENT MARKING LEGEND, DETAILS AND GENERAL NOTES
4 – 5	WATER POLLUTION & EROSION CONTROL NOTES
6 – 22	PAVEMENT MARKING PLANS

STATE OF HAWAII

DEPARTMENT OF TRANSPORTATION

HIGHWAYS DIVISION

HONOLULU, HAWAII

AS-BUILT

PLANS FOR

PAVEMENT MARKING AND STRIPING

AT VARIOUS LOCATIONS

PROJECT NO. HWY-M-03-08M

DISTRICT OF MOLOKAI

ISLAND OF MOLOKAI

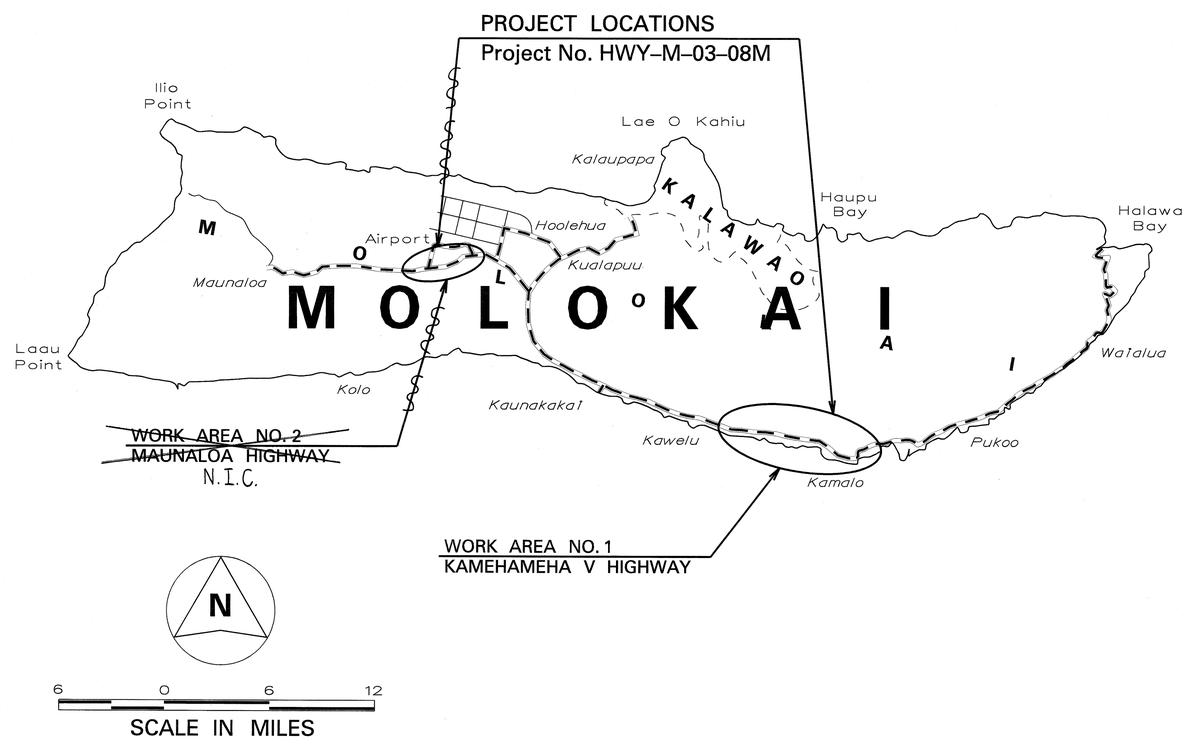

FEDERAL AID PROJECTS PREVIOUSLY CONSTRUCTED OR UNDER CONSTRUCTION

(1) MILE POST 7.14 TO MILE POST 11.30 (KAM V HWY.)

~~(2) MILE POST 7.00 TO MILE POST 9.00 (MAUNALOA HWY.)~~

CHANGES MADE DURING CONSTRUCTION HAVE BEEN INCORPORATED ON THESE PLANS EXCEPT CHANGES IN THE ORIGINAL THEORETICAL QUANTITIES. FOR ACTUAL QUANTITIES, REFER TO PROJECT LEDGER AND/OR COMPUTATION BOOK.

RESIDENT ENGINEER — DATE 5/12/11

DEPARTMENT OF TRANSPORTATION STATE OF HAWAII	
APPROVED:	
DIR. OF TRANSPORTATION	DATE 4-23-08

HWY-M	HWY-ME	873-3535	APRIL 2008
DESIGNED BY	MANAGED BY	PHONE	DATE