FED. ROAD DIST. NO.	STATE	FED. AID PROJ. NO.	FISCAL YEAR	SHEET NO.	TOTAL SHEETS
HAWAII	HAW.	RS-0450(3)	1981	1	18

450

450

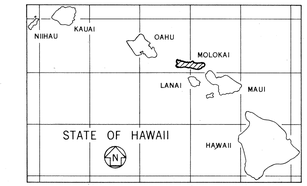

INDEX TO DRAWINGS

SHEET NO.	DESCRIPTION
1	TITLE SHEET
2	DETOUR ROAD
3-8	REPLACEMENT OF KAMALO BR.
9-17	STANDARD DETAIL
18	TYPICAL BARRICADES DETAILS

STATE OF HAWAII

DEPARTMENT OF TRANSPORTATION

HIGHWAYS DIVISION

HONOLULU, HAWAII

"AS-BUILT"

PLANS FOR

KAMEHAMEHA V HIGHWAY

REPLACEMENT OF KAMALO BRIDGE

FEDERAL AID SECONDARY PROJ. NO. RS-0450(3)

DISTRICT OF MOLOKAI
ISLAND OF MOLOKAI

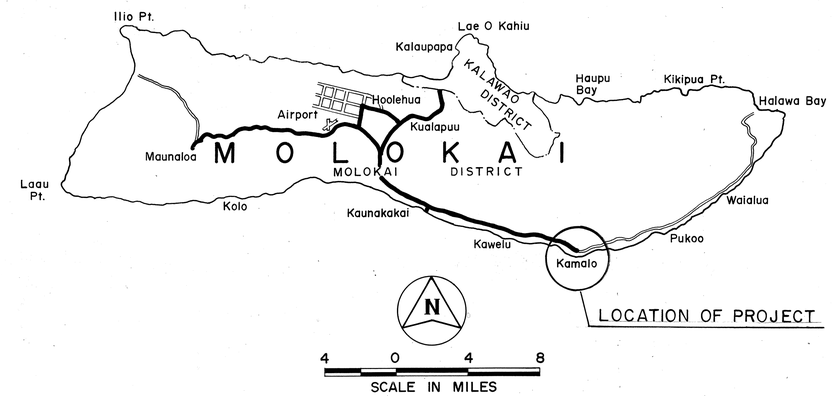

FEDERAL AID PROJECTS PREVIOUSLY CONSTRUCTED OR UNDER CONSTRUCTION

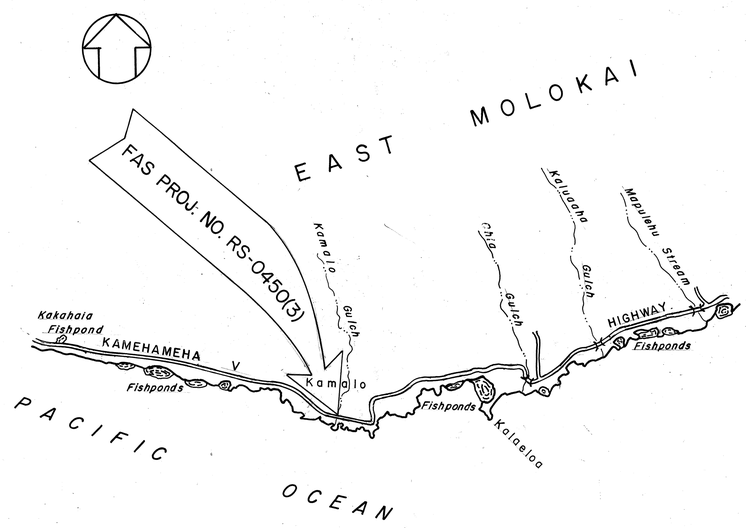

LAYOUT PLAN

SCALE IN MILES 0 1 2 3 4

DESIGN DESIGNATION

CURRENT ADT (1980)	1,290
DESIGN ADT (2000)	2,230
DHV	250
D	65/35
T	7.0%
T24	4.5%
K	11.0%

ALL CHANGES MADE DURING CONSTRUCTION HAVE BEEN INCORPORATED ON THESE PLANS EXCEPT CHANGES IN THE ORIGINAL THEORETICAL QUANTITIES.

Manuel J. Silva — PROJECT ENGINEER

1 Dec 81 — DATE

DEPARTMENT OF TRANSPORTATION
STATE OF HAWAII

APPROVED:

Ryokichi Higashionna — DIR. OF TRANSPORTATION

Jan 12, 81 — DATE

HWY-DB — DESIGNED BY

A. YAMAGUCHI — P. S. & E. BY

548-4125 — PHONE

JAN. 12, 1981 — DATE

1988-1122

C-7-1