FED. ROAD DIST. NO.	STATE	FED. AID PROJ. NO.	FISCAL YEAR	SHEET NO.	TOTAL SHEETS
HAWAII	HAW.	ER-12(4)	2001	17	73

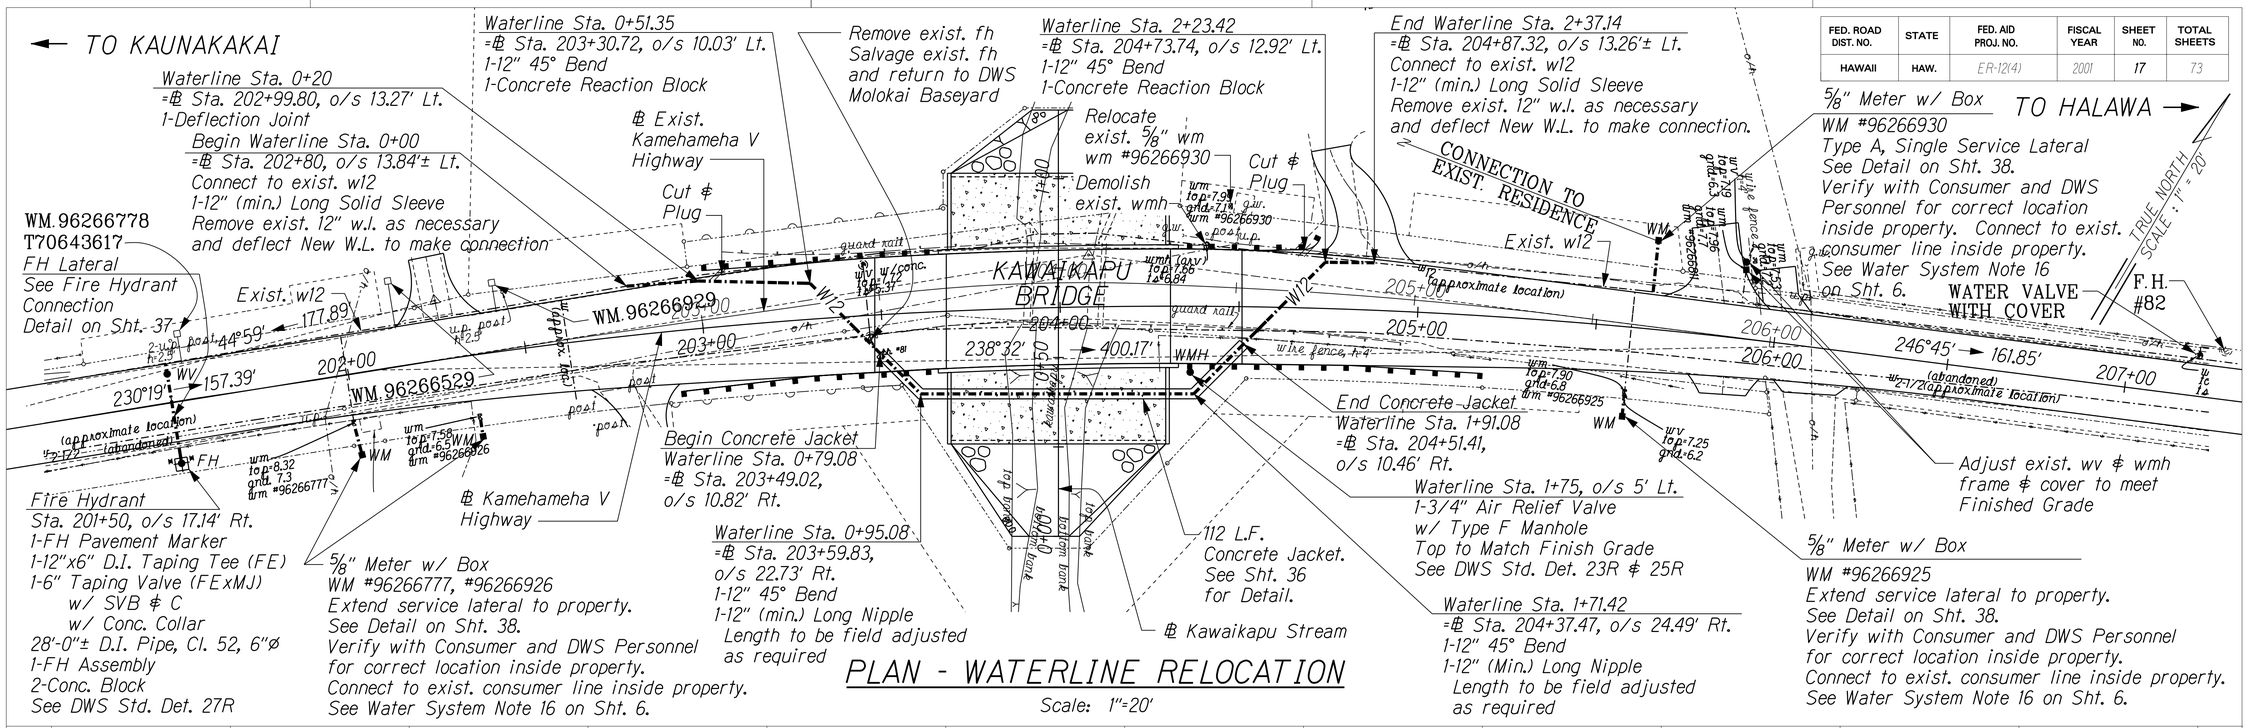

PLAN - WATERLINE RELOCATION

Scale: 1"=20'

NOTE:

All stationings are based on new Kamehameha V Highway baseline.

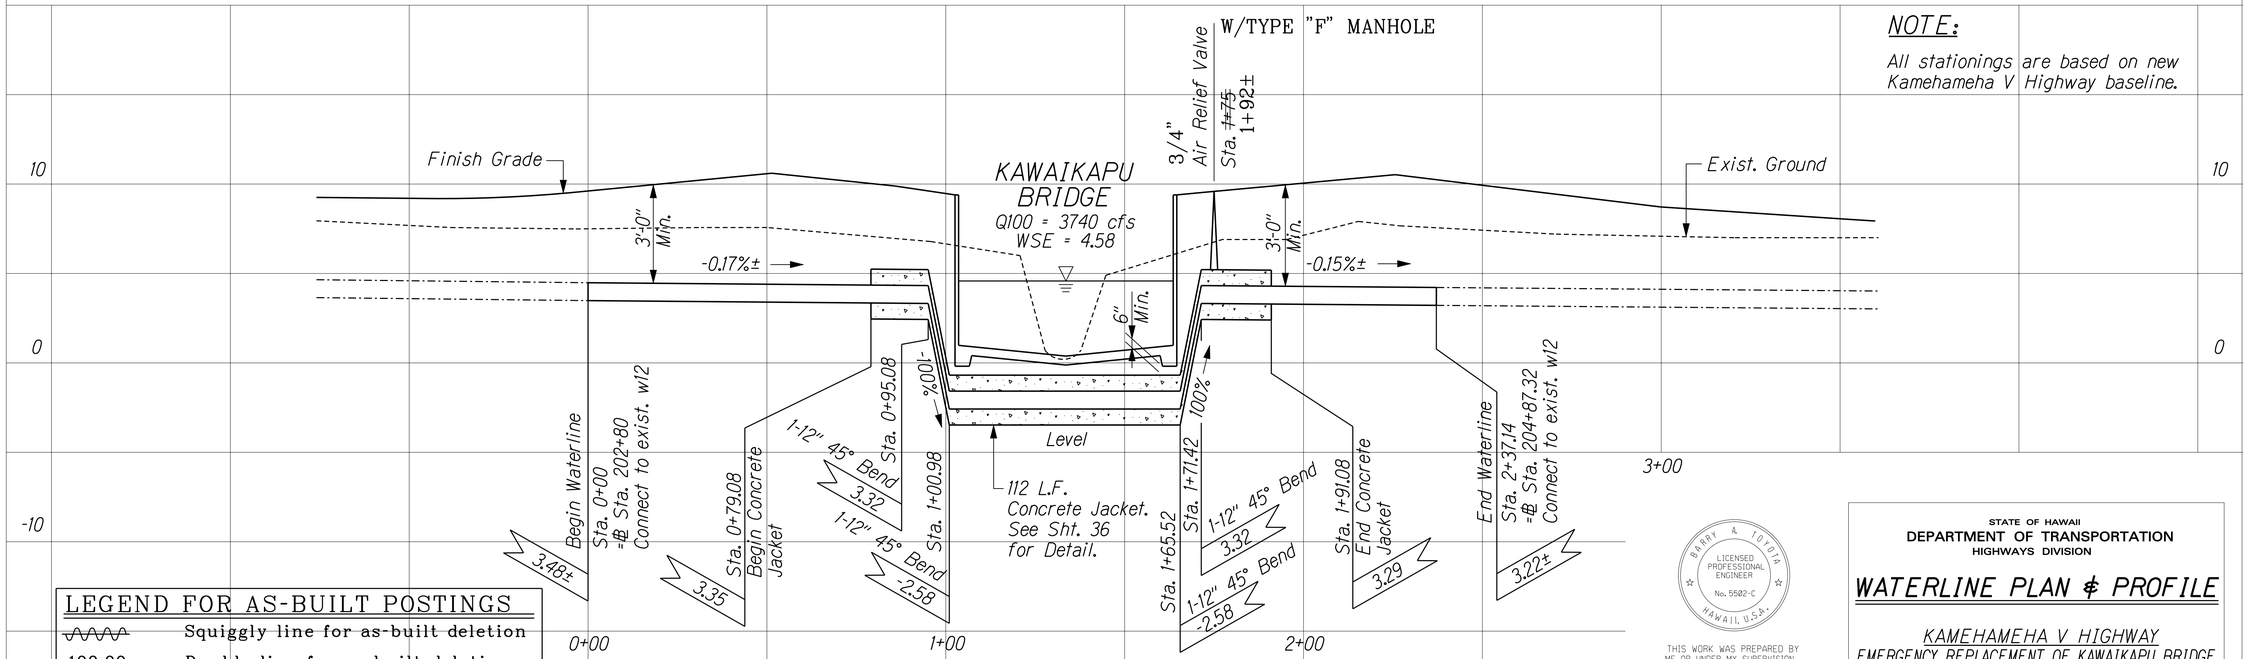

PROFILE - WATERLINE RELOCATION

Scale: Horiz. 1"=20'
Vert. 1"=4'

LEGEND FOR AS-BUILT POSTINGS	
~~	Squiggly line for as-built deletion
~~100.00~~	Double line for as-built deletion
Roadway	Text for as-built posting

ORIGINAL PLAN	SURVEY PLOTTED BY	DATE
	DRAWN BY	
	TRACED BY	
NOTE BOOK	DESIGNED BY	
	QUANTITIES BY	
	CHECKED BY	
No.		

BARRY K. TOYOTA
LICENSED PROFESSIONAL ENGINEER
No. 5502-C
HAWAII, U.S.A.

THIS WORK WAS PREPARED BY ME OR UNDER MY SUPERVISION.

SIGNATURE

STATE OF HAWAII
DEPARTMENT OF TRANSPORTATION
HIGHWAYS DIVISION

WATERLINE PLAN & PROFILE

KAMEHAMEHA V HIGHWAY
EMERGENCY REPLACEMENT OF KAWAIKAPU BRIDGE
FEDERAL AID PROJECT NO. ER-12(4)

Scale: As Shown Date: April 30, 2001

SHEET No. C14 OF 46 SHEETS

"AS-BUILT"