





FINAL SURVEY	SURVEYED BY	DATE
NOTE BOOK	PLOTTED TEMPLATE	
NO.	AREAS CHECKED	

ORIGINAL SURVEY		BY _____	DATE _____
SURVEYED	_____		
PLOTTED	_____		
TEMPLATE	_____		
AREAS	_____		
AREAS CHECKED	_____		
NO.	_____		

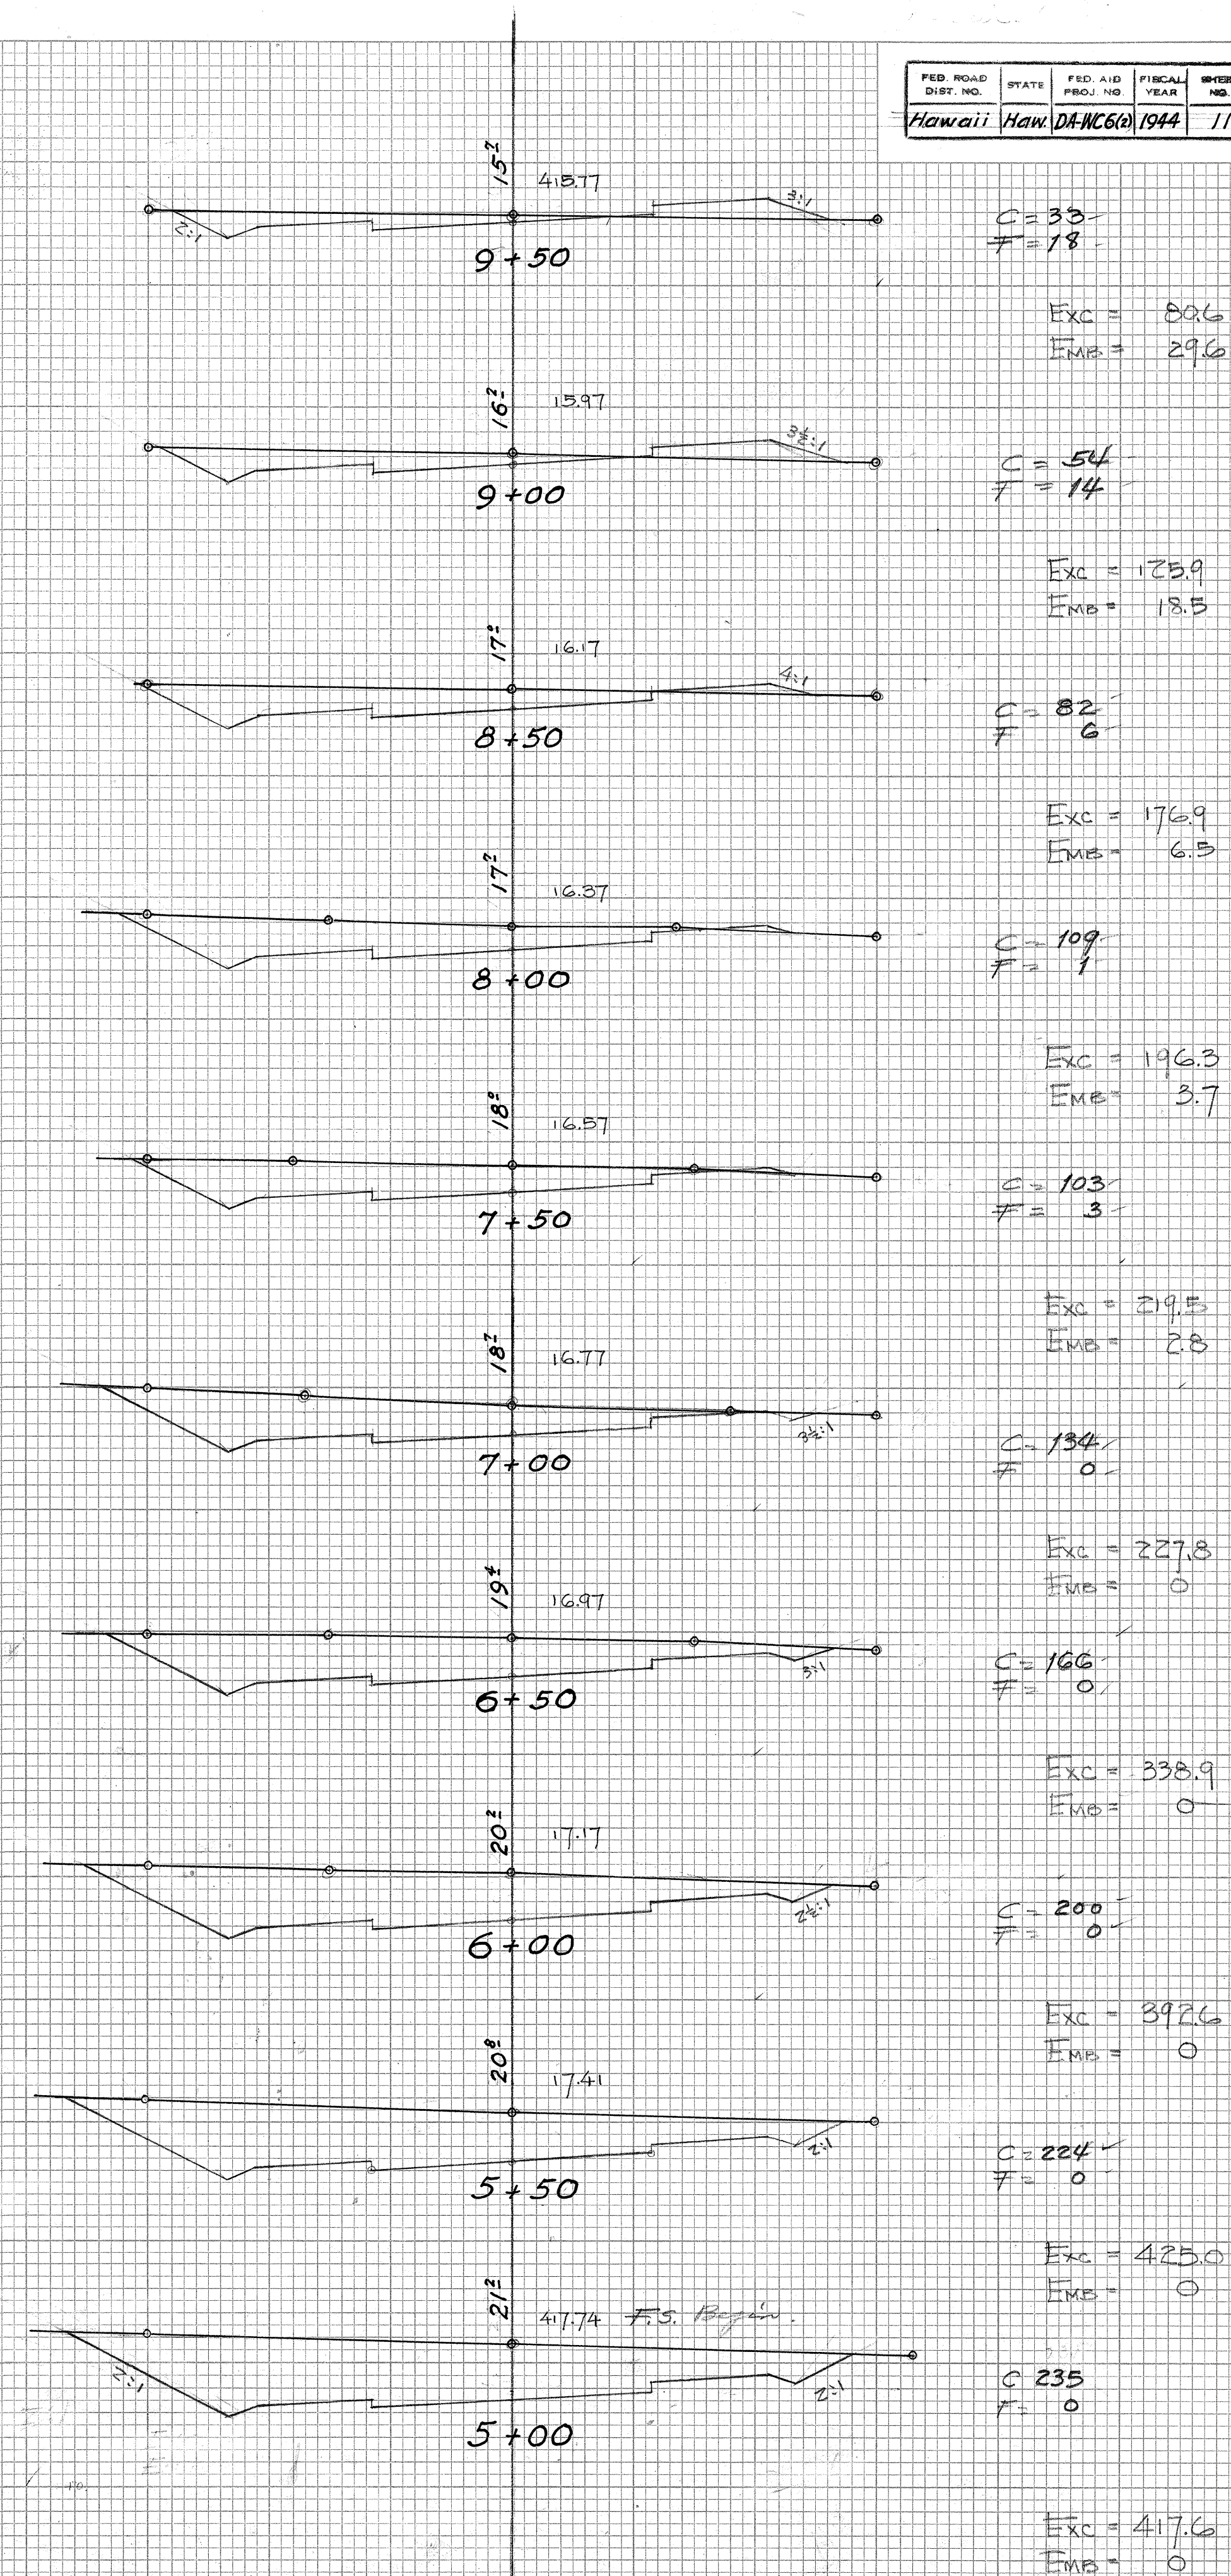


FINAL SURVEY PLOTTED DATE
NOTE BOOK NO.
AREAS CHECKED

ORIGINAL SURVEY PLOTTED DATE
NOTE BOOK NO.
AREAS CHECKED

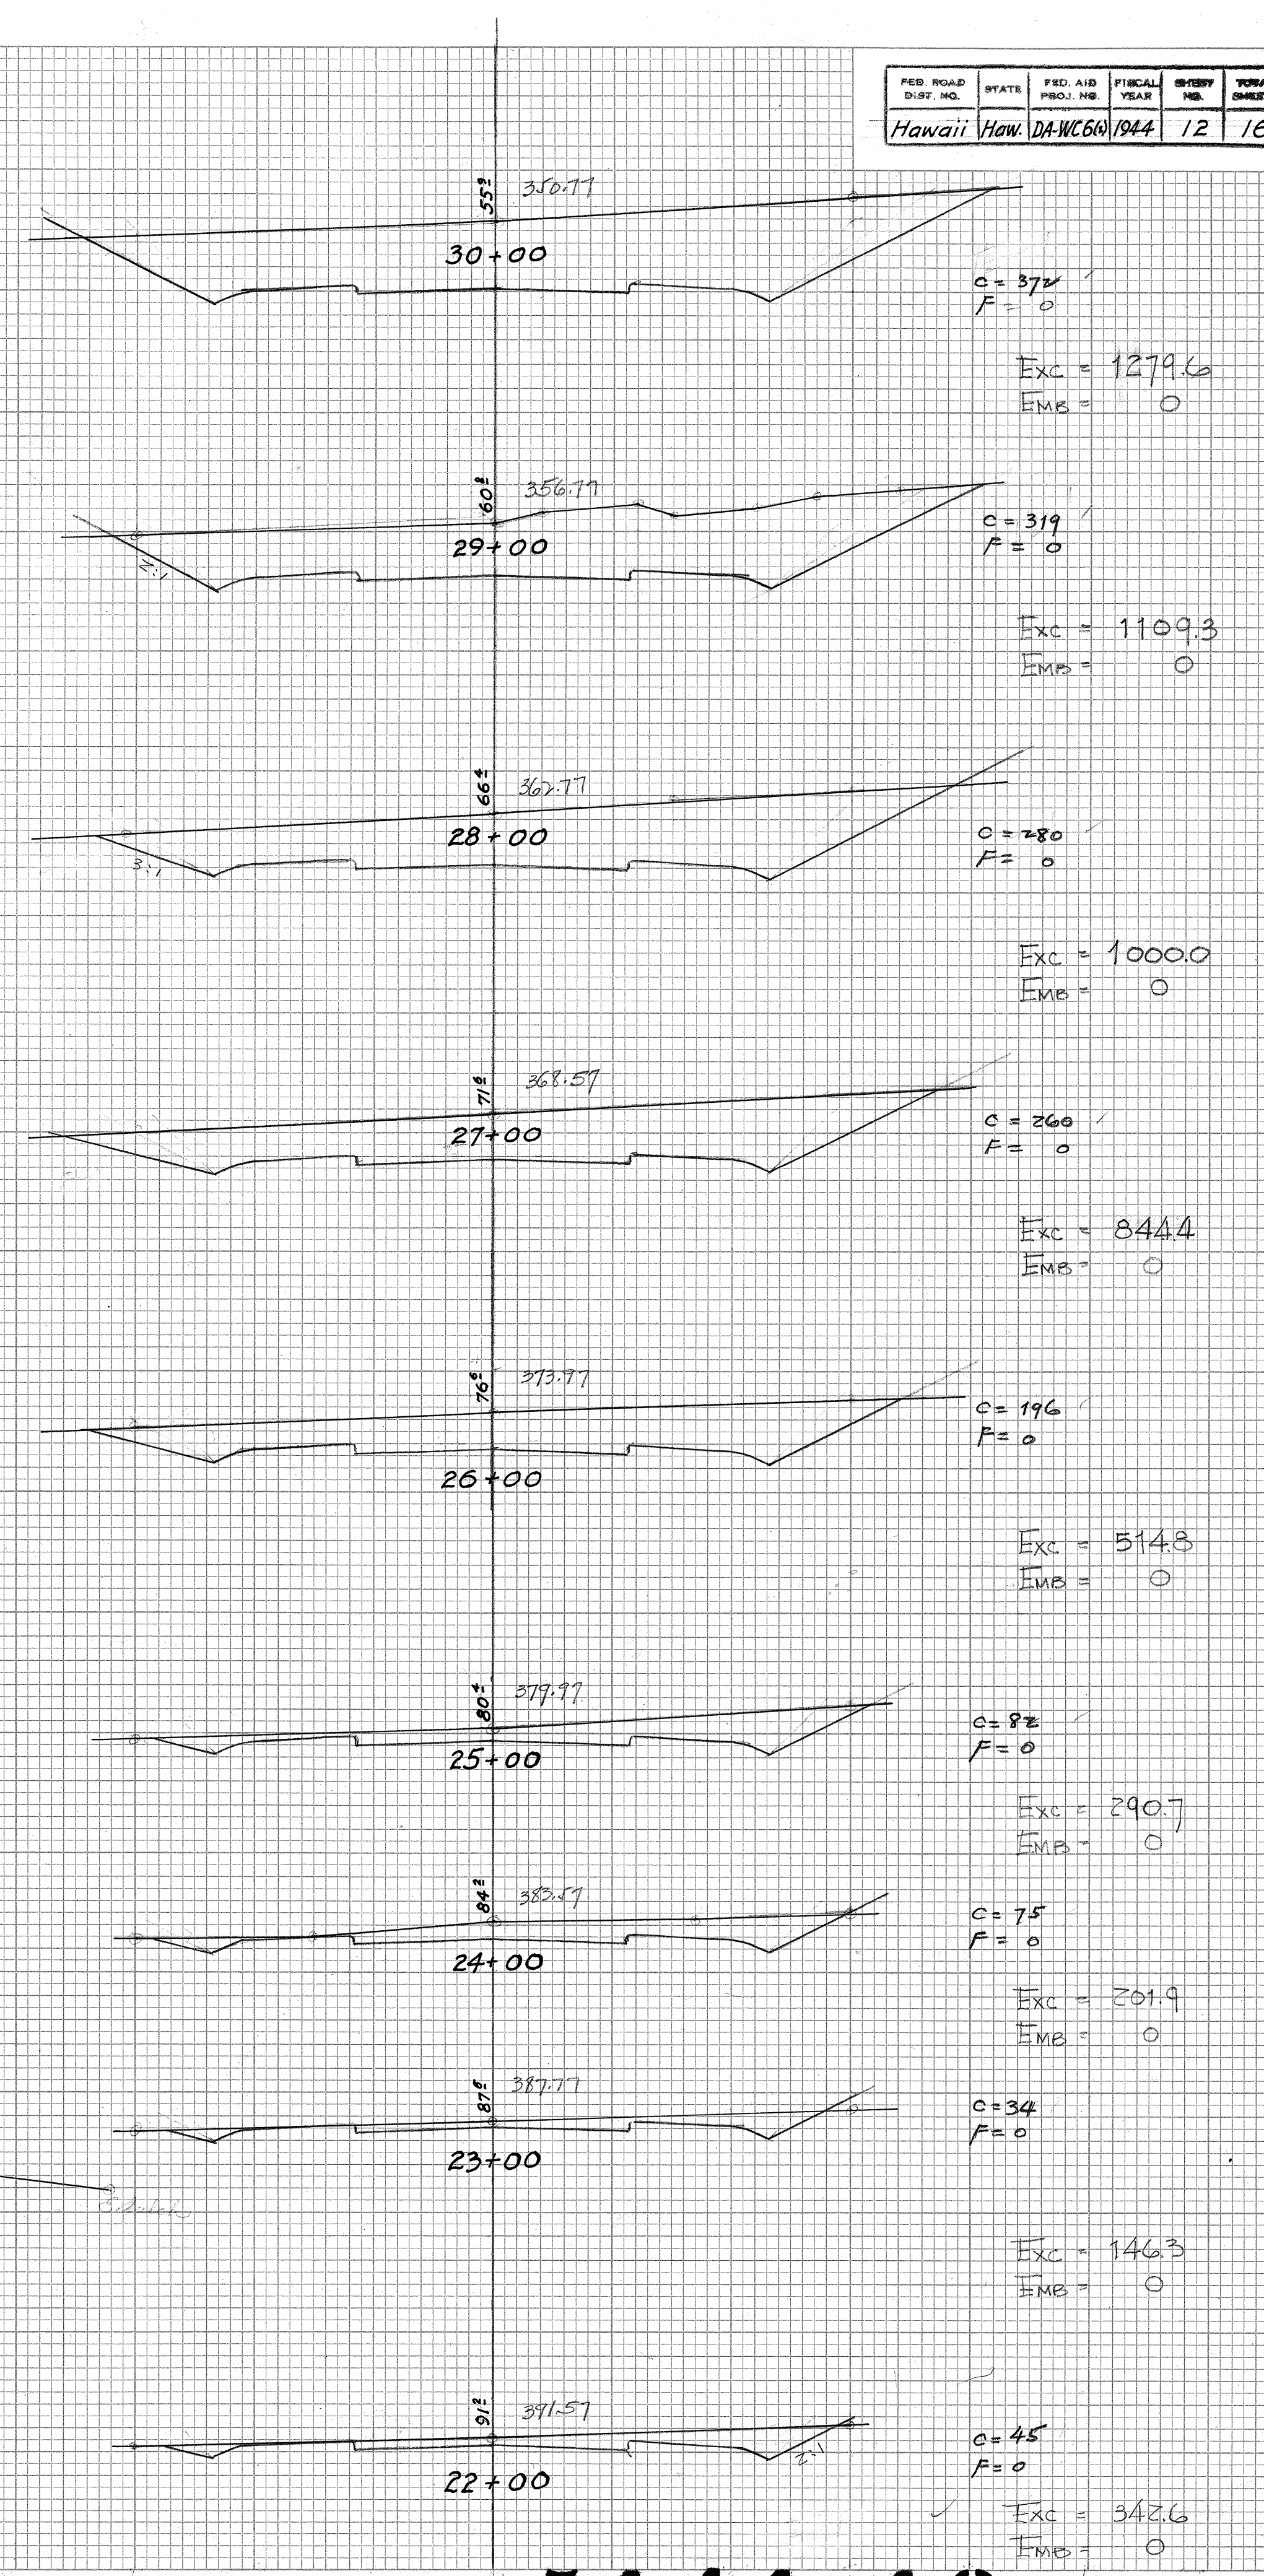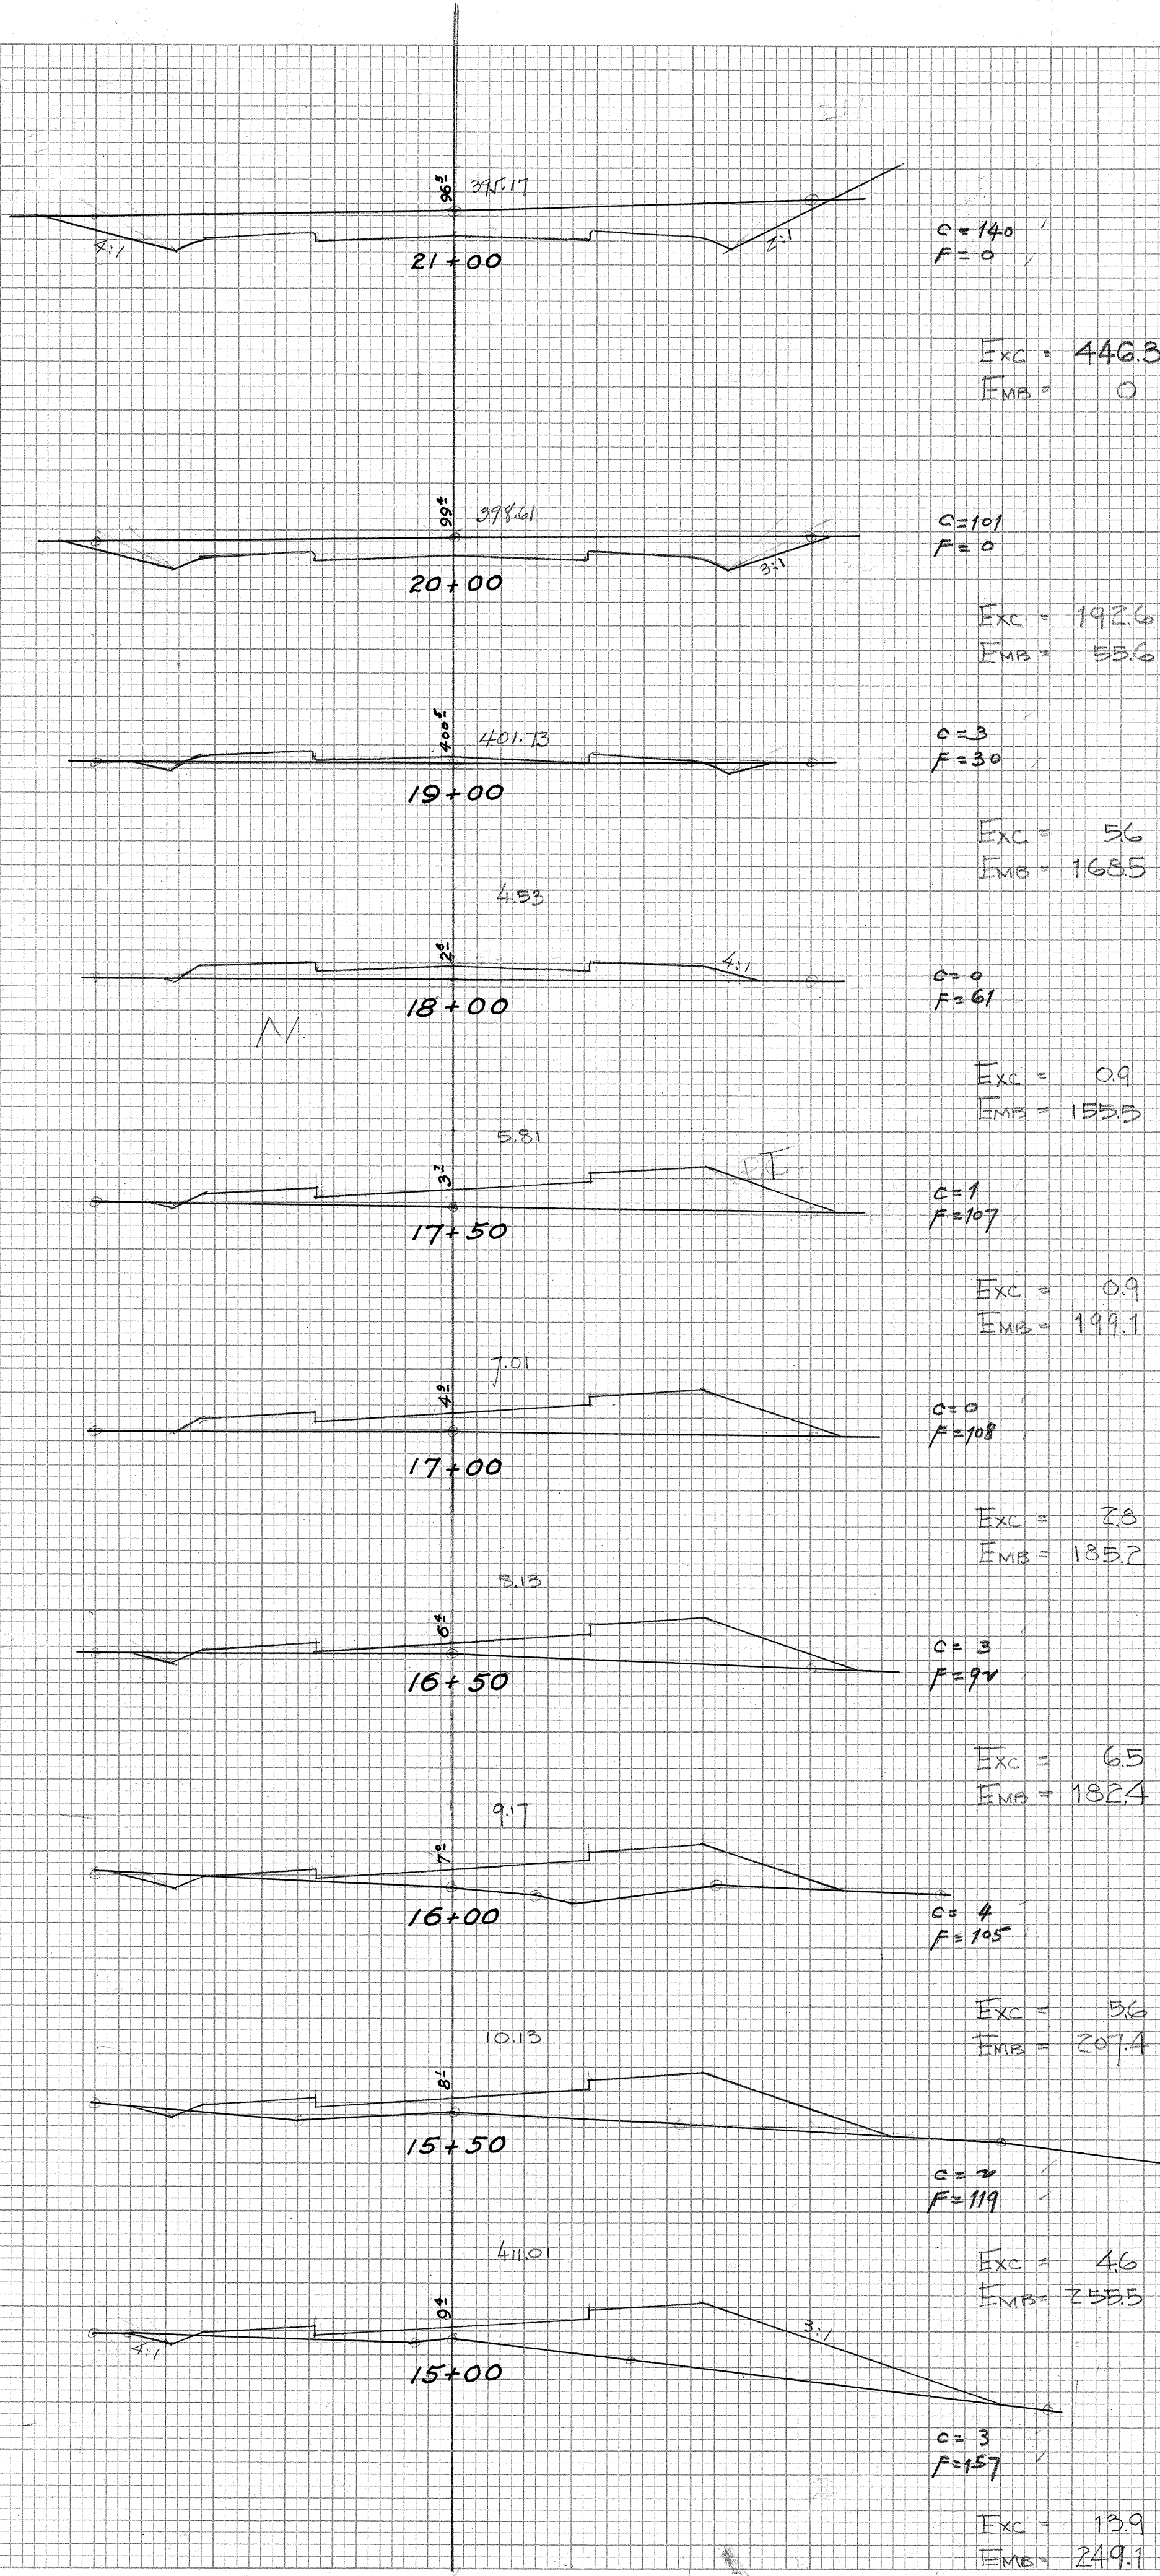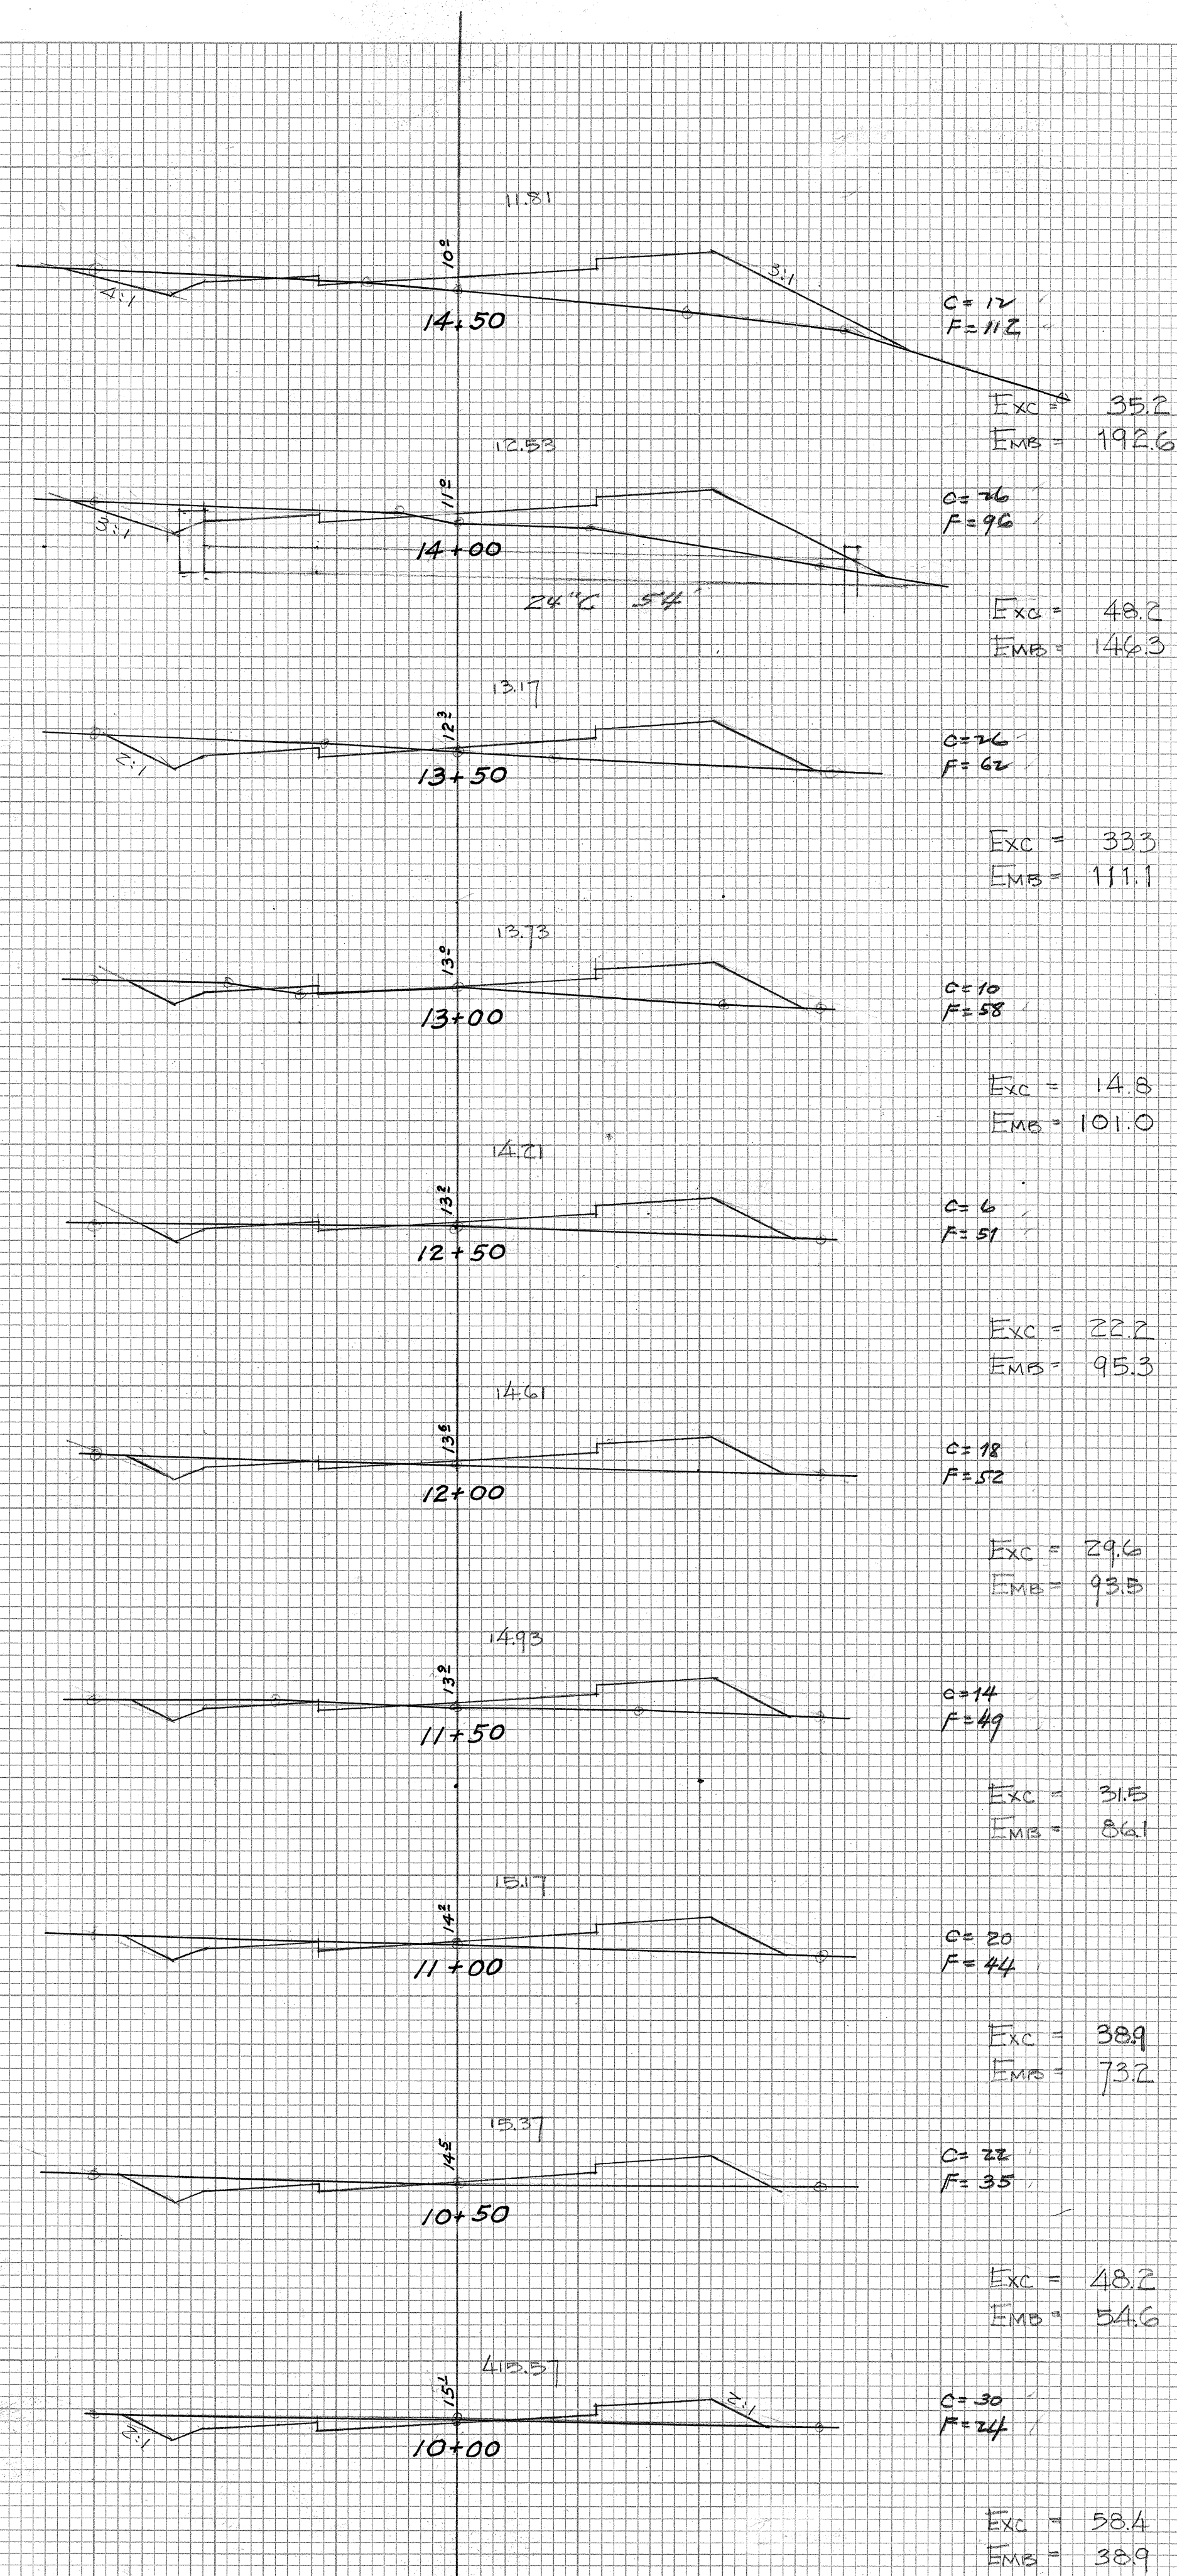

FINAL SURVEY
NO. _____
DATE _____
BY _____
SURVEYED
PLOTTED
NOTE BOOK
AREAS CHECKED


ORIGINAL SURVEY
NO. _____
DATE _____
BY _____
SURVEYED
PLOTTED
NOTE BOOK
AREAS CHECKED

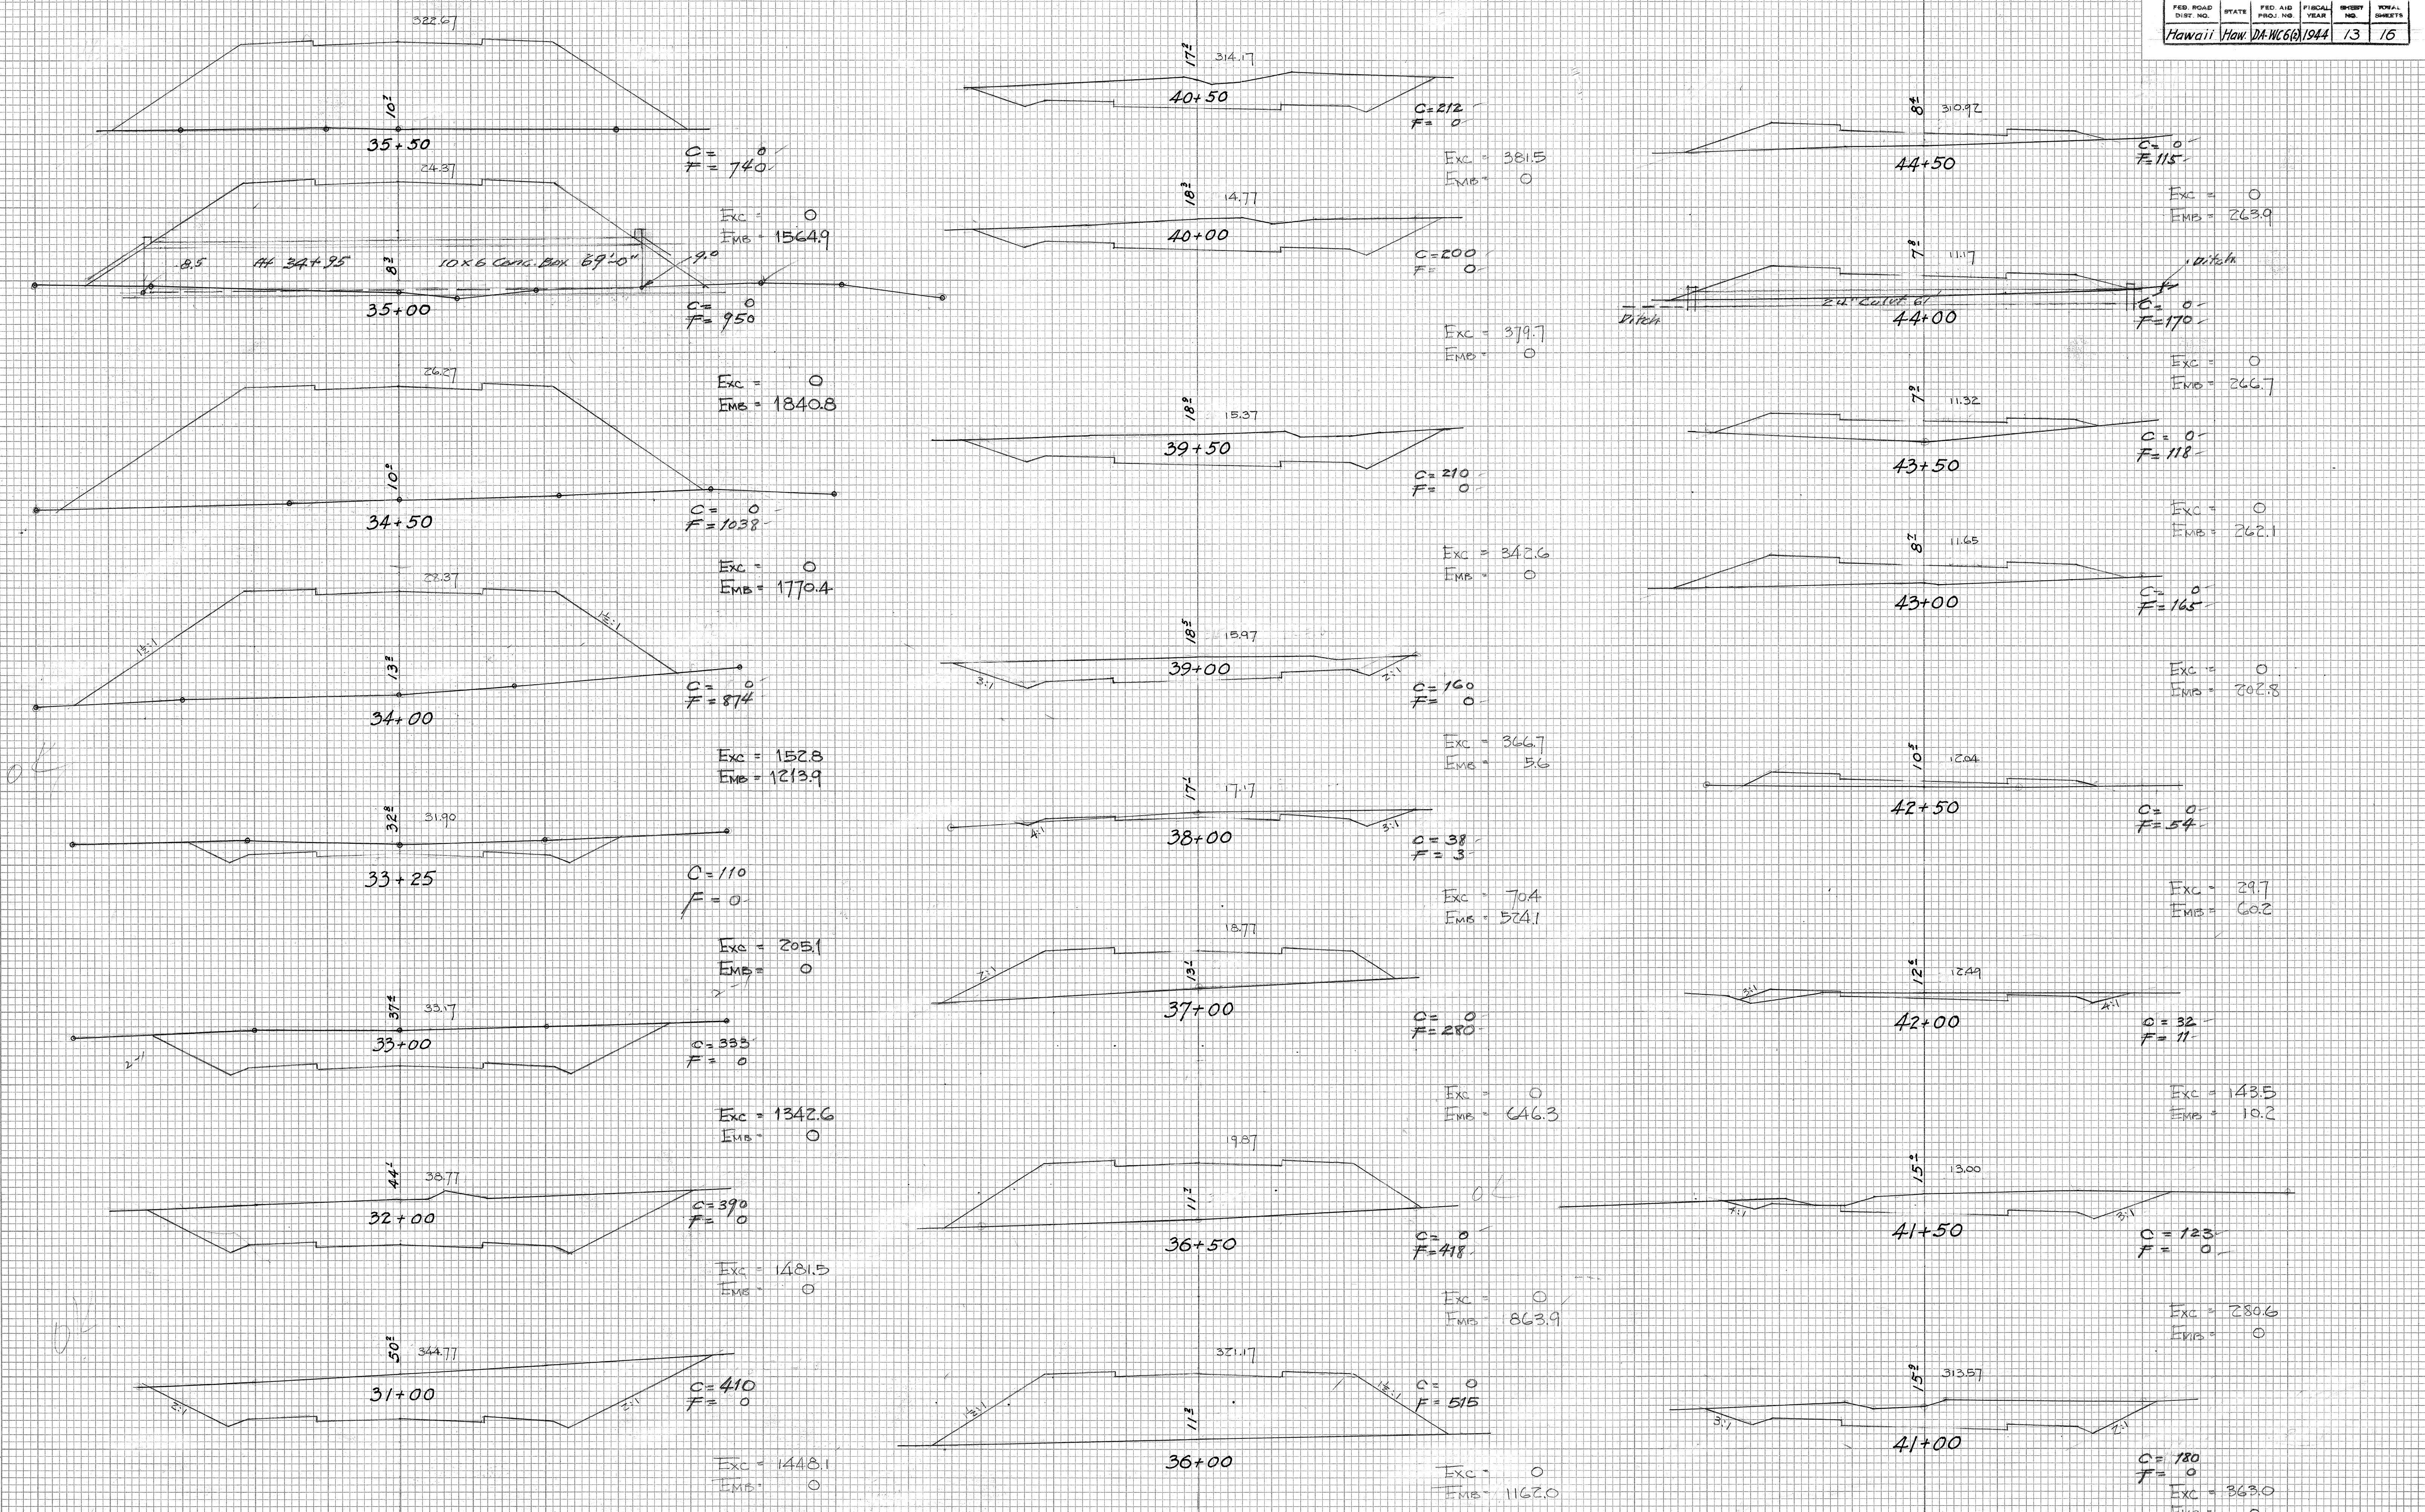

DATE	BY
FINAL SURVEY	SURVEYED
NOTE BOOK	PLOTTED
NO.	AREAS CHECKED





DATE	BY
ORIGINAL SURVEY	SURVEYED
NOTE BOOK	PLOTTED
NO.	AREAS CHECKED

FED. ROAD DIST. NO.	STATE	FED. AID PROJ. NO.	FISCAL YEAR	SHEET NO.	TOTAL SHEETS

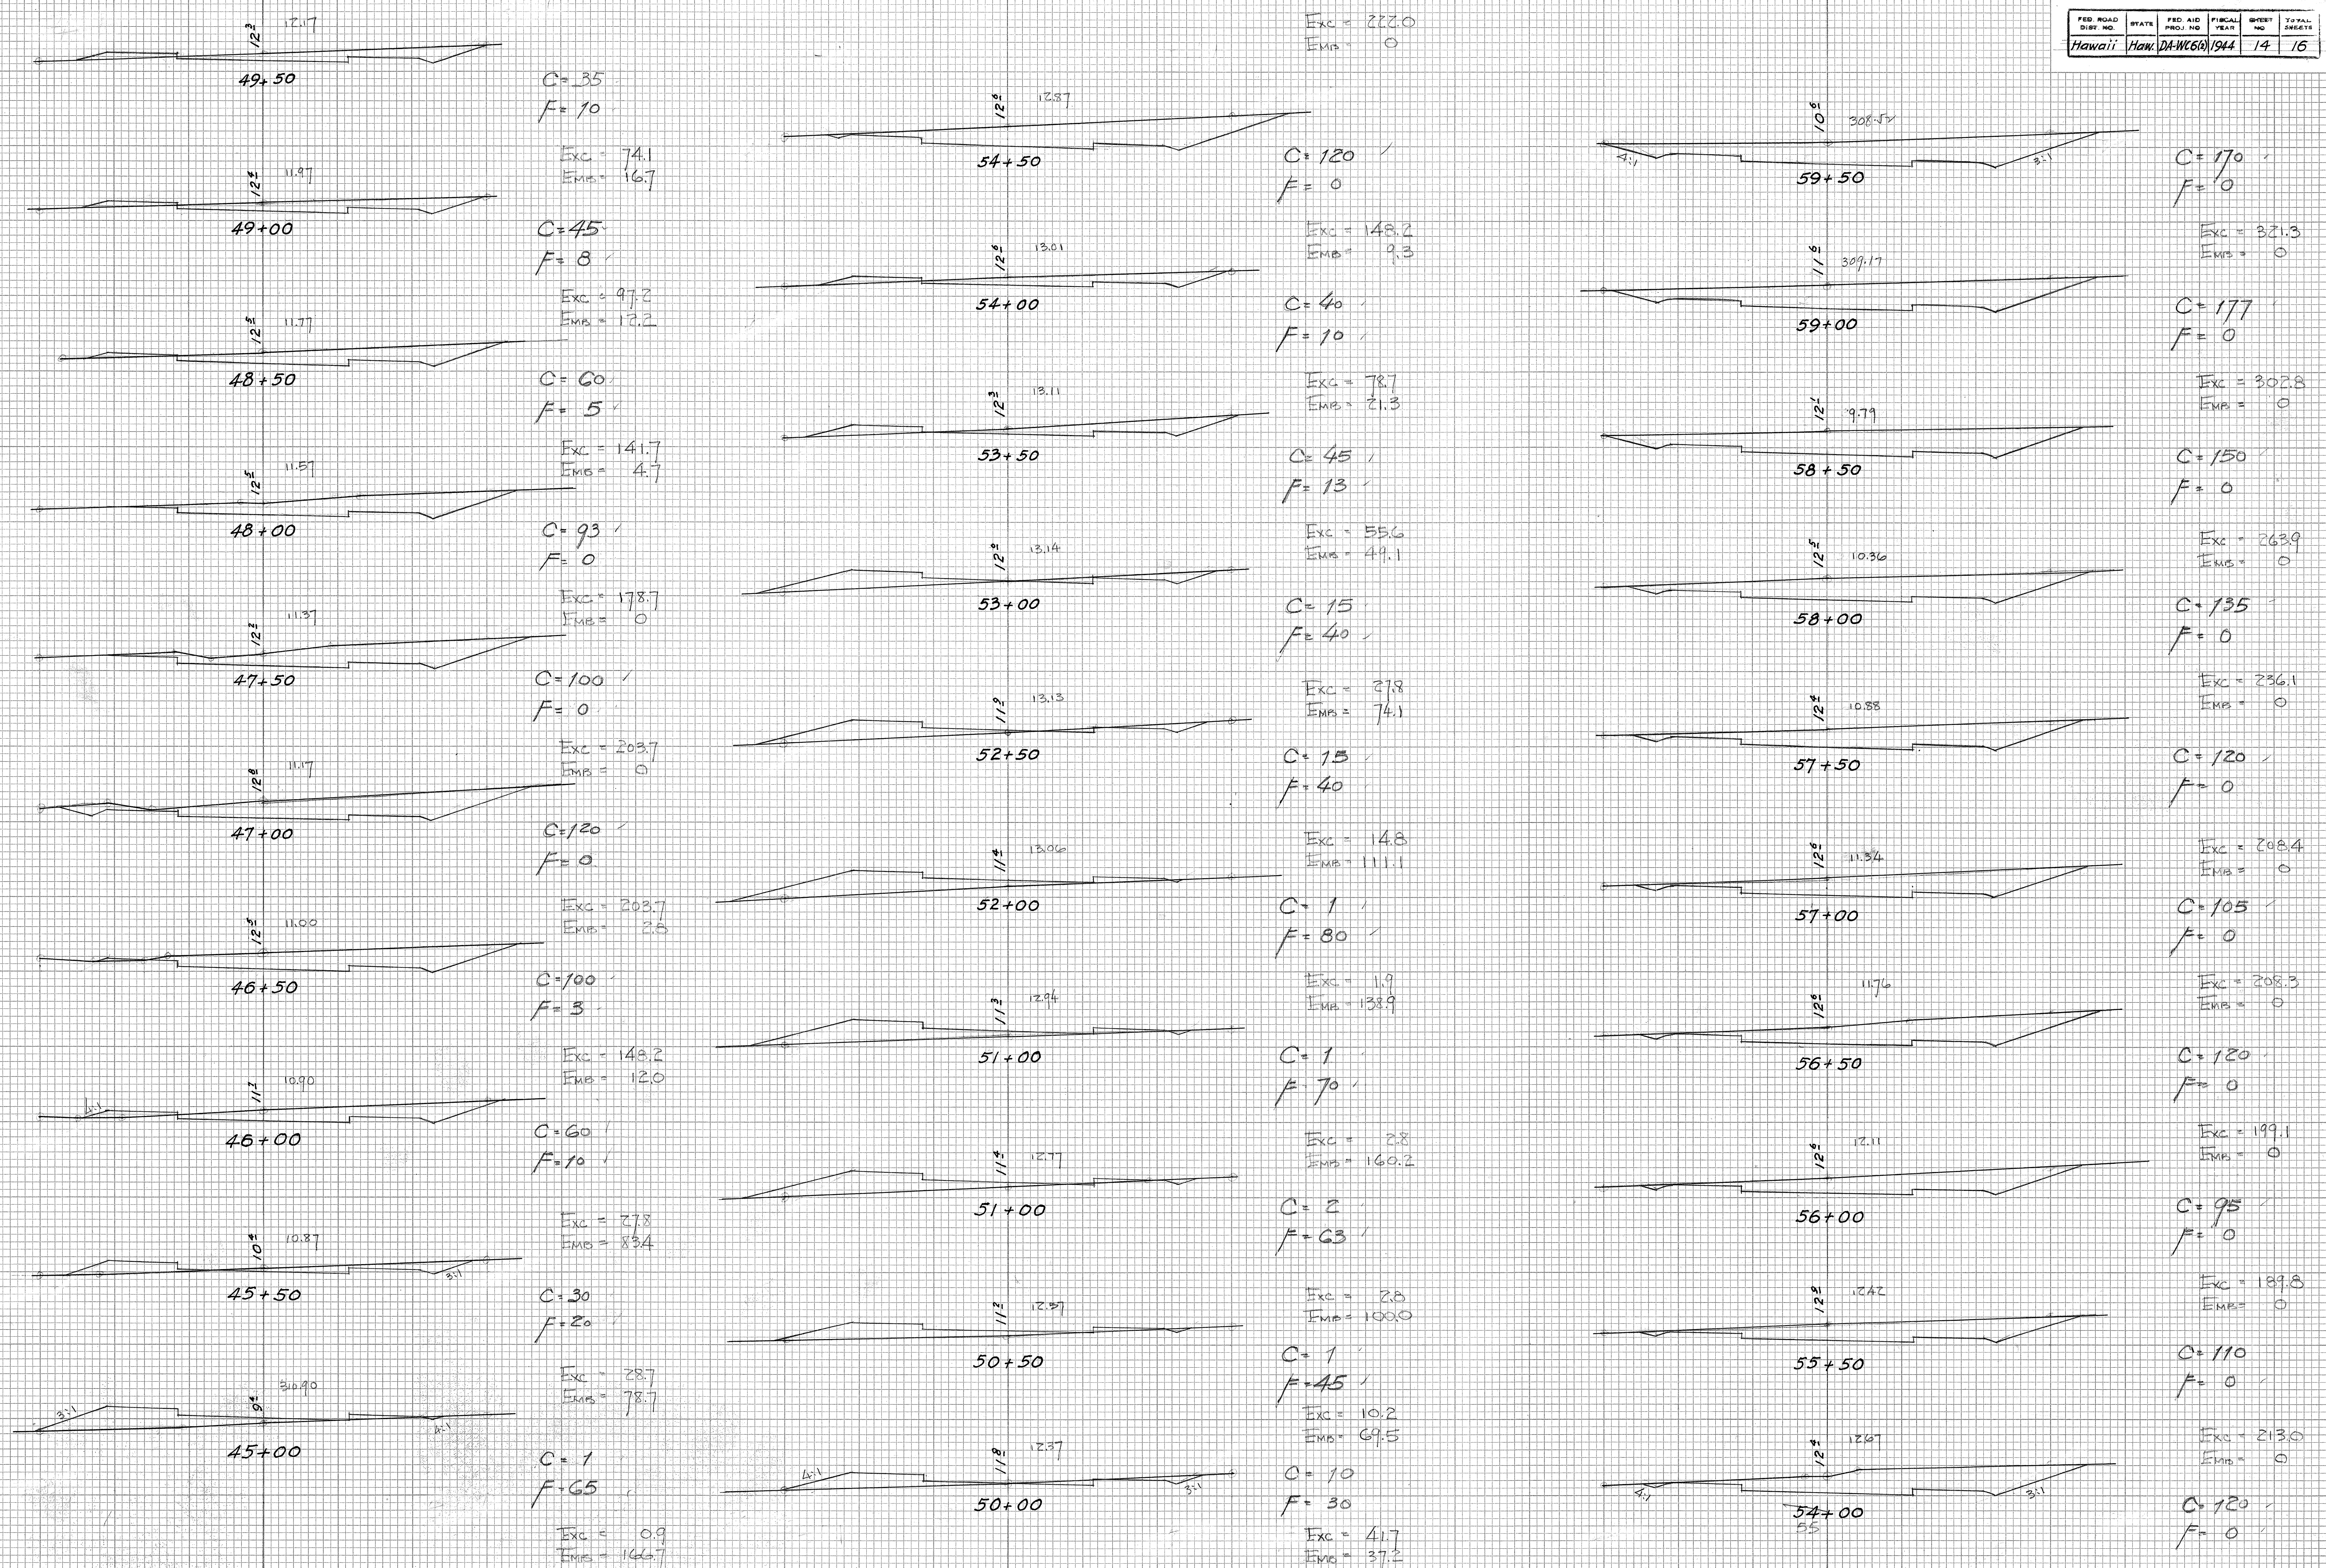

DATE _____ BY _____
 ORIGINAL SURVEY PLOTTED _____
 NOTE BOOK _____
 AREAS CHECKED _____

DATE _____ BY _____
 ORIGINAL SURVEY PLOTTED _____
 NOTE BOOK _____
 AREAS CHECKED _____

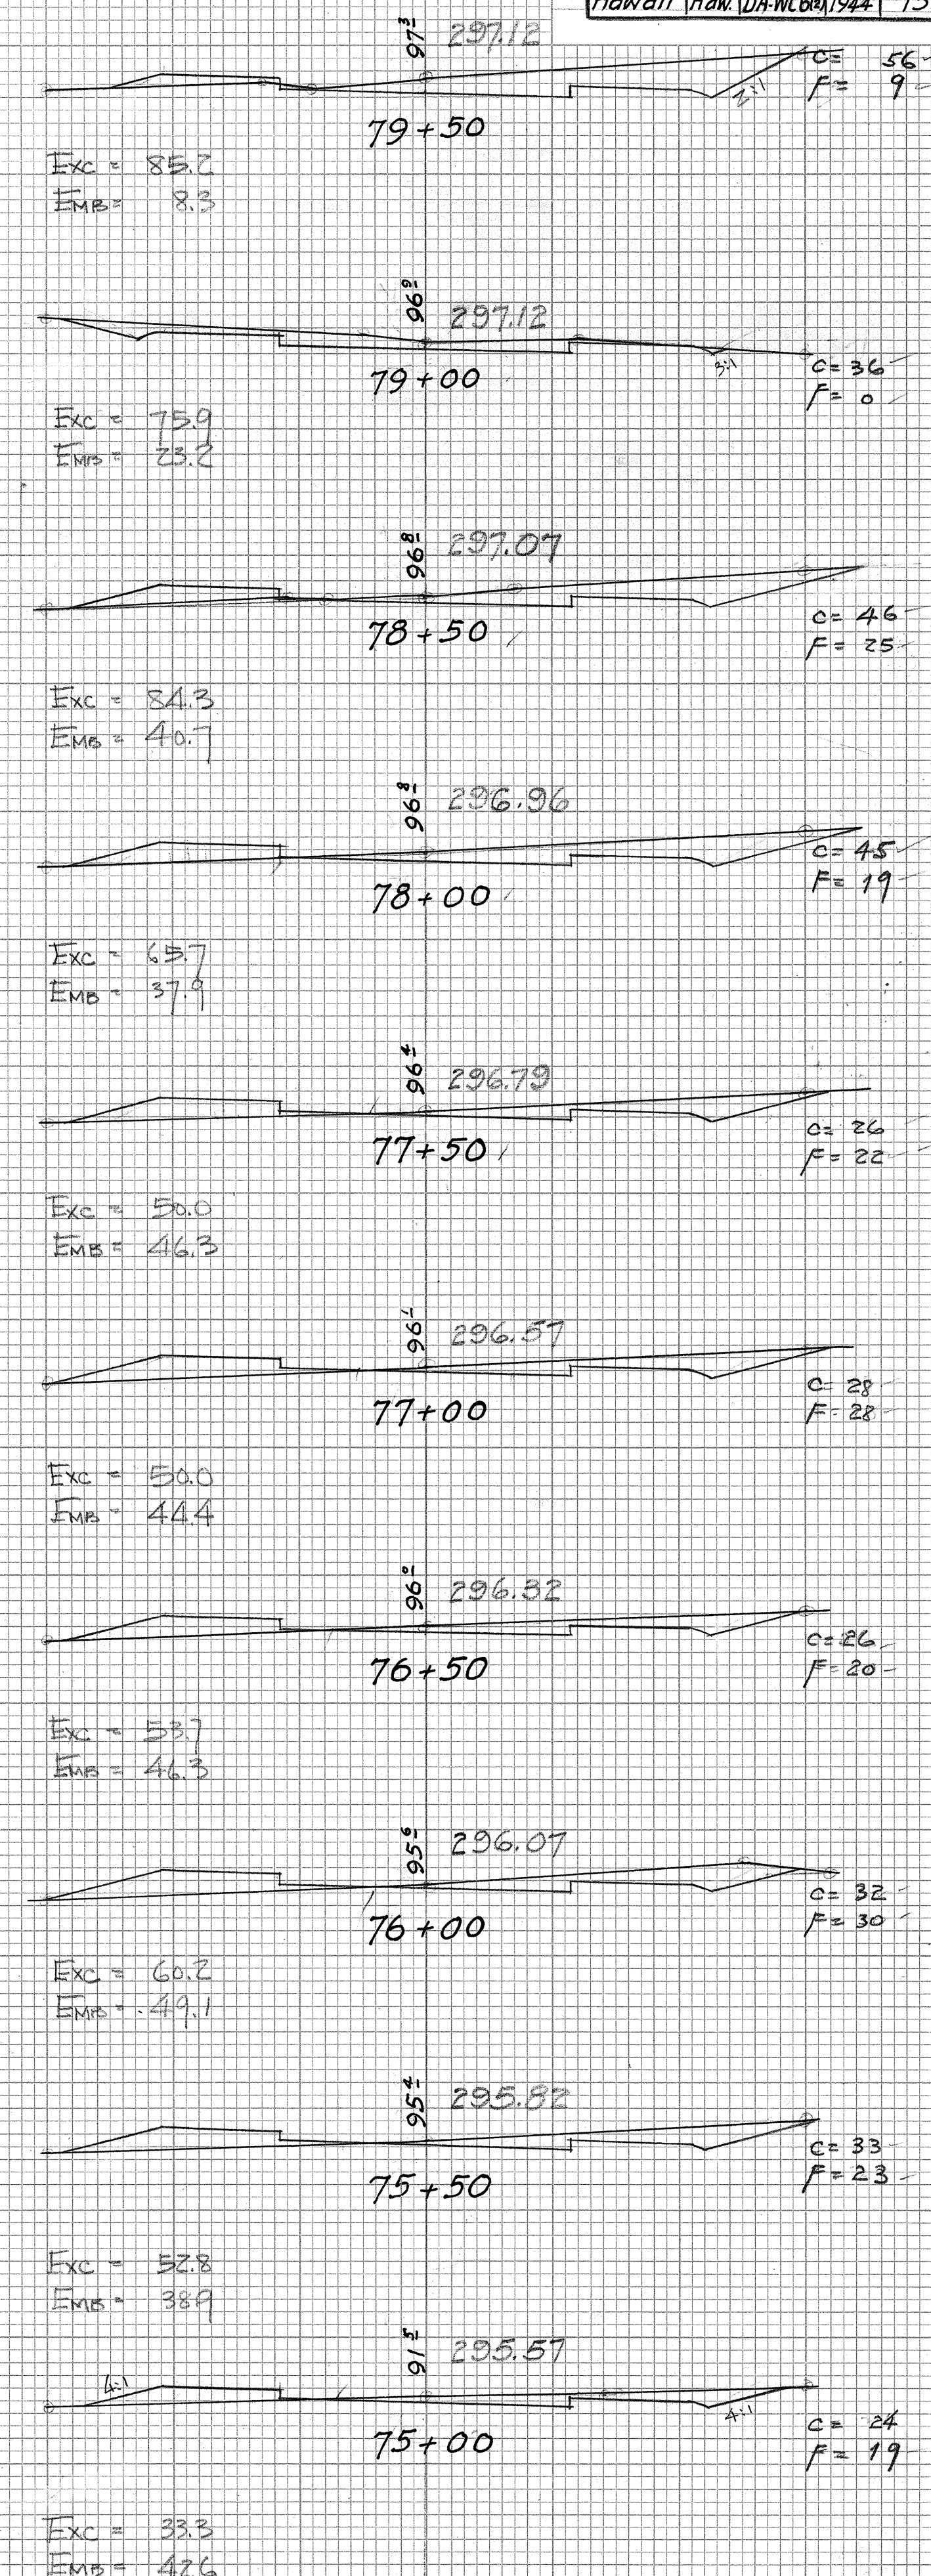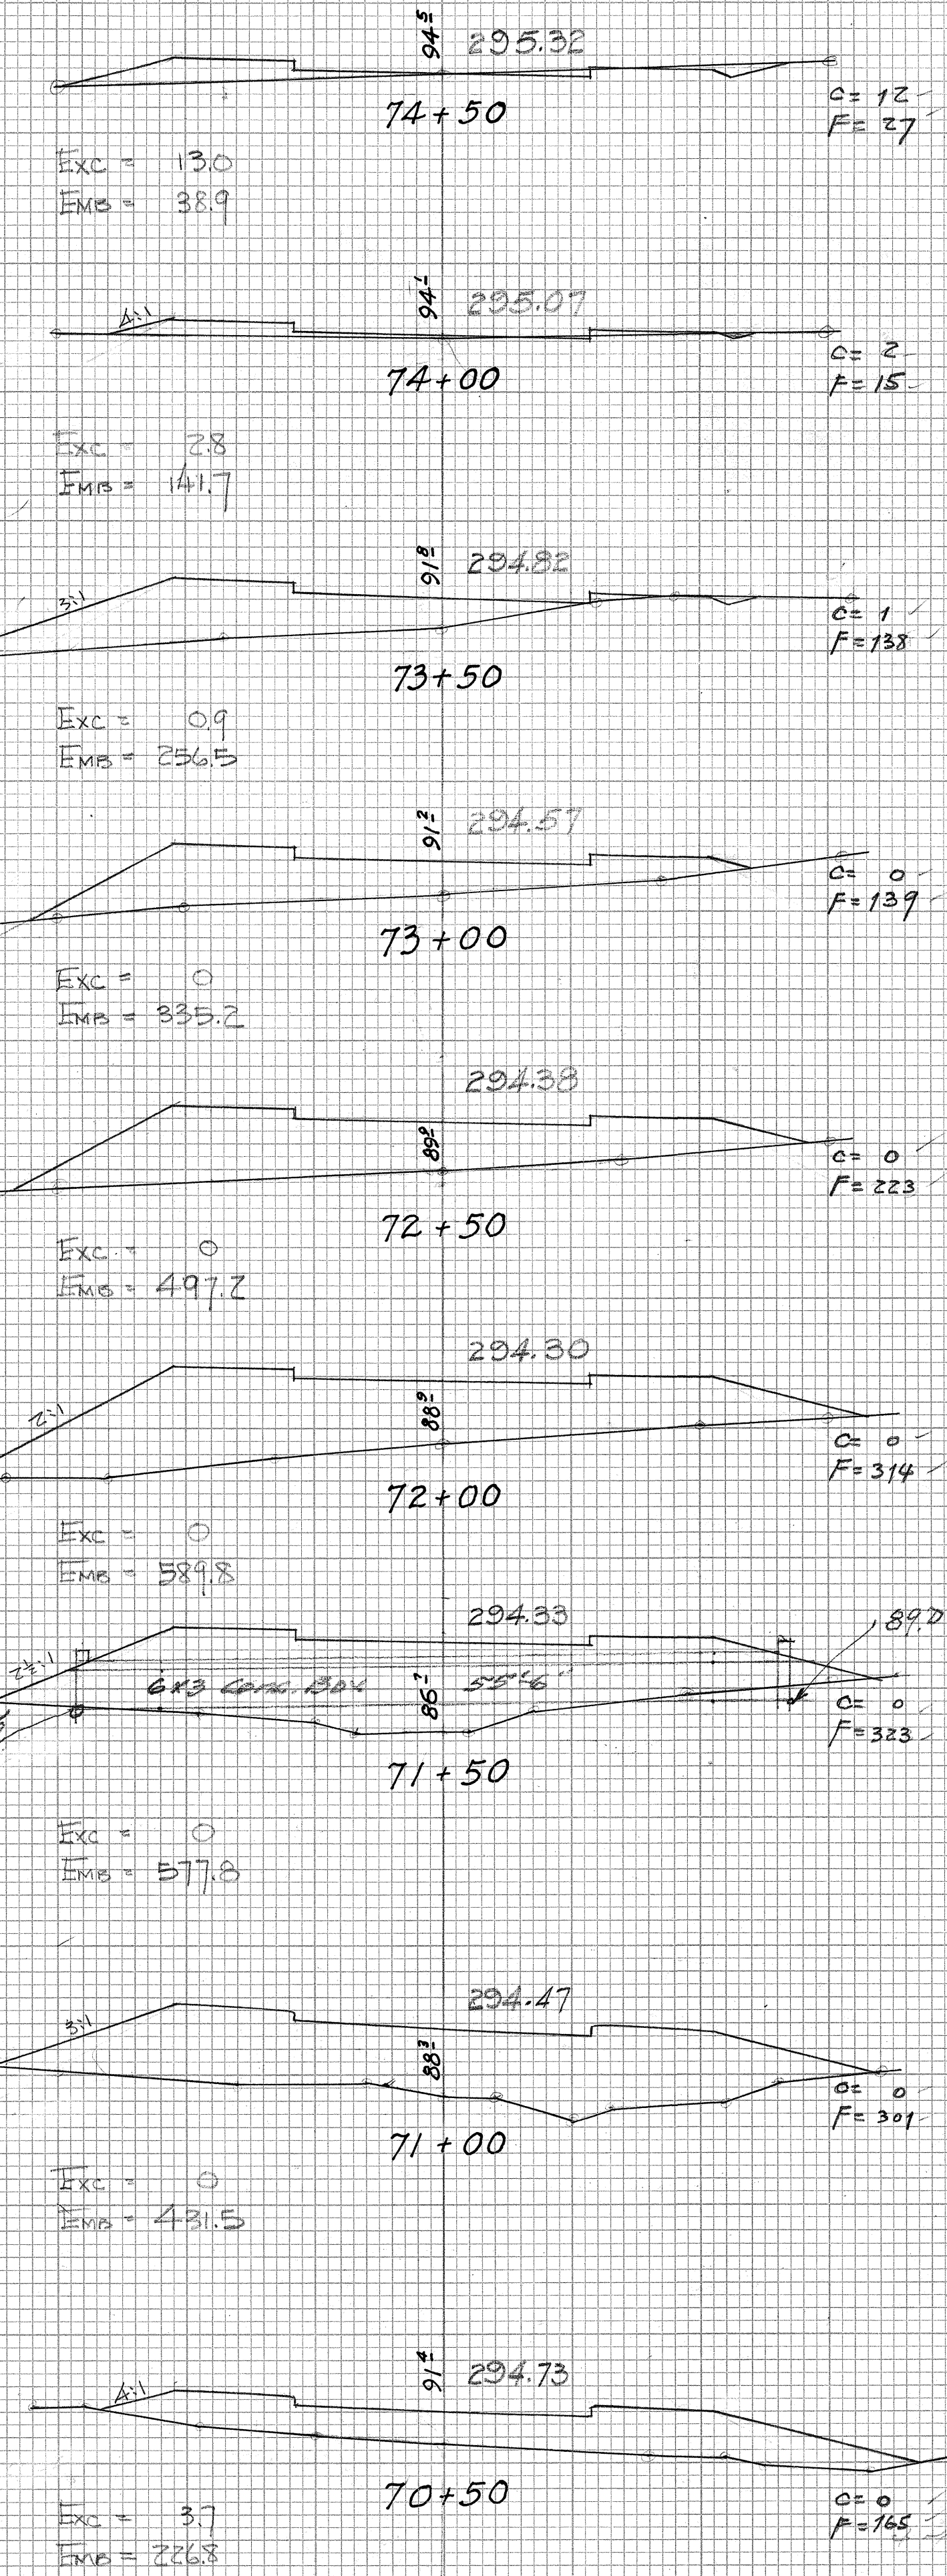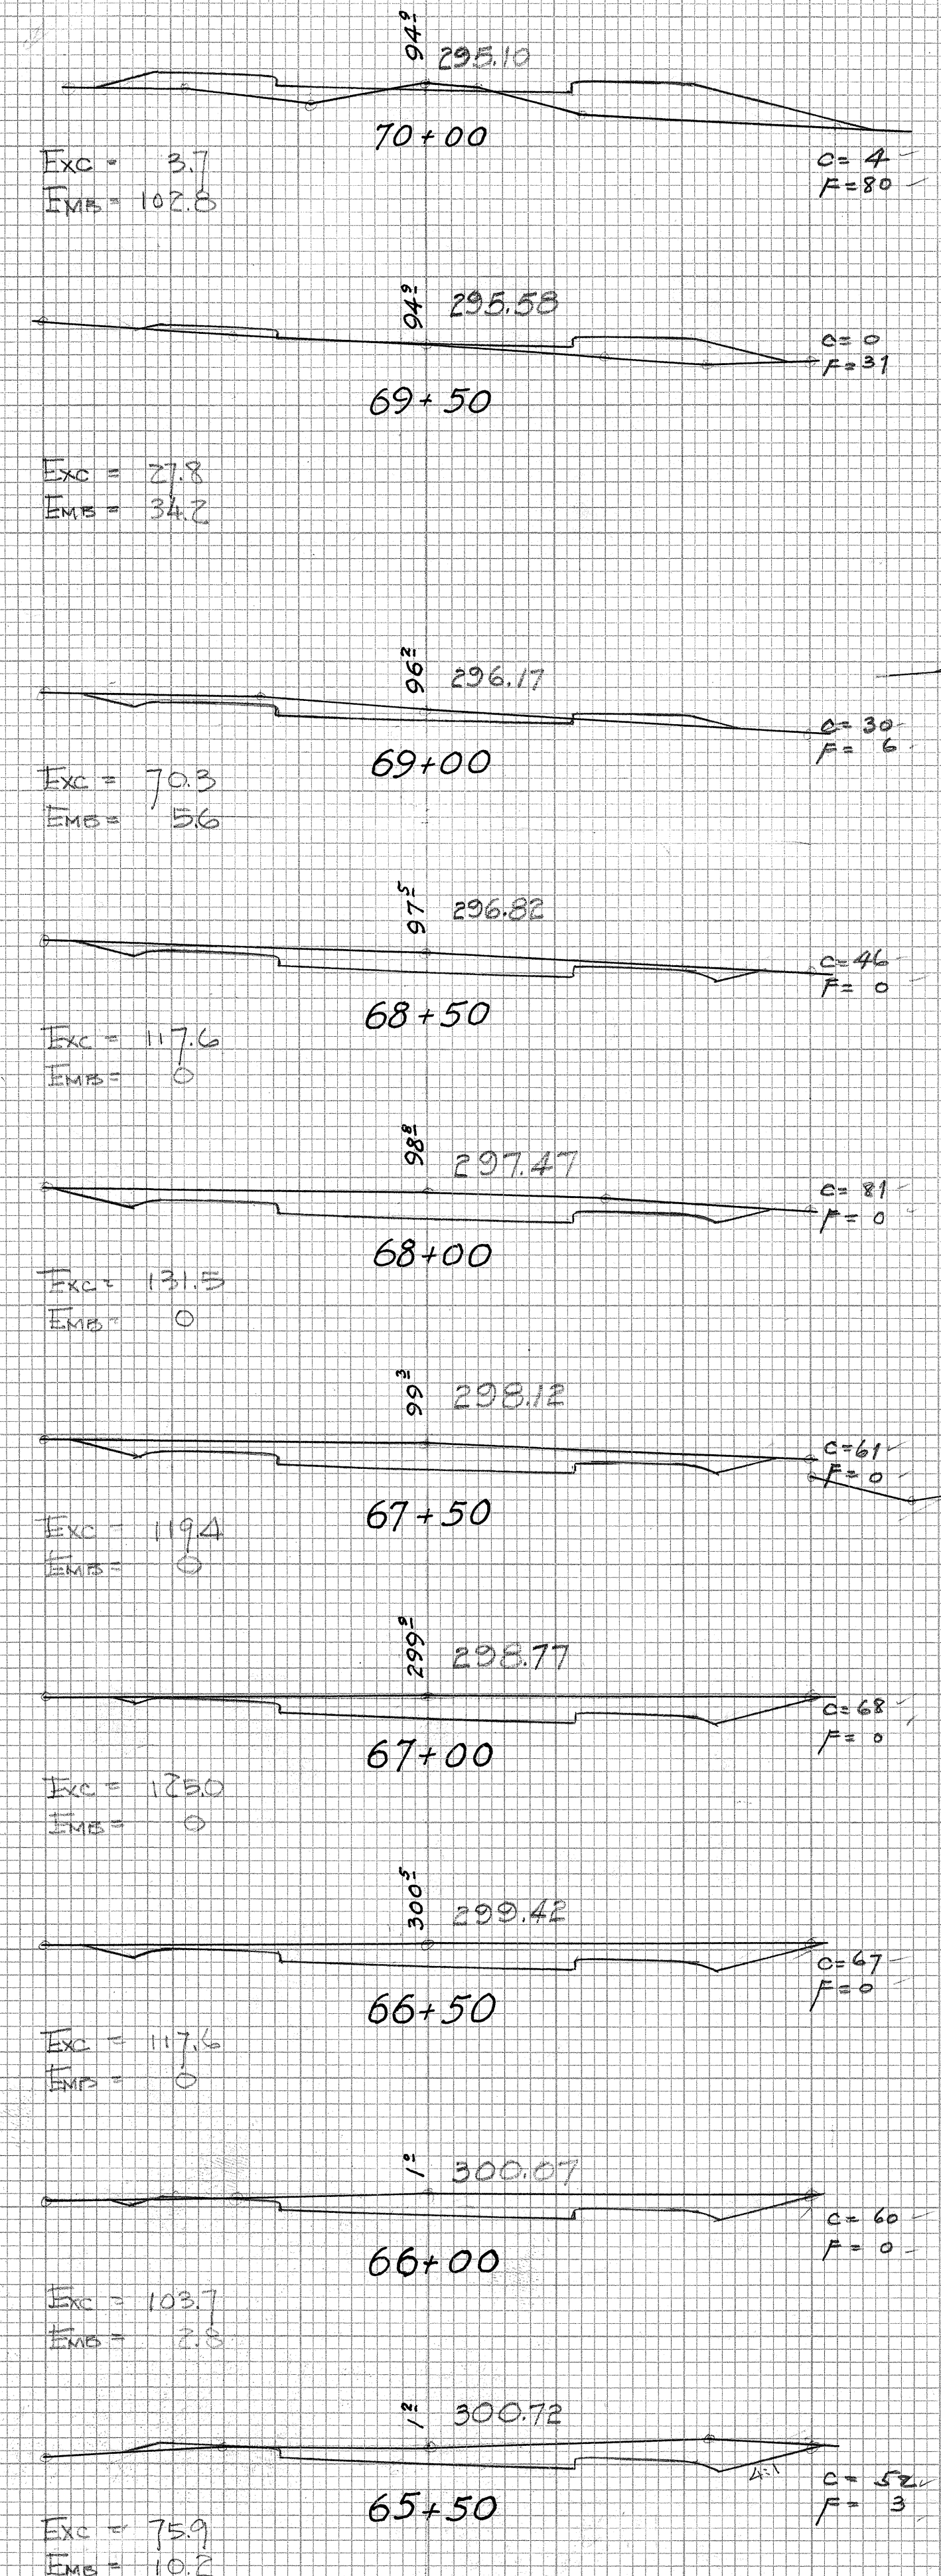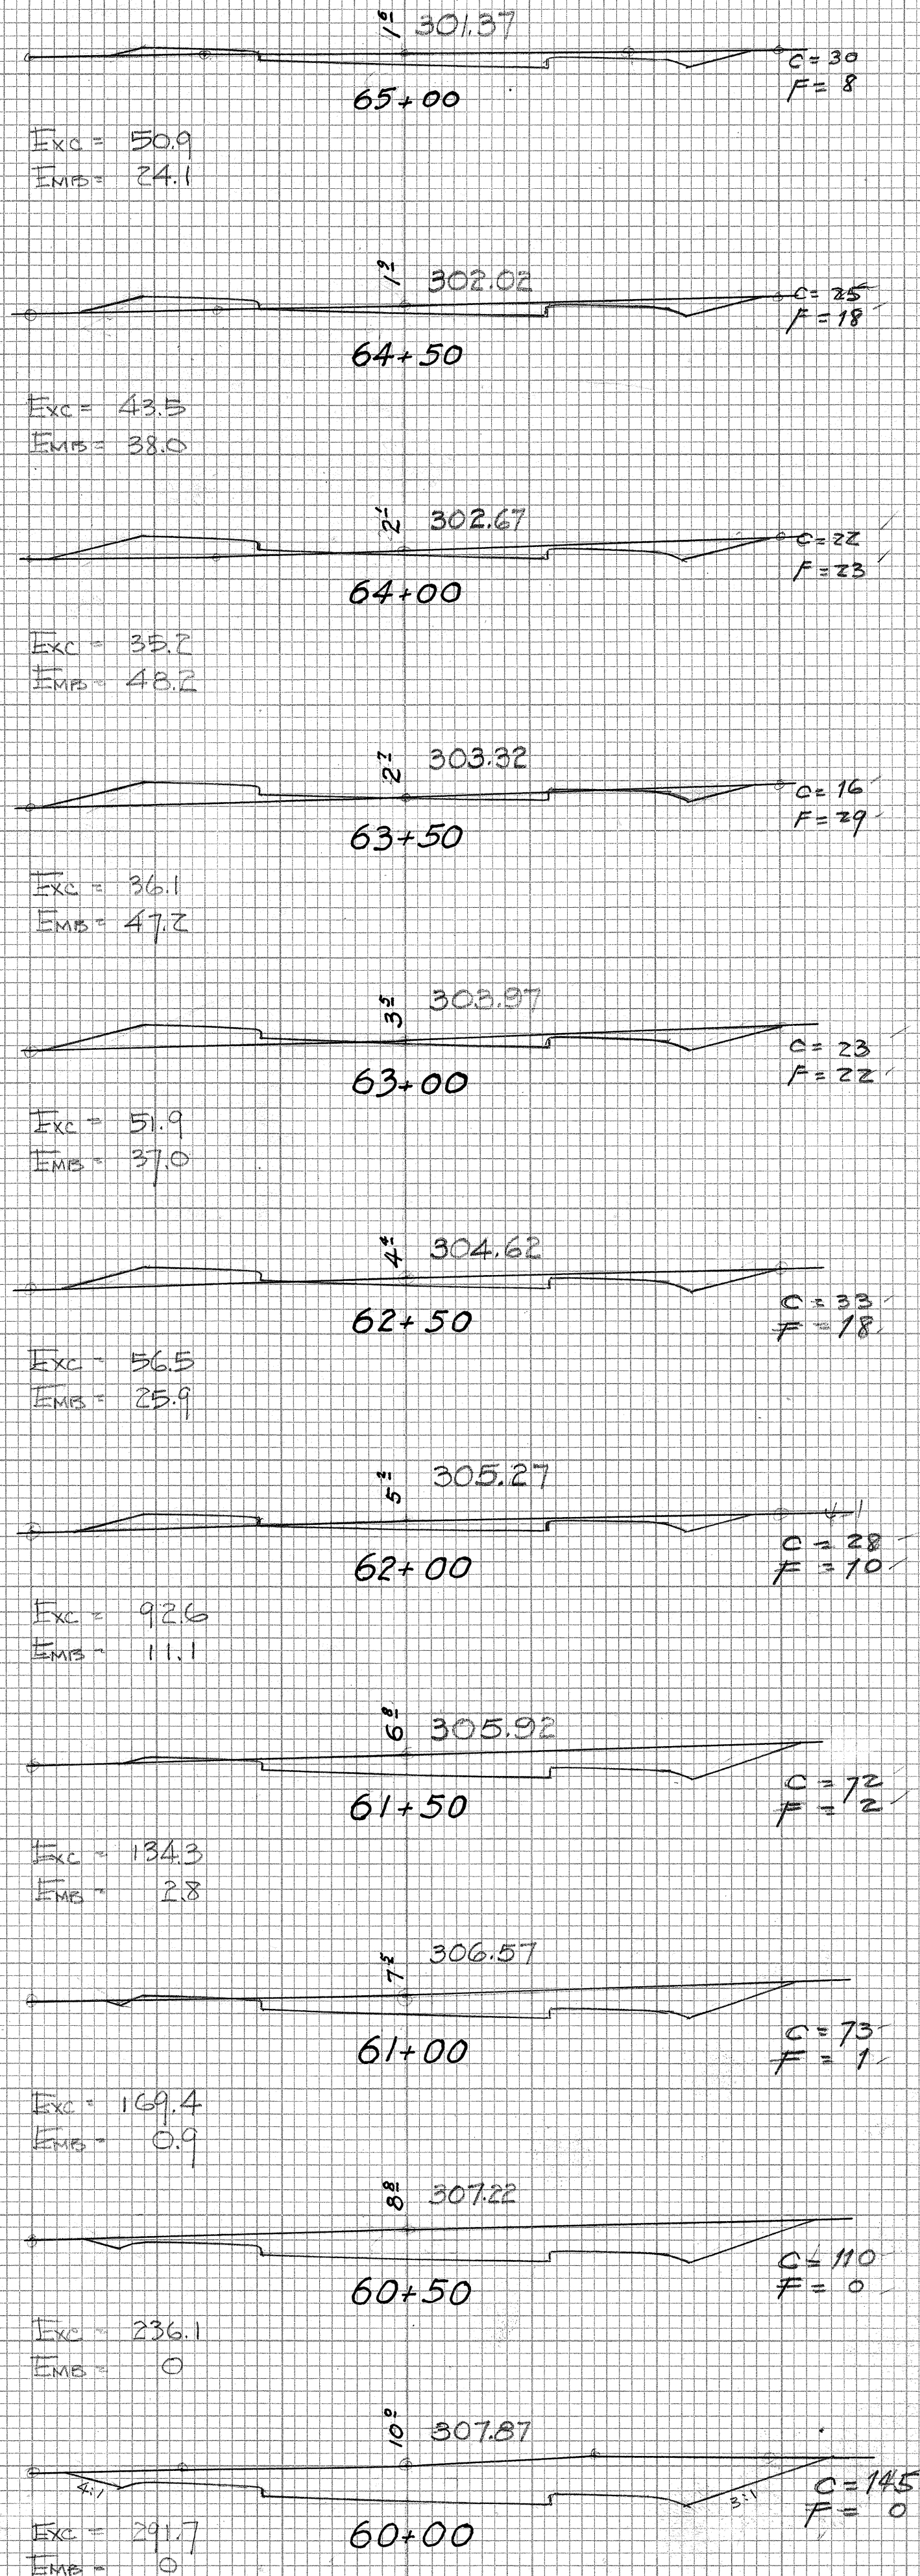

FINAL SURVEY PLOTTED
NOTE BOOK AREAS CHECKED

ORIGINAL SURVEY PLOTTED
NOTE BOOK AREAS CHECKED

FED. ROAD DIST. NO.	STATE	FED. AID PROJ. NO.	FISCAL YEAR	SHEET NO.	TOTAL SHEETS
Hawaii	Haw.	DW566	1944	16	16

