FED. ROAD DIST. NO.	STATE	FED. AID PROJ. NO.	FISCAL YEAR	SHEET NO.	TOTAL SHEETS
HAWAII	HAW.	S 21(1)	1947	1	76

INDEX TO DRAWINGS

SHEET NO.	DESCRIPTION
1	TITLE SHEET
2	TYPICAL SECTION
3-14	PLAN & PROFILE
15-16	STD. DETAILS
17	84" METAL CULVERT
18-76	CROSS SECTIONS

TERRITORY OF HAWAII
TERRITORIAL HIGHWAY DEPARTMENT
HONOLULU, T. H.

PLANS OF
MAUNALOA ROAD

FEDERAL AID SECONDARY PROJECT NO. S 21(1)

ISLAND OF MOLOKAI

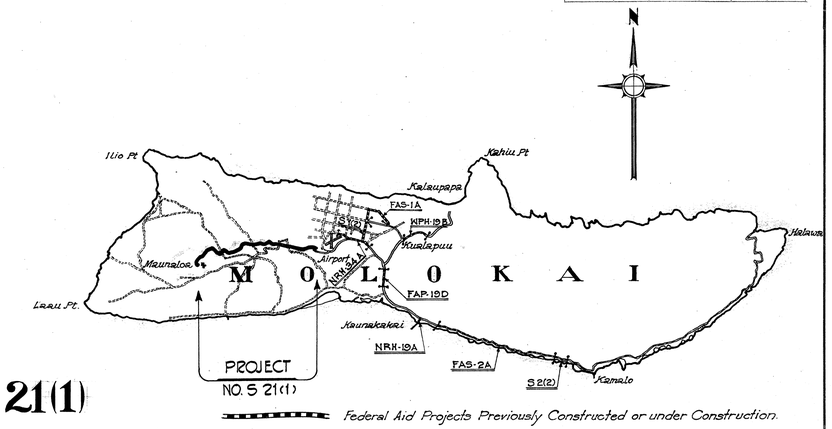

SCALE

PLAN		1" = 100 FT.
PROFILE	HOR.	1" = 100 FT.
	VERT.	1" = 10 FT.
CROSS SECTIONS	HOR.	1" = 10 FT.
	VERT.	1" = 10 FT.

CONVENTIONAL SIGNS USED

Boundary Lines, or
Box Culvert
Bridge
Centerline — 120
Centerline Monument — ℄ Mon.
Circular Culvert
Concrete Drop Intake
Electric Line Pole — P.P.
Existing Roadway
Fences (Noted), or
Fire Hydrant — F.H.
Railroad, or
Sewer Line — S_6 S_8 S_{10}
Sewer Manhole — S.M.H.
Standard Catch Basin
Standard Manhole — M.H.
Storm Drain — SD_{18} SD_{24} SD_{30}
Storm Drain Manhole — S.M.H.
Telephone Manhole — T.M.H.
Telephone Pole — T.P.
Tree (Large) or
Warning & Regulatory Signs — Type
Water Main — W_6 W_8 W_{10}
Water Valve — W.V.
Water Valve Manhole — W.V.M.

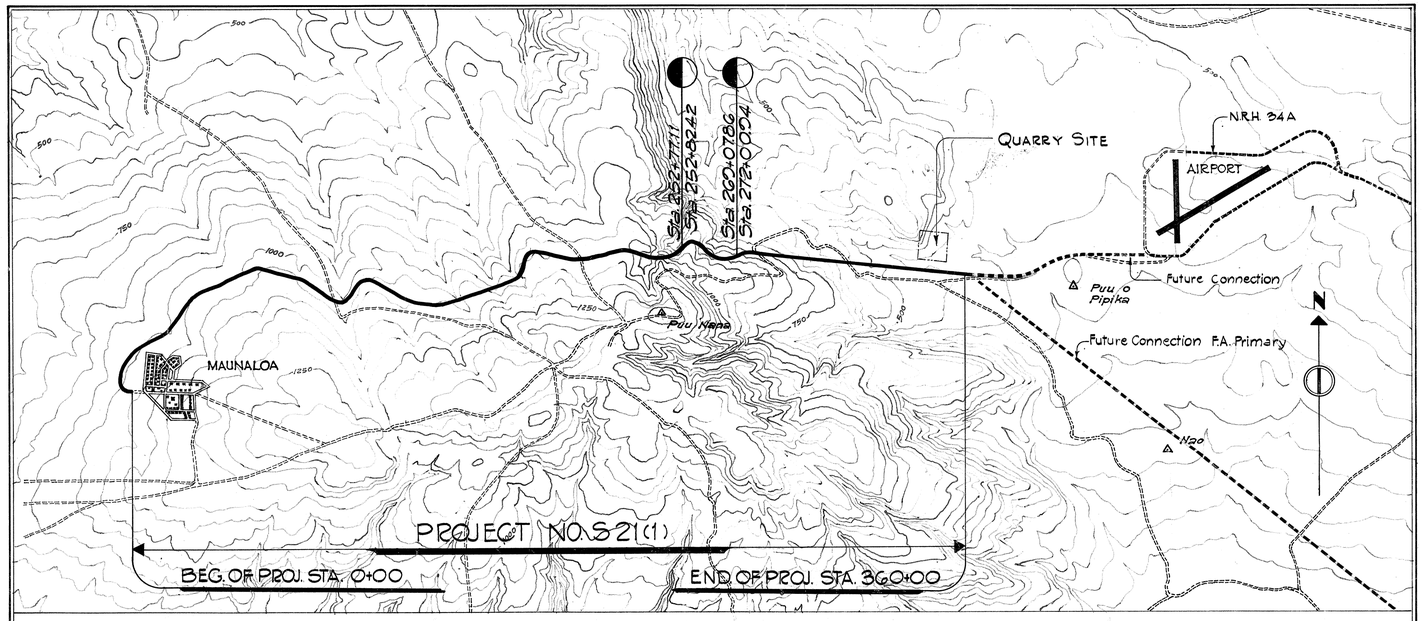

SCALE = 1 : 31,250

LAYOUT OF PROJECT

GROSS & NET LENGTH OF PROJECT = 6.762

Note: All changes made during construction have been noted in red on these tracings and checked by:

Resident Engineer
Date Feb. 27, 1950

ORIGINAL PLAN		DATE
	SURVEY PLOTTED BY	
	DRAWN BY	"
	TRACED BY	"
NOTE BOOK	QUANTITIES BY	"
	QUANTITIES CHECKED BY	"
No.	CHECKED BY	"

RECOMMENDED FOR APPROVAL: DATE [redacted]

DISTRICT ENGINEER
PUBLIC ROADS ADMINISTRATION
FEDERAL WORKS AGENCY

APPROVED: DATE JAN. 12, 1948

TERRITORIAL HIGHWAY ENGINEER

APPROVED: DATE [redacted]

DIVISION ENGINEER
PUBLIC ROADS ADMINISTRATION
FEDERAL WORKS AGENCY

DD-K-9

5288.1

NO. 166 ARMWRIGHT TRACING CLOTH
K & E CO., N. Y.