FED. ROAD DIST. NO.	STATE	FED. AID PROJ. NO.	FISCAL YEAR	SHEET NO.	TOTAL SHEETS
Hawaii	HAW	F046(1)	1955	1	32

INDEX TO DRAWINGS	
SHEET NO.	DESCRIPTION
1	TITLE SHEET
2	TYPICAL SECTION
3-9	PLAN & PROFILE
10-14	STANDARD DETAILS
15-17	BOX CULVERT DETAILS
18-32	CROSS SECTIONS

CONVENTIONAL SIGNS USED

Boundary Lines
Bridge
Centerline — 35
Centerline Monument — ℄ Mon.
Circular Pipe Culvert
Electric Pole — EP
Existing Road
Fences
Telephone Pole — TP
Warning & Regulatory Signs — W-1 R-1 (Type)

TERRITORY OF HAWAII
TERRITORIAL HIGHWAY DEPARTMENT
HONOLULU, T.H.

PLANS OF
MOLOKAI AIRPORT ROAD
FEDERAL AID PROJECT NO. F 046 (1)

DISTRICT OF MOLOKAI
COUNTY OF MAUI
ISLAND OF MOLOKAI

SCALES

PLAN		1 IN. = 100 FT.
PROFILE	HOR.	1 IN. = 100 FT.
	VER.	1 IN. = 10 FT.
CROSS SECTION	HOR.	1 IN. = 10 FT.
	VER.	1 IN. = 10 FT.

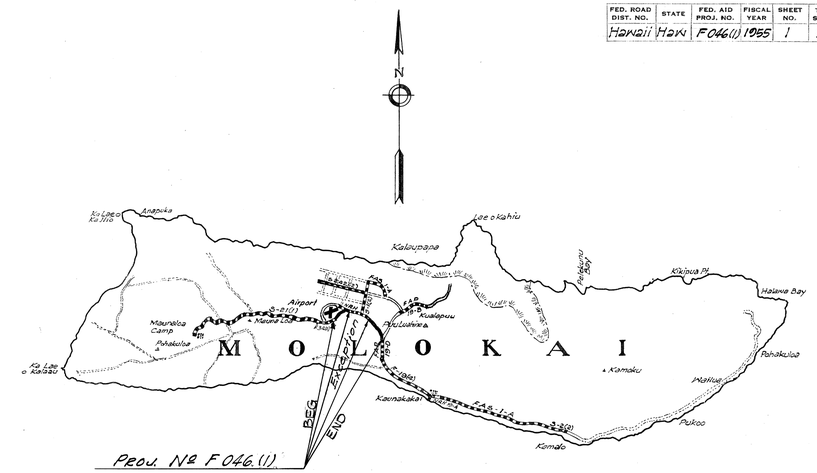

LOCATION MAP
FEDERAL AID PROJECTS PREVIOUSLY CONSTRUCTED OR UNDER CONSTRUCTION

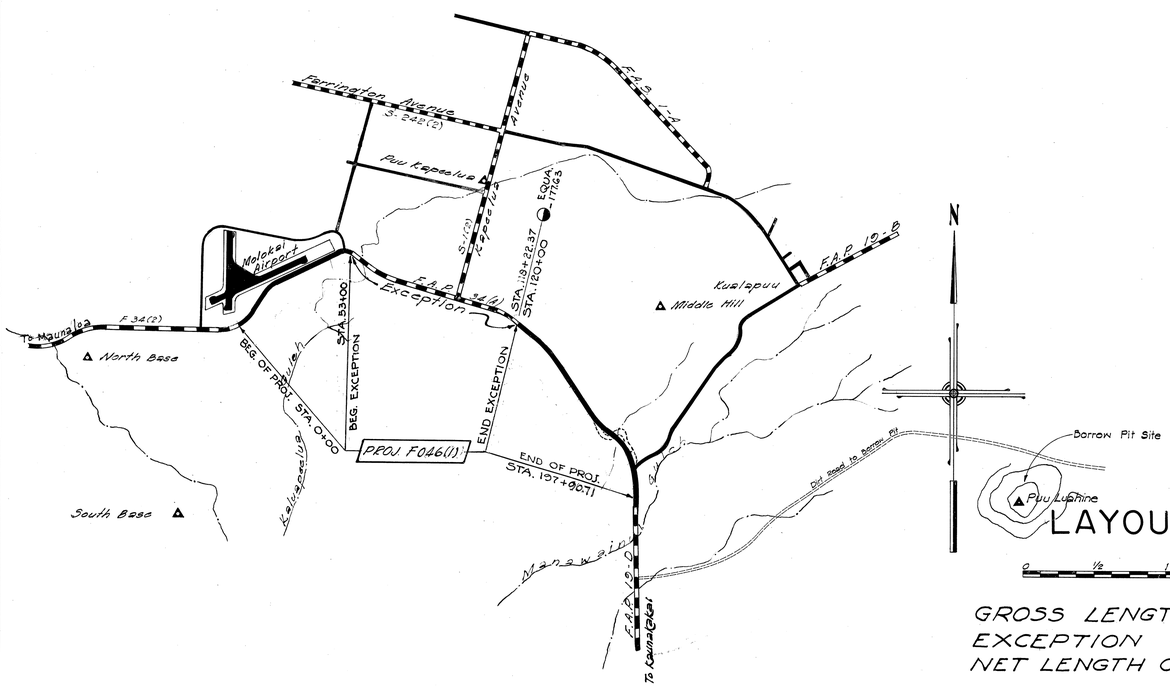

LAYOUT OF PROJECT
Scale: 1" = 2640'

GROSS LENGTH = 3.714 MILES
EXCEPTION = 1.235 "
NET LENGTH OF PROJECT = 2.479 MILES

NOTE:
ALL CHANGES MADE DURING CONSTRUCTION HAVE BEEN NOTED IN RED ON THESE TRACINGS AND CHECKED BY

DISTRICT ENGINEER
9-16-55
DATE

APPROVED: DATE 8/10/54
TERRITORIAL HIGHWAY ENGINEER

DEPARTMENT OF COMMERCE
BUREAU OF PUBLIC ROADS
APPROVED:
DISTRICT ENGINEER — DATE

ORIGINAL PLAN	
SURVEY PLOTTED BY	DATE
DESIGNED BY	"
DRAWN BY	"
TRACED BY	"
QUANTITIES BY	"
QUANTITIES CHECKED BY	"
CHECKED BY	"
NOTE BOOK No.	

5712.1