


FED. ROAD DIST. NO.	STATE	PROJ. NO.	FISCAL YEAR	SHEET NO.	TOTAL SHEETS
HAWAII	HAW.	460A-01-70	1970	2	7

FINAL SURVEY	NO.	DATE
SURVEYED		
PLOTTED		
CHECKED		
AREAS CHECKED		

ORIGINAL SURVEY	NO.	DATE
SURVEYED		
PLOTTED		
CHECKED		
AREAS CHECKED		


ESTIMATED QUANTITY
EXCAVATION = 54,000 c.y.

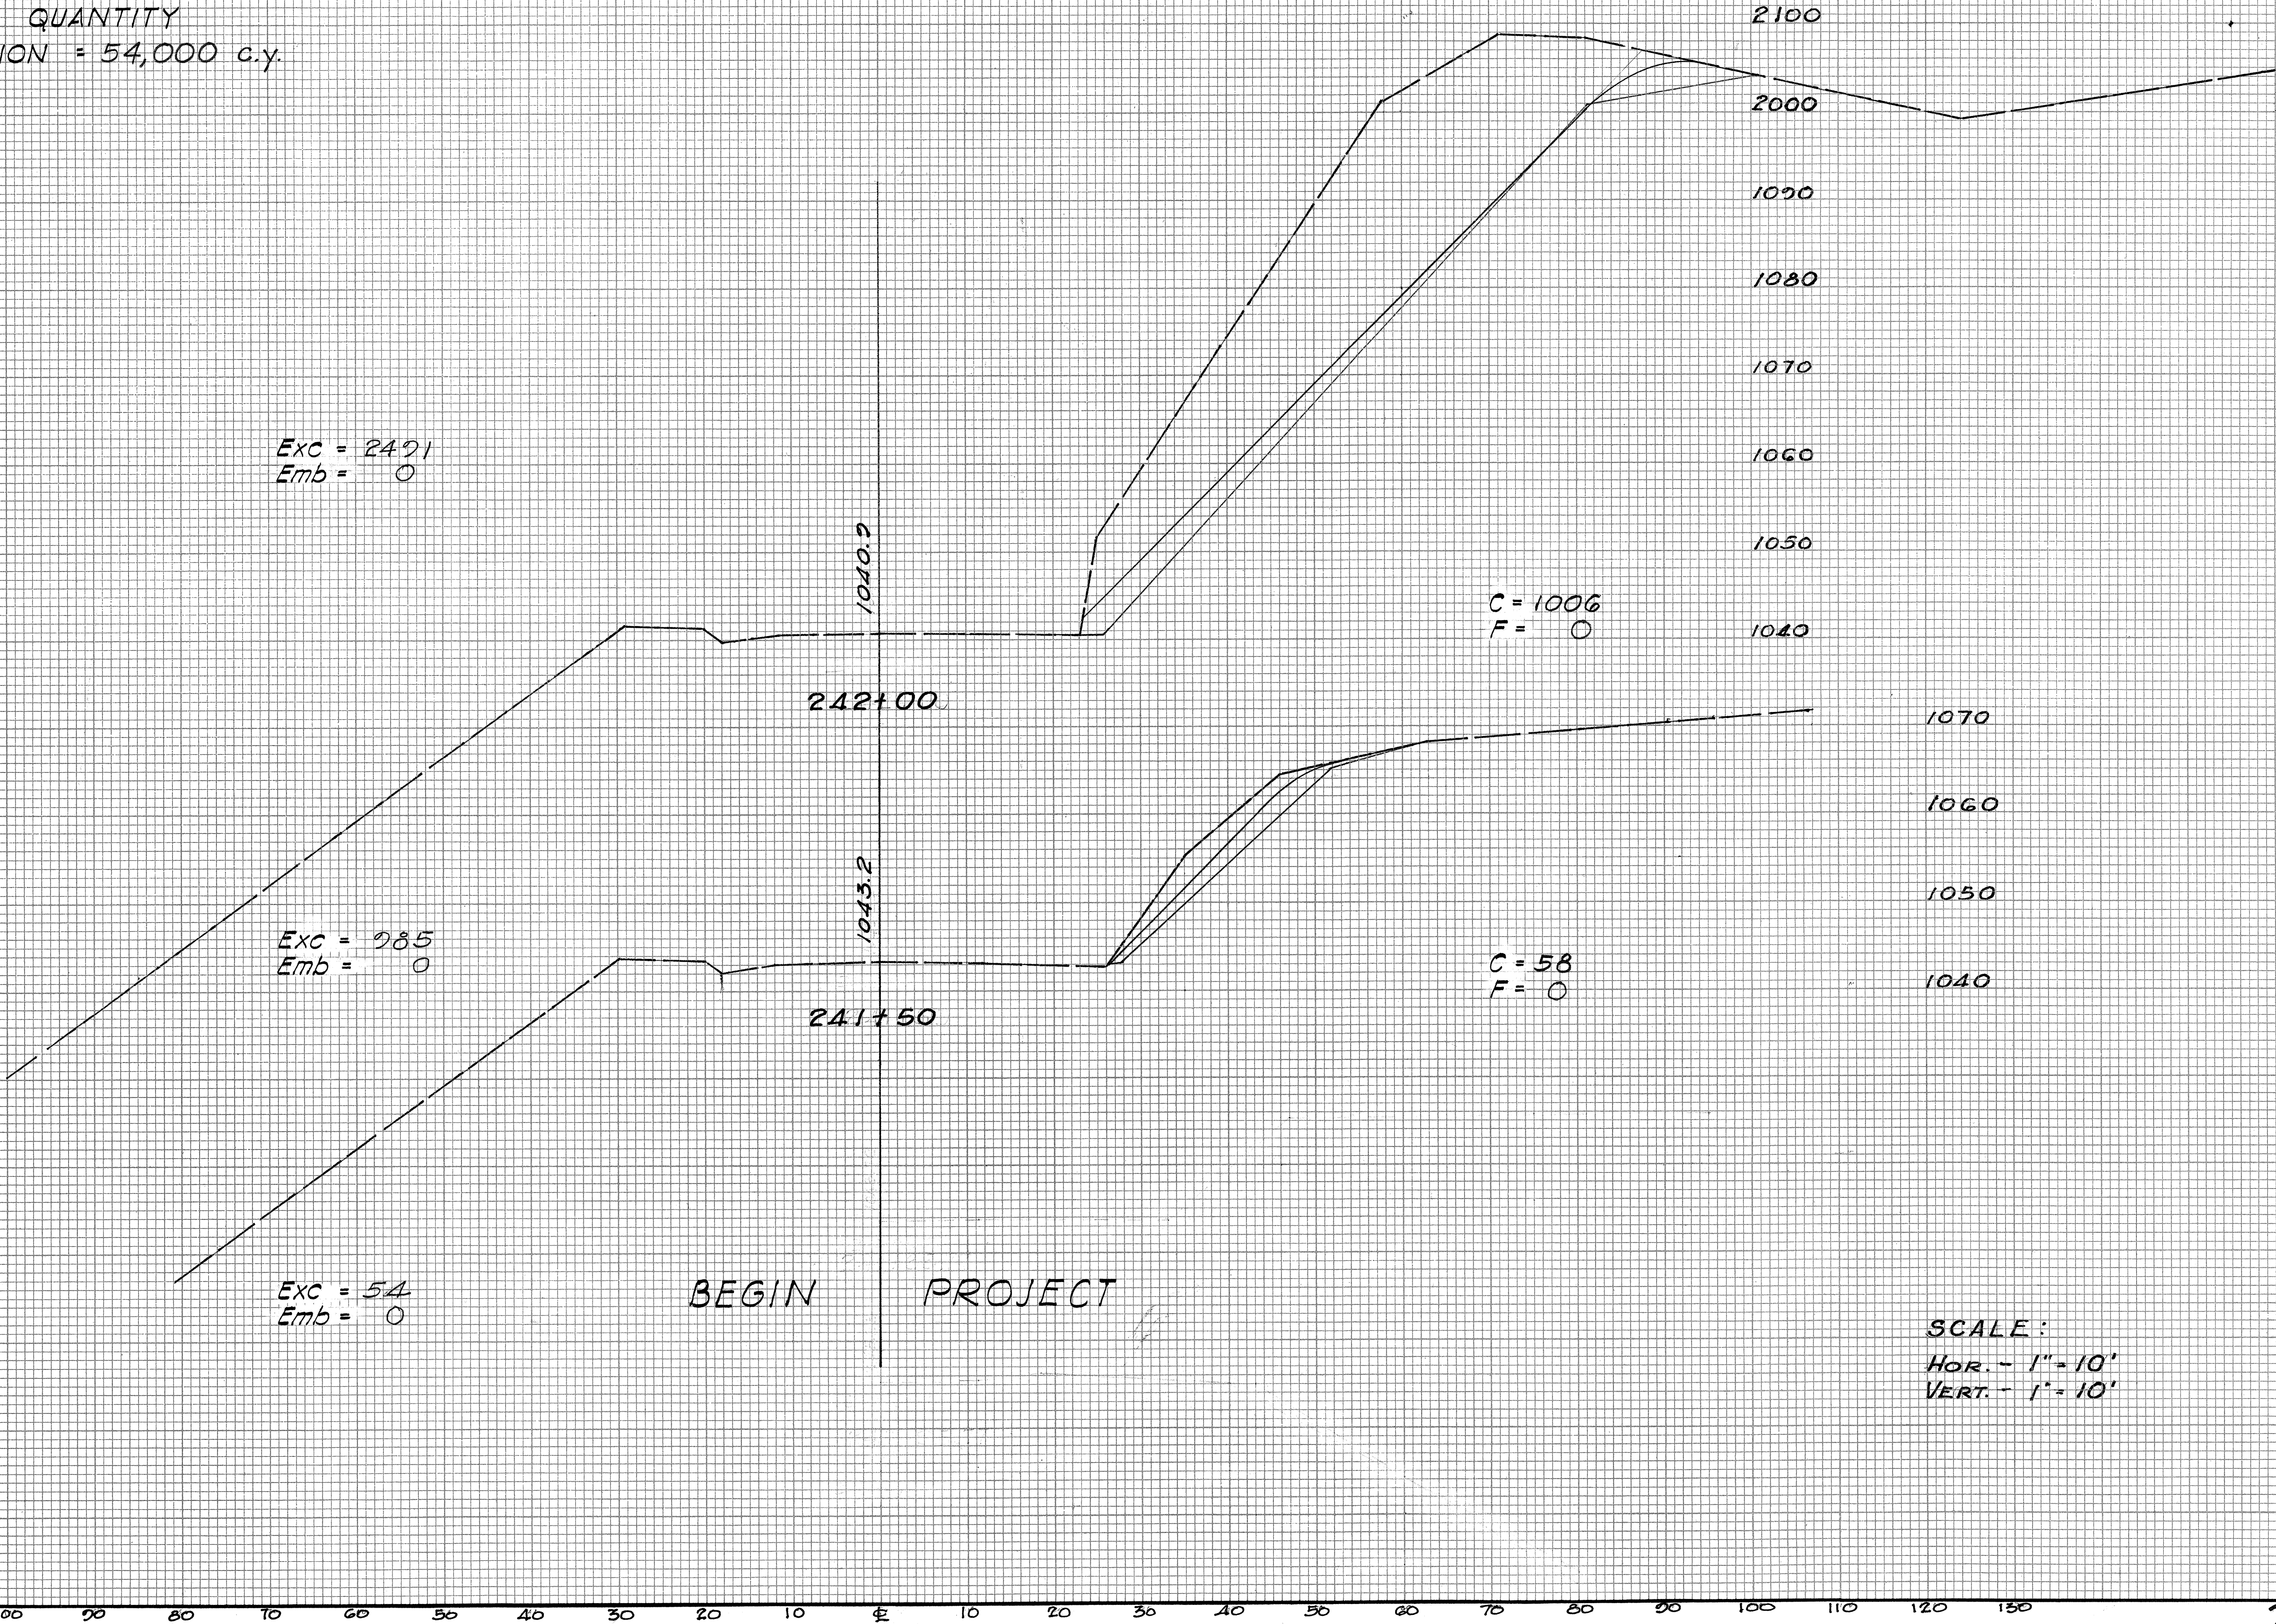

FED. ROAD DIST. NO.	STATE	PROJ. NO.	FISCAL YEAR	SHEET NO.	TOTAL SHEETS
HAWAII	HAW.	460A-01-70	1970	3	7

FINAL SURVEY	SURVEYED	BY	DATE
NOTE BOOK NO.	PLOTTED		
	APPROVED		
	AREAS CHECKED		

ORIGINAL SURVEY	SURVEYED	BY	DATE
NOTE BOOK NO.	PLOTTED	PSKUGW2	5-11-70
	APPROVED		
	AREAS CHECKED		

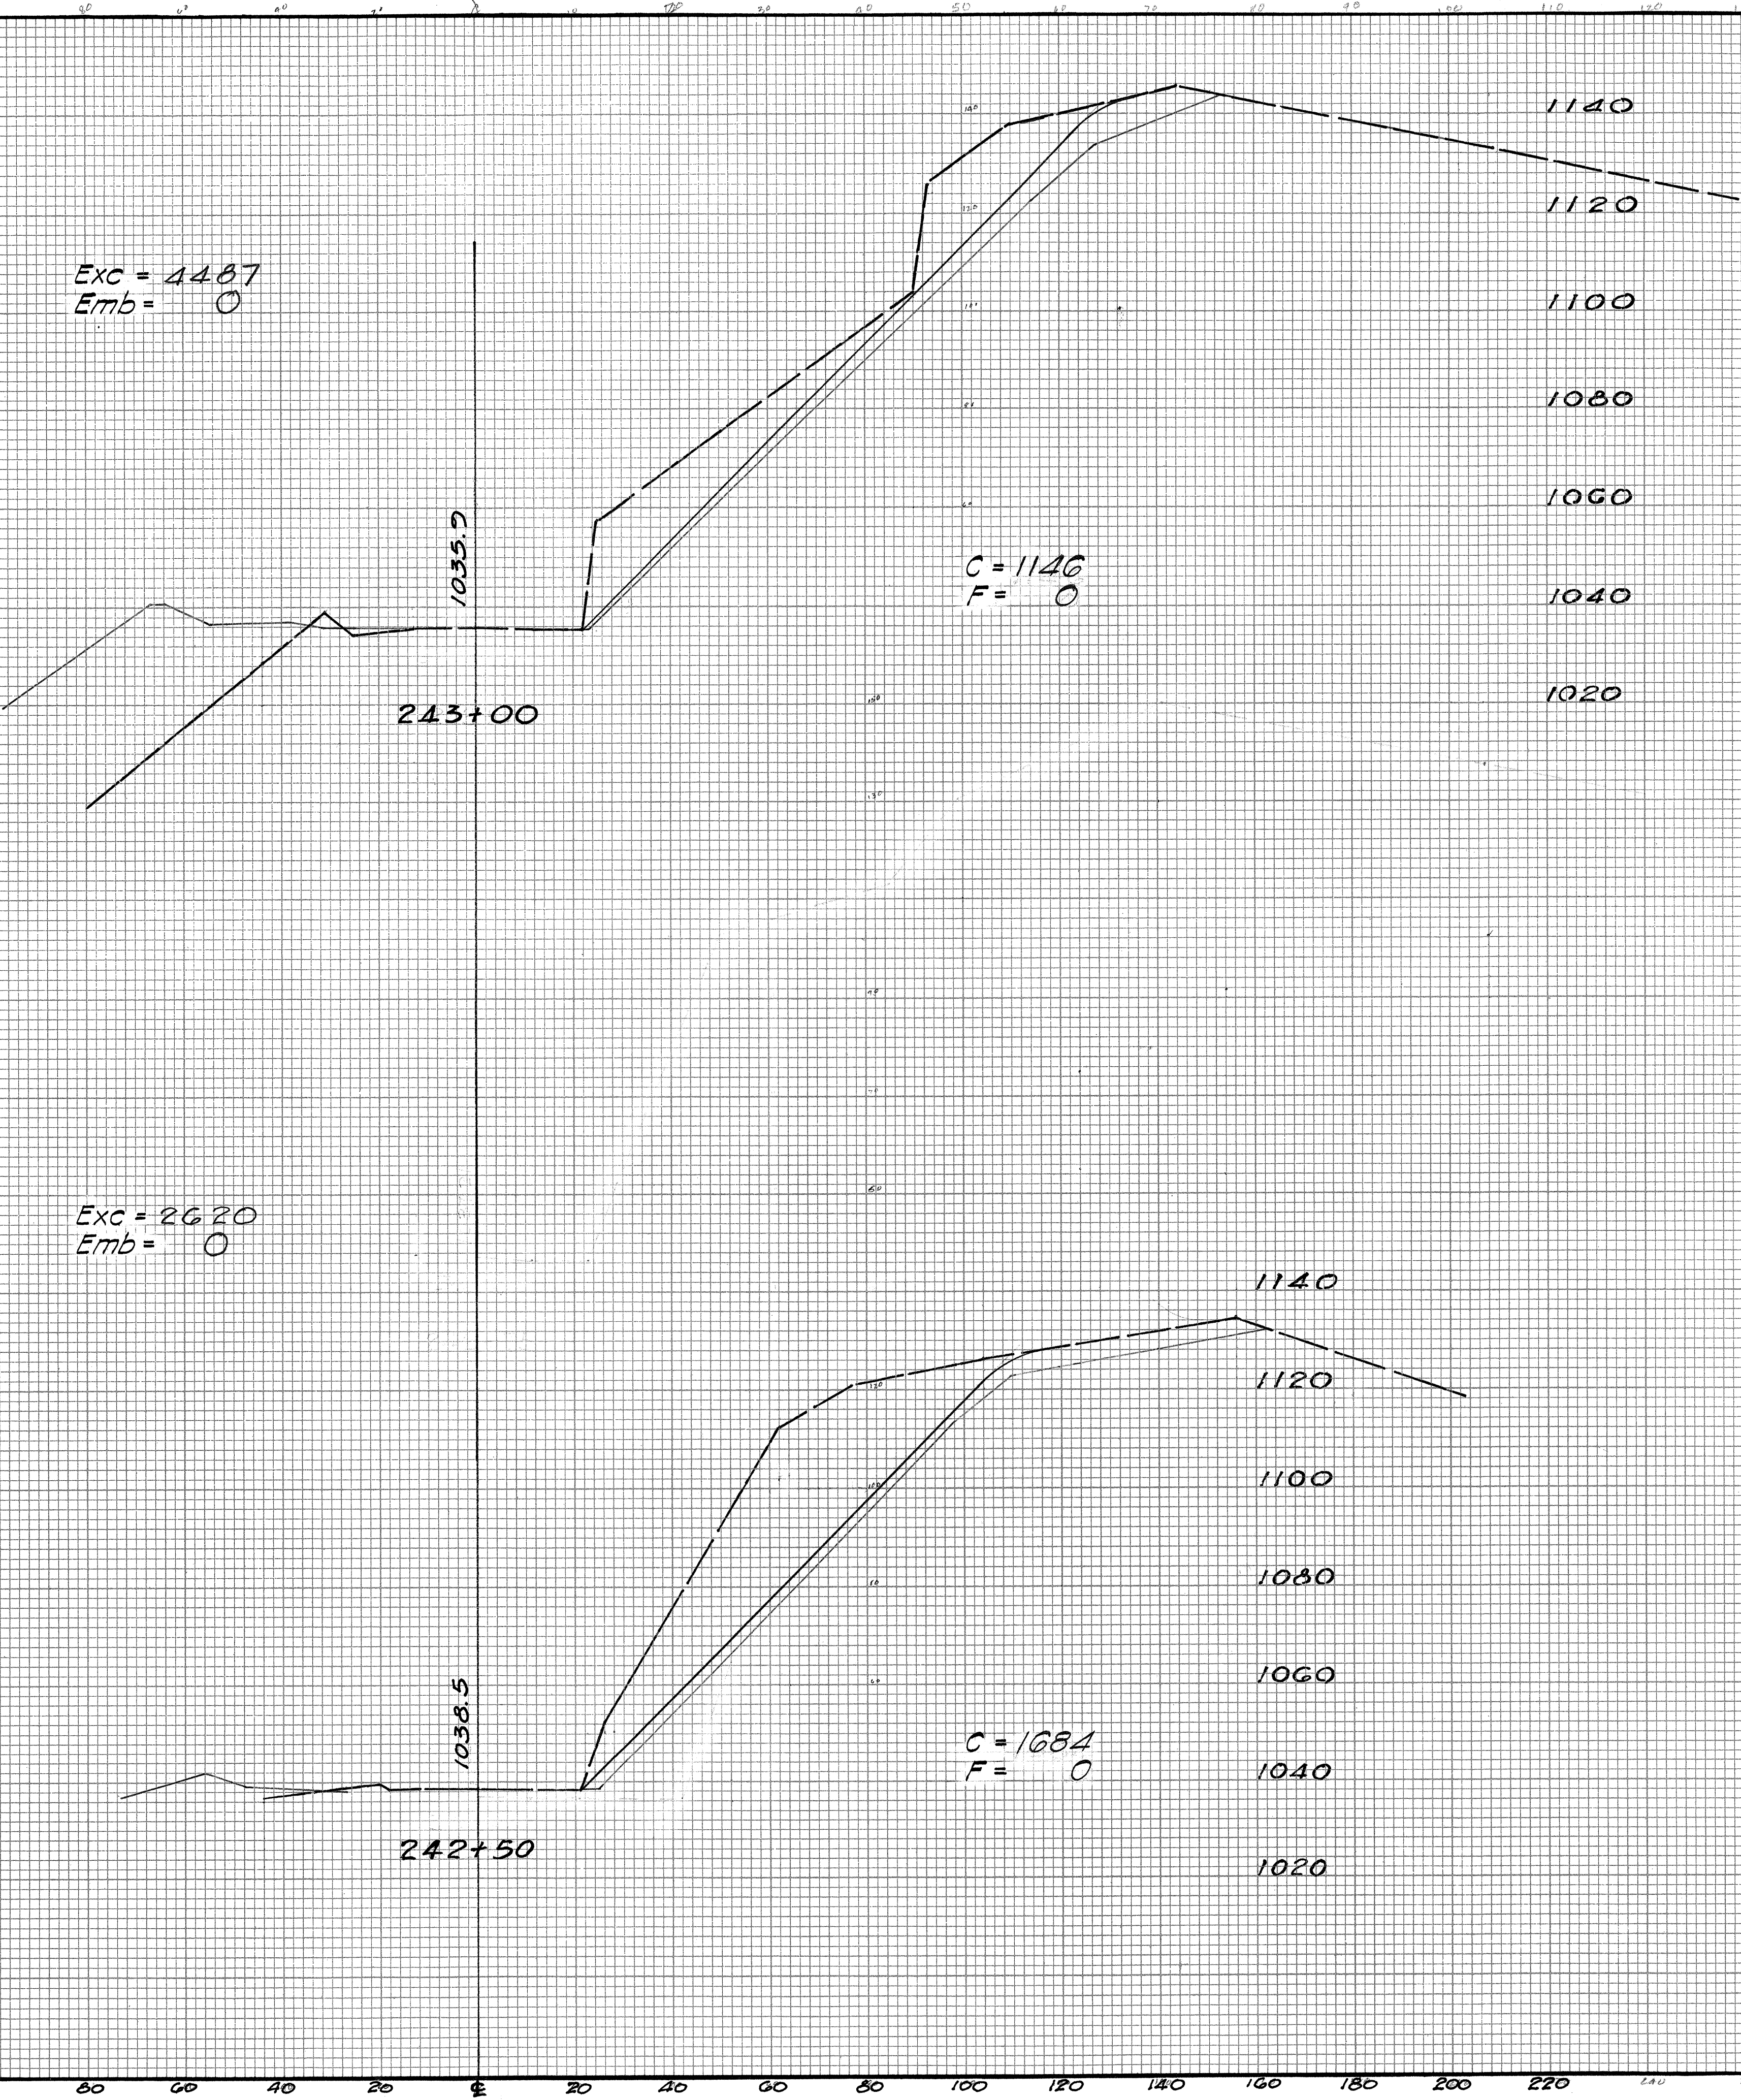


SCALE
HOR. - 1" = 20'
VERT. - 1" = 20'

FED. ROAD DIST. NO.	STATE	PROJ. NO.	FISCAL YEAR	SHEET NO.	TOTAL SHEETS
HAWAII	HAW.	460A-01-70	1970	4	7

FINAL SURVEY	BY	DATE
NO.		


ORIGINAL SURVEY	BY	DATE
NO.		

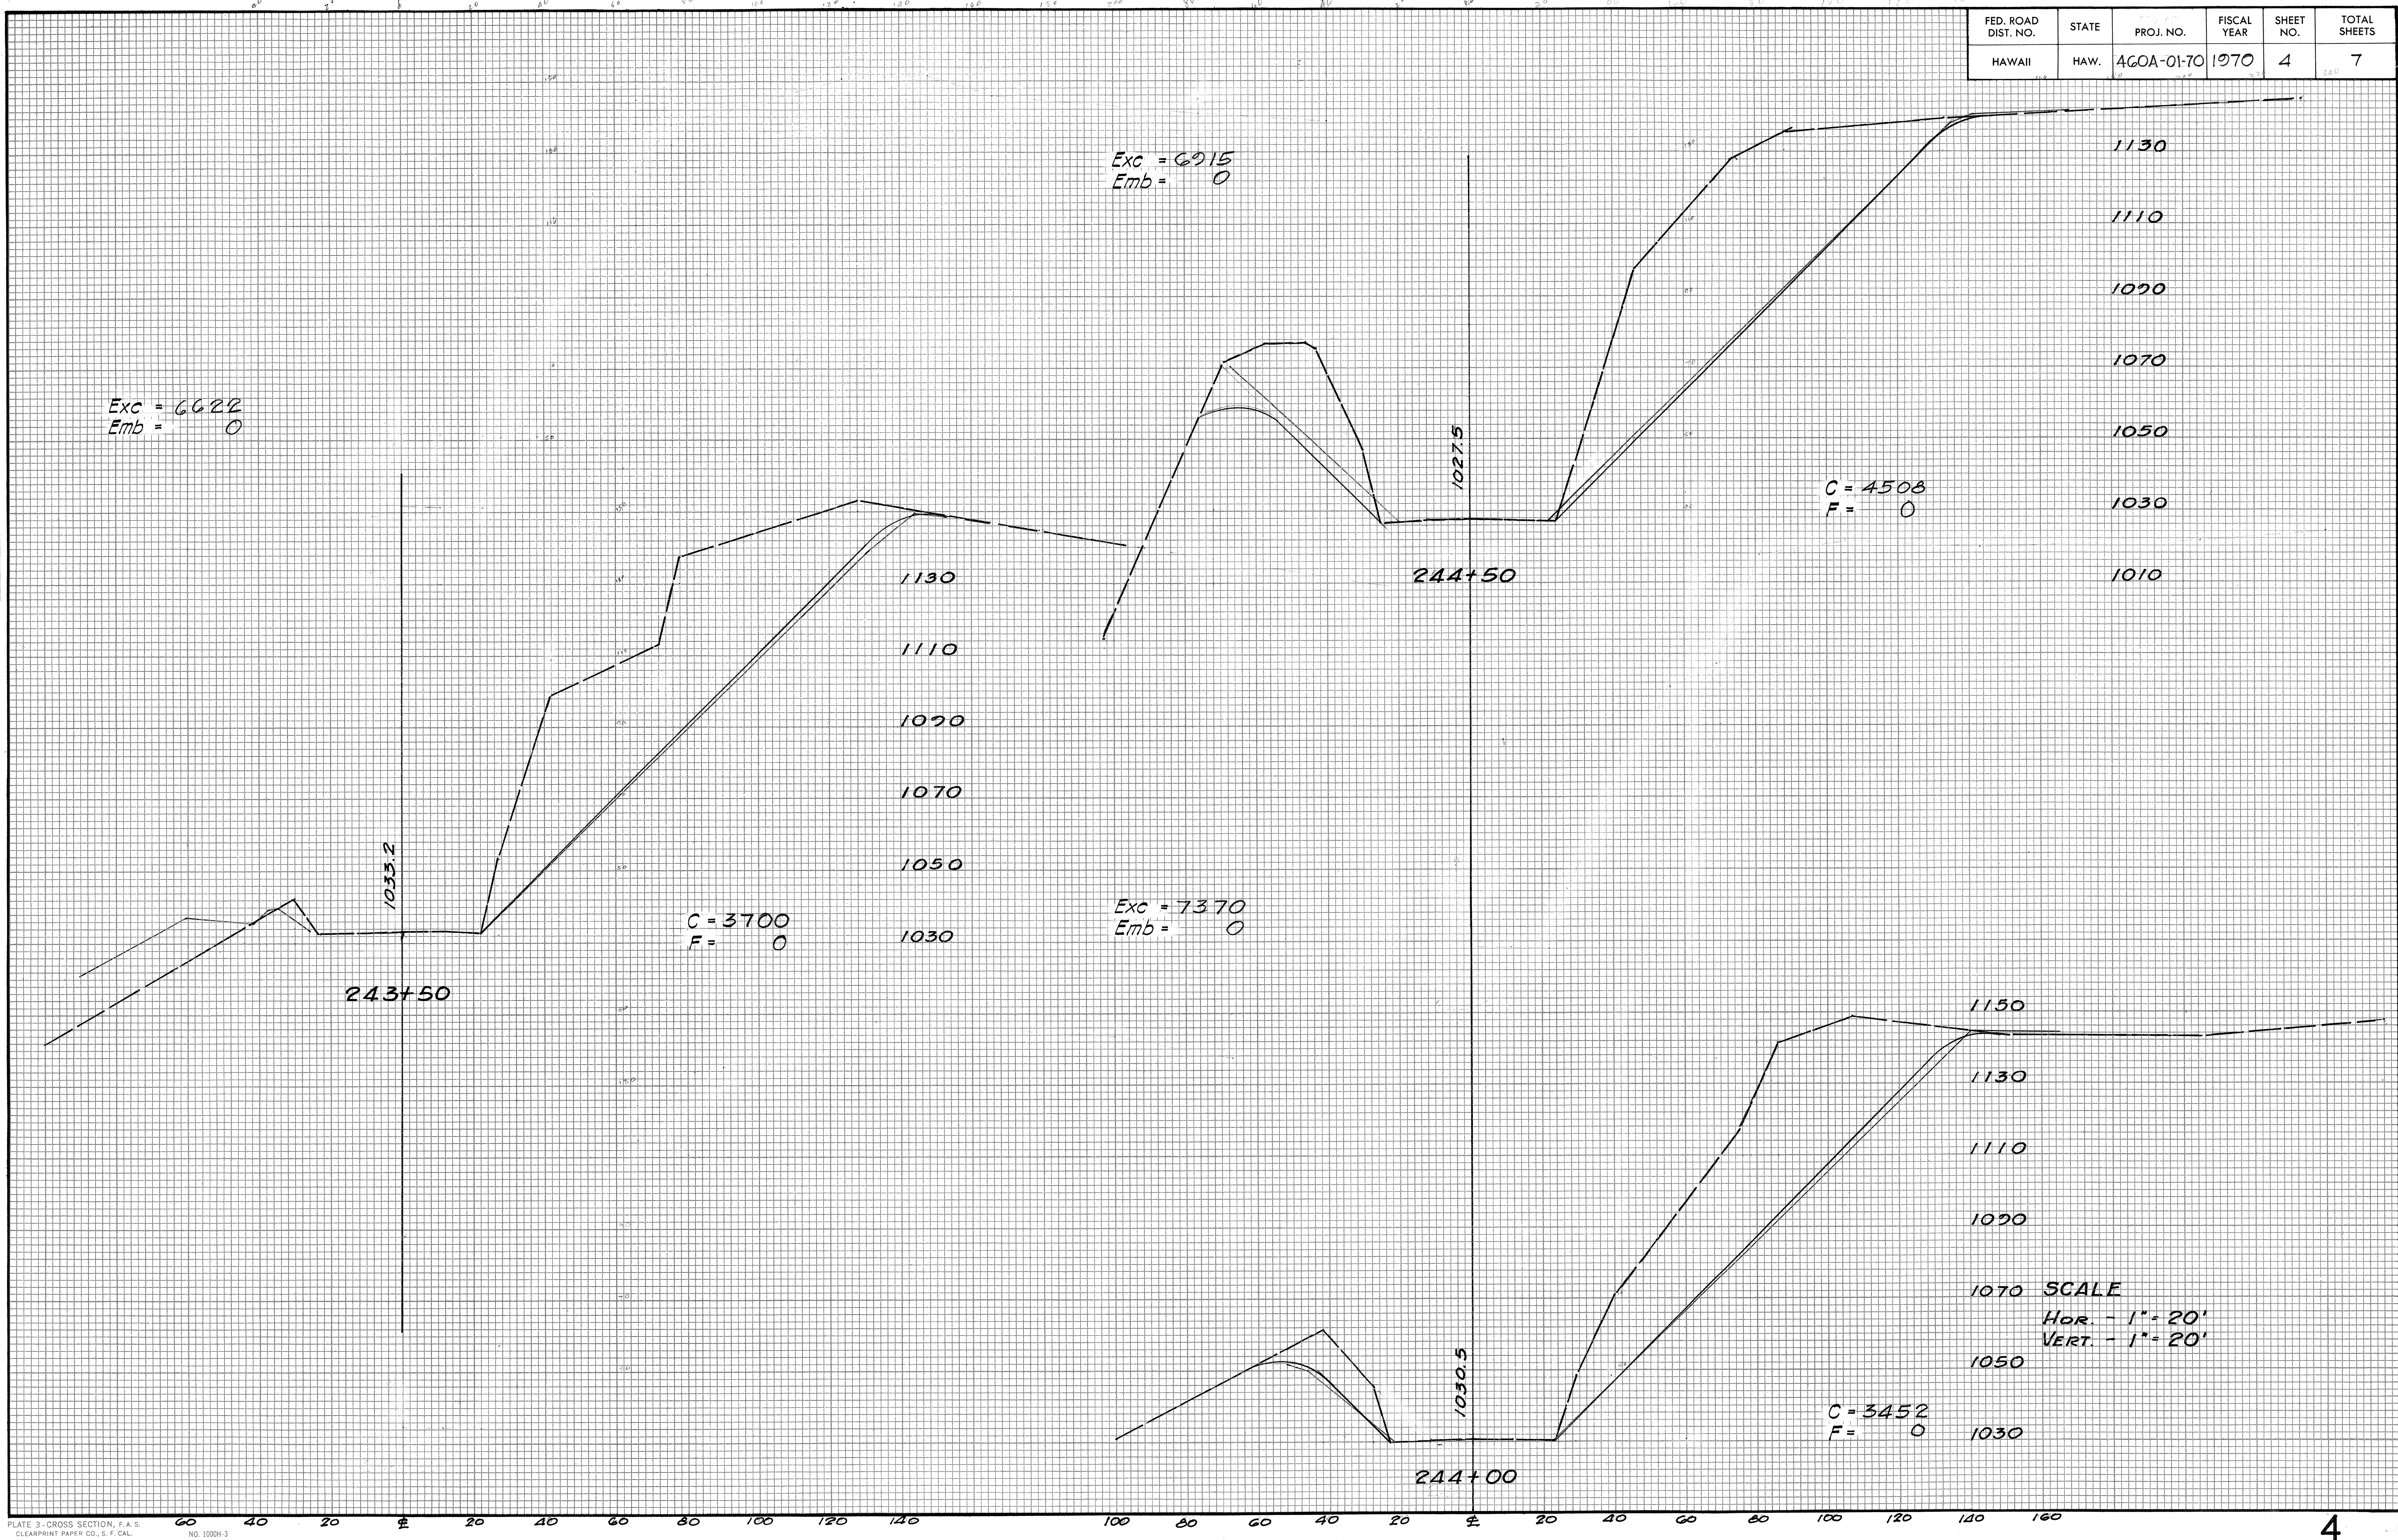

FED. ROAD DIST. NO.	STATE	PROJ. NO.	FISCAL YEAR	SHEET NO.	TOTAL SHEETS
HAWAII	HAW.	460A-01-70	1970	5	7

FINAL SURVEY NOTE BOOK NO.	SURVEYED PLOTTED TEMPLATE AREAS CHECKED	DATE
		BY


ORIGINAL SURVEY NOTE BOOK NO.	SURVEYED PLOTTED TEMPLATE AREAS CHECKED	DATE
		BY

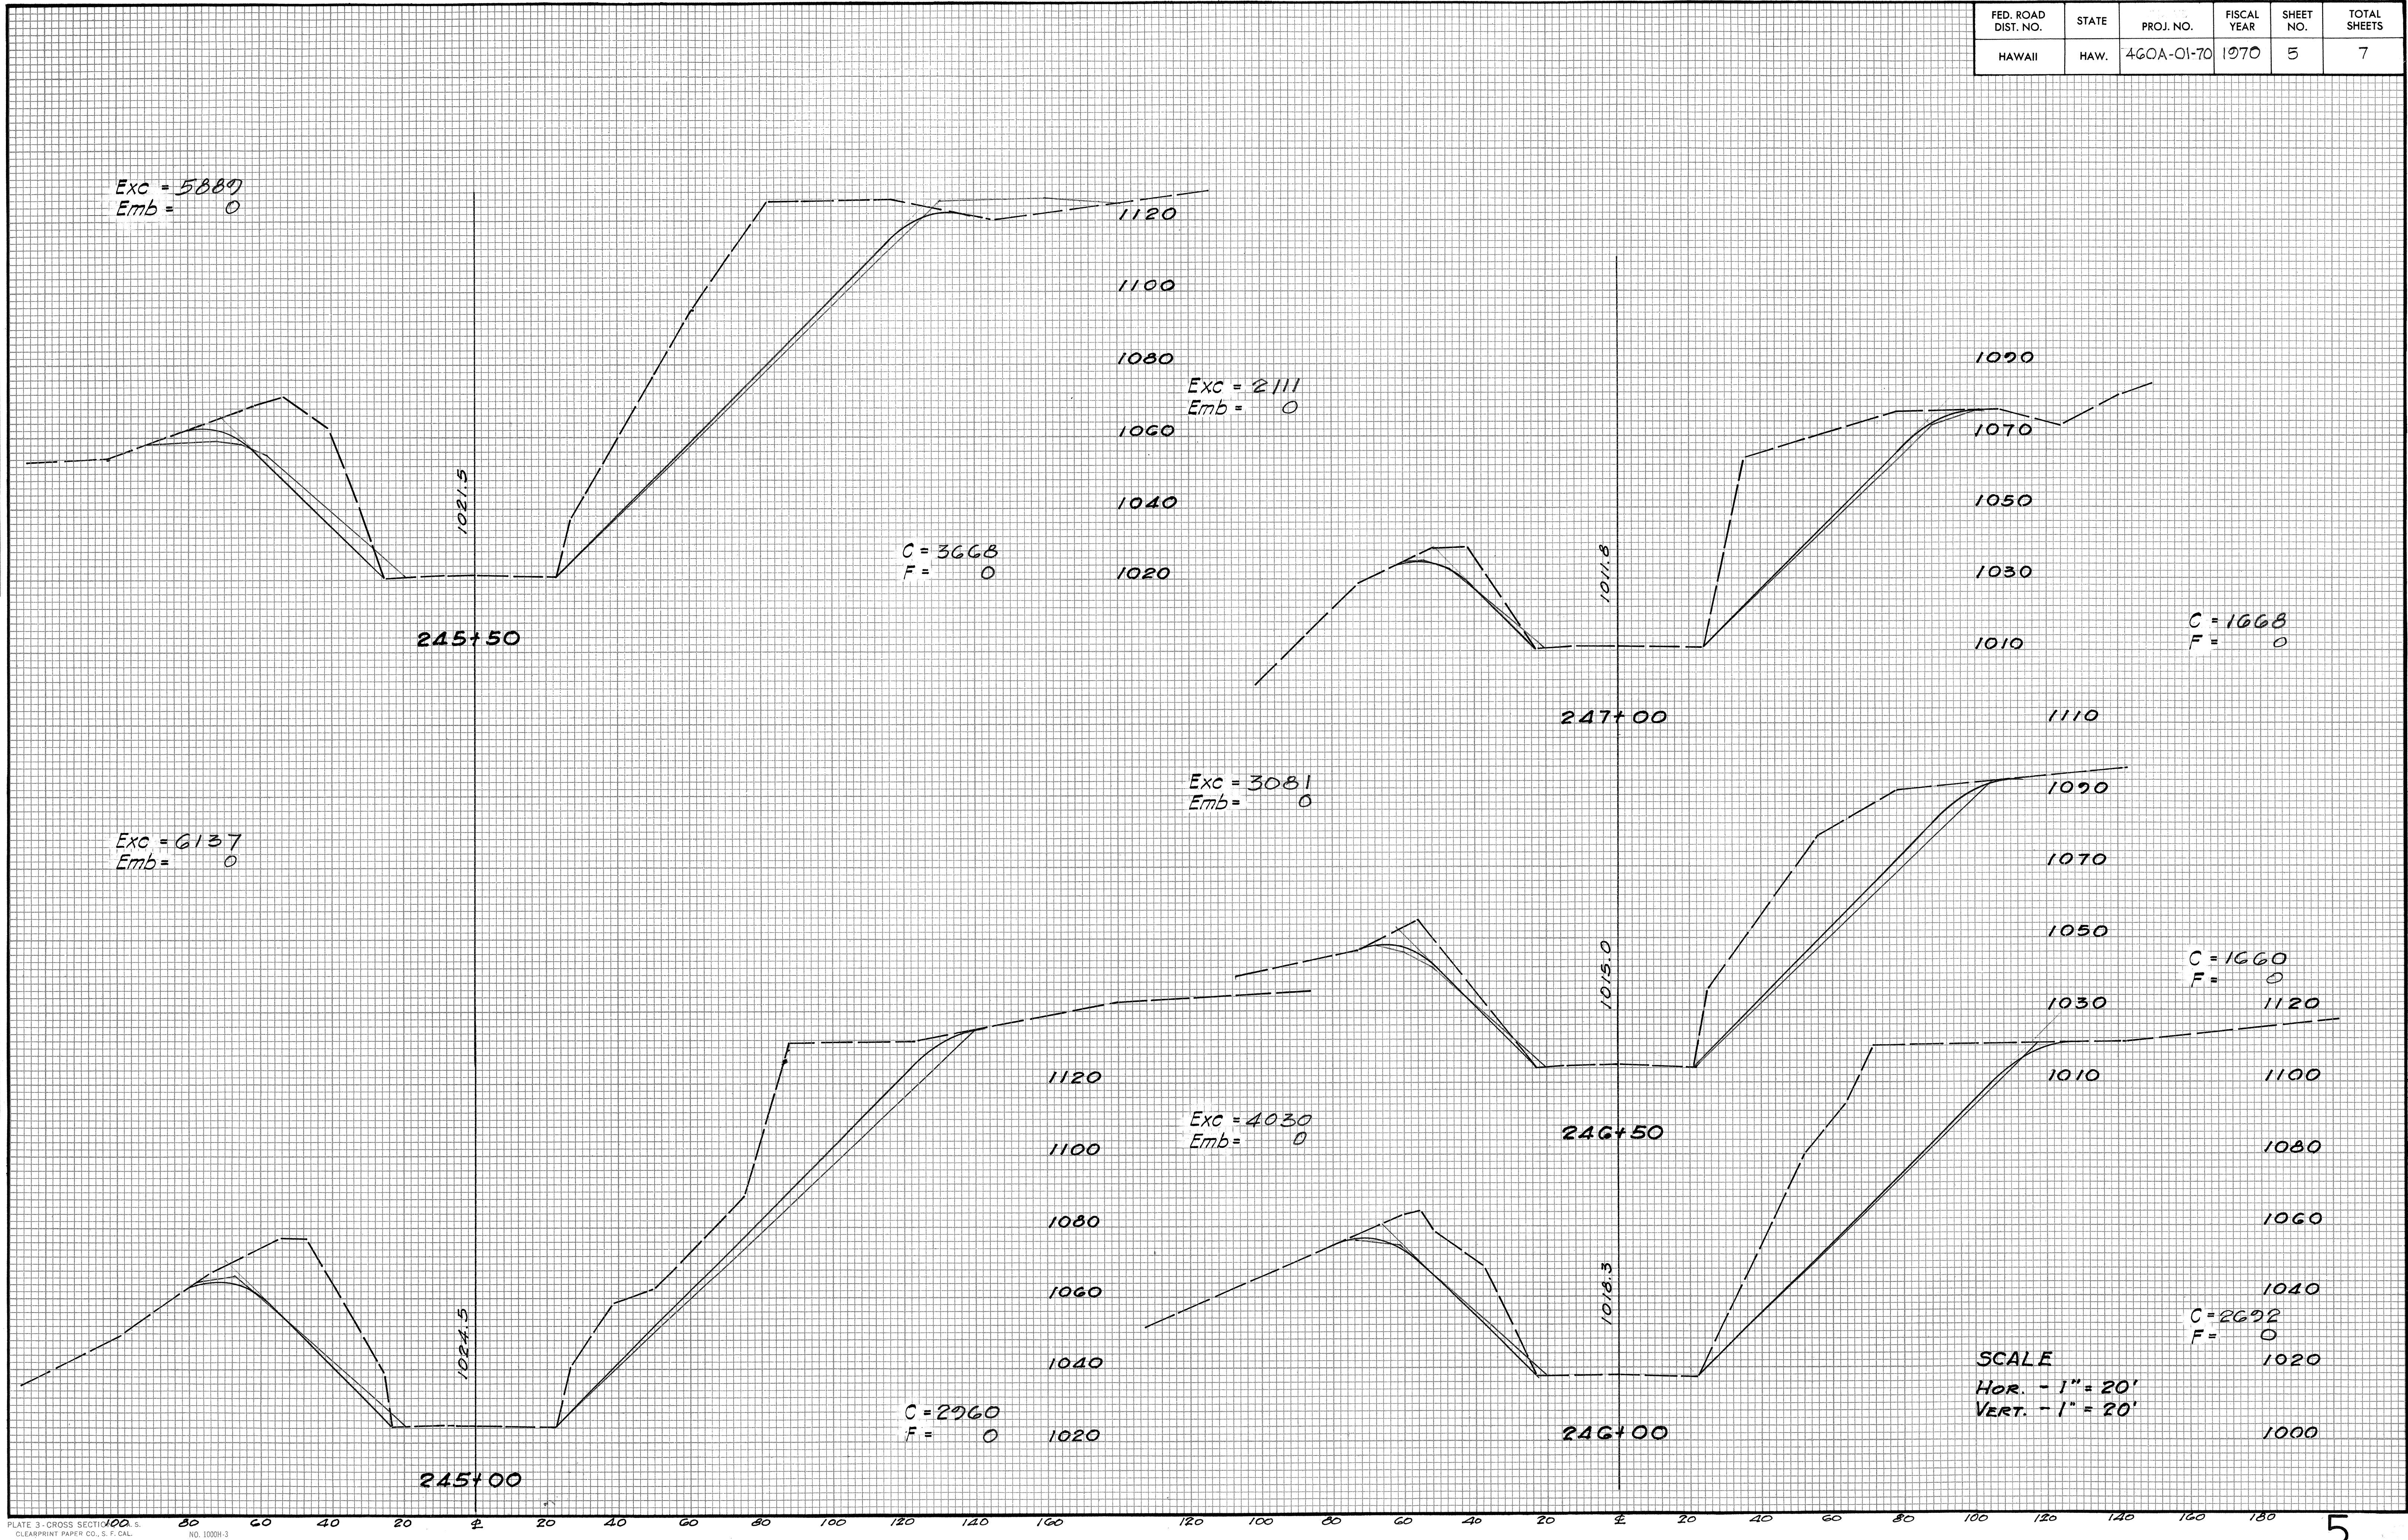

FED. ROAD DIST. NO.	STATE	PROJ. NO.	FISCAL YEAR	SHEET NO.	TOTAL SHEETS
HAWAII	HAW.	460A-01-70	1970	6	7

FINAL SURVEY NOTE BOOK NO.	SURVEYED PLOTTED DATE AREAS CHECKED	BY	DATE

ORIGINAL SURVEY NOTE BOOK NO.	SURVEYED PLOTTED DATE AREAS CHECKED	BY	DATE

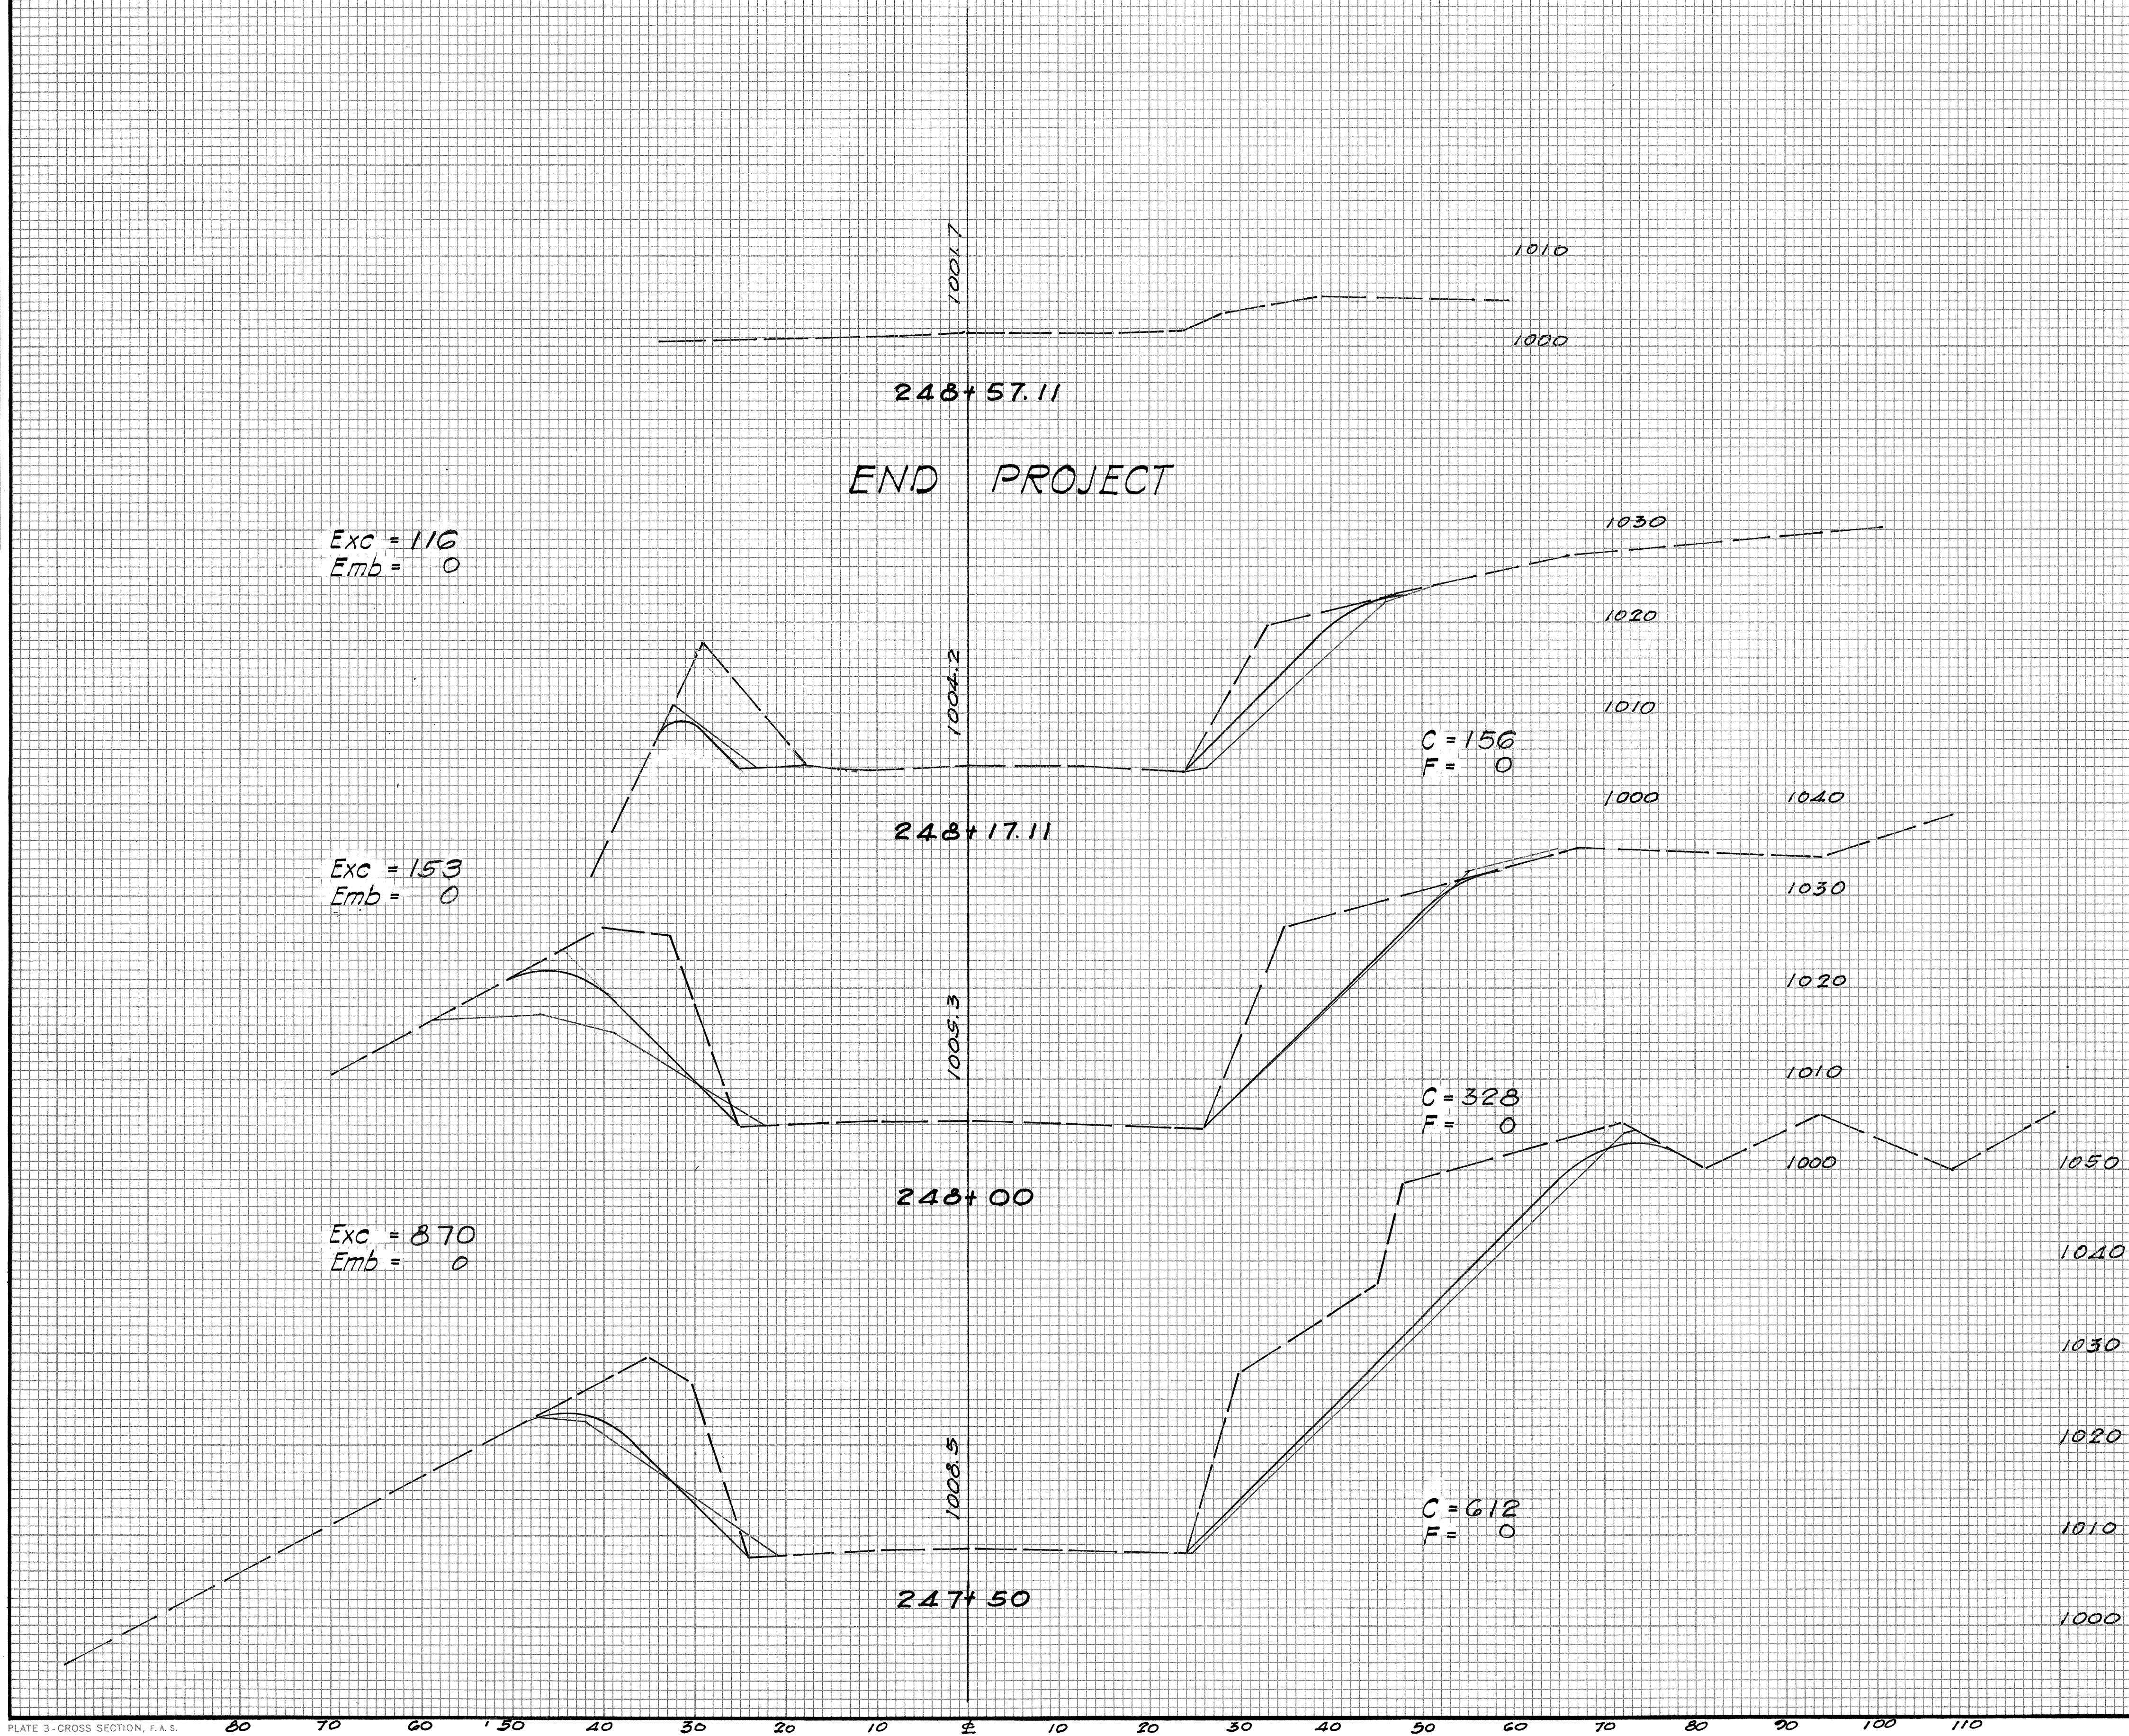

SCALE
Hor. - 1" = 10'
Vert. - 1" = 10'