INDEX TO DRAWINGS	
SHEET NO.	DESCRIPTION
1	TITLE SHEET
2-6	CROSS SECTIONS
7	PROJ. INFORMATION SIGN

FED. ROAD DIST. NO.	STATE	PROJ. NO.	FISCAL YEAR	SHEET NO.	TOTAL SHEETS
HAWAII	HAW.	460A-01-70	1970	1	7

STATE OF HAWAII

DEPARTMENT OF TRANSPORTATION

HIGHWAYS DIVISION

"AS BUILT" PLANS OF

SLOPE IMPROVEMENT
MAUNALOA ROAD
PROJECT NO. 460A-01-70

DISTRICT OF MOLOKAI
COUNTY OF MAUI
ISLAND OF MOLOKAI

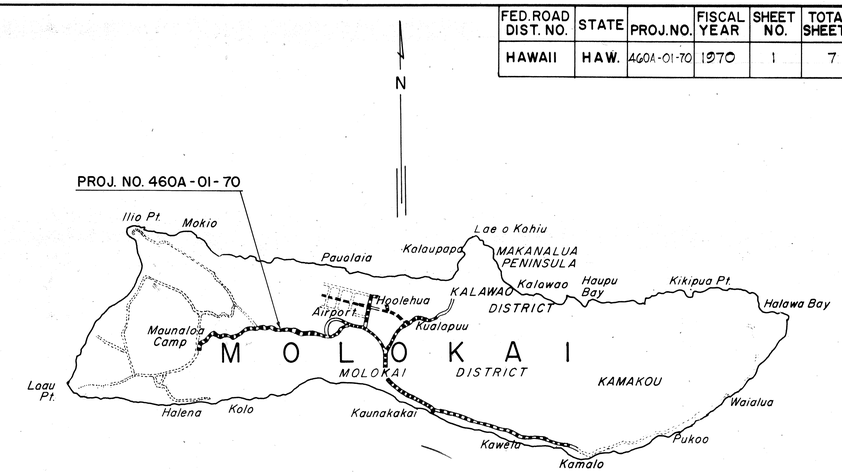

FEDERAL AID PROJECTS PREVIOUSLY CONSTRUCTED OR UNDER CONSTRUCTION

LOCATION MAP

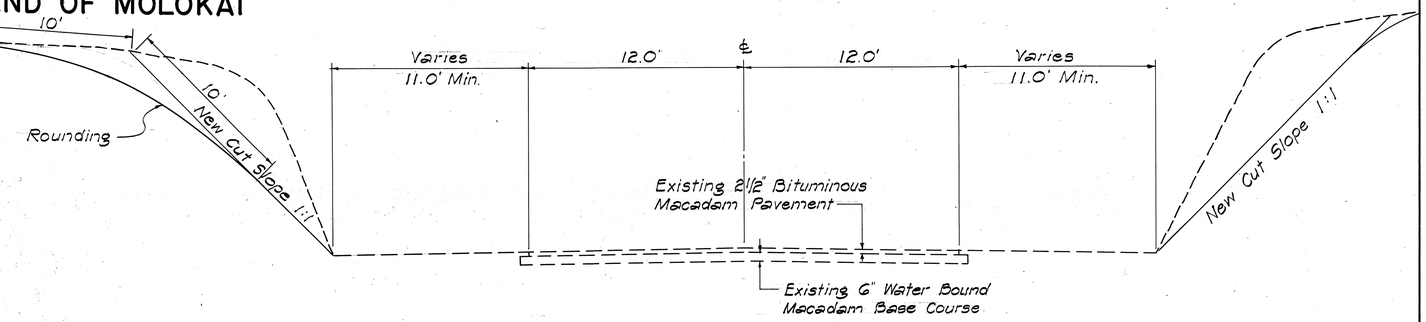

TYPICAL SECTION

Scale: 1/4" = 1'-0"

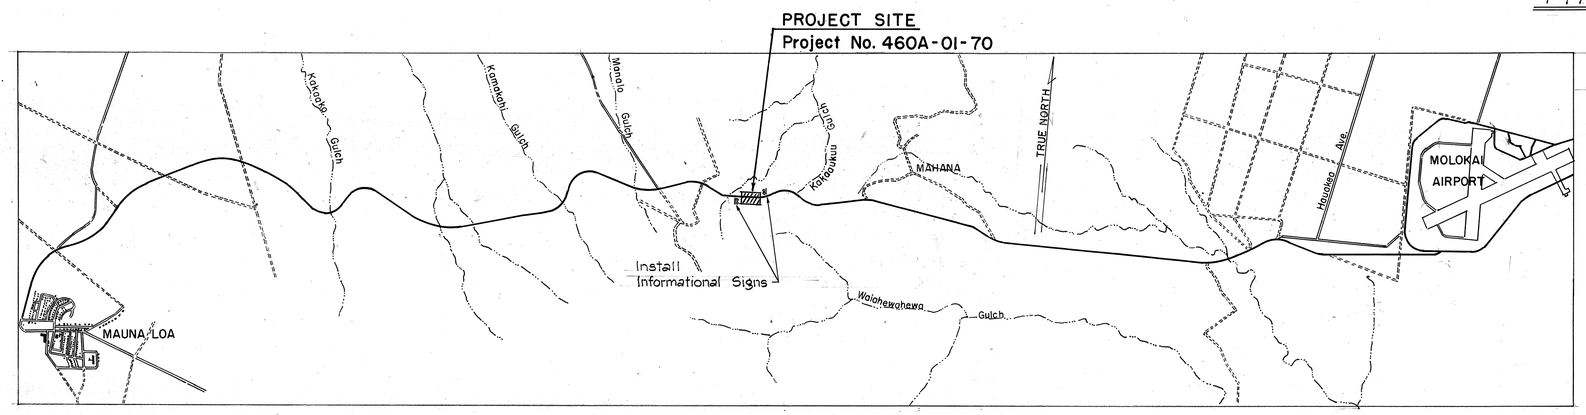

LAYOUT OF PROJECT

Scale: 1" = 2000'

LENGTH OF PROJECT = 0.134 MILE

NOTE:

ALL CHANGES MADE DURING CONSTRUCTION HAVE BEEN NOTED IN RED ON THESE TRACINGS AND CHECKED BY

Katsumi Nakamoto 5/17/71
PROJECT ENGINEER DATE

DEPARTMENT OF TRANSPORTATION
STATE OF HAWAII

APPROVED:

for E. Alvey Wright 8/11/70
DIR. OF TRANSPORTATION DATE

Ronald Tsuzuki 548-2211 301 July 1970
P.S. & E. By Phone Loc. Date

DESIGNED BY: MAUI DISTRICT OFFICE
STATE HIGHWAYS DIVISION
DATE: JUNE 1970