FED. ROAD DIST. NO.	STATE	FED. AID PROJ. NO.	FISCAL YEAR	SHEET NO.	TOTAL SHEETS
HAWAII	HAW.	STP-0460 (11)	1996	1	39

INDEX TO DRAWINGS

SHEET NO.	DESCRIPTION
1	TITLE SHEET
2	STANDARD PLANS SUMMARY
3	GENERAL NOTES AND LEGEND
4–5	TYPICAL SECTIONS AND DETAILS
6–19	ROADWAY PLANS
20	DRAINAGE DETAILS AND NOTES
21–23	MODIFIED ECCENTRIC LOADER
	TERMINAL (MELT) DETAILS
24	PAVEMENT MARKING, LEGEND,
	DETAILS AND NOTES
25–38	SIGNING AND PAVEMENT
	MARKING PLANS
39	TRAFFIC SIGN SUMMARIES

STATE OF HAWAII

DEPARTMENT OF TRANSPORTATION

HIGHWAYS DIVISION

HONOLULU, HAWAII

"AS-BUILT"

PLANS FOR MAUNALOA HIGHWAY RESURFACING

KAUNAKAKAI WHARF TO HOOLEHUA

FEDERAL AID PROJECT NO. STP-0460 (11)

DISTRICT OF MOLOKAI

ISLAND OF MOLOKAI

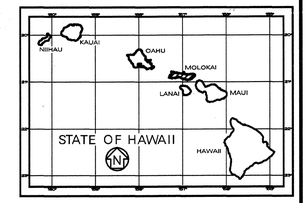

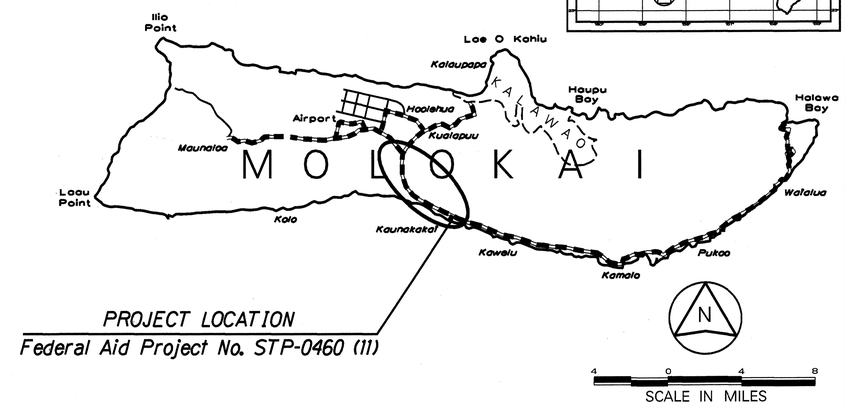

FEDERAL AID PROJECT NO. STP-0460 (11)

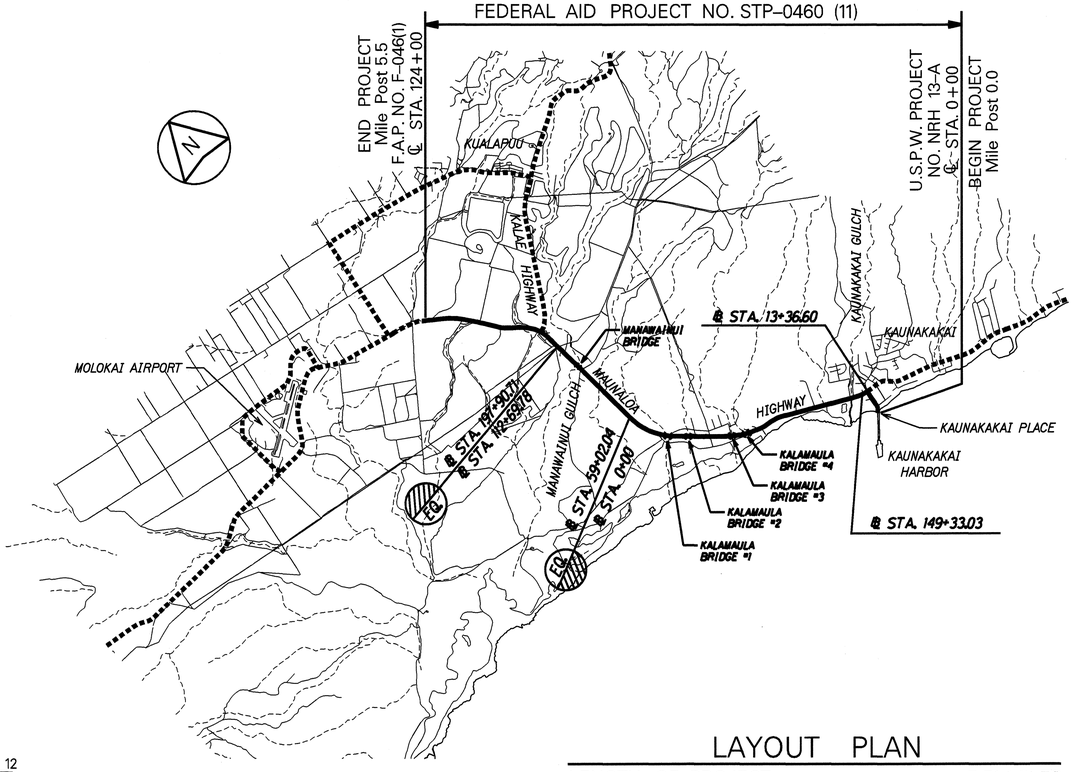

FEDERAL AID PROJECTS PREVIOUSLY CONSTRUCTED OR UNDER CONSTRUCTION

MILE POST 0 TO MILE POST 5.5

DESIGN DESIGNATION

CURRENT ADT (1996) 7,540
DESIGN ADT (2006) 10,380
DHV ..... 930 vph
D des. 60/40
T des ..... 2.5 %
V ..... 50 mph

4 0 4 8 12
SCALE IN THOUSAND FEET

LAYOUT PLAN

LENGTH OF PROJECT ..... 5.51 MILES

CHANGES MADE DURING CONSTRUCTION HAVE BEEN INCORPORATED ON THESE PLANS EXCEPT CHANGES IN THE ORIGINAL THEORETICAL QUANTITIES. FOR ACTUAL QUANTITIES, REFER TO PROJECT LEDGER AND/OR COMPUTATION BOOK.

Michael Downing 11-16-00
RESIDENT ENGINEER DATE

DEPARTMENT OF TRANSPORTATION STATE OF HAWAII	
APPROVED: Fujio Hayashida	5/23/96
DIR. OF TRANSPORTATION	DATE

R.T. TANAKA ENGINEERS, INC. — DESIGNED BY
HWY-M — P. S. & E. BY
877-5061 — PHONE
MAY 1996 — DATE