FED. ROAD DIST. No.	STATE	FED. AID PROJ. No.	FISCAL YEAR	SHEET No.	TOTAL SHEETS
HAWAII	HAW.	S-0480(1)	1965	10	31

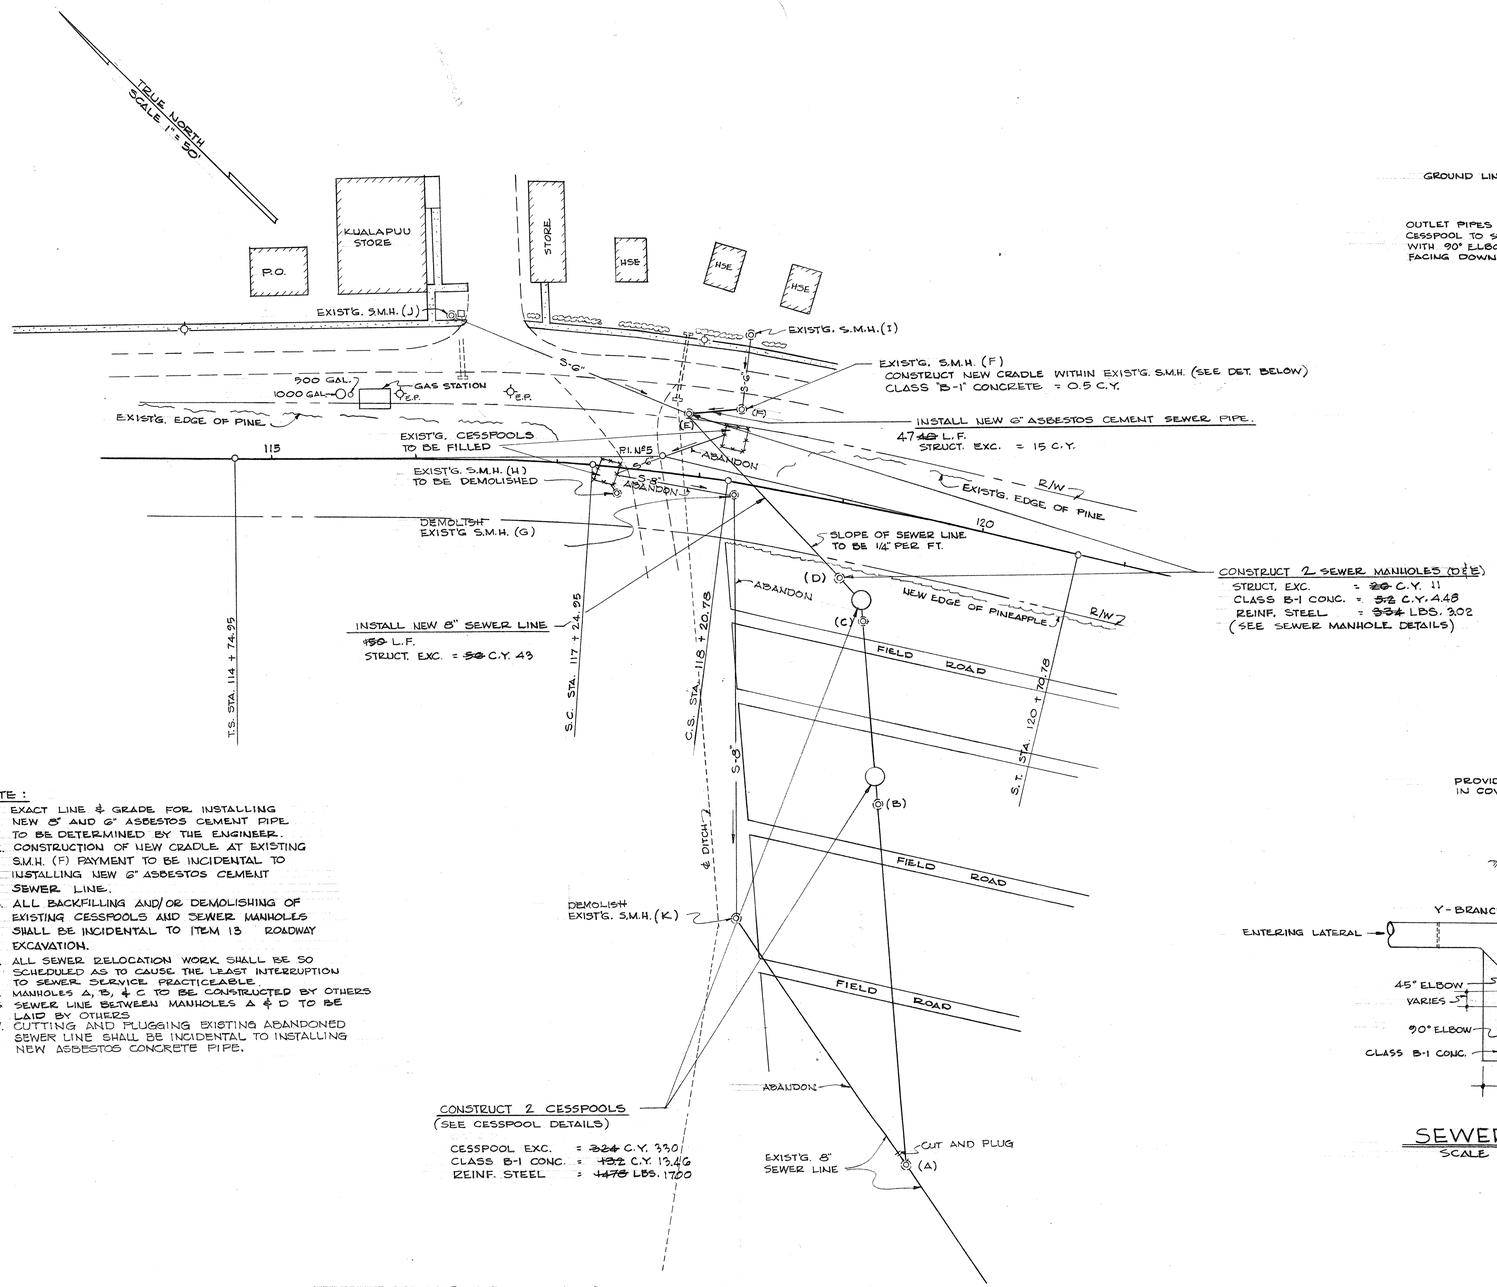

NOTE :

1. EXACT LINE & GRADE FOR INSTALLING NEW 8" AND 6" ASBESTOS CEMENT PIPE TO BE DETERMINED BY THE ENGINEER.
2. CONSTRUCTION OF NEW CRADLE AT EXISTING S.M.H. (F) PAYMENT TO BE INCIDENTAL TO INSTALLING NEW 6" ASBESTOS CEMENT SEWER LINE.
3. ALL BACKFILLING AND/OR DEMOLISHING OF EXISTING CESSPOOLS AND SEWER MANHOLES SHALL BE INCIDENTAL TO ITEM 13 ROADWAY EXCAVATION.
4. ALL SEWER RELOCATION WORK SHALL BE SO SCHEDULED AS TO CAUSE THE LEAST INTERRUPTION TO SEWER SERVICE PRACTICEABLE.
5. MANHOLES A, B, & C TO BE CONSTRUCTED BY OTHERS
6. SEWER LINE BETWEEN MANHOLES A & D TO BE LAID BY OTHERS
7. CUTTING AND PLUGGING EXISTING ABANDONED SEWER LINE SHALL BE INCIDENTAL TO INSTALLING NEW ASBESTOS CONCRETE PIPE.

CONSTRUCTION OF SEWER SYSTEM
STA 117 + 00 TO STA. 118 + 50

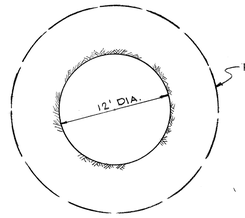

PLAN
NO SCALE

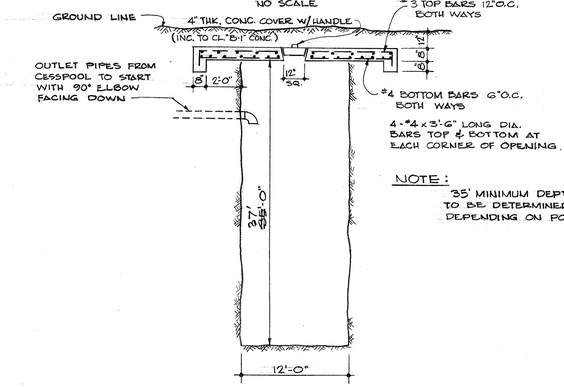

NOTE :
35' MINIMUM DEPTH. EXACT DEPTH TO BE DETERMINED BY THE ENGINEER DEPENDING ON POROUSITY OF MATERIAL

ELEVATION
NO SCALE

CESSPOOL DETAILS

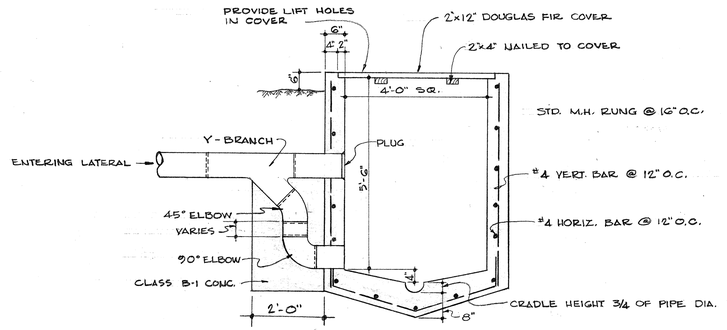

NOTE :
WOODEN M.H. COVER INCIDENTAL TO CONCRETE.

SEWER MANHOLE DETAILS
SCALE 1/2" = 1'-0"

ORIGINAL PLAN	SURVEY PLOTTED BY	DATE
	DESIGNED BY	
	DRAWN BY	
	TRACED BY	
NOTE BOOK	QUANTITIES BY	
No.	CHECKED BY	

STATE OF HAWAII
DEPARTMENT OF TRANSPORTATION
HIGHWAYS DIVISION

CONSTRUCTION OF SEWER SYSTEM

FARRINGTON AVE. MOLOKAI
PROJ. N° S-0480(1)

SHEET No. 10 OF SHEETS

PRINTED ON DIEPO 1000H CLEARPRINT