FED. ROAD DIST. NO.	STATE	PROJ. NO.	FISCAL YEAR	SHEET NO.	TOTAL SHEETS
HAWAII	HAW.	480A-01-83	1984	1	10

INDEX TO DRAWINGS

SHEET NO.	DESCRIPTION
1	TITLE SHEET
2	PLAN - PUUPEELUA AVE., GENERAL NOTES AND DETAILS
3-4	PLAN - FARRINGTON AVE.
5-10	STANDARD DETAILS

STATE OF HAWAII

DEPARTMENT OF TRANSPORTATION
HIGHWAYS DIVISION

HONOLULU, HAWAII

"AS-BUILT"

PLANS FOR

FARRINGTON AVE. AND PUUPEELUA AVE.
SAFETY IMPROVEMENTS AT VARIOUS LOCATIONS

PROJECT NO. 480A-01-83

DISTRICT OF MOLOKAI
ISLAND OF MOLOKAI

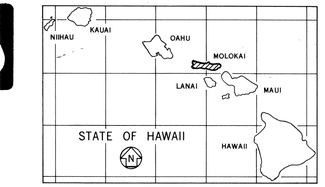

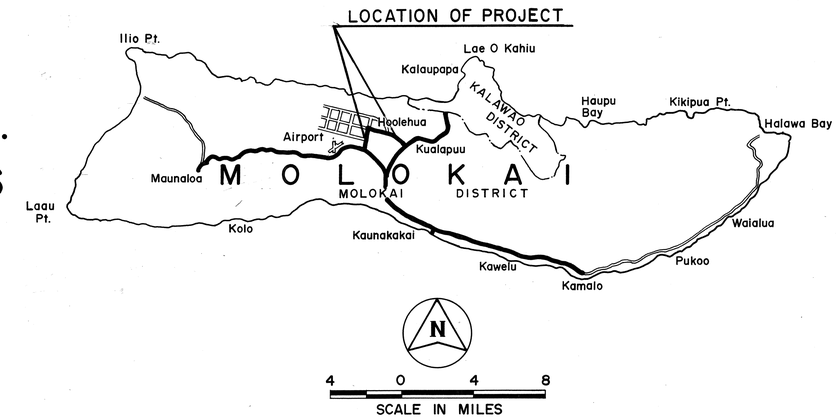

FEDERAL AID PROJECTS PREVIOUSLY CONSTRUCTED OR UNDER CONSTRUCTION

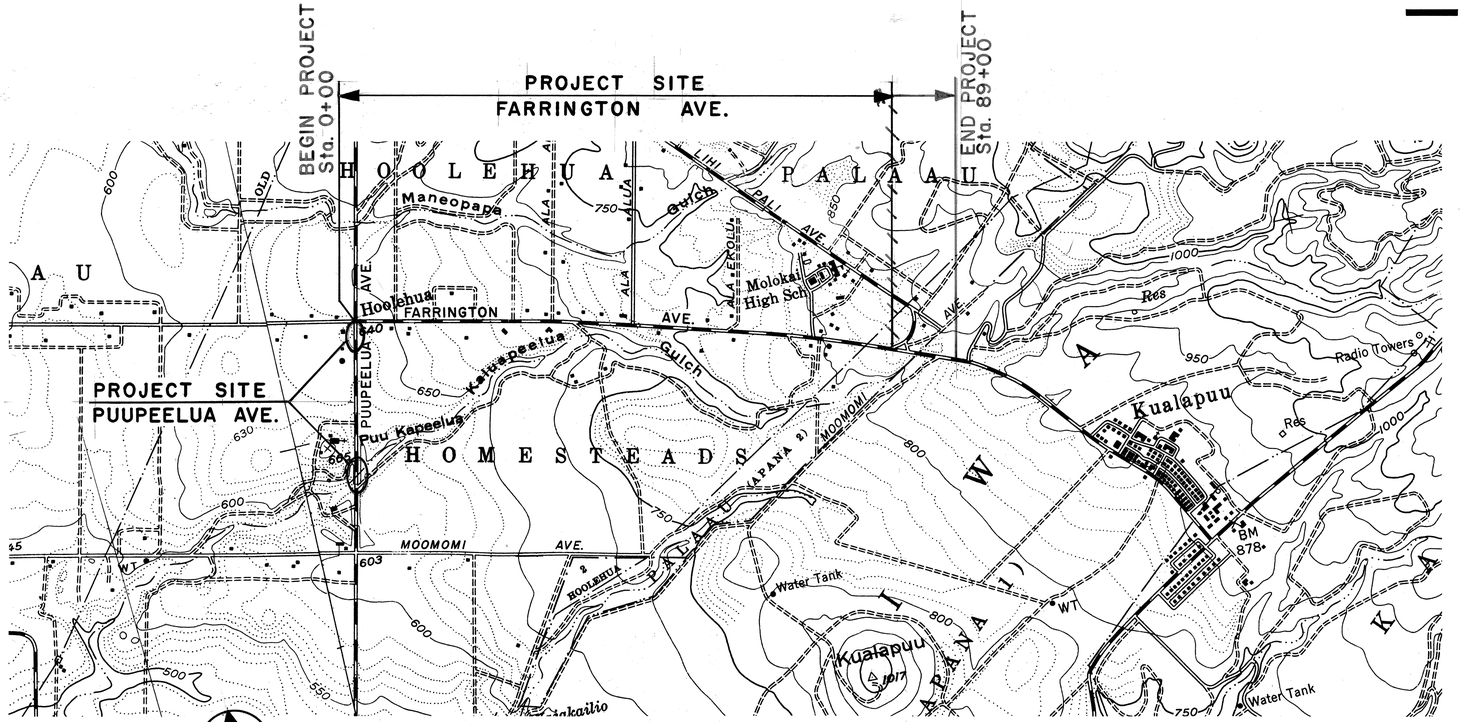

LAYOUT PLAN

LENGTH OF PROJECT ..... 2.055 MI.

CHANGES MADE DURING CONSTRUCTION HAVE BEEN INCORPORATED ON THESE PLANS EXCEPT CHANGES IN THE ORIGINAL THEORETICAL QUANTITIES. FOR ACTUAL QUANTITIES, REFER TO PROJECT LEDGER AND/OR COMPUTATION BOOK.

Gary Yamashita — RESIDENT ENGINEER — 6-12-84 DATE

DEPARTMENT OF TRANSPORTATION
STATE OF HAWAII
APPROVED:
Cheryl D. Soon — for DIR. OF TRANSPORTATION — 11/9/83 DATE

A. NISHIMURA — DESIGNED BY
A. NISHIMURA — P. S. & E. BY
548-7490 — PHONE
NOV. 1983 — DATE