FED. ROAD DIST. NO.	STATE	FED. AID PROJ. NO.	FISCAL YEAR	SHEET NO.	TOTAL SHEETS
HAWAII	HAW.	STP-0900(34)	1997	1	20

INDEX TO DRAWINGS

SHEET NO.	DESCRIPTION
1	TITLE SHEET
2	STANDARD PLANS SUMMARY
3	GENERAL NOTES AND LEGEND
4 – 5	TYPICAL SECTIONS AND DETAILS
6 – 7	GUARDRAIL POST LAYOUT AND ERECTION DETAILS
8	PAVEMENT MARKING LEGEND, DETAILS AND NOTES
9 – 16	ROADWAY AND SIGNING PLAN
17	SIGN PANEL LAYOUT AND NOTES
18 – 20	MISCELLANEOUS SUMMARIES

STATE OF HAWAII

DEPARTMENT OF TRANSPORTATION

HIGHWAYS DIVISION

HONOLULU, HAWAII

"AS-BUILT"

PLANS FOR

KAAHUMANU AVENUE GUARDRAIL AND SHOULDER IMPROVEMENTS

NANILOA DRIVE TO KAHULUI BEACH ROAD

AND

HANA HIGHWAY SHOULDER IMPROVEMENTS

KAAHUMANU AVENUE TO DAIRY ROAD

FEDERAL-AID PROJECT NO. STP-0900(34)

DISTRICT OF WAILUKU

ISLAND OF MAUI

PROJECT LOCATIONS
Fed. Aid Project No. STP-0900(34)

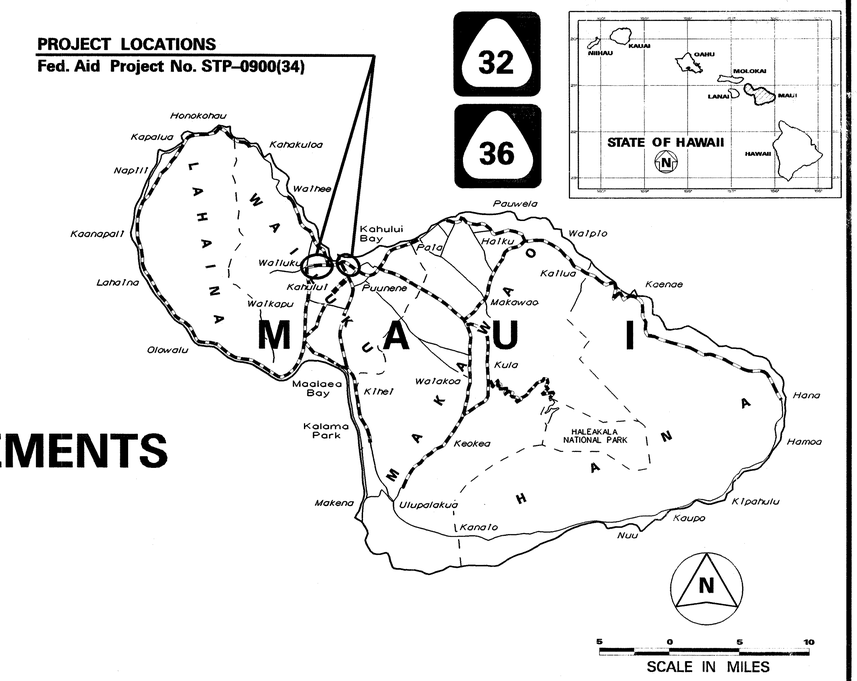

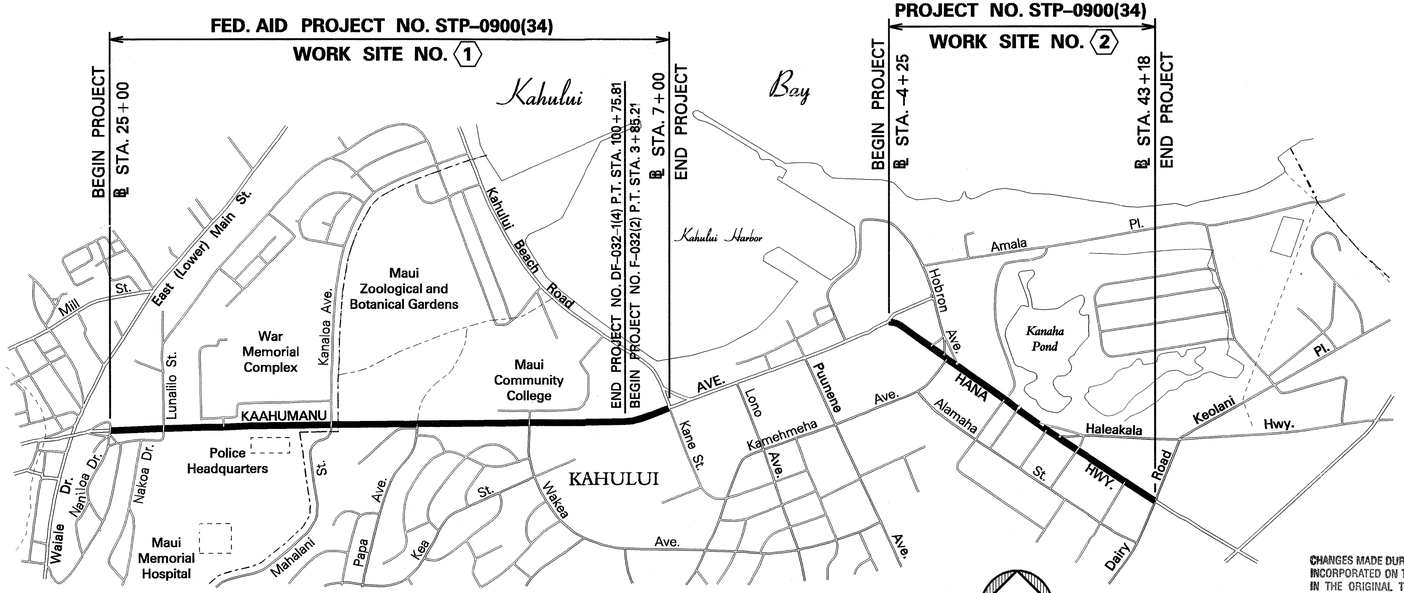

FEDERAL AID PROJECTS PREVIOUSLY CONSTRUCTED OR UNDER CONSTRUCTION

(1) MILE POST 0.60 TO MILE POST 2.09

(2) MILE POST -0.08 TO MILE POST 0.82

DESIGN DESIGNATION

KAAHUMANU AVENUE:

ADT (1995).....46,200
ADT (2005).....59,700
DHV.....5,370
D.....60/40
T_{24}.....2.5%

HANA HIGHWAY:

ADT (1995).....37,300
ADT (2005).....47,800
DHV.....4,060
D.....60/40
T_{24}.....5%

LAYOUT PLAN

GROSS LENGTH OF PROJECT.....2.39 MILES
NET LENGTH OF PROJECT.....2.39 MILES

CHANGES MADE DURING CONSTRUCTION HAVE BEEN INCORPORATED ON THESE PLANS EXCEPT CHANGES IN THE ORIGINAL THEORETICAL QUANTITIES. FOR ACTUAL QUANTITIES, REFER TO PROJECT LEDGER AND/OR COMPUTATION BOOK.

RESIDENT ENGINEER — DATE 1/14/08

DEPARTMENT OF TRANSPORTATION
STATE OF HAWAII

APPROVED:

DIR. OF TRANSPORTATION — DATE 8/27/96

HWY-M	K. ITO	587-2244	MAR., 1996
DESIGNED BY	P. S. & E. BY	PHONE	DATE

