FED. ROAD DIST. NO.	STATE	FED. AID PROJ. NO.	FISCAL YEAR	SHEET NO.	TOTAL SHEETS
HAW.	HAW.	5B	1929	1	86

TERRITORY OF HAWAII

TERRITORIAL HIGHWAY DEPARTMENT

HONOLULU, T.H.

PLANS OF

THE

HALEAKALA ROAD

FEDERAL AID PROJECT NO. 5B.

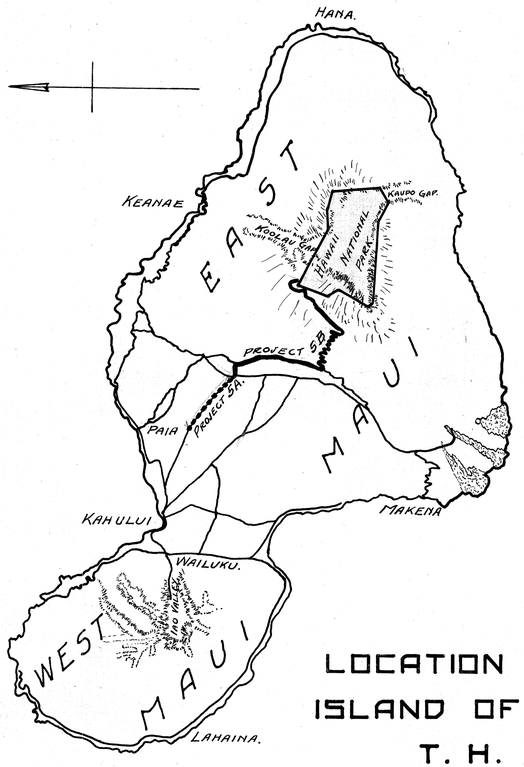

LOCATION MAP
ISLAND OF MAUI
T. H.

	GROSS	EXCEPTIONS	NET.
GROUP A	6.400 MI.	.048 MI.	6.352 MI.
" B	10.212 "	.027 "	10.185 ".
ENTIRE PROJ.	16.612 "	.075 "	16.537 ".

CONVENTIONAL SIGNS.

EXISTING ROADS,
EXISTING TRAILS,
EXISTING FENCES,
DRY STREAM BEDS,
BOUNDARY LINES,
ENLARGED DITCH SECTION,
CENTERLINE,
RT-OF-WAY LINES,
GULCHES,
POWER AND TELEPHONE LINES, T T T

SCALES.

LAYOUT OF PROJECT,	1/31,680
PLAN,	1" = 100'
PROFILE, HOR.	1" = 100'
PROFILE, VER.	1 = 10'
SECTIONS, HOR.	1 = 10'
SECTIONS. VER.	1 = 10'

INDEX.

TITLE SHEET,	1	BOX CULVERT DETAILS,	33-34
TYPICAL SECTIONS,	2	ADDITIONAL DETAILS,	35
KEY MAP TO SHEETS,	3	BRIDGE DETAILS,	36-42 INC., 40A&B
LINE AND PROFILE,	4 TO 31 & 10A	CROSS-SECTIONS,	43-86 INC.
STANDARD DETAILS,	32	SUMMARY OF GRADING QUANTS.	42-A, B&C

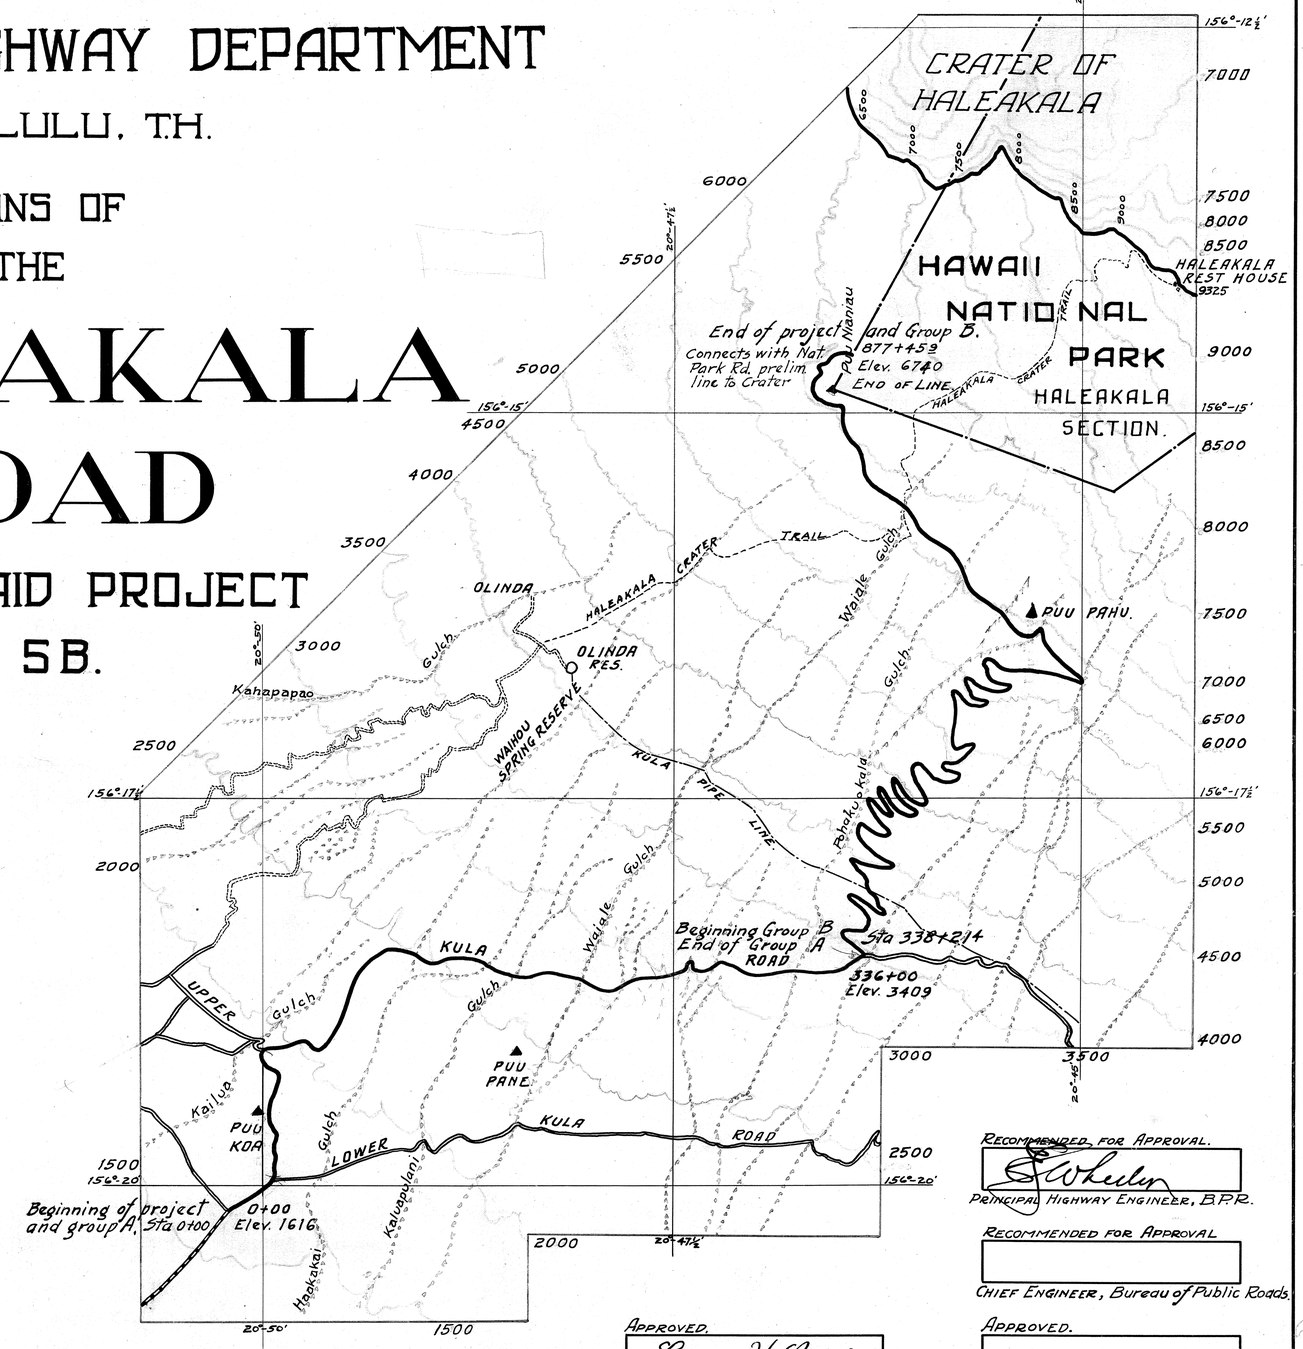

LAYOUT OF PROJECT.

RECOMMENDED FOR APPROVAL.
PRINCIPAL HIGHWAY ENGINEER, B.P.R.

RECOMMENDED FOR APPROVAL
CHIEF ENGINEER, Bureau of Public Roads.

APPROVED.
Lyman H. Bigelow
TERRITORIAL HIGHWAY ENGINEER.

APPROVED.
DIRECTOR, Bureau of Public Roads.

Revised 1935-1939 to add sheets 10A, 40A, 40B, and 42A-B-C to index and revise mileage.

4081.1

Plan File	Pocket	Folder	Plan
No. 6	No. 15	No. 3	No.