FED. ROAD DIST. NO.	STATE	FISCAL YEAR	SHEET NO	TOTAL SHEETS
HAWAII	HAW.	1943	1	43

TERRITORY OF HAWAII
TERRITORIAL HIGHWAY DEPARTMENT
HONOLULU, T. H.

PLANS OF

HALEAKALA ROAD & PAIA SPUR
HAWAII PROJECT NO. D.A.-N.C.- 8 (1)

WAILUKU DISTRICT
ISLAND OF MAUI

INDEX TO DRAWINGS

SHEET NO.	DESCRIPTION
1	Title Sheet
2	Typical Road Section
3 - 12	Plans and Profiles
14 - 15	Standard Details
18 - 20	Bridge Details
13A - 13B	Detail Showing Intersections
21 - 43	Cross Sections
16 - 17	Culvert Details

REVISED INDEX TO DRAWINGS

SHEET NO	DESCRIPTION	REV. DATE
1	Title Sheet	5/20/44
2	Typical Road Sections	"
2-A	" " "	"
2-B	Revised Road Sections	New-5/20/44
3	Plans & Profile	5/20/44
3-A	" " "	"
3-B	" " "	"
3-C	Haleakala Road & Portion of Main St.	New-5/20/44
3-D	Main St. at Hobron Ave.	"
3-E	Hobron Ave. Extension	"
3-F	Intersection: Hobron Ave. at Haleakala Road	"
4-6	Plan & Profile	5/20/44
7	" "	No Revisions
8	" "	5/20/44
9-10	" "	No Revisions
11-12	" "	5/20-44
13-A	Intersection Details	Obsolete!
13-B	" "	No Revisions
14-15	Standard Details	" "
16-17	Culvert Details	Obsolete!
16A-17A	Replaces Sheets 16 & 17	Oct., '43
19 - 20	Bridge Details (18 Void)	Sept., '43
20-A	Bridge Girders	New - Nov. 43
20-B	Steel Schedule	No Revisions
21-43	Cross Sections	No Revisions
15A	Standard Details	New - 5/20/44
13C, 13D	Location & Details of Traffic Signs	New - 9/25/45

REVISED: 10/5/44
REVISED: 5/20/44

CONVENTIONAL SIGNS

- Existing Dirt Road
- Fence Line
- Railroad
- Center Line
- Culvert
- Bridge
- Large Tree

SCALE

PLAN		1 IN = 100 FT.
PROFILE		1 IN = 100 FT.
CROSS SECTION	HOR.	1 IN = 10 FT.
	VER.	1 IN = 10 FT.

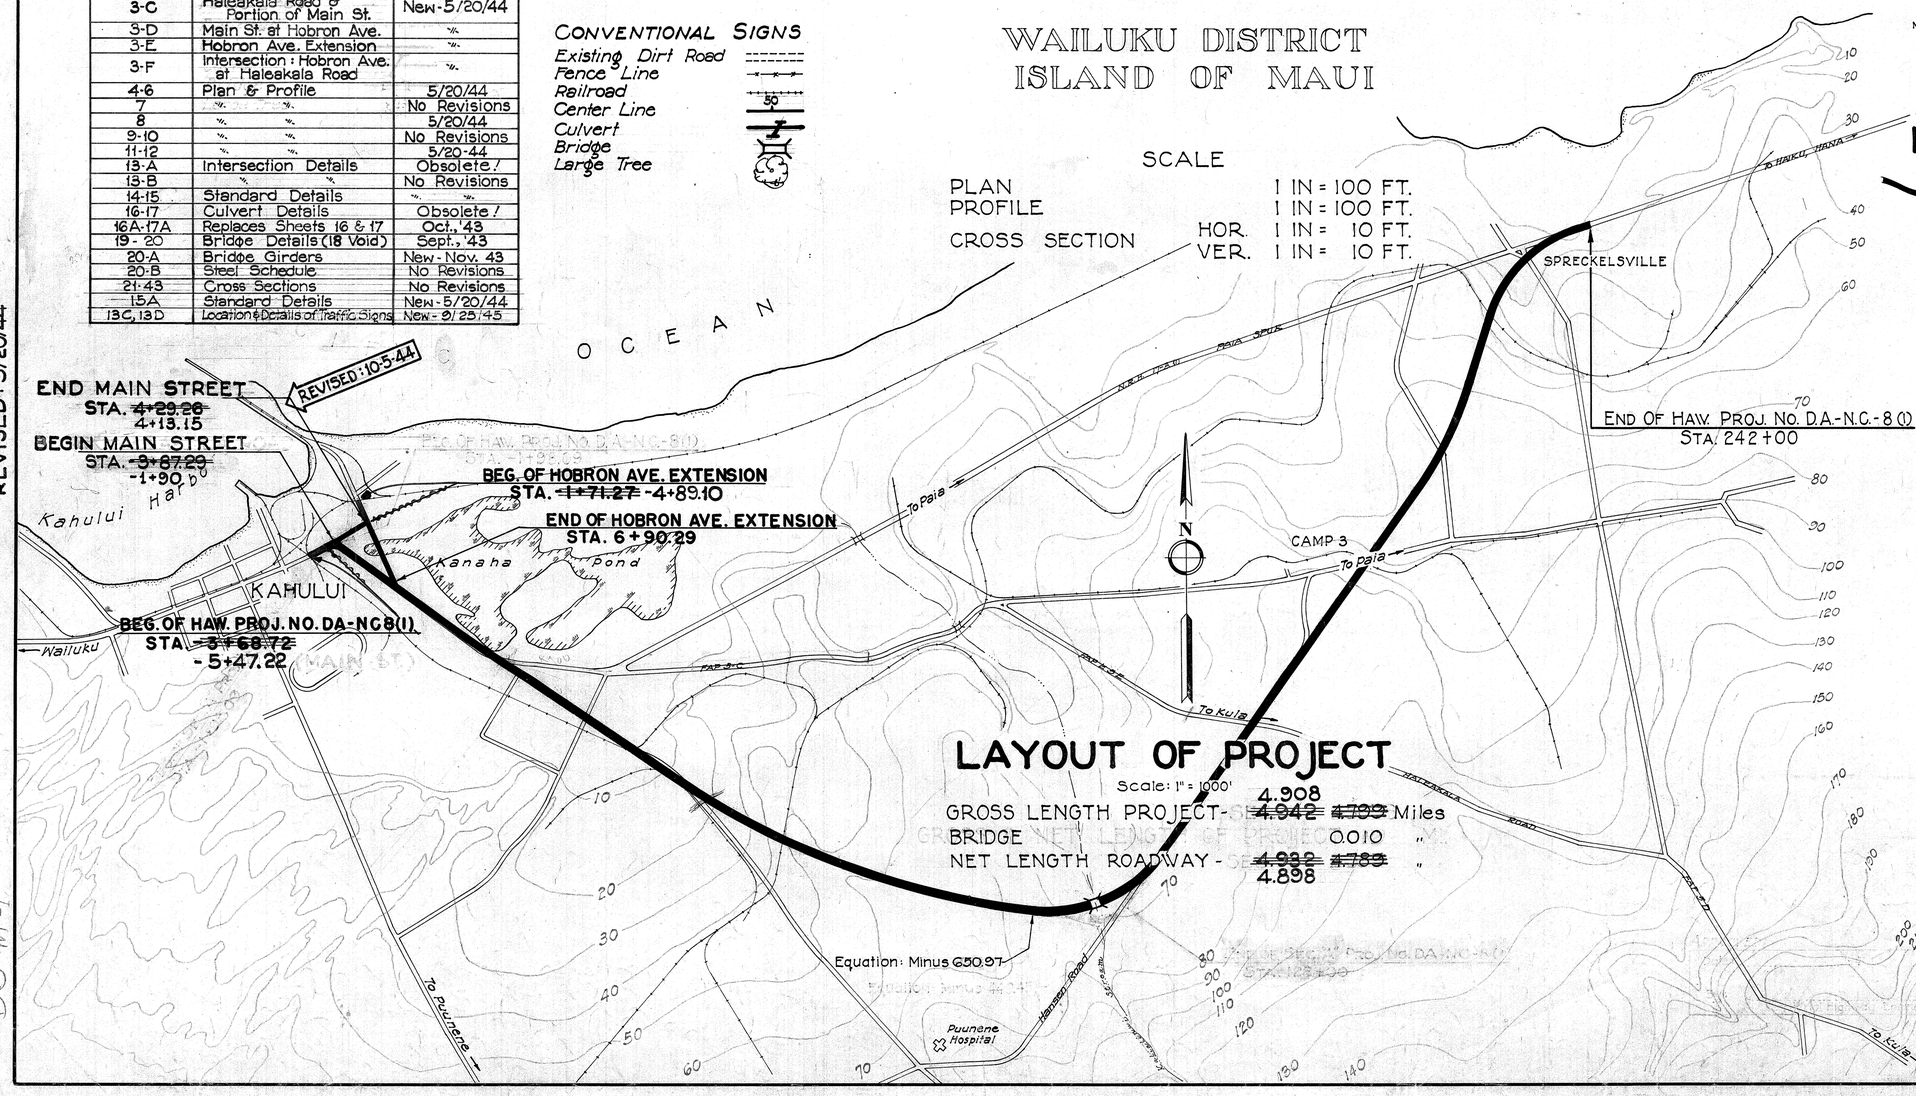

LAYOUT OF PROJECT

Scale: 1" = 1000'

GROSS LENGTH PROJECT-	~~4.942~~ ~~4.799~~ 4.908	Miles
BRIDGE	0.010	"
NET LENGTH ROADWAY -	~~4.932~~ ~~4.789~~ 4.898	"

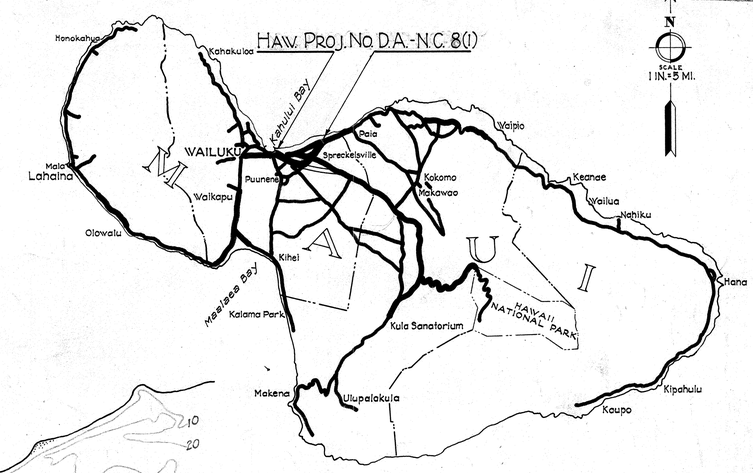

LOCATION MAP

Federal Aid Projects previously constructed.

I hereby certify that all changes on this project as finally completed are marked on the plans.

Benjamin K. Kaiwakilani
Resident Engineer.
4-27-45

RECOMMENDED FOR APPROVAL:

[redacted]
Principal Highway Engineer
Public Roads Administration
Federal Works Agency

RECOMMENDED FOR APPROVAL:

[redacted]
Chief Western Division
Public Roads Administration
Federal Works Agency

APPROVED:

[redacted]
Commissioner
Public Roads Administration
Federal Works Agency

APPROVED:
Date: May 12, 1943
By: L. R. Balch
Territorial Highway Engineer

April 1943

DO-M-1

5119.1

Speed 1