FED. ROAD DIST. NO.	STATE	PROJ. NO.	FISCAL YEAR	SHEET NO.	TOTAL SHEETS
HAWAII	HAW.	3800A-01-03M	2003	1	17

3800

STATE OF HAWAII

DEPARTMENT OF TRANSPORTATION

HIGHWAYS DIVISION

HONOLULU, HAWAII

"AS-BUILT"

PLANS FOR

DAIRY ROAD RESURFACING

KEOLANI PLACE TO KUIHELANI HIGHWAY

PROJECT NO. 3800A-01-03M

DISTRICT OF WAILUKU

ISLAND OF MAUI

INDEX TO DRAWINGS	
SHEET NO.	DESCRIPTION
1	TITLE SHEET
2	STANDARD PLANS SUMMARY
3	GENERAL NOTES AND LEGEND
4 – 5	WATER POLLUTION & EROSION CONTROL NOTES
6 – 7	TYPICAL SECTIONS & DETAILS
8 – 10	ROADWAY PLANS
11	PAVEMENT MARKING LEGEND, DETAILS & NOTES
12	SIGN PANEL LAYOUT & CURB RAMP DETAILS
13 – 15	SIGNING & PAVEMENT MARKING PLANS
16 – 17	MISCELLANEOUS SUMMARIES

Sheet No. 12S-1 is supplementary sheet to this project. Total SHEET COUNT after "As Built" postings is 18 Sheets.

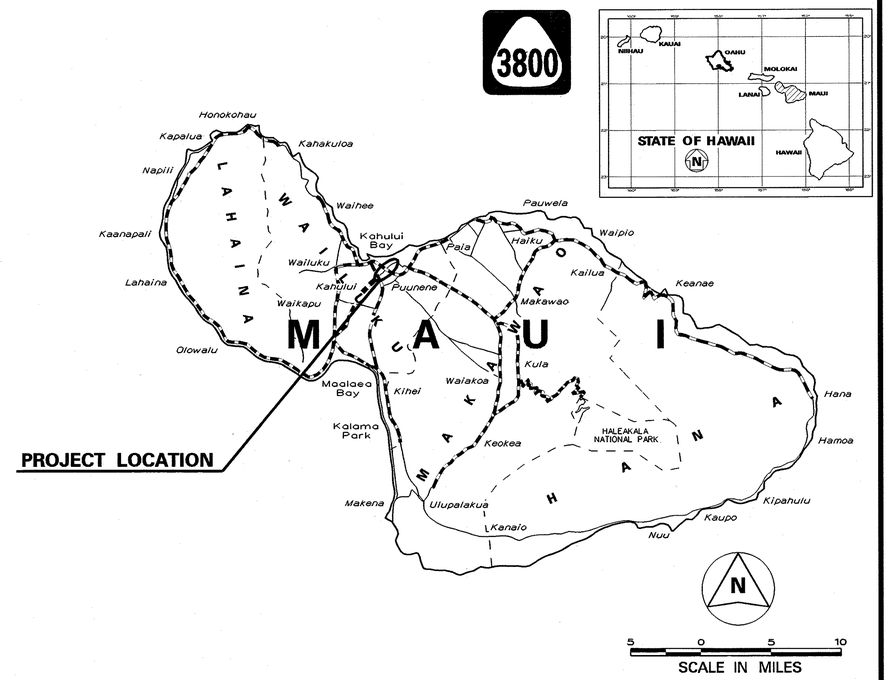

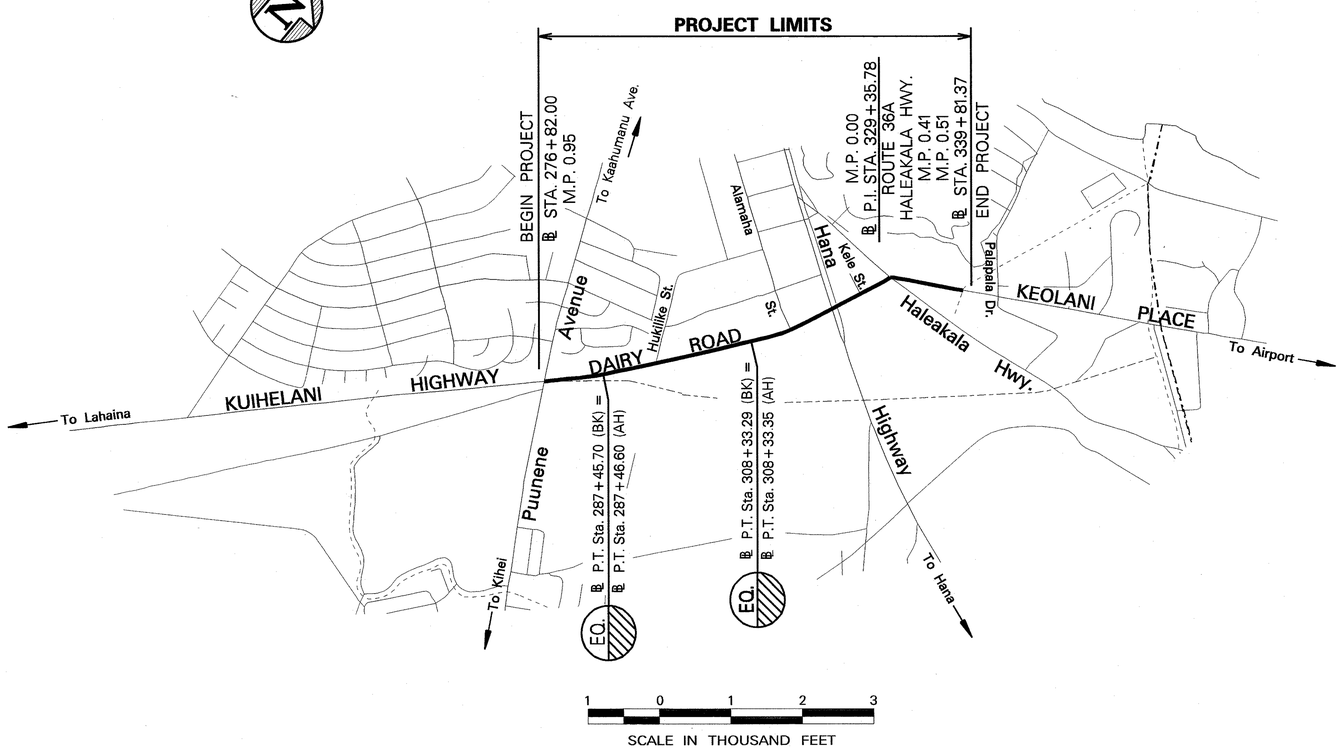

FEDERAL AID PROJECTS PREVIOUSLY CONSTRUCTED OR UNDER CONSTRUCTION

ROUTE 3800: MILE POST 0.00 TO MILE POST 0.95

ROUTE 36A: MILE POST 0.41 TO MILE POST 0.51

CHANGES MADE DURING CONSTRUCTION HAVE BEEN INCORPORATED ON THESE PLANS EXCEPT CHANGES IN THE ORIGINAL THEORETICAL QUANTITIES. FOR ACTUAL QUANTITIES, REFER TO PROJECT LEDGER AND/OR COMPUTATION BOOK.

Charlene Shibuya, Const. Eng. 2/14/07
for RESIDENT ENGINEER DATE

HWYM	PAUL CHUNG	873-3535	NOV. 2002
DESIGNED BY	P. S. & E. BY	PHONE	DATE

DEPARTMENT OF TRANSPORTATION
STATE OF HAWAII

APPROVED:

11-22-02
for DIR. OF TRANSPORTATION DATE