
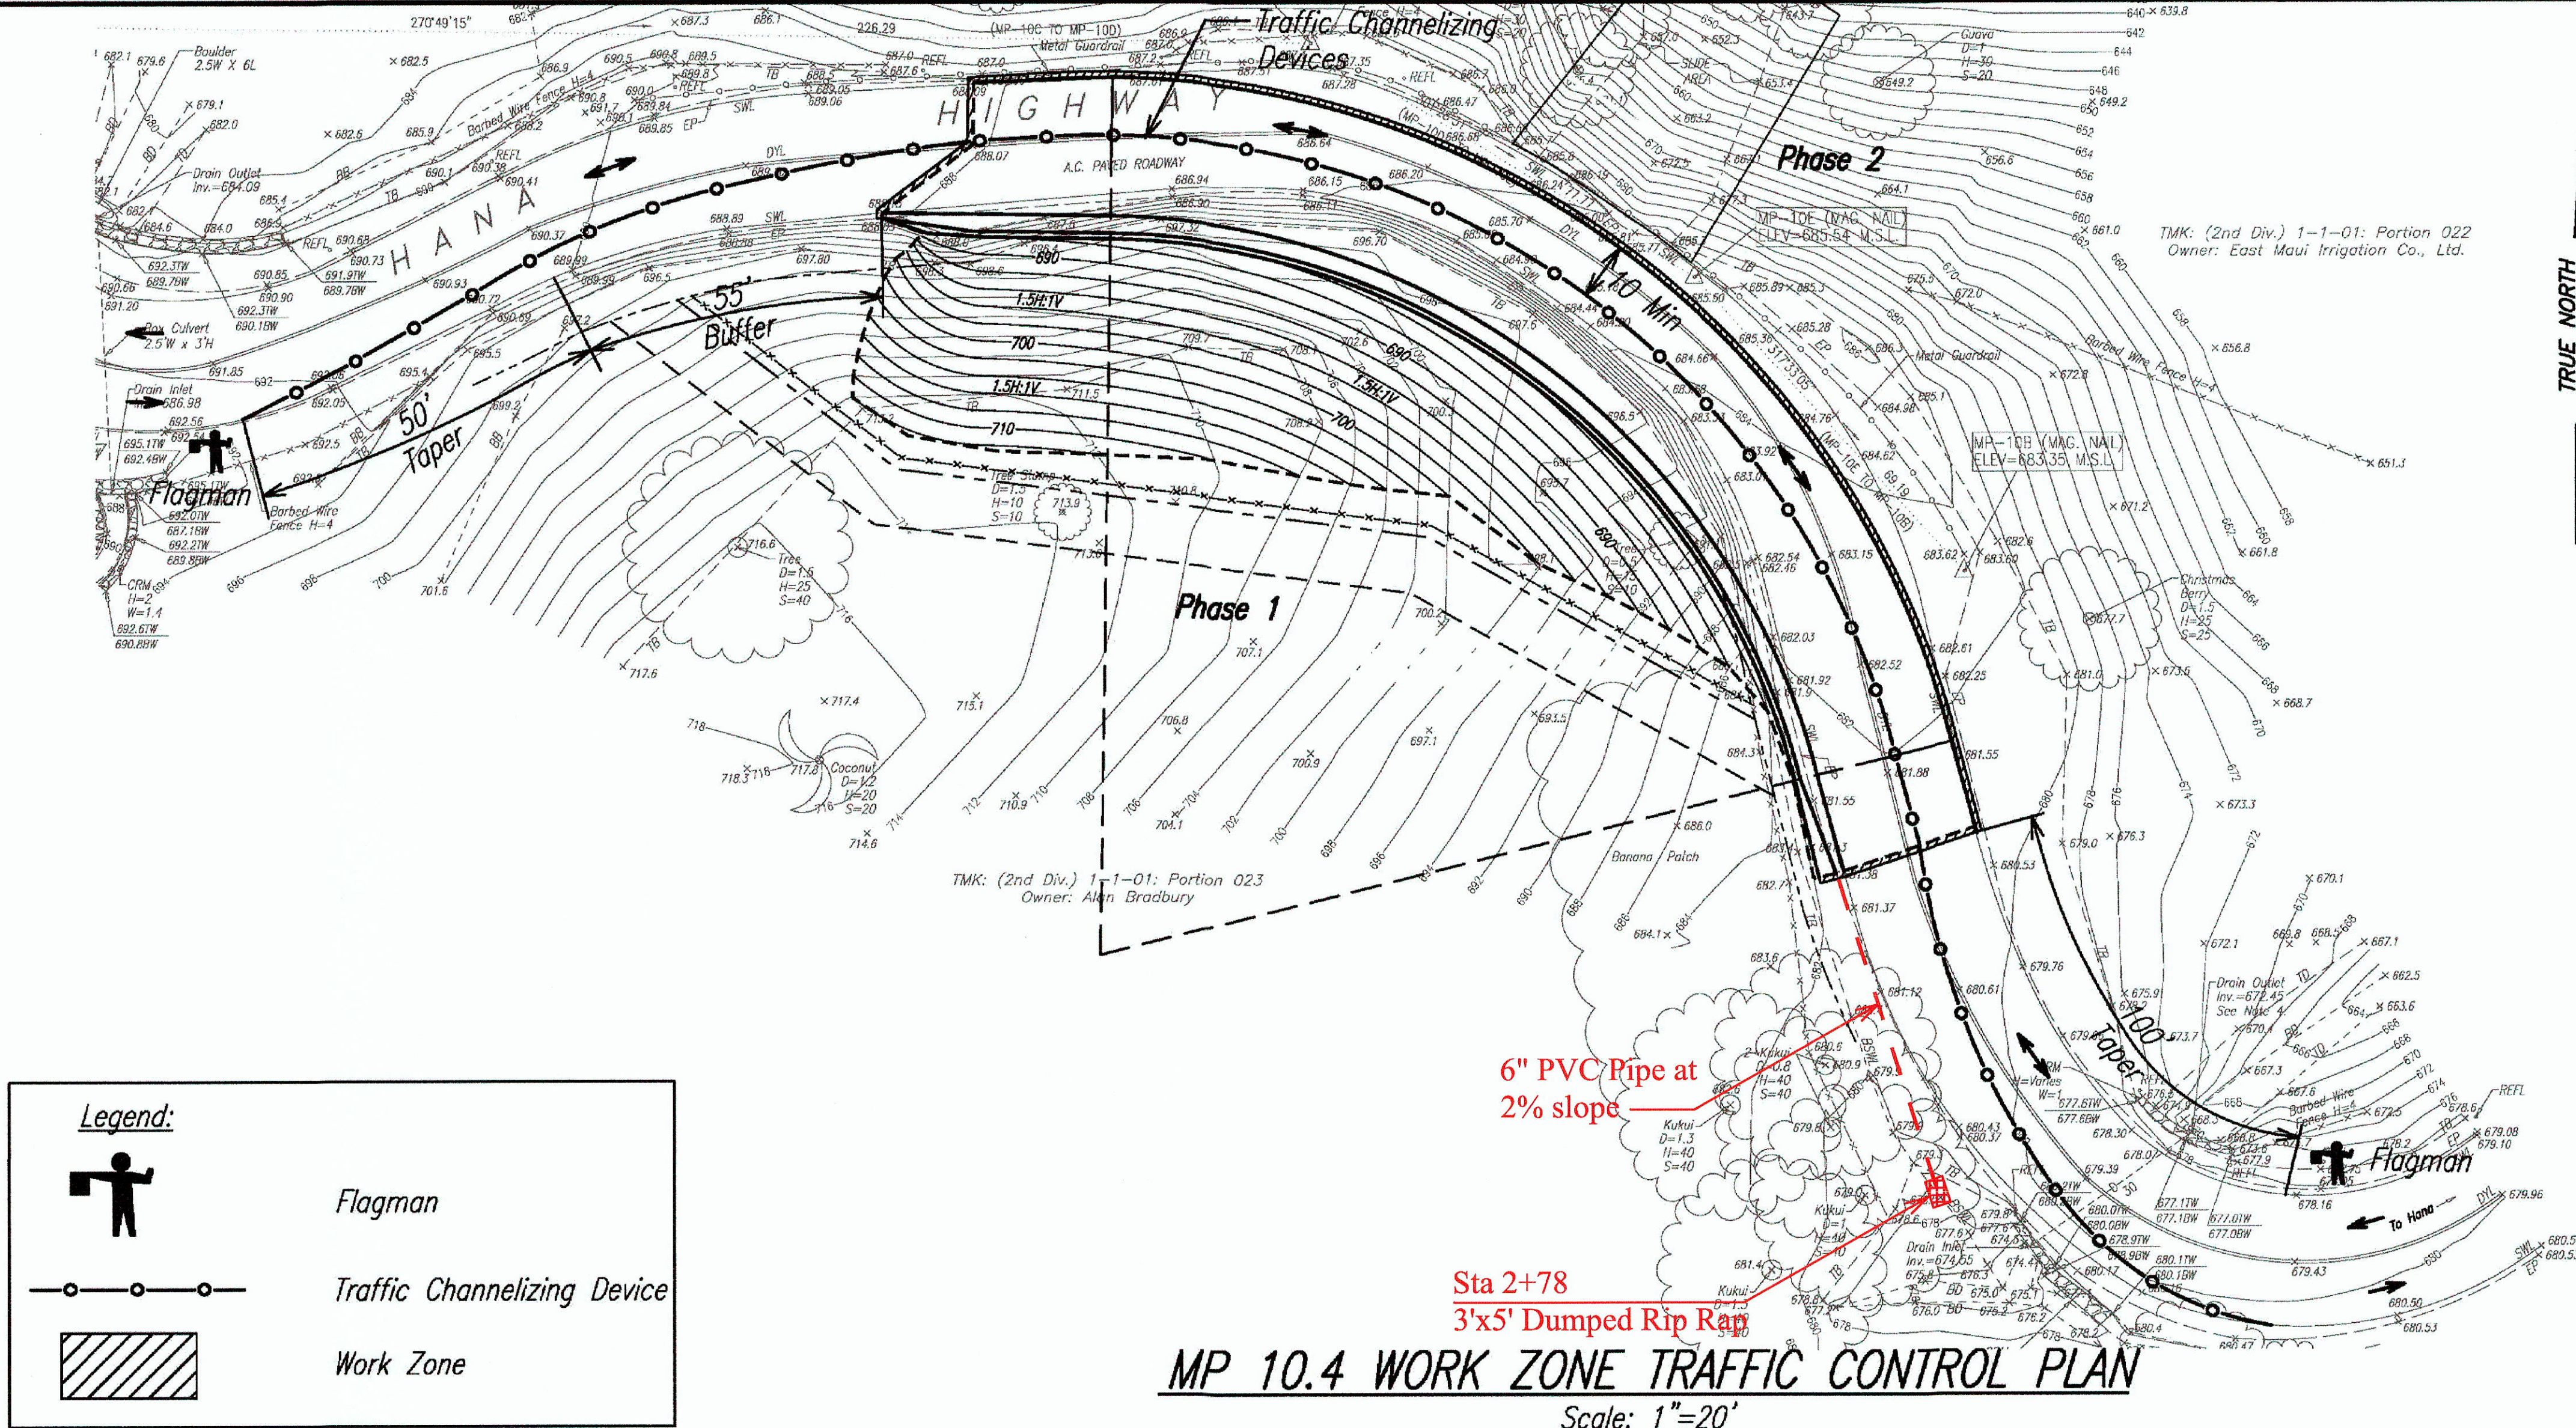


FED. ROAD DIST. NO.	STATE	FED. AID PROJ. NO.	FISCAL YEAR	SHEET NO.	TOTAL SHEETS
MAUI	HAW.	ER-16(008)	2012	13	14

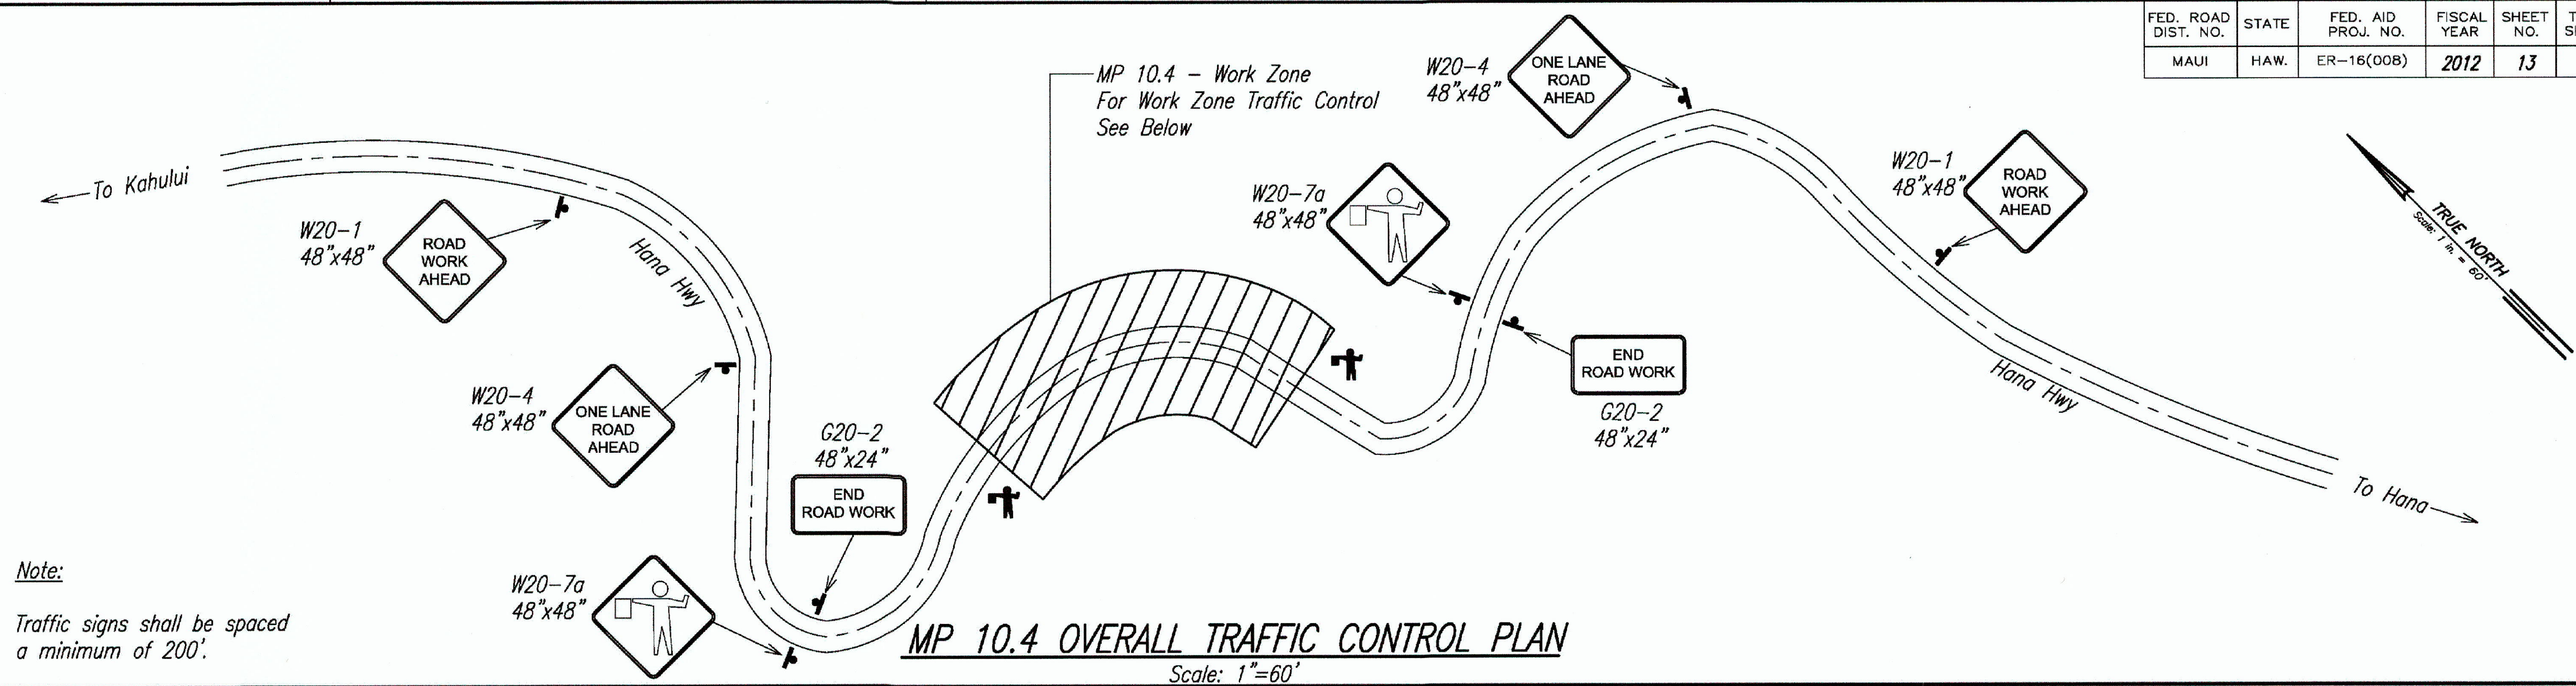


- General Notes For Traffic Control Plan**
1. The Contractor shall make minor adjustments at intersections, driveways, bridges, structures, etc., to fit field conditions.
 2. Cones or delineators shall be extended to a point where they are visible to approaching traffic.
 3. Traffic control devices shall be installed such that the sign or device farthest from the work area is placed first. The others shall then be placed progressively toward the work area.
 4. Regulatory and warning signs within the construction zone that are in conflict with the traffic control plans shall be removed or covered.
 5. Flaggers shall be in sight of each other or in direct communication at all times.
 6. All traffic lanes shall be a minimum of 10-feet wide.
 7. All construction warning signs shall be promptly removed or covered whenever the message is not applicable or not in use.
 8. Cones and delineators shall be spaced at a maximum distance of 20-feet apart. A minimum of six (6) channelizing devices shall be used for each taper length.
 9. Buffer and taper areas on approach to any work area shall be kept clear of vehicles and equipment.

LEGEND FOR AS-BUILT POSTINGS

- Squiggly line for as-built deletion
- Double line for as-built deletion
- Text for as-built posting

AECOM

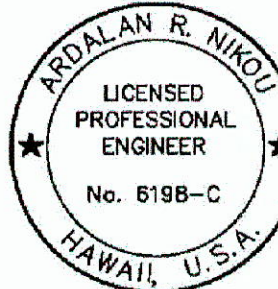

STATE OF HAWAII
DEPARTMENT OF TRANSPORTATION
HIGHWAYS DIVISION

PH 1 - TRAFFIC CONTROL PLAN
(MAUKA WORK)

HANA HIGHWAY EMERGENCY REPAIRS
MILEPOST 10.4



FEDERAL-AID PROJECT NO. ER-16(008)
Scale: As Noted Date: July 10, 2012

SHEET No. 13 OF 14 SHEETS

EXPIRATION DATE OF THE LICENSE 4/30/2014
THIS WORK WAS PREPARED BY ME OR UNDER MY SUPERVISION.

"AS-BUILT"

FED. ROAD DIST. NO.	STATE	FED. AID PROJ. NO.	FISCAL YEAR	SHEET NO.	TOTAL SHEETS
MAUI	HAW.	ER-16(00B)	2012	14	14

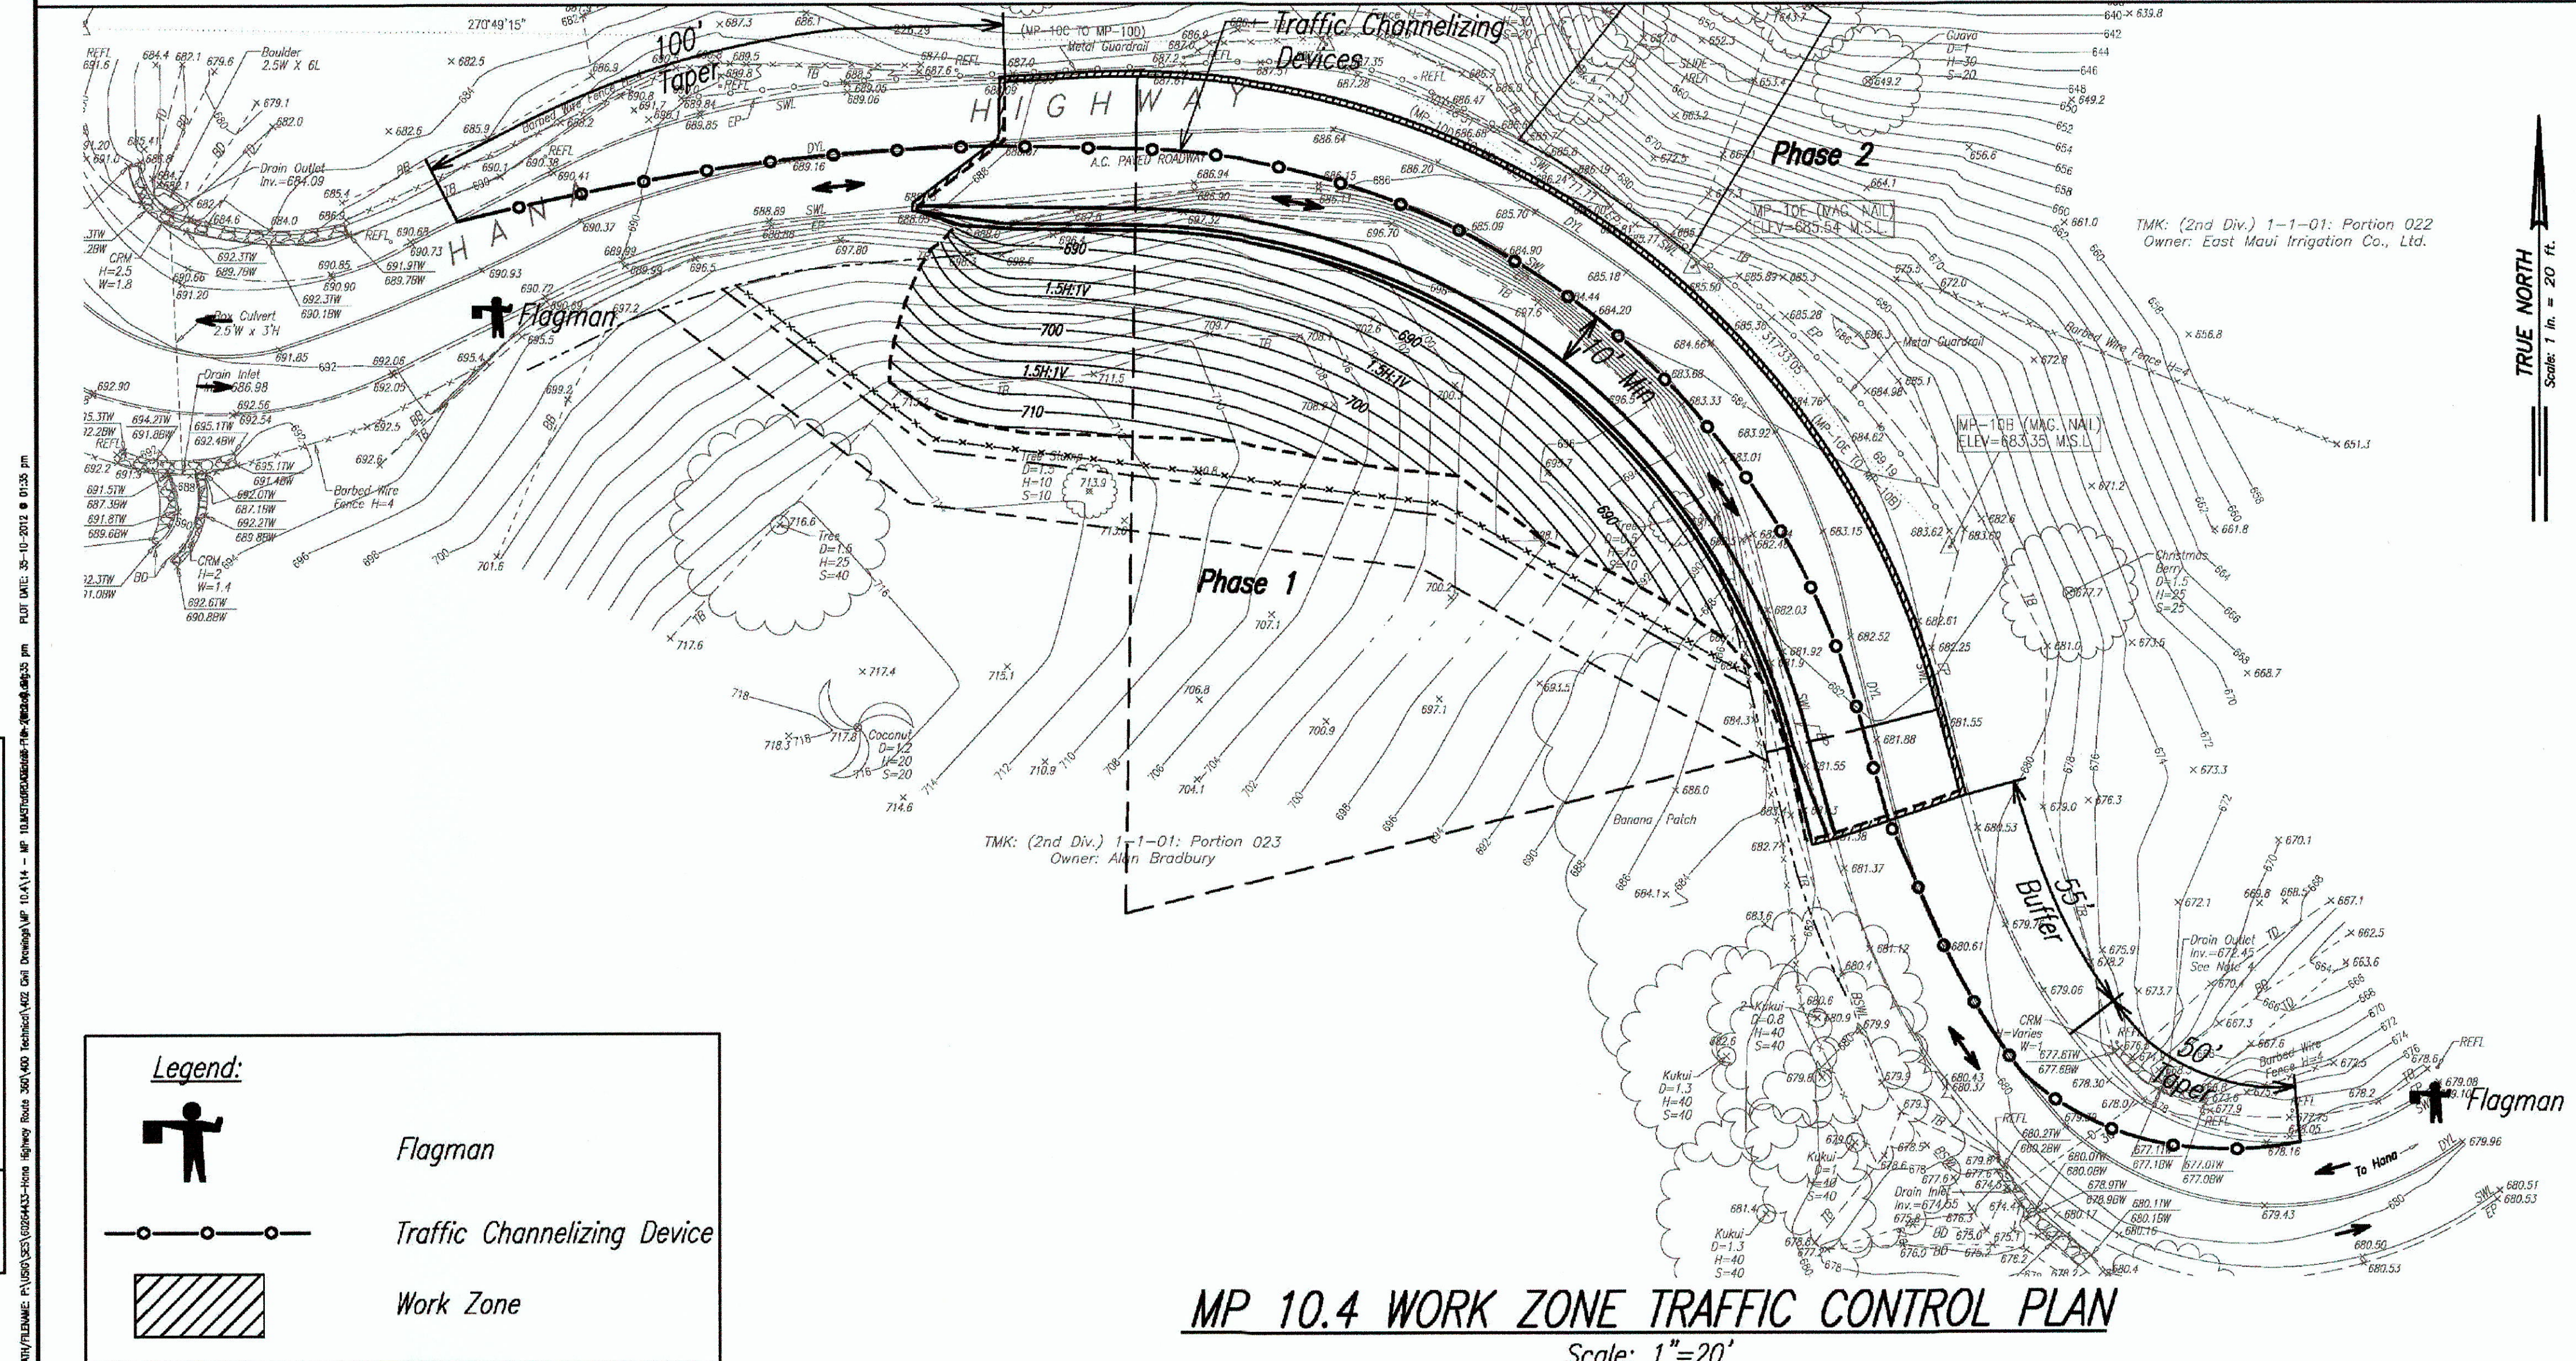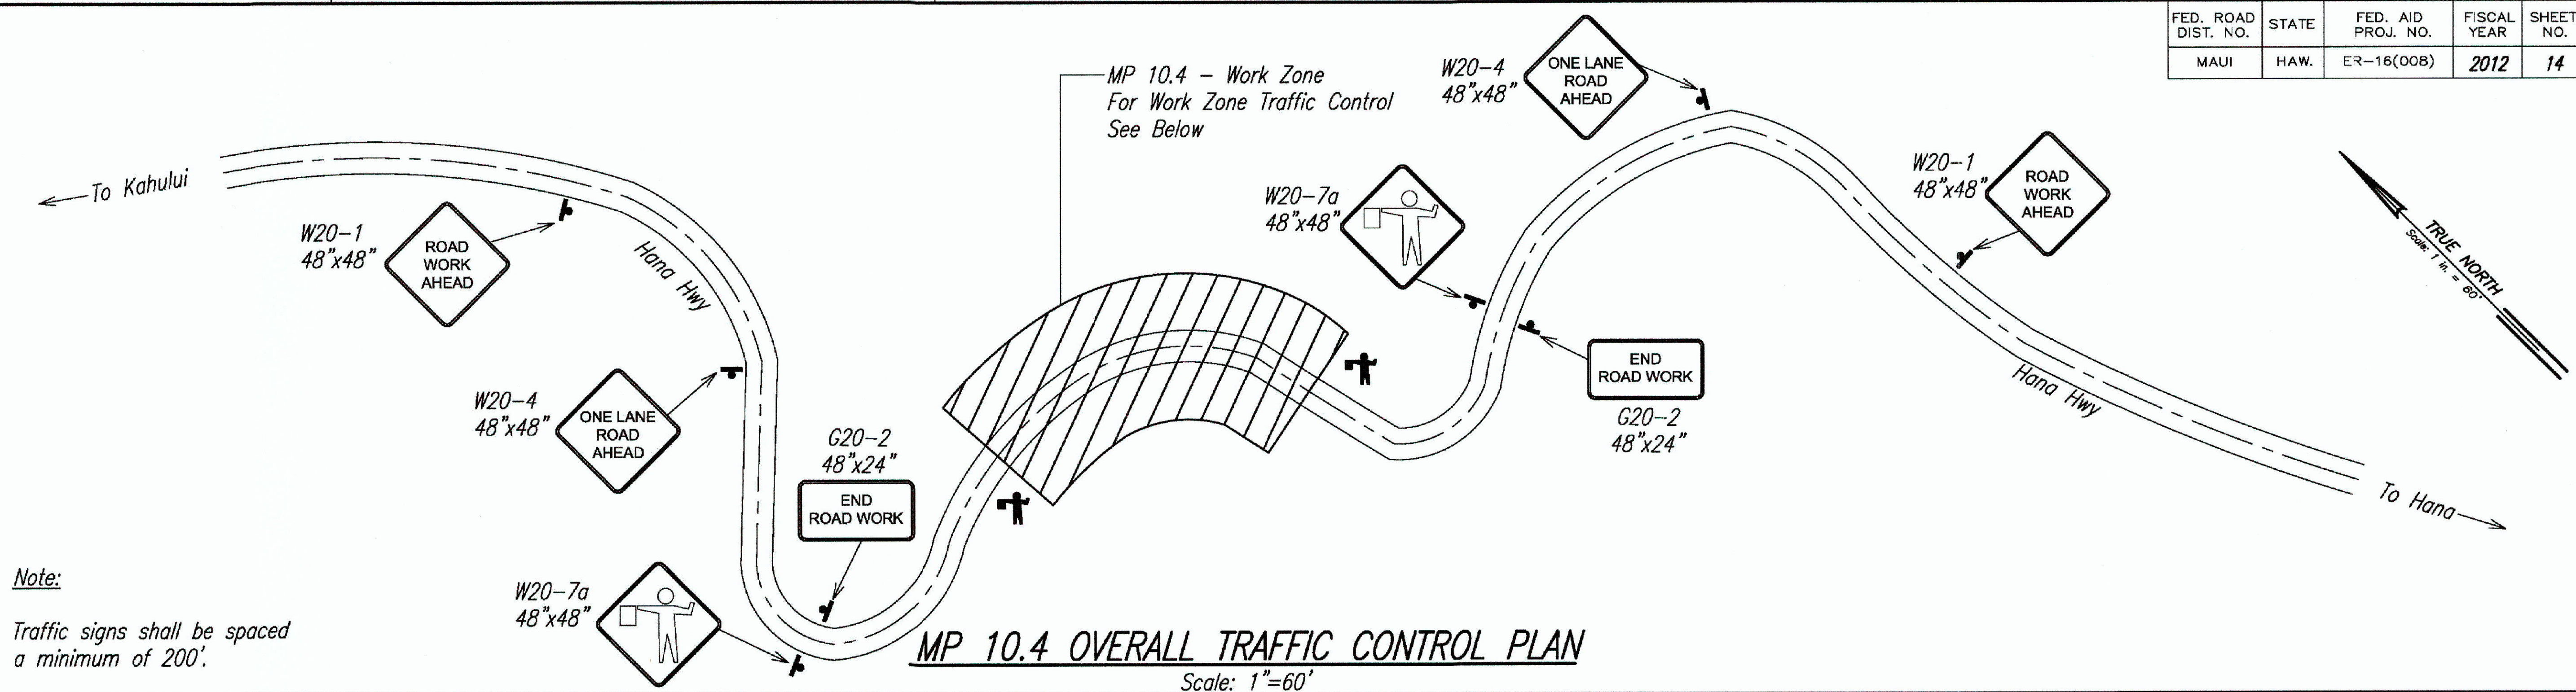

DATE	_____
DESIGNED BY	_____
CHECKED BY	_____
NOTED BY	_____
QUANTITIES BY	_____
NO.	_____

Legend:

- Flagman
- Traffic Channelizing Device
- Work Zone

LEGEND FOR AS-BUILT POSTINGS

- Squiggly line for as-built deletion
- Double line for as-built deletion
- Text for as-built posting

AECOM

ARJALAN R. NIKOU
LICENSED PROFESSIONAL ENGINEER
No. 6198-C
HAWAII, U.S.A.

STATE OF HAWAII
DEPARTMENT OF TRANSPORTATION
HIGHWAYS DIVISION

PH 2 - TRAFFIC CONTROL PLAN
(MAKAI WORK)
HANA HIGHWAY EMERGENCY REPAIRS
MILEPOST 10.4
FEDERAL-AID PROJECT NO. ER-16(00B)
Scale: As Noted Date: July 10, 2012

SHEET No. 14 OF 14 SHEETS

"AS-BUILT"