FED. ROAD DIST. NO.	STATE	PROJ. NO.	FISCAL YEAR	SHEET NO.	TOTAL SHEETS
HAWAII	HAW.	HWY-M-06-98	2000	4	14

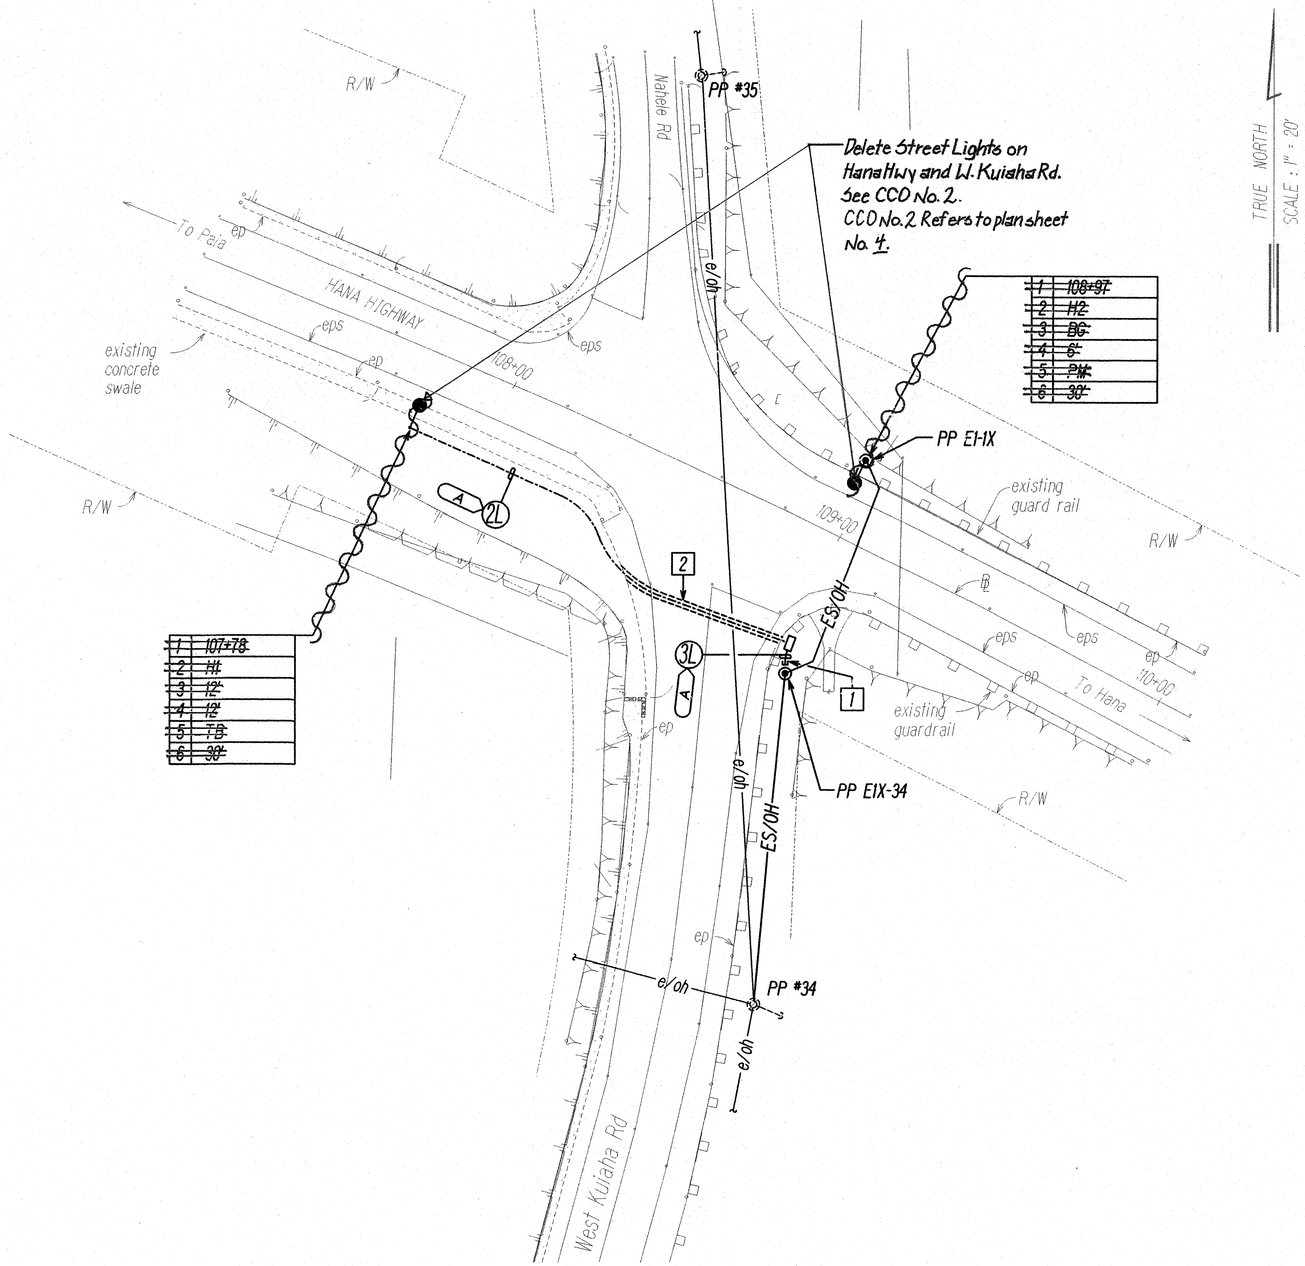

1	~~108+97~~
2	~~H2~~
3	~~BG~~
4	~~6'~~
5	~~PM~~
6	~~30'~~

1	~~107+78~~
2	~~H1~~
3	~~12'~~
4	~~12'~~
5	~~TB~~
6	~~30'~~

Notes:

1. Riser up pole per MECo requirements. See B/E-12 for Typical Pole Riser Detail.
2. Sawcut existing asphalt pavement as required to install ductline. Repair to match existing condition.

REDUCED PLAN
(HALF SIZE)
0 1 2 3
3 INCHES ON ORIGINAL PLAN

ORIGINAL PLAN	SURVEY PLOTTED BY	DATE
	DRAWN BY	"
NOTE BOOK	TRACED BY	"
	DESIGNED BY	"
	QUANTITIES BY	"
No.	CHECKED BY	"

GARY I. FUNASAKI
LICENSED PROFESSIONAL ENGINEER
No. 4195-E
HAWAII, U.S.A.
19 MAY 2000
This Work was Prepared by Me or Under My Supervision

STATE OF HAWAII
DEPARTMENT OF TRANSPORTATION
HIGHWAYS DIVISION

HANA HWY @ WEST KUIAHA RD
LIGHTING PLAN

Street Lights at
Various Highway Locations
Project No. HWY-M-06-98

Scale: 1"=20' Date: May, 2000

SHEET No. E-2 OF 12 SHEETS

"AS-BUILT"