FED. ROAD DIST. NO.	STATE	PROJ. NO.	FISCAL YEAR	SHEET NO.	TOTAL SHEETS
HAWAII	HAW.	HWY-M-06-98	2000	9	14

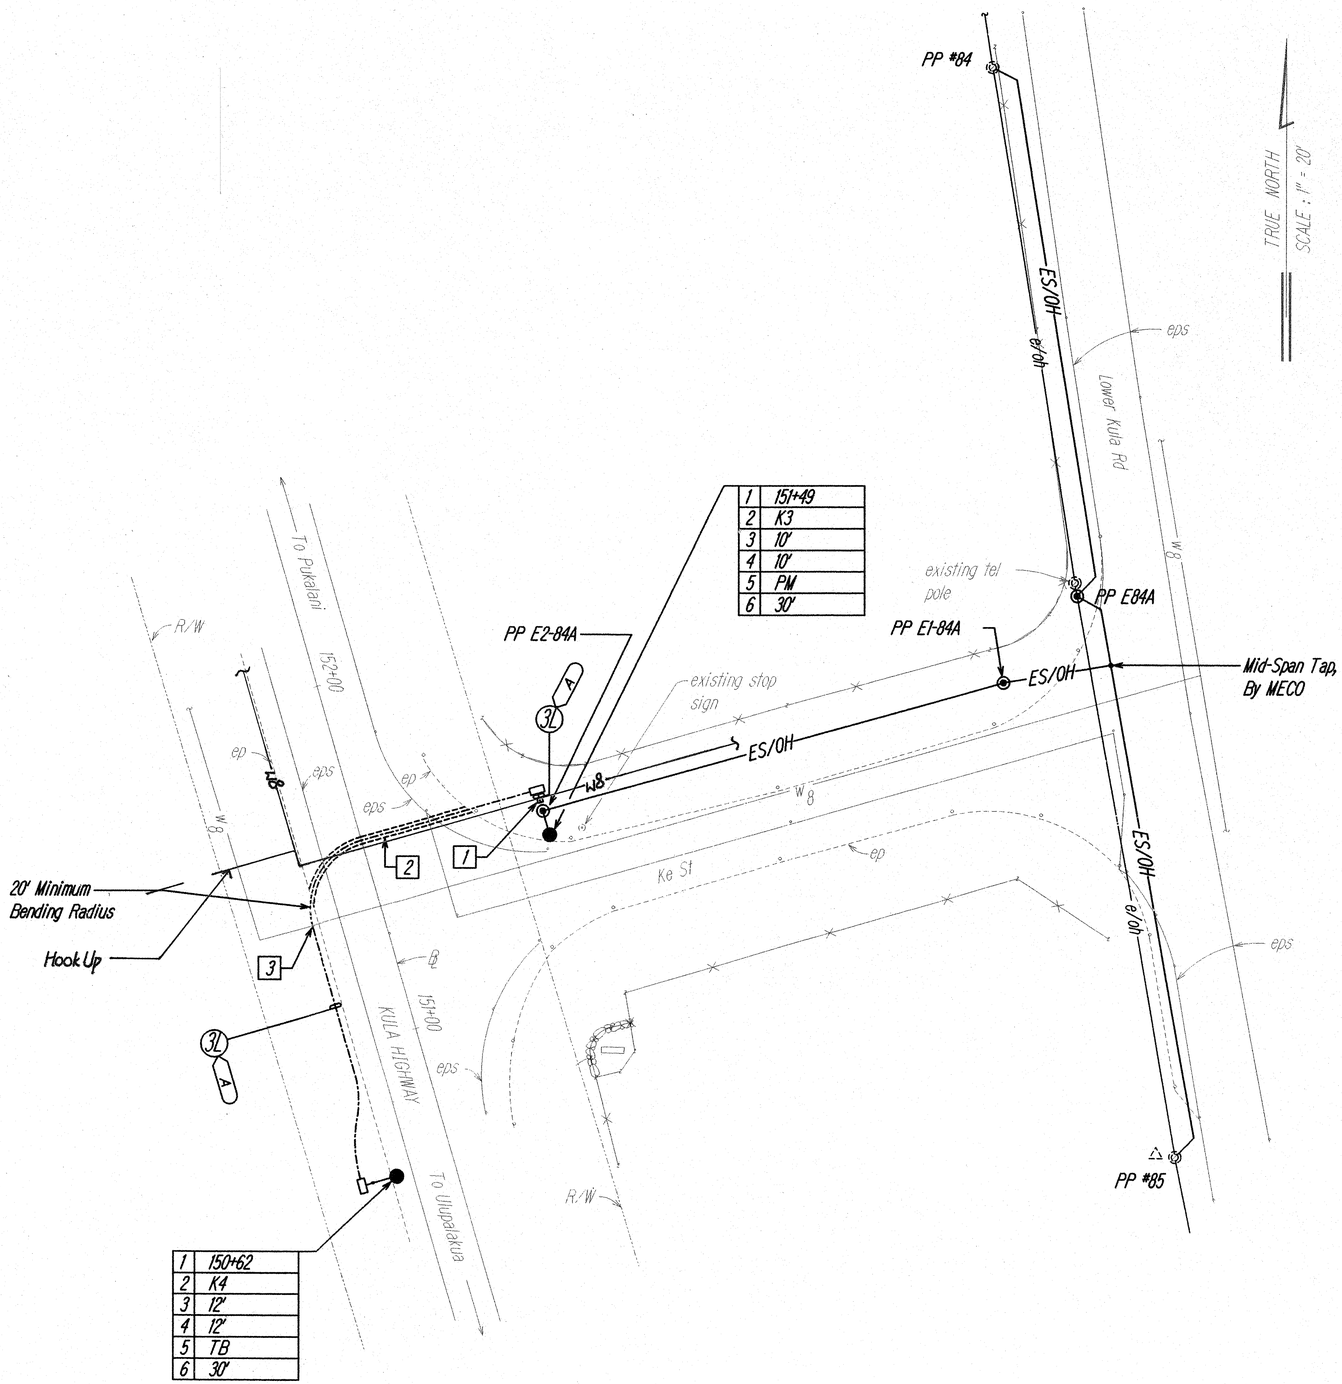

1	151+49
2	K3
3	10'
4	10'
5	PM
6	30'

1	150+62
2	K4
3	12'
4	12'
5	TB
6	30'

Notes:

1. Riser up pole per MECo requirements. See B/E-12 for Typical Pole Riser Detail.
2. Sawcut existing asphalt pavement as required to install ductline. Repair to match existing condition.
3. Ductline to cross under existing water line.

REDUCED PLAN
(HALF SIZE)
0 1 2 3
3 INCHES ON ORIGINAL PLAN

ORIGINAL PLAN	SURVEY PLOTTED BY	DATE
	DRAWN BY	
NOTE BOOK	TRACED BY	
	DESIGNED BY	
	QUANTITIES BY	
No.	CHECKED BY	

19 MAY 100 12:36:19 TM Z:\Kula\Hwy\Lighting\HWY-M-06-98\Sheet 9.dgn

GARY I. FUNASAKI
LICENSED PROFESSIONAL ENGINEER
No. 4195-E
HAWAII, U.S.A.

19 May 2000

This Work was Prepared by Me or Under My Supervision

STATE OF HAWAII
DEPARTMENT OF TRANSPORTATION
HIGHWAYS DIVISION

KULA HWY @ KE ST
LIGHTING PLAN

Street Lights at
Various Highway Locations
Project No. HWY-M-06-98

Scale: 1"=20' Date: May, 2000

SHEET No. E-7 OF 12 SHEETS

"AS-BUILT"