FED. ROAD DIST. NO.	STATE	FED. AID PROJ. NO.	FISCAL YEAR	SHEET NO.	TOTAL SHEETS
HAWAII	HAW.	NH-0900(080)	2013	30	47

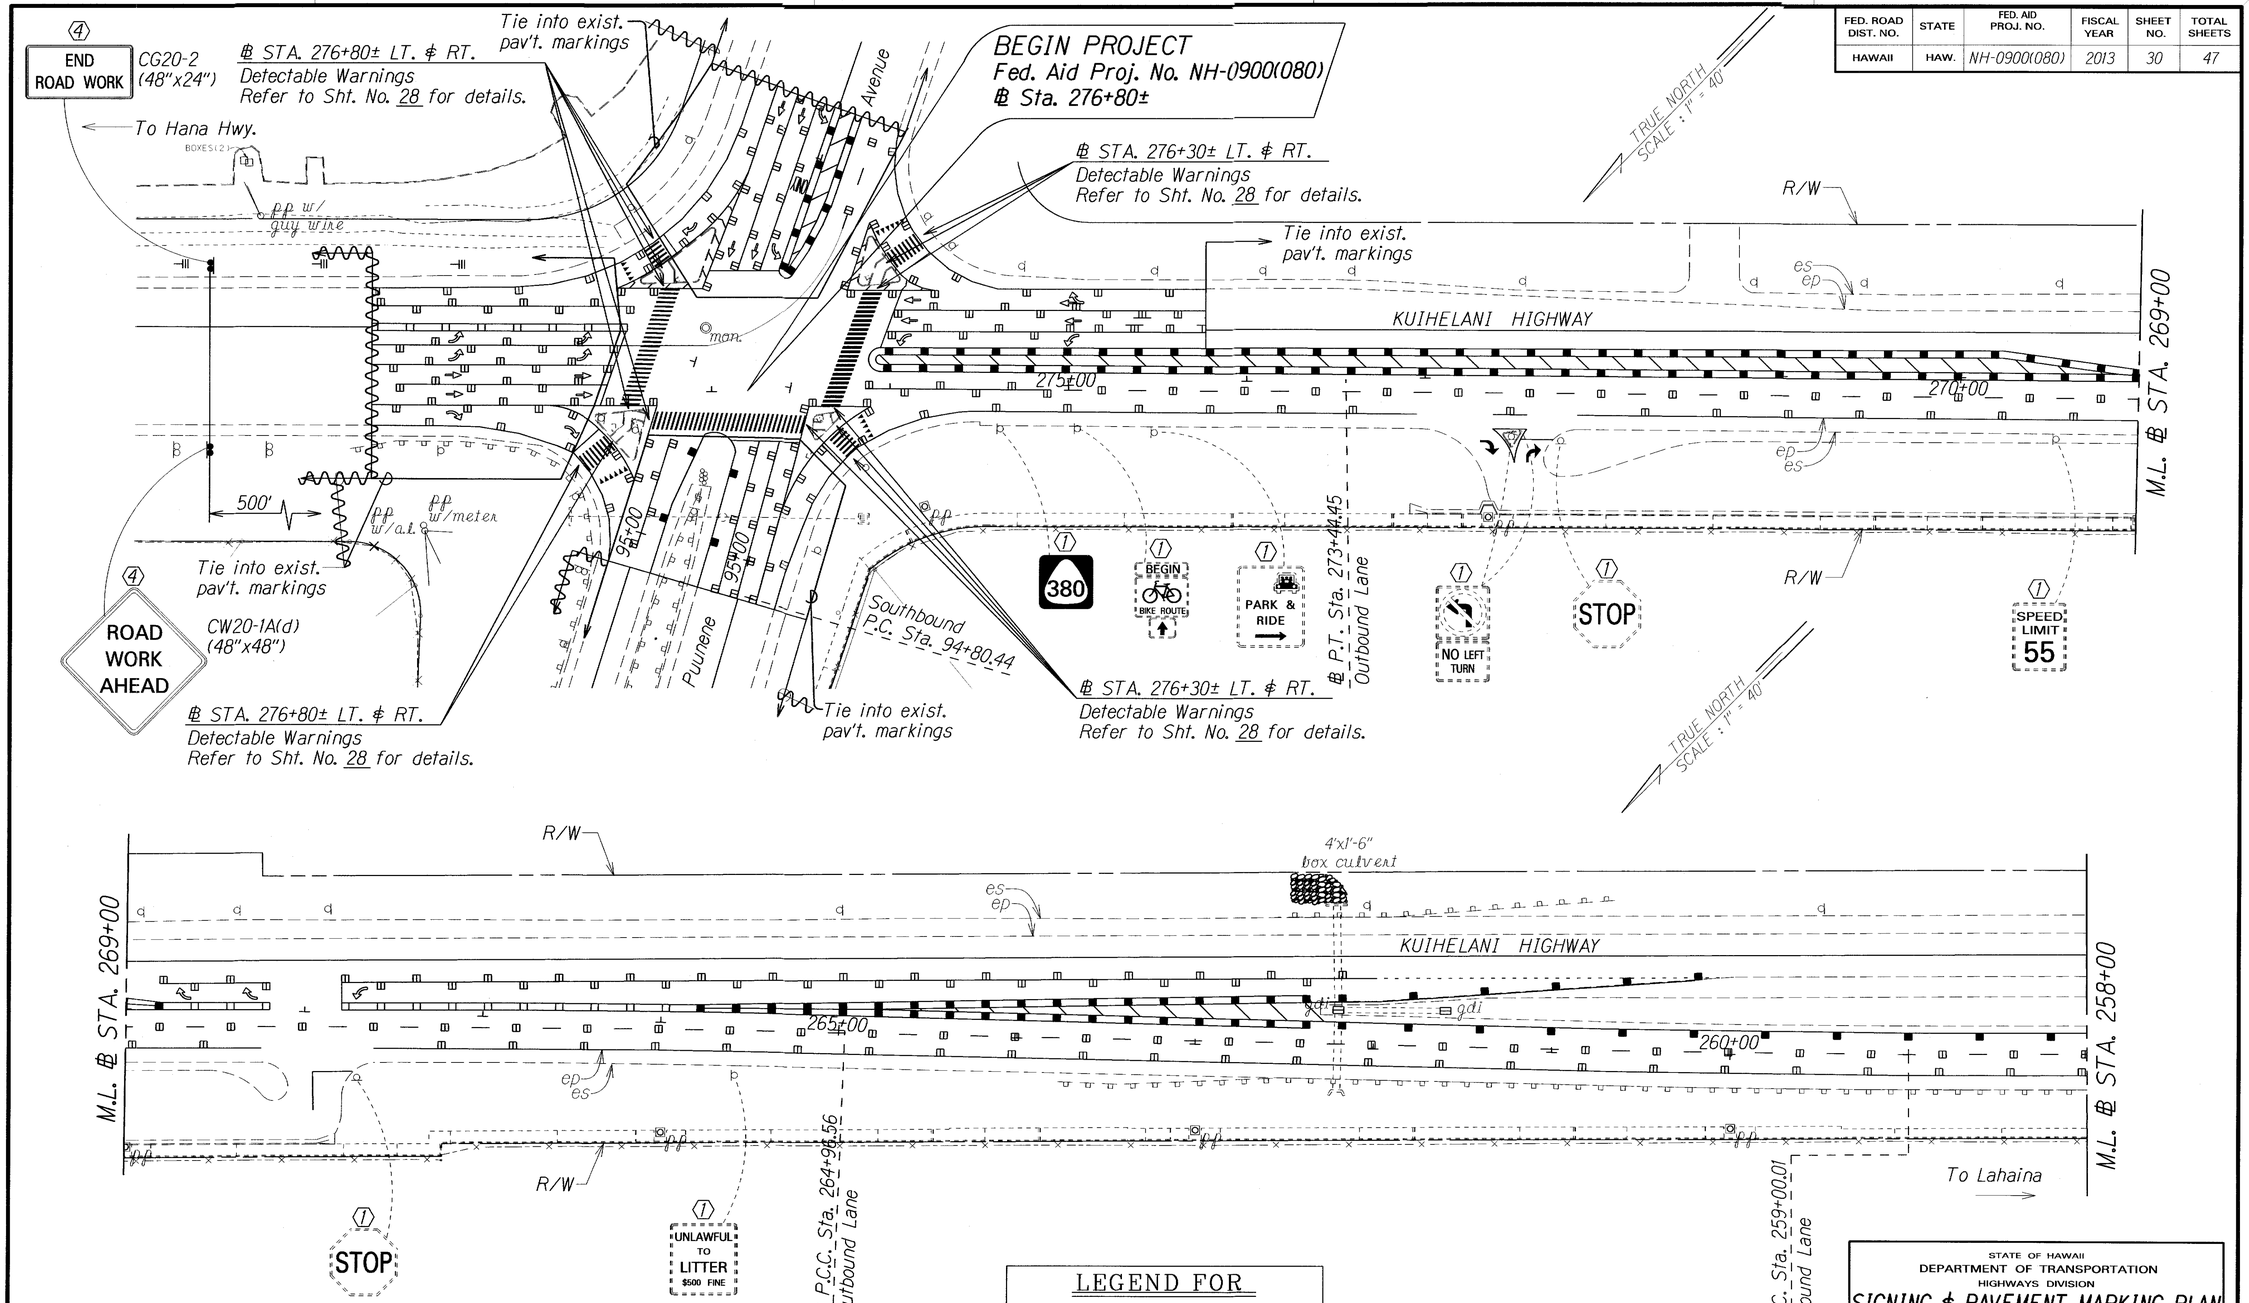

ORIGINAL PLAN	SURVEY PLOTTED BY	DATE
	DRAWN BY JS	
	TRACED BY	
NOTE BOOK	DESIGNED BY Land	
	QUANTITIES BY	
	CHECKED BY	

LEGEND FOR AS-BUILT POSTINGS

~~^^^^~~	Squiggly line for as-built deletion
~~100.00~~	Double line for as-built deletion
Roadway	Text for as-built posting

KEY:

1. Exist. Sign(s) & Post(s) to Remain
2. Remove Exist. Sign(s) & Post(s)
3. Remove Exist. & Install New Sign(s) & Post(s)
4. Install New Sign(s) & Post(s)

STATE OF HAWAII
DEPARTMENT OF TRANSPORTATION
HIGHWAYS DIVISION

SIGNING & PAVEMENT MARKING PLAN

KUIHELANI HIGHWAY & HONOAPIILANI HIGHWAY
PAVEMENT PREVENTIVE MAINTENANCE
Puunene Avenue to Honoapiilani Highway and Kuihelani Highway to Kapoli Street
Federal-Aid Project No. NH-0900(080)

Scale: 1" =40' Date: May, 2012

SHEET No. 1 OF 18 SHEETS

"AS-BUILT"

FED. ROAD DIST. NO.	STATE	FED. AID PROJ. NO.	FISCAL YEAR	SHEET NO.	TOTAL SHEETS
HAWAII	HAW.	NH-0900(080)	2013	31	47

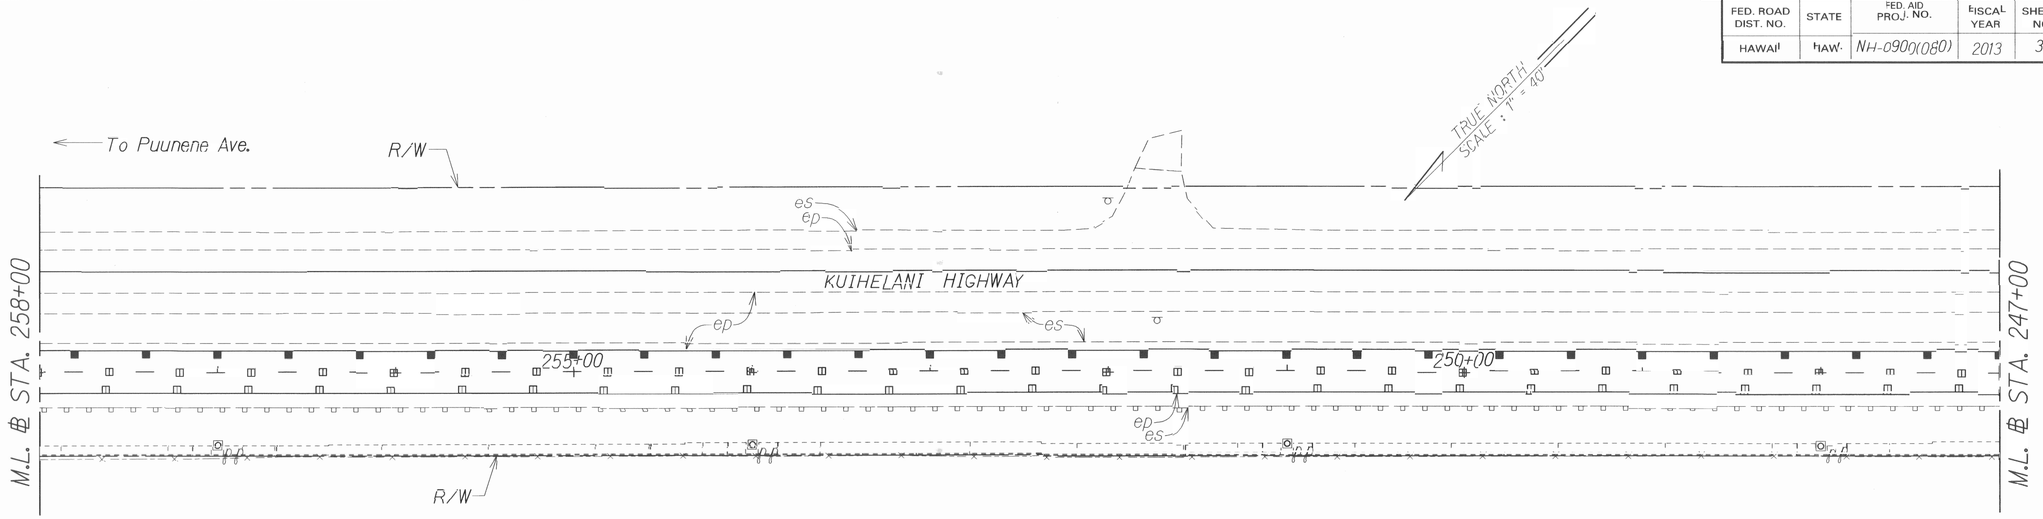

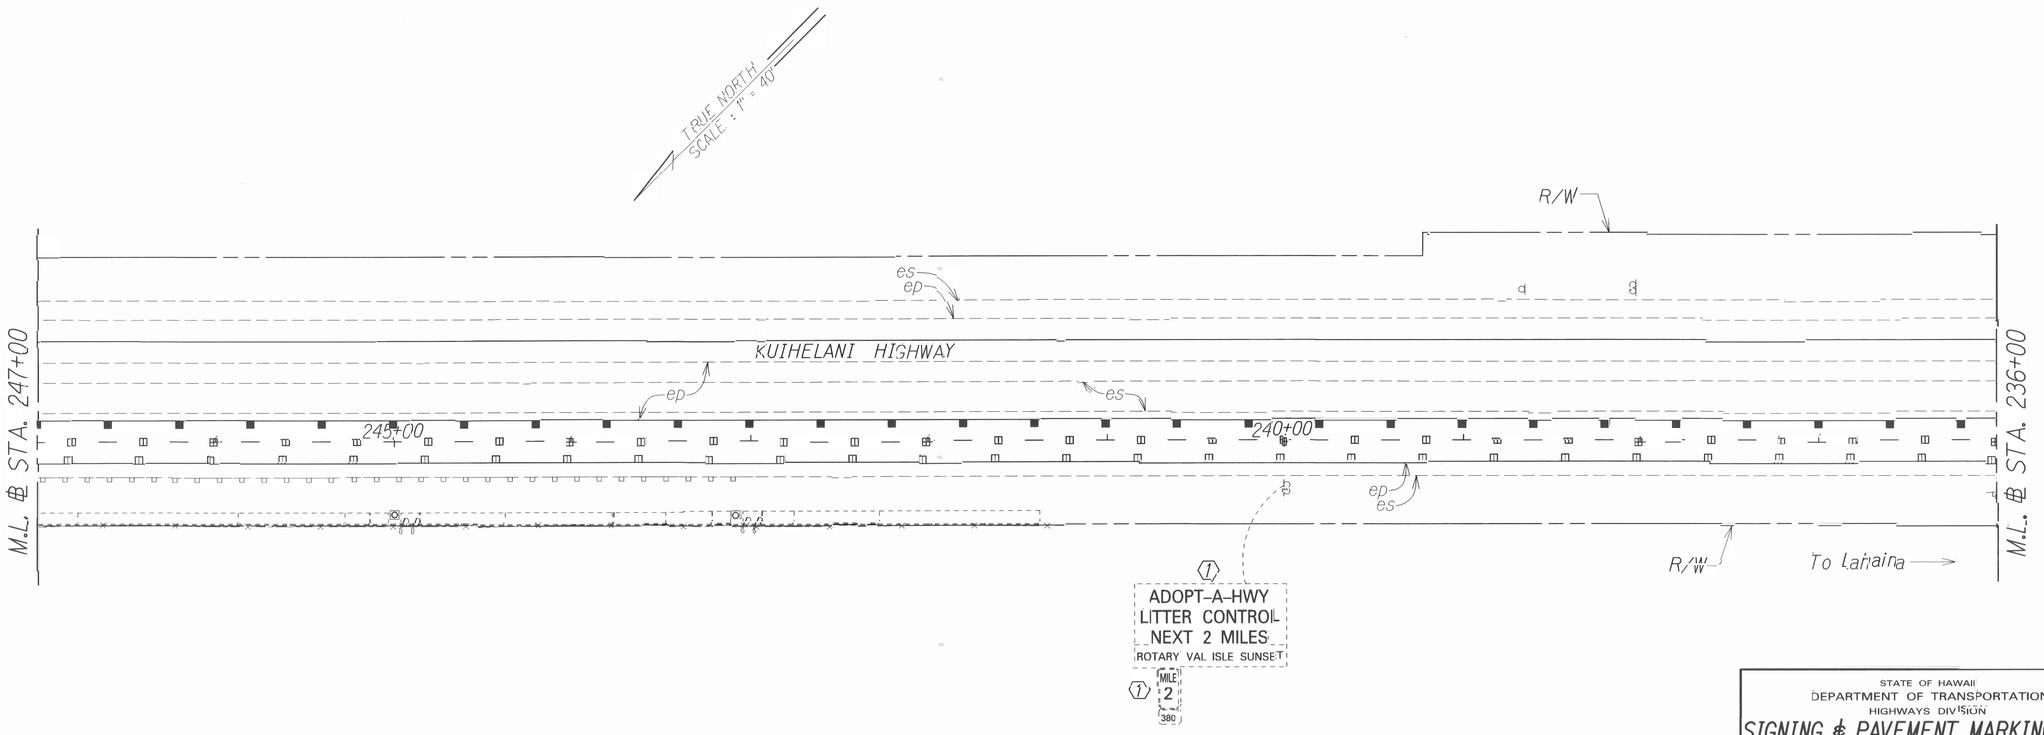

ORIGINAL PLANS	SURVEY PLOTTED BY	DATE
	DRAWN BY	
	TRACED BY	
NOTE BOOK	DESIGNED BY	
	QUANTITIES BY	
	CHECKED BY	

KEY:

1. Exist. Sign(s) & Post(s) to Remain
2. Remove Exist. Sign(s) & Post(s)
3. Remove Exist. & Install New Sign(s) & Post(s)
4. Install New Sign(s) & Post(s)

STATE OF HAWAII
DEPARTMENT OF TRANSPORTATION
HIGHWAYS DIVISION

SIGNING & PAVEMENT MARKING PLAN

KUIHELANI HIGHWAY & HONOAPIILANI HIGHWAY
PAVEMENT PREVENTIVE MAINTENANCE
Puunene Avenue to Honoapiilani Highway
and Kuihelani Highway to Kapoli Street
Federal-Aid Project No. NH-0900(080)

Scale: 1" =40' Date: May, 2012

SHEET No. 2 OF 18 SHEETS

FED. ROAD DIST. NO.	STATE	FED. AID PROJ. NO.	FISCAL YEAR	SHEET NO.	TOTAL SHEETS
HAWAII	HAW.	NH-0900(080)	2013	32	47

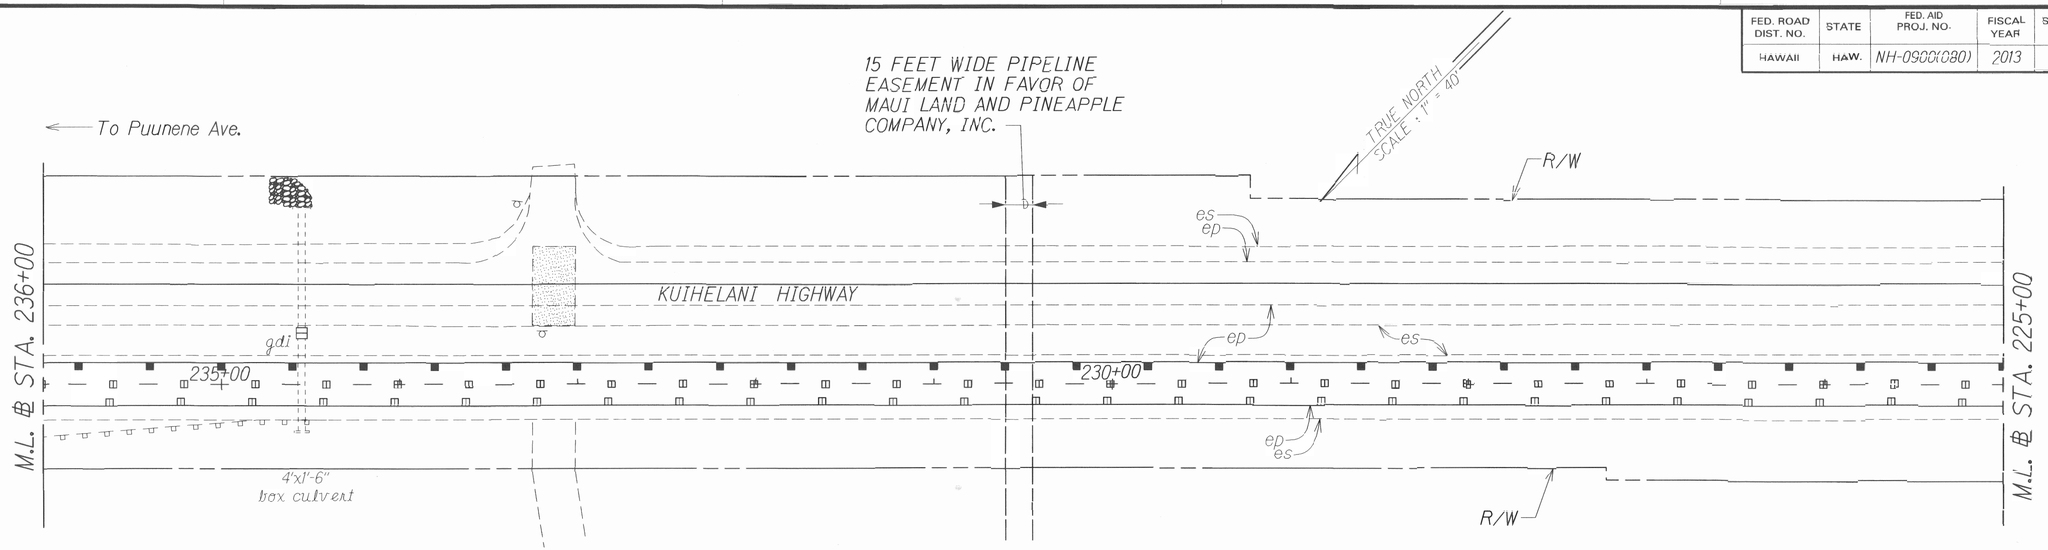

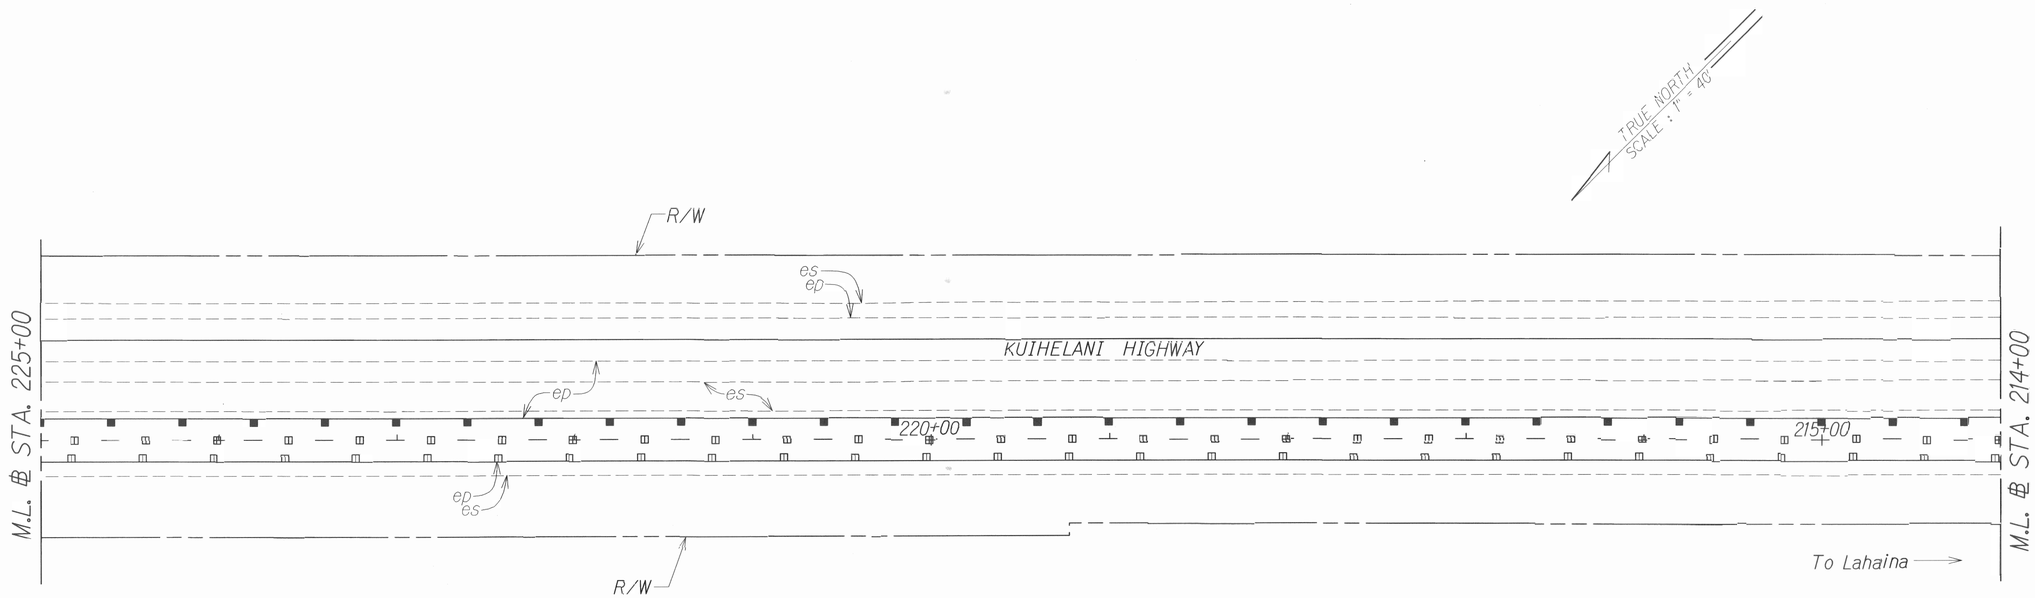

ORIGINAL PLAN

SURVEY PLOTTED BY
DRAWN BY
TRACED BY
DESIGNED BY
QUANTITIES BY
CHECKED BY
DATE: 7/12

NOTE BOOK

KEY:

1. Exist. Sign(s) & Post(s) to Remain
2. Remove Exist. Sign(s) & Post(s)
3. Remove Exist. & Install New Sign(s) & Post(s)
4. Install New Sign(s) & Post(s)

STATE OF HAWAII
DEPARTMENT OF TRANSPORTATION
HIGHWAYS DIVISION

SIGNING & PAVEMENT MARKING PLAN

KUIHELANI HIGHWAY & HONOAPIILANI HIGHWAY
PAVEMENT PREVENTIVE MAINTENANCE
Puunene Avenue to Honoapiilani Highway and Kuihelani Highway to Kapoli Street
Federal-Aid Project No. NH-0900(080)

Scale: 1" =40' Date: May, 2012

SHEET No. 3 OF 18 SHEETS

FED. ROAD DIST. NO.	STATE	FED. AID PROJ. NO.	FISCAL YEAR	SHEET NO.	TOTAL SHEETS
HAWAII	HAW.	NH-0900(080)	2013	33	47

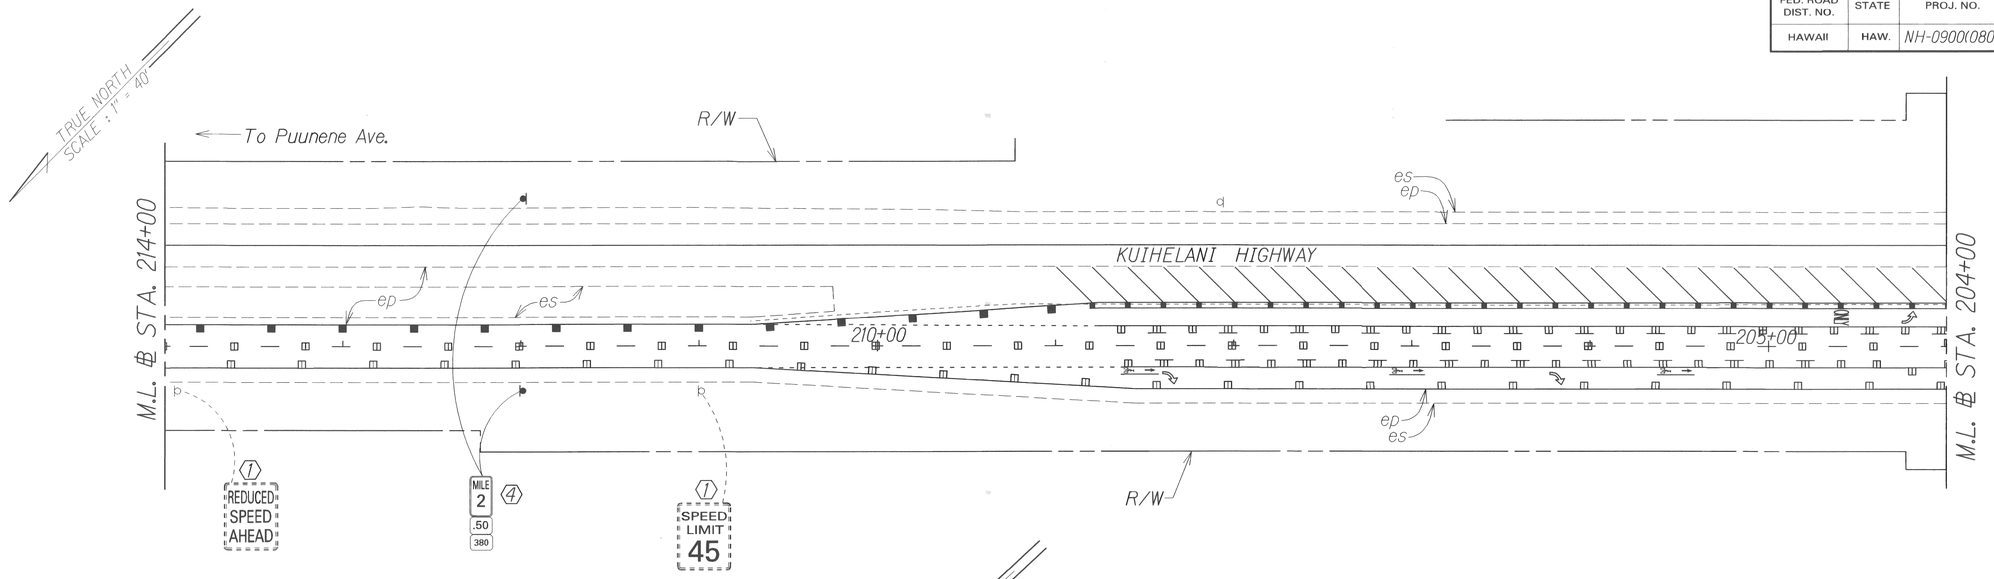

ORIGINAL PLAN	SURVEY PLOTTED BY	DATE 7/12
	DRAWN BY	
	TRACED BY	
NOTE BOOK	DESIGNED BY Trish G.	
	QUANTITIES BY	
	CHECKED BY	

STATE OF HAWAII
DEPARTMENT OF TRANSPORTATION
HIGHWAYS DIVISION

SIGNING & PAVEMENT MARKING PLAN

KUIHELANI HIGHWAY & HONOAPIILANI HIGHWAY
PAVEMENT PREVENTIVE MAINTENANCE
Puunene Avenue to Honoapiilani Highway and Kuihelani Highway to Kapoli Street
Federal-Aid Project No. NH-0900(080)
Scale: 1" =40' Date: May, 2012

SHEET No. 4 OF 18 SHEETS

KEY:

⟨1⟩ Exist. Sign(s) & Post(s) to Remain
⟨2⟩ Remove Exist. Sign(s) & Post(s)
⟨3⟩ Remove Exist. & Install New Sign(s) & Post(s)
⟨4⟩ Install New Sign(s) & Post(s)

FED. ROAD DIST. NO.	STATE	FED. AID PROJ. NO.	FISCAL YEAR	SHEET NO.	TOTAL SHEETS
HAWAII	HAW.	NH-0900(080)	2013	34	47

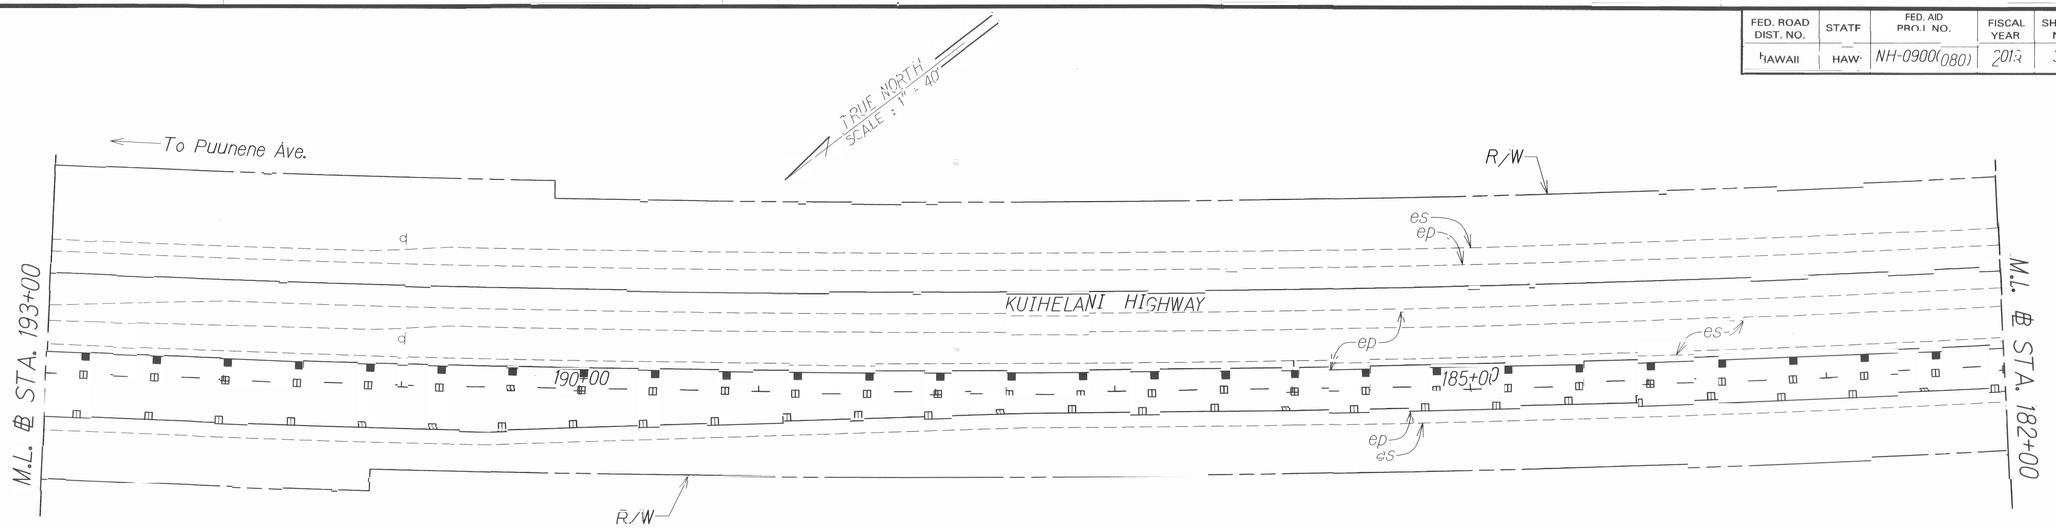

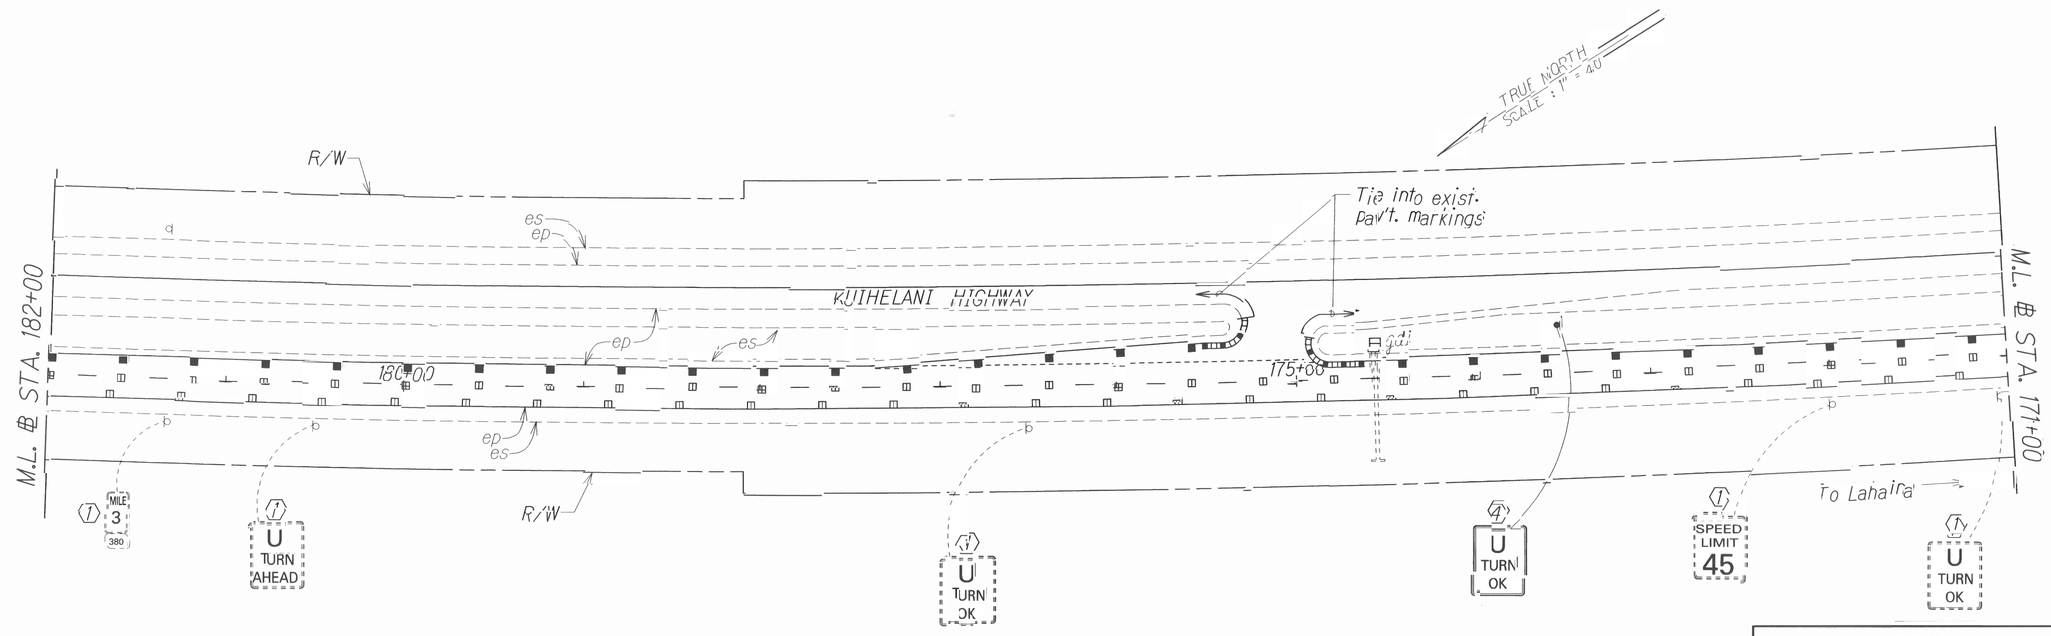

KEY:

1. Exist. Sign(s) & Post(s) to Remain
2. Remove Exist. Sign(s) & Post(s)
3. Remove Exist. & Install New Sign(s) & Post(s)
4. Install New Sign(s) & Post(s)

STATE OF HAWAII
DEPARTMENT OF TRANSPORTATION
HIGHWAYS DIVISION

SIGNING & PAVEMENT MARKING PLAN

KUIHELANI HIGHWAY & HONOAPIILANI HIGHWAY
PAVEMENT PREVENTIVE MAINTENANCE
Puunene Avenue to Honoapiilani Highway and Kuihelani Highway to Kapoli Street
Federal-Aid Project No. NH-0900(080)

Scale: 1" = 40' Date: May, 2012

SHEET No. 5 OF 18 SHEETS

ORIGINAL PLAN	SURVEY PLOTTED BY	DATE 7/11
	DRAWN BY	
NOTE BOOK	TRACED BY	
	DESIGNED BY	
	QUANTITIES BY	
	CHECKED BY	

FED. ROAD DIST. NO.	STATE	FED. AID PROJ. NO.	FISCAL YEAR	SHEET NO.	TOTAL SHEETS
HAWAII	HAW.	NH-0900(080)	2013	35	47

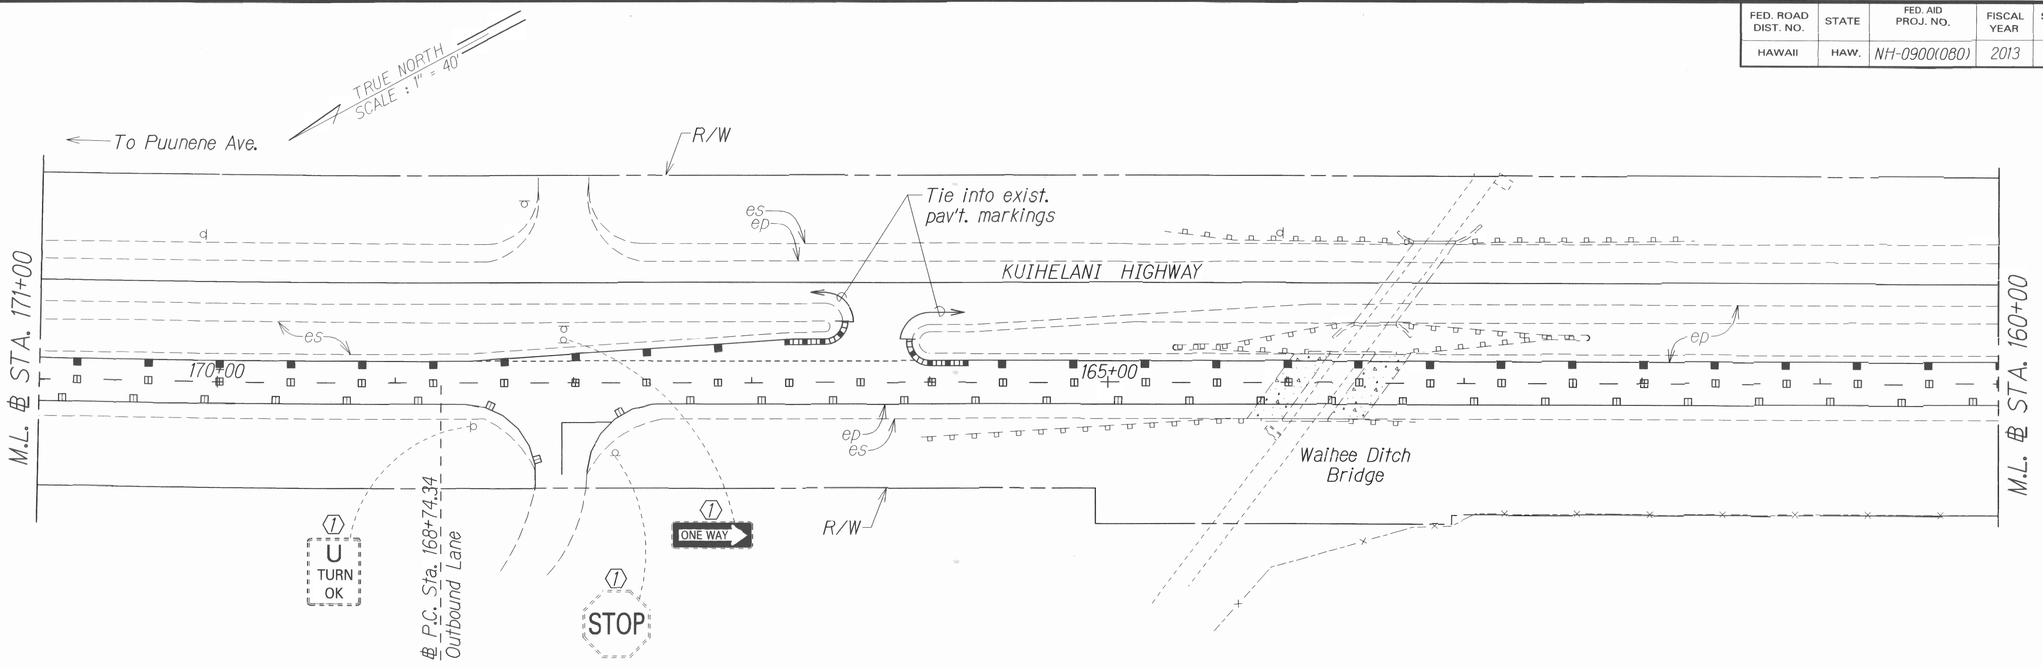

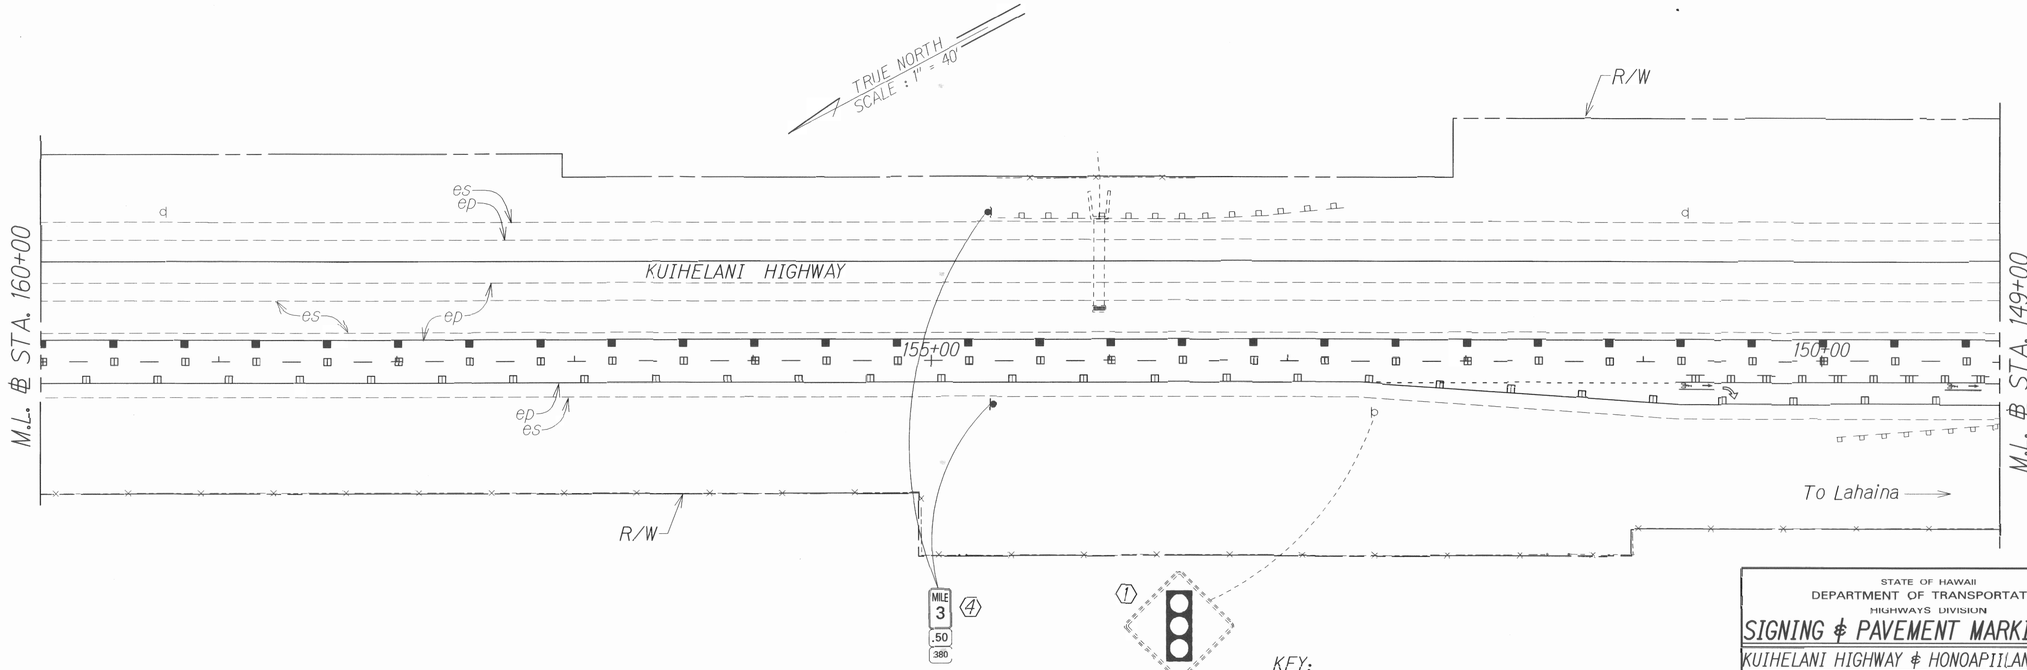

KEY:

1. Exist. Sign(s) & Post(s) to Remain
2. Remove Exist. Sign(s) & Post(s)
3. Remove Exist. & Install New Sign(s) & Post(s)
4. Install New Sign(s) & Post(s)

ORIGINAL PLAN	SURVEY PLOTTED BY	DATE Mar
	DRAWN BY	:
	TRACED BY	:
NOTE BOOK	DESIGNED BY Fields	:
	QUANTITIES BY	:
	CHECKED BY Anderson	:

STATE OF HAWAII
DEPARTMENT OF TRANSPORTATION
HIGHWAYS DIVISION

SIGNING & PAVEMENT MARKING PLAN

KUIHELANI HIGHWAY & HONOAPIILANI HIGHWAY
PAVEMENT PREVENTIVE MAINTENANCE
Puunene Avenue to Honoapiilani Highway and Kuihelani Highway to Kapoli Street
Federal-Aid Project No. NH-0900(080)

Scale: 1" =40' Date: May, 2012

SHEET No. 6 OF 18 SHEETS

FED. ROAD DIST. NO.	STATE	FED. AID PROJ. NO.	FISCAL YEAR	SHEET NO.	TOTAL SHEETS
HAWAII	HAW.	NH-0900(080)	2013	36	47

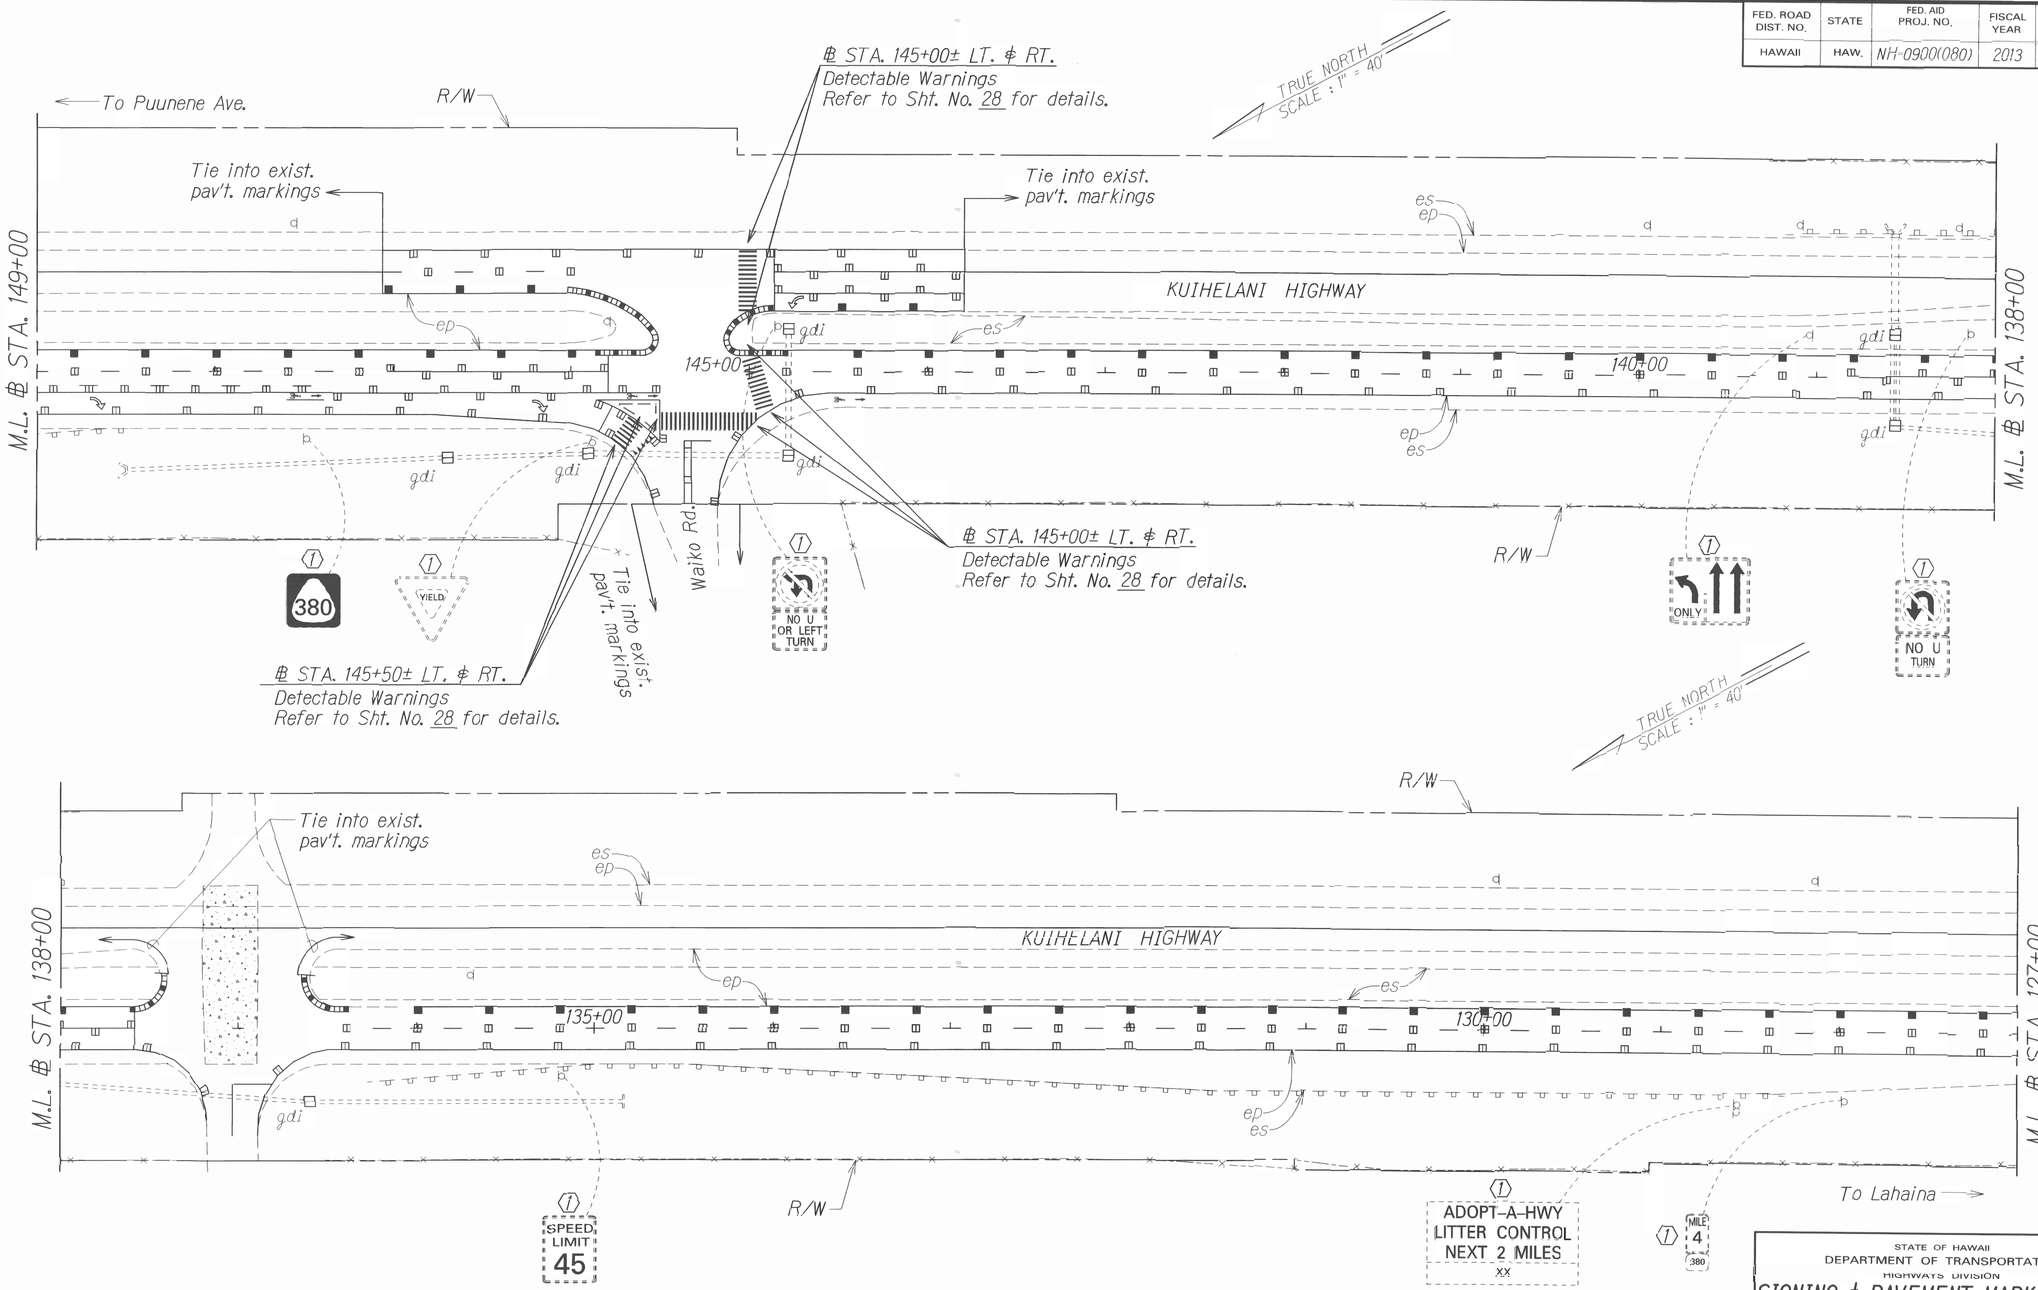

KEY:

1. Exist. Sign(s) & Post(s) to Remain
2. Remove Exist. Sign(s) & Post(s)
3. Remove Exisl. & Install New Sign(s) & Post(s)
4. Install New Sign(s) & Post(s)

STATE OF HAWAII
DEPARTMENT OF TRANSPORTATION
HIGHWAYS DIVISION

SIGNING & PAVEMENT MARKING PLAN

KUIHELANI HIGHWAY & HONOAPIILANI HIGHWAY
PAVEMENT PREVENTIVE MAINTENANCE
Puunene Avenue to Honoapiilani Highway and Kuihelani Highway to Kapoli Street
Federal-Aid Project No. NH-0900(080)

Scale: 1" =40' Date: May, 2012

SHEET No. 7 OF 18 SHEETS

ORIGINAL PLAN	SURVEY PLOTTED BY	DATE
	DRAWN BY	
NOTE BOOK	TRACED BY	
	DESIGNED BY	
	QUANTITIES BY	
	CHECKED BY	

FED. ROAD DIST. NO.	STATE	FED. AID PROJ. NO.	FISCAL YEAR	SHEET NO.	TOTAL SHEETS
HAWAII	HAW.	NH-0900(080)	2013	37	47

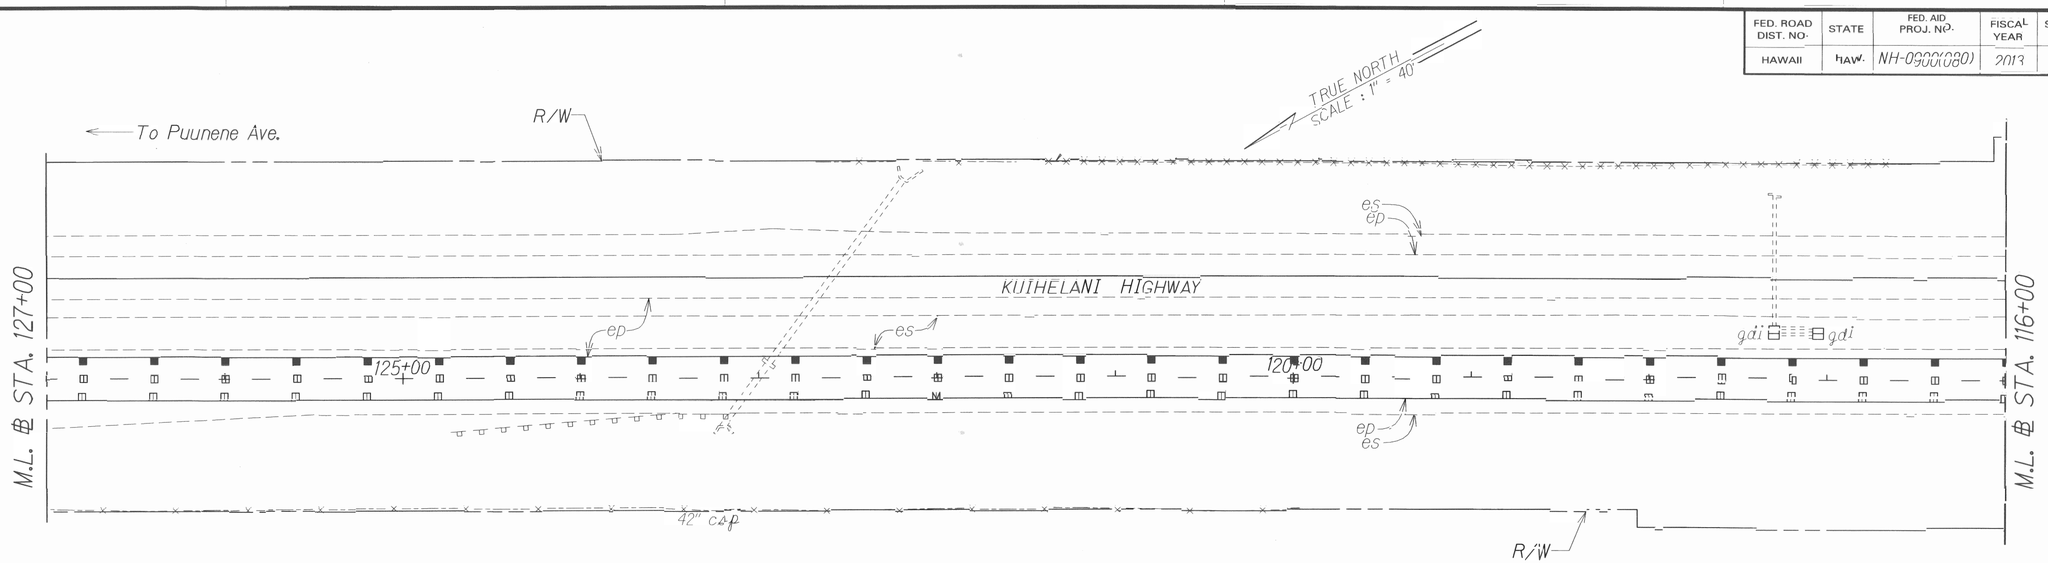

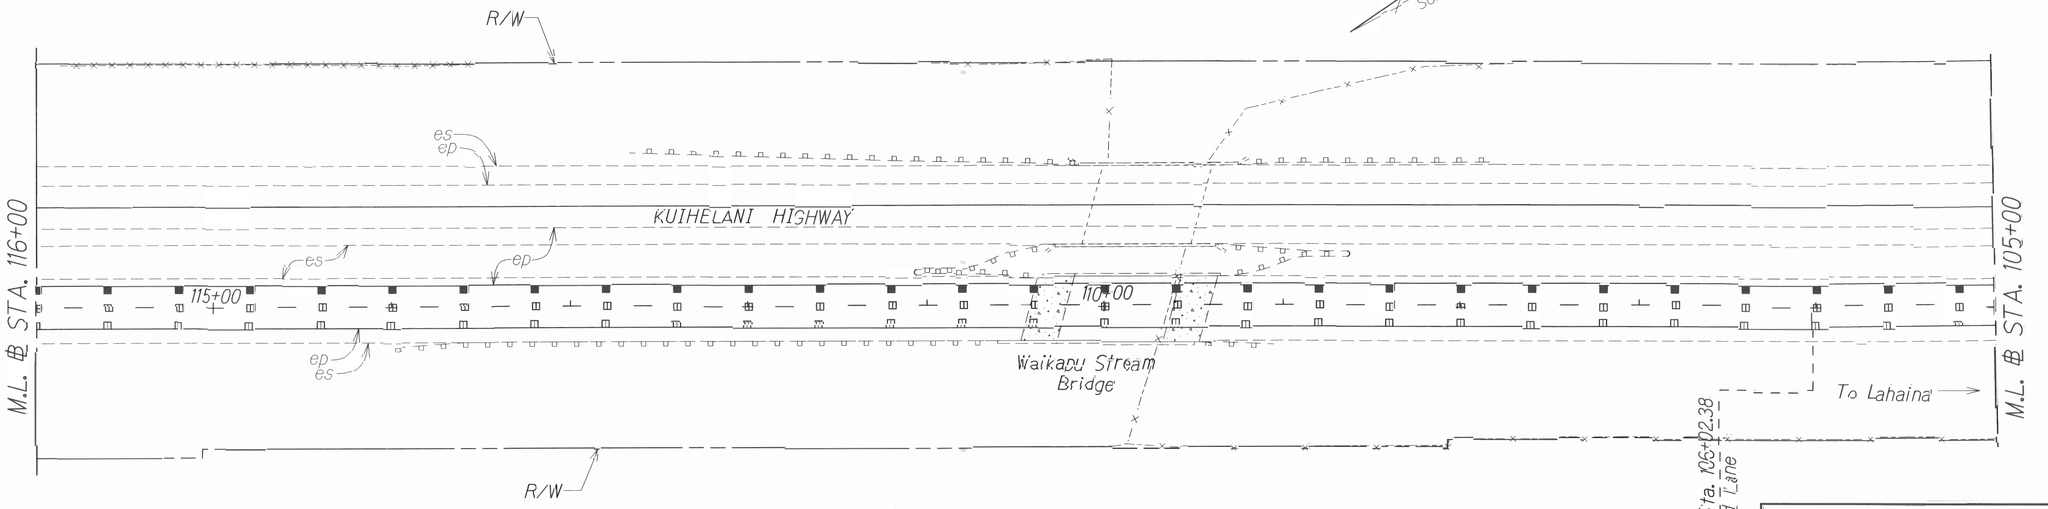

KEY:

1. Exist. Sign(s) & Post(s) to Remain
2. Remove Exist. Sign(s) & Post(s)
3. Remove Exist. & Install New Sign(s) & Post(s)
4. Install New Sign(s) & Post(s)

STATE OF HAWAII
DEPARTMENT OF TRANSPORTATION
HIGHWAYS DIVISION

SIGNING & PAVEMENT MARKING PLAN

KUIHELANI HIGHWAY & HONOAPIILANI HIGHWAY
PAVEMENT PREVENTIVE MAINTENANCE
Puunene Avenue to Honoapiilani Highway
and Kuihelani Highway to Kapoli Street
Federal-Aid Project No. NH-0900(080)

Scale: 1" =40' Date: May, 2012

SHEET No. 8 OF 18 SHEETS

ORIGINAL PLAN	SURVEY PLOTTED BY	DATE
	PLANS BY	
NOTE BOOK	TRACED BY	
	DESIGNED BY	
	QUANTITIES BY	
	CHECKED BY	

FED. ROAD DIST. NO.	STATE	FED. AID PROJ. NO.	FISCAL YEAR	SHEET NO.	TOTAL SHEETS
HAWAII	HAW.	NH-0900(080)	2013	38	47

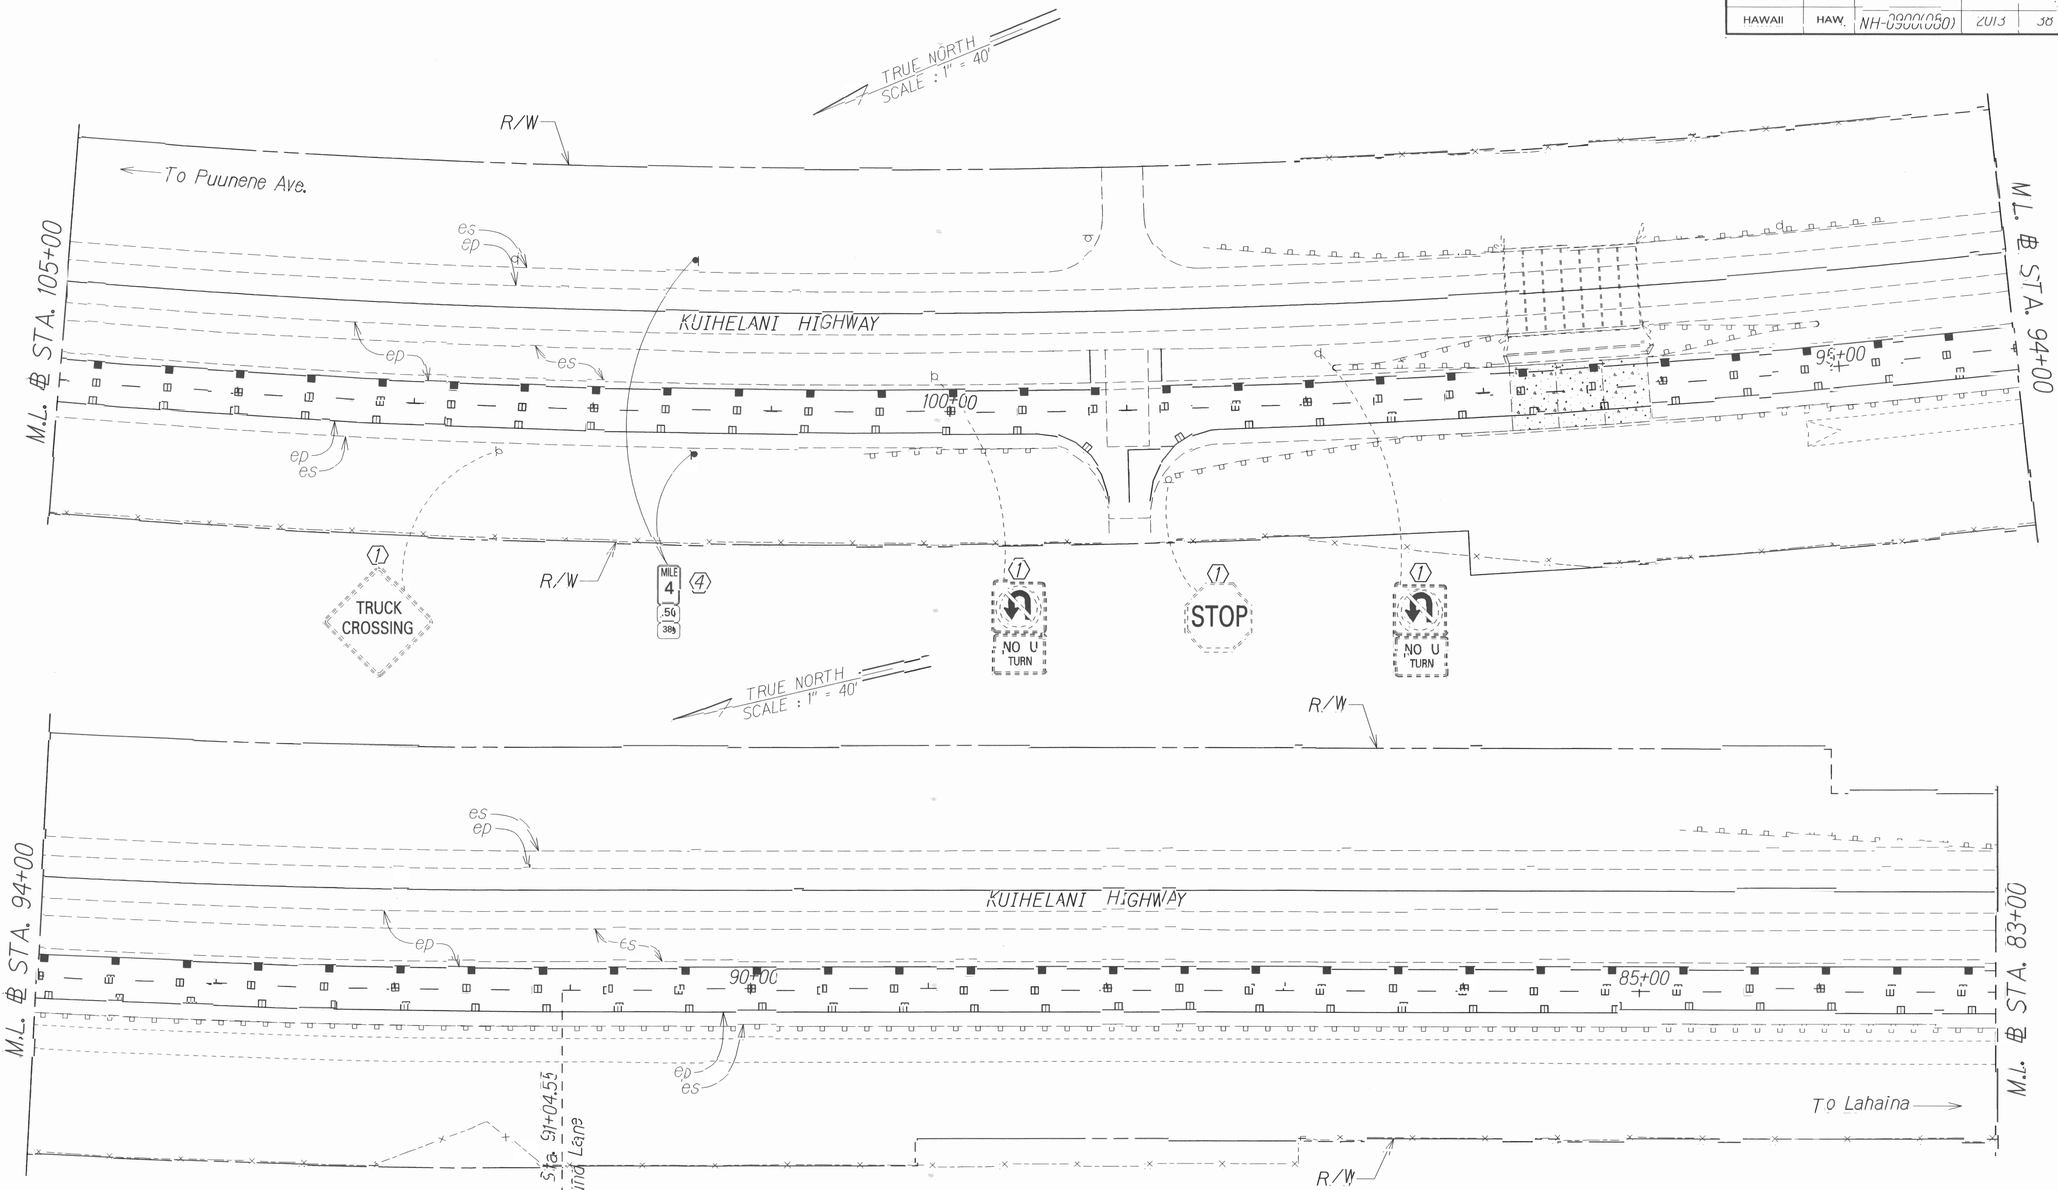

KEY:

1. Exist. Sign(s) & Post(s) to Remain
2. Remove Exist. Sign(s) & Post(s)
3. Remove Exist. & Install New Sign(s) & Post(s)
4. Install New Sign(s) & Post(s)

ORIGINAL PLAN	SURVEY PLOTTED BY	DATE
	DRAWN BY JL	
NOTE BOOK	TRACED BY	
	DESIGNED BY Leach	
	QUANTITIES BY melay	
	CHECKED BY alhirosaki	

STATE OF HAWAII
DEPARTMENT OF TRANSPORTATION
HIGHWAYS DIVISION

SIGNING & PAVEMENT MARKING PLAN

KUIHELANI HIGHWAY & HONOAPIILANI HIGHWAY
PAVEMENT PREVENTIVE MAINTENANCE
Puunene Avenue to Honoapiilani Highway
and Kuihelani Highway to Kapoli Street
Federal-Aid Project No. NH-0900(080)

Scale: 1" = 40' Date: May, 2012

SHEET No. 9 OF 18 SHEETS

FED. ROAD DIST. NO.	STATE	FED. AID PROJ. NO.	FISCAL YEAR	SHEET NO.	TOTAL SHEETS
Hawaii	HAW.	NH-0900(080)	2013	39	47

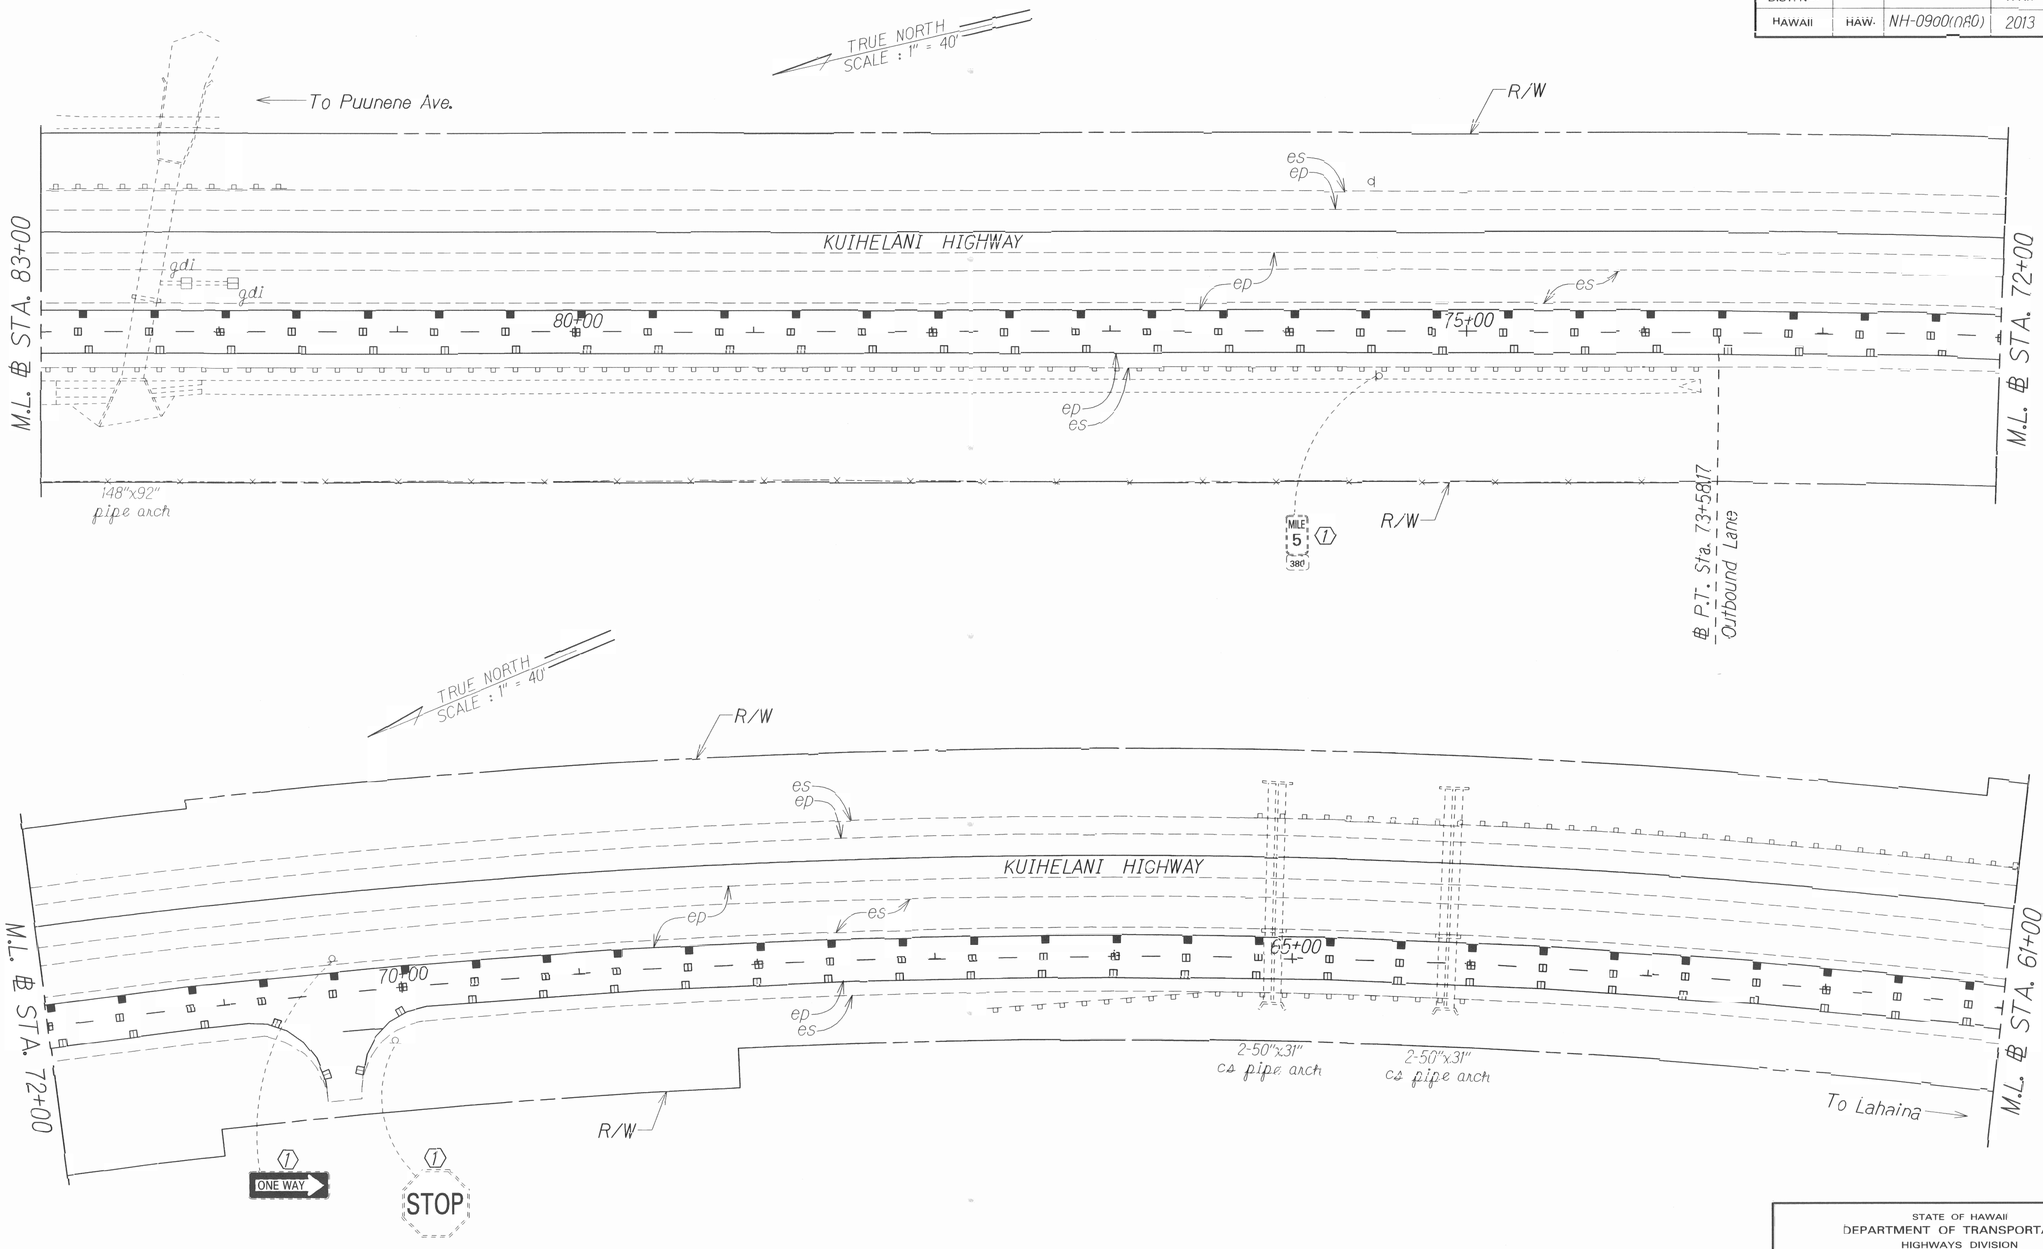

ORIGINAL PLAN	SURVEY PLOTTED BY	DATE 7/12
	DRAWN BY	:
	TRACED BY	:
NOTE BOOK	DESIGNED BY Dan G.	:
	QUANTITIES BY	:
	CHECKED BY	:

KEY:

1. Exist. Sign(s) & Post(s) to Remain
2. Remove Exist. Sign(s) & Post(s)
3. Remove Exist. & Install New Sign(s) & Post(s)
4. Install New Sign(s) & Post(s)

STATE OF HAWAII
DEPARTMENT OF TRANSPORTATION
HIGHWAYS DIVISION

SIGNING & PAVEMENT MARKING PLAN

KUIHELANI HIGHWAY & HONOAPIILANI HIGHWAY
PAVEMENT PREVENTIVE MAINTENANCE
Puunene Avenue to Honoapiilani Highway
and Kuihelani Highway to Kapoli Street
Federal-Aid Project No. NH-0900(080)
Scale: 1" =40' Date: May, 2012

SHEET No. 10 OF 18 SHEETS

FED. ROAD DIST. NO.	STATE	FED. AID PROJ. NO.	FISCAL YEAR	SHEET NO.	TOTAL SHEETS
HAWAII	HAW.	NH-0900(080)	2013	46	47

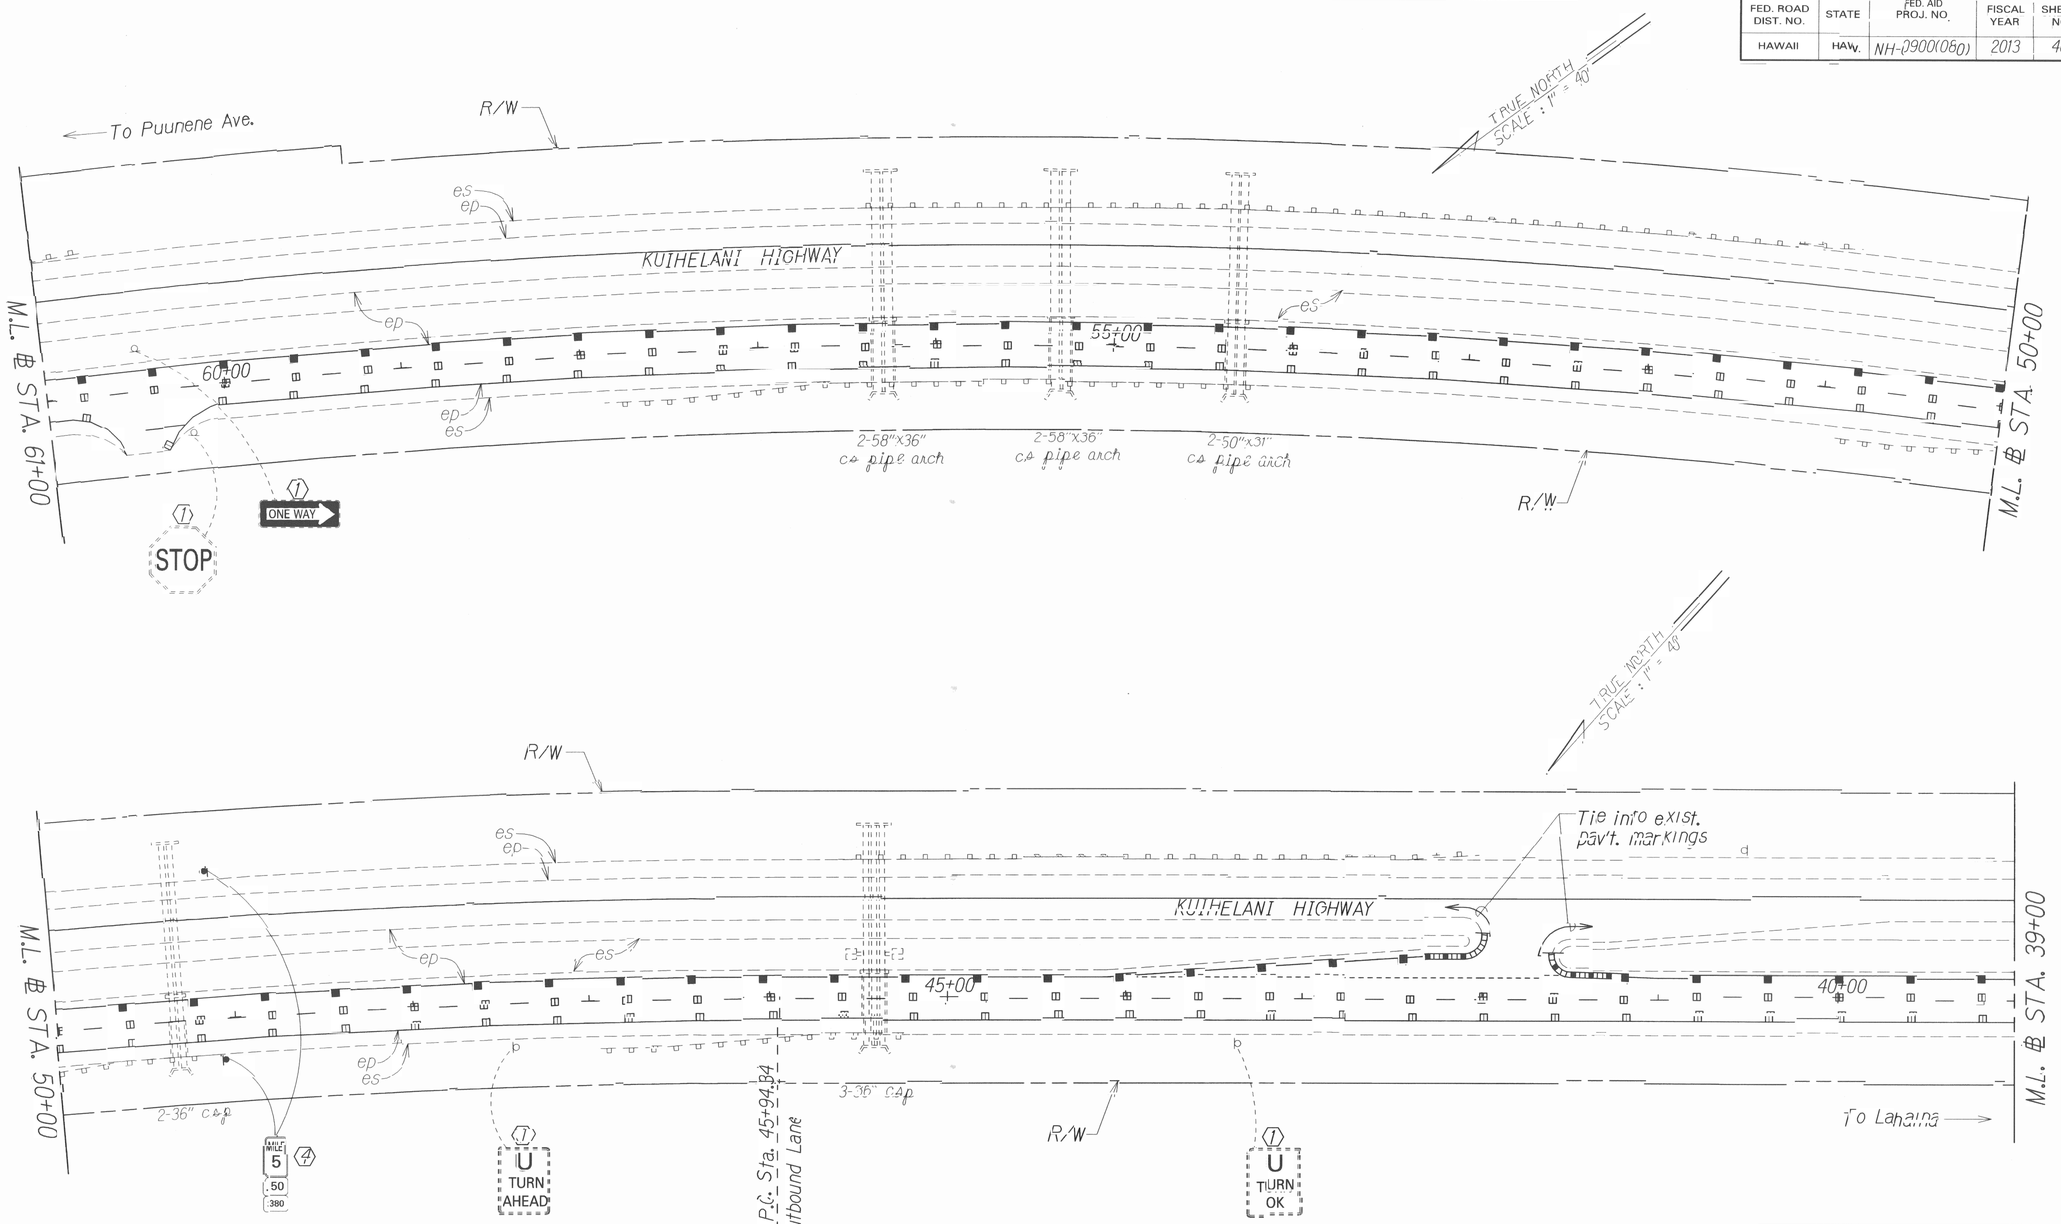

ORIGINAL PLAN	SURVEY PLOTTED BY	DATE: 7/12
	DRAWN BY JL	
	TRACED BY	
NOTE BOOK	DESIGNED BY Lloyd G.	
	QUANTITIES BY	
	CHECKED BY	

KEY:

1. Exist. Sign(s) & Post(s) to Remain
2. Remove Exist. Sign(s) & Post(s)
3. Remove Exist. & Install New Sign(s) & Post(s)
4. Install New Sign(s) & Post(s)

STATE OF HAWAI
DEPARTMENT OF TRANSPORTATION
HIGHWAYS DIVISION

SIGNING & PAVEMENT MARKING PLAN

KUIHELANI HIGHWAY & HONOAPIILANI HIGHWAY
PAVEMENT PREVENTIVE MAINTENANCE
Puunene Avenue to Honoapiilani Highway
and Kuihelani Highway to Kapoli Street
Federal-Aid Project No. NH-0900(080)

Scale: 1" =40' Date: May, 2012

SHEET No. 11 OF 18 SHEETS

FED. ROAD DIST. NO.	STATE	FED. AID PROJ. NO.	FISCAL YEAR	SHEET NO.	TOTAL SHEETS
HAWAII	HAW.	NH-0900(080)	2013	41	47

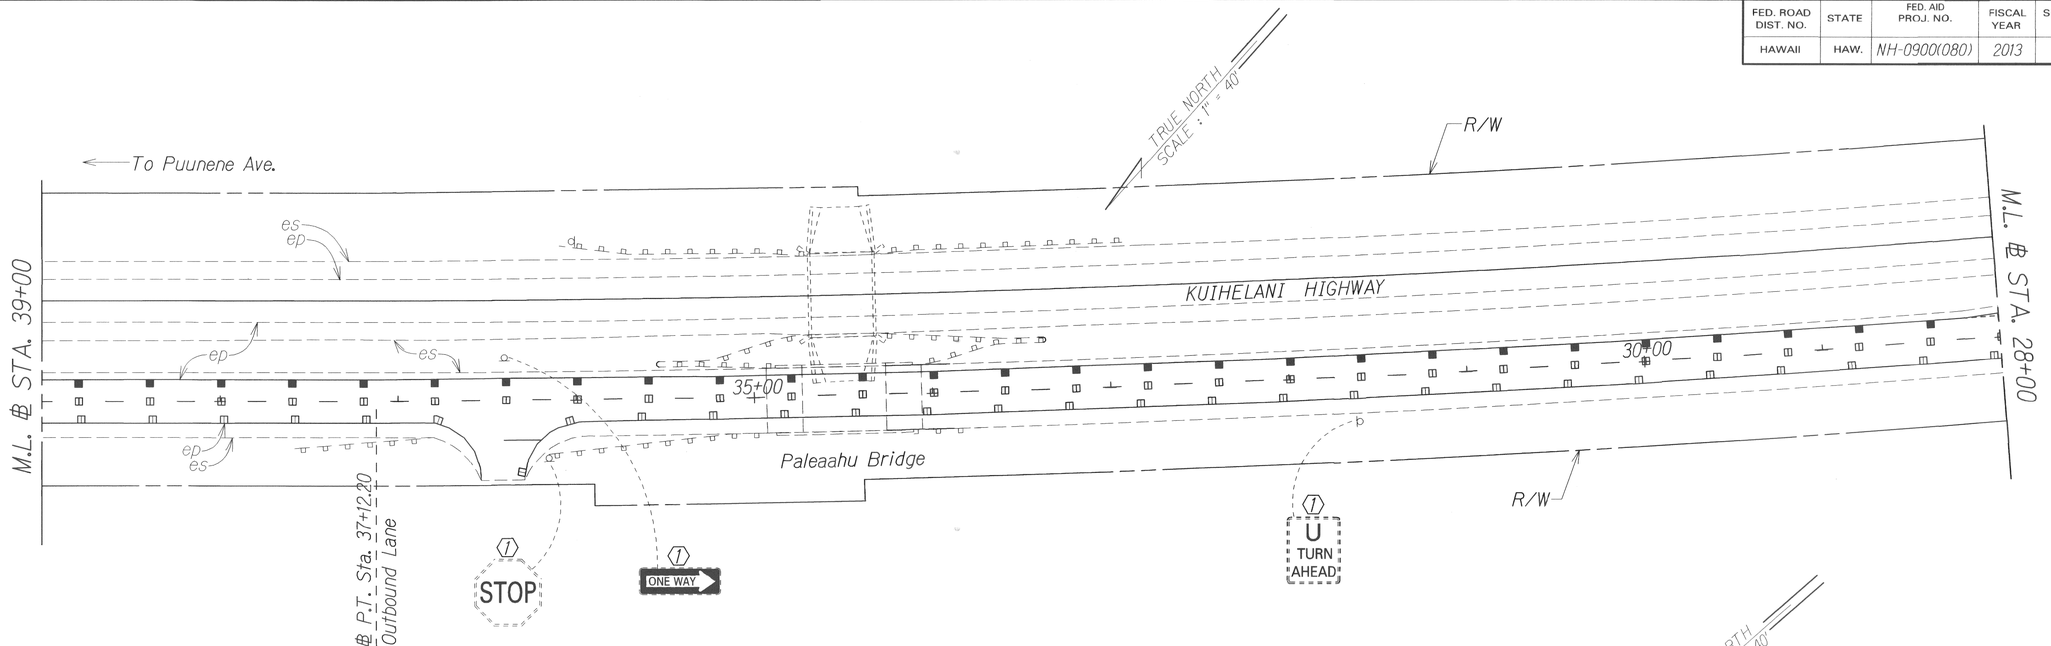

ORIGINAL PLAN	SURVEY PLOTTED BY	DATE
	DRAWN BY	
	TRACED BY	
NOTE BOOK	DESIGNED BY	
	QUANTITIES BY	
	CHECKED BY	

KEY:

1. Exist. Sign(s) ℄ Post(s) to Remain
2. Remove Exist. Sign(s) ℄ Post(s)
3. Remove Exist. ℄ Install New Sign(s) ℄ Post(s)
4. Install New Sign(s) ℄ Post(s)

STATE OF HAWAII
DEPARTMENT OF TRANSPORTATION
HIGHWAYS DIVISION

SIGNING ℄ PAVEMENT MARKING PLAN

KUIHELANI HIGHWAY ℄ HONOAPIILANI HIGHWAY
PAVEMENT PREVENTIVE MAINTENANCE
Puunene Avenue to Honoapiilani Highway
and Kuihelani Highway to Kapoli Street
Federal-Aid Project No. NH-0900(080)

Scale: 1" =40' Date: May, 2012

SHEET No. 12 OF 18 SHEETS

FED. ROAD DIST. NO.	STATE	FED. AID PROJ. NO.	FISCAL YEAR	SHEET NO.	TOTAL SHEETS
HAWAII	HAW.	NH-0900(080)	2013	42	47

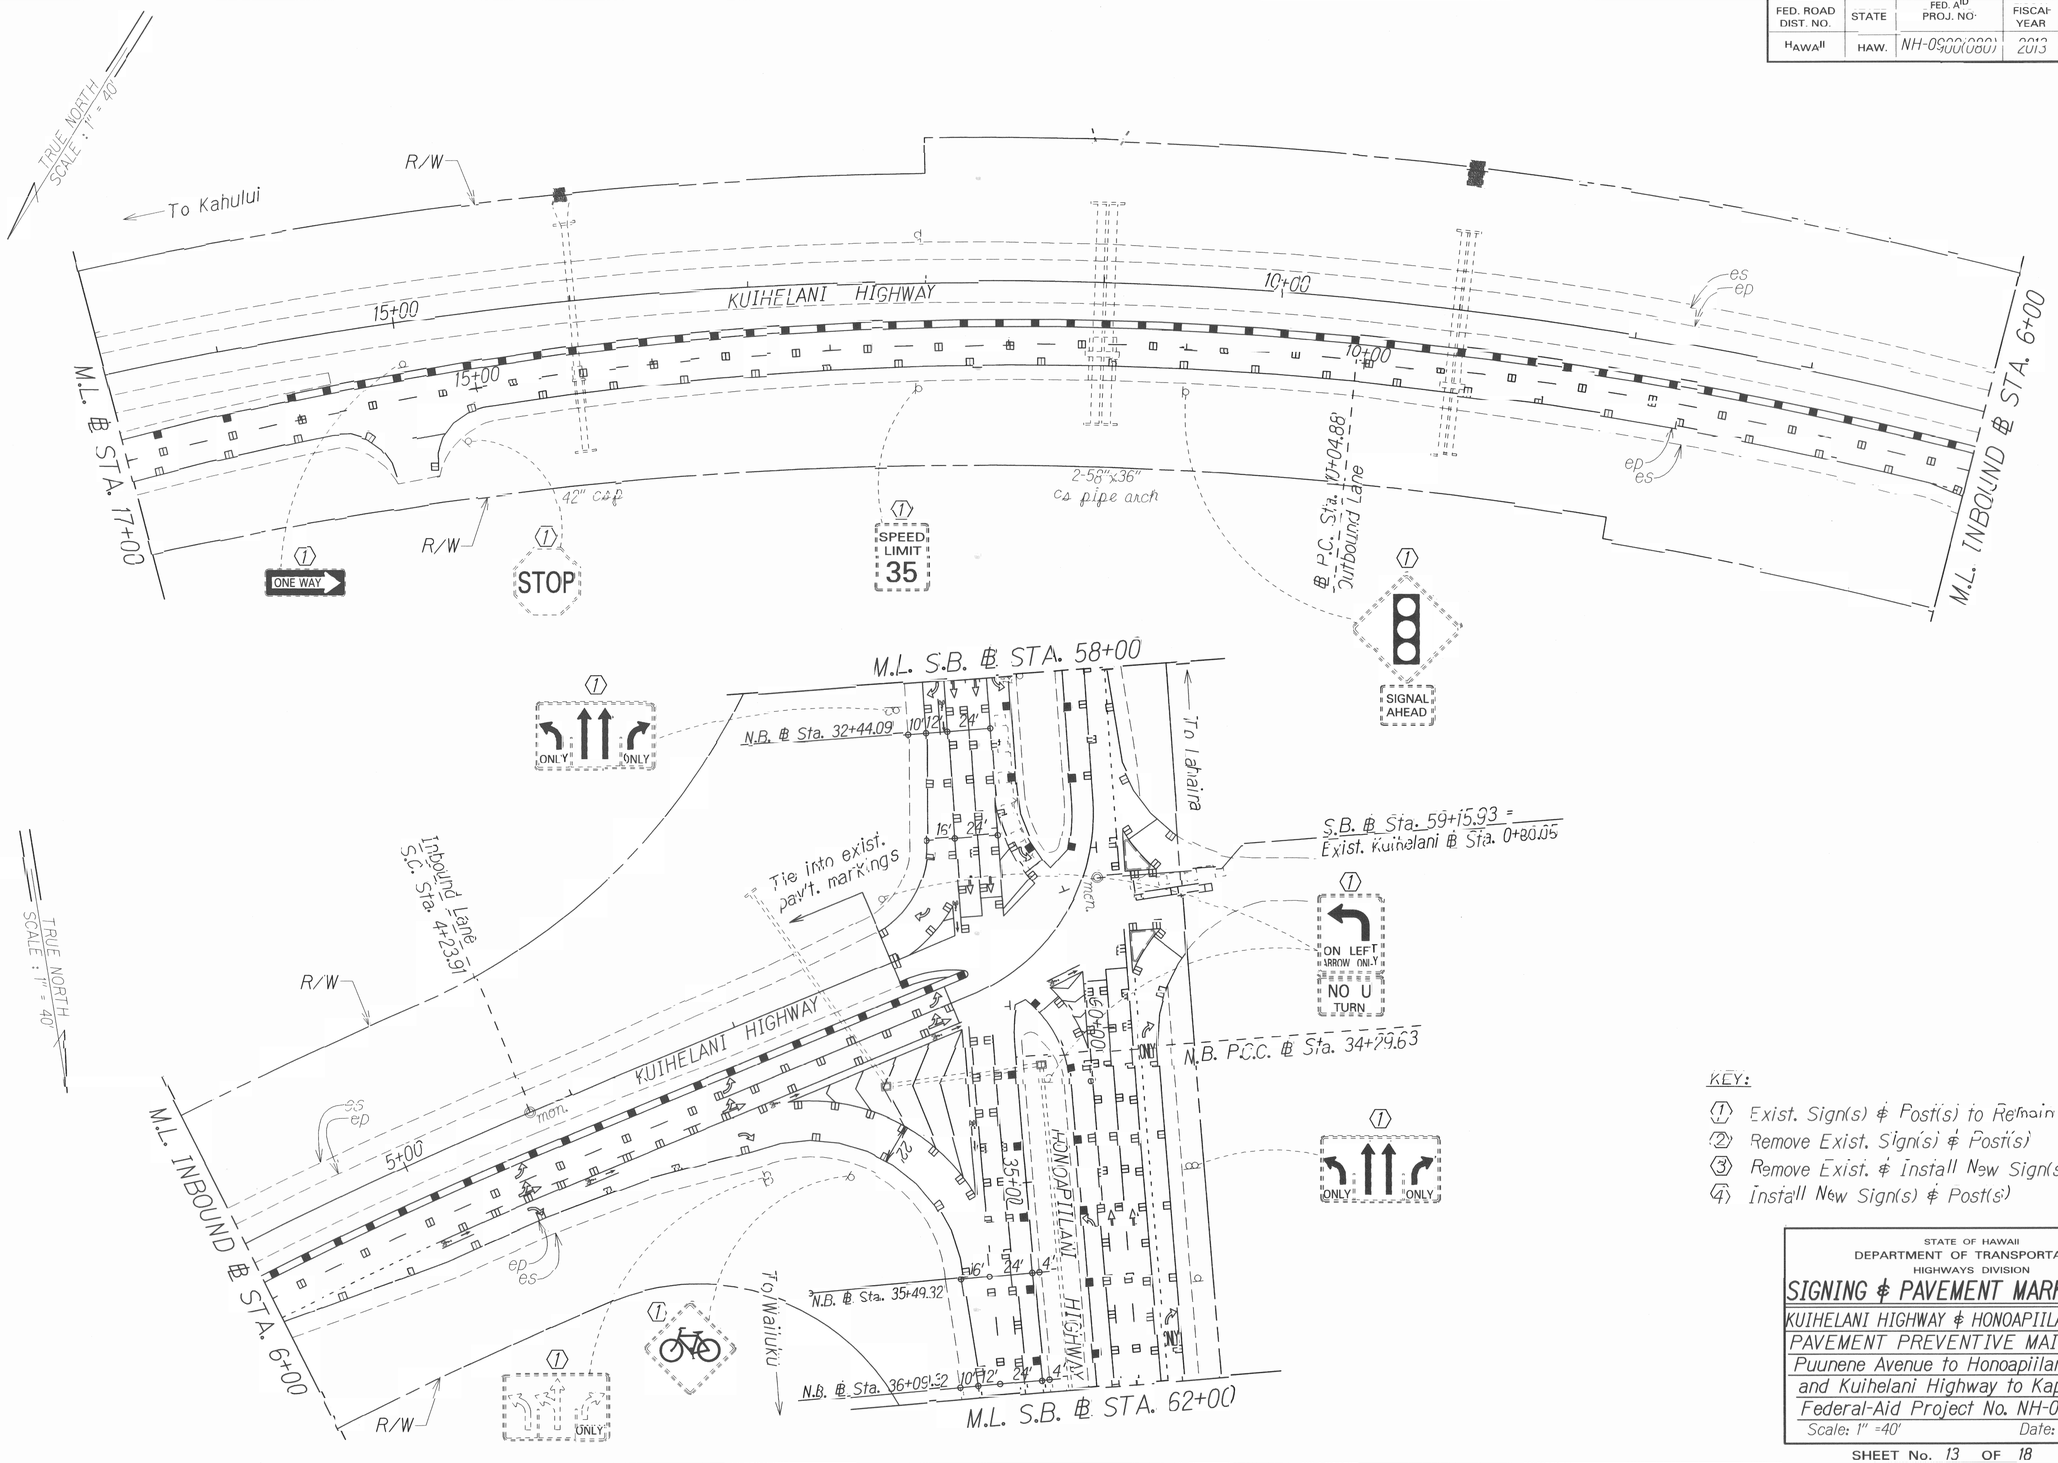

KEY:

1. Exist. Sign(s) & Post(s) to Remain
2. Remove Exist. Sign(s) & Post(s)
3. Remove Exist. & Install New Sign(s) & Post(s)
4. Install New Sign(s) & Post(s)

ORIGINAL PLAN
SURVEY PLOTTED BY
DRAWN BY
TRACED BY
DESIGNED BY
QUANTITIES BY
CHECKED BY
DATE
NOTE BOOK

STATE OF HAWAII
DEPARTMENT OF TRANSPORTATION
HIGHWAYS DIVISION

SIGNING & PAVEMENT MARKING PLAN

KUIHELANI HIGHWAY & HONOAPIILANI HIGHWAY
PAVEMENT PREVENTIVE MAINTENANCE
Puunene Avenue to Honoapiilani Highway and Kuihelani Highway to Kapoli Street
Federal-Aid Project No. NH-0900(080)

Scale: 1" =40' Date: May, 2012

SHEET No. 13 OF 18 SHEETS

FED. ROAD DIST. NO.	STATE	FED. AID PROJ. NO.	FISCAL YEAR	SHEET NO.	TOTAL SHEETS
HAWAII	HAW.	NH-0900(080)	2013	43	47

TRUE NORTH
SCALE : 1" = 40'

④ END ROAD WORK — CG20-2 (40"x24")

500'

To Wailuku

Sta. 79+02 24" rcp

pp96 tp130 pp97 tp131 pp98 tp132

80+00

HONOAPIILANI HIGHWAY

gdi

pp46

S.B. ℄ P.T. Sta. 78+11.00

④ ROAD WORK AHEAD — CW20-1A(d) (48"x48")

R/W

S.B. ℄ Sta. 75+13.50
N.B. ℄ P.T. Sta. 49+32.05

75+00

10" 12" 8"

18" conc. pipe
pp47

Tie into exist. pav't. markings

R/W

es ep

B ep es

① MAALAEA 1 LAHAINA 17 KAHULUI 5

M.L. S.B. ℄ STA. 73+00

TRUE NORTH
SCALE : 1" = 10'

N.B. ℄ P.C. Sta. 43+04.86

N.B. ℄ Sta. 43+20

① (diverging)

⑦ UNLAWFUL LITTER $500 FINE

N.B. ℄ P.T. Sta. 40+74.06

N.B. ℄ Sta. 40+35

① LANE ENDS MERGE LEFT

R/W

N.B. ℄ Sta. 46+15

M.L. S.B. ℄ STA. 73+00

es ep

10" 24"

45+00

40+00

12" 8"

10" 12" 24"

HONOAPIILANI HIGHWAY

65+00

10" 12" 8"

119°54'56"

es ep

B

SEE PLAN SHT. NO. 41 FOR M.L. S.B. ℄ STA. 62+00

24" conc. pipe

① BUCKLE UP IT'S THE LAW

① REDUCED SPEED 45

N.B. ℄ Sta. 44+26.20
S.B. ℄ Sta. 70+17.33

① JCT 380

⑦ ONLY

S.B. ℄ Sta. 67+25

R/W

① SPEED LIMIT 45 MINIMUM 35

S.B. ℄ Sta. 65+02

① 380 30 To Lahaina

ORIGINAL PLAN	SURVEY PLOTTED BY	DATE
NOTE BOOK	DRAWN BY	
	TRACED BY	
	DESIGNED BY	
	QUANTITIES BY	
	CHECKED BY	

KEY:

① Exist. Sign(s) & Post(s) to Remain
② Remove Exist. Sign(s) & Post(s)
③ Remove Exist. & Install New Sign(s) & Post(s)
④ Install New Sign(s) & Post(s)

STATE OF HAWAII
DEPARTMENT OF TRANSPORTATION
HIGHWAYS DIVISION

SIGNING & PAVEMENT MARKING PLAN

KUIHELANI HIGHWAY & HONOAPIILANI HIGHWAY
PAVEMENT PREVENTIVE MAINTENANCE
Puunene Avenue to Honoapiilani Highway and Kuihelani Highway to Kapoli Street
Federal-Aid Project No. NH-0900(080)

Scale: 1" =40' Date: May, 2012


FED. ROAD DIST. NO.	STATE	FED. AID PROJ. NO.	FISCAL YEAR	SHEET NO.	TOTAL SHEETS
HAWAII	HAW.	NH-0900(080)	2013	44	47

TRUE NORTH
SCALE : 1" = 40'

SEE PLAN SHT. NO. 41 FOR M.L. S.B. ℄ STA. 58+00

To Wailuku

N.B. ℄ Sta. 31+00

N.B. ℄ Sta. 28+55

N.B. ℄ Sta. 23+65

M.L. S.B. ℄ STA. 47+00

30+00

25+00

55+00

50+00

HONOAPIILANI HIGHWAY

6'x3' box culvert

S.B. ℄ Sta. 56+07.70

R/W

Puhaka Stream

MILE 5 30

WAIKAPU 2
WAILUKU 5
KAHULUI 5
PUUNENE 6

MAALAEA
LAHAINA
KIHEI
WAILEA
MAKENA

JCT 380

JCT 310

BEGIN RIGHT TURN LANE
YIELD TO BIKES

ONLY ONLY

30 380

es ep pp

TRUE NORTH
SCALE : 1" = 40'

LANE ENDS
MERGE
LEFT

ONLY

Tie into exist. pav't. markings

YIELD

℄ Sta. 0+88.10
R=60'

℄ Sta. 0+88.01
R=60'

10' 18' 14' 14' 20' 10'

N. Kihei Rd.

NORTH 30 EAST 310

N.B. ℄ Sta. 20+70

℄ Sta. 16+49.14

M.L. S.B. ℄ STA. 47+00

20+00

15+00

40+00

45+00

HONOAPIILANI HIGHWAY

S.B. ℄ Sta. 46+15

R/W

EAST 310 SOUTH 30

SPEED LIMIT 45

N.B. P.C.C. ℄ Sta. 15+01.67

N. Kihei ℄ Sta. (-)0+12
N.B. ℄ Sta. 14+77.16 =

S.B. ℄ P.C. Sta. 39+13.50
R=34,377.50

UNLAWFUL TO LITTER $500 FINE

M.L. S.B. ℄ STA. 36+00

To Lahaina

KEY:

1. Exist. Sign(s) & Post(s) to Remain
2. Remove Exist. Sign(s) & Post(s)
3. Remove Exist. & Install New Sign(s) & Post(s)
4. Install New Sign(s) & Post(s)

ORIGINAL PLAN	SURVEY PLOTTED BY	DATE
	DRAWN BY	
NOTE BOOK	TRACED BY	
	DESIGNED BY	
	QUANTITIES BY	
	CHECKED BY	

STATE OF HAWAII
DEPARTMENT OF TRANSPORTATION
HIGHWAYS DIVISION

SIGNING & PAVEMENT MARKING PLAN

KUIHELANI HIGHWAY & HONOAPIILANI HIGHWAY
PAVEMENT PREVENTIVE MAINTENANCE
Puunene Avenue to Honoapiilani Highway
and Kuihelani Highway to Kapoli Street
Federal-Aid Project No. NH-0900(080)

Scale: 1" =40' Date: May, 2012

SHEET No. 15 OF 18 SHEETS

FED. ROAD DIST. NO.	STATE	FED. AID PROJ. NO.	FISCAL YEAR	SHEET NO.	TOTAL SHEETS
HAWAII	HAW.	NH-0900(080)	2013	45	47

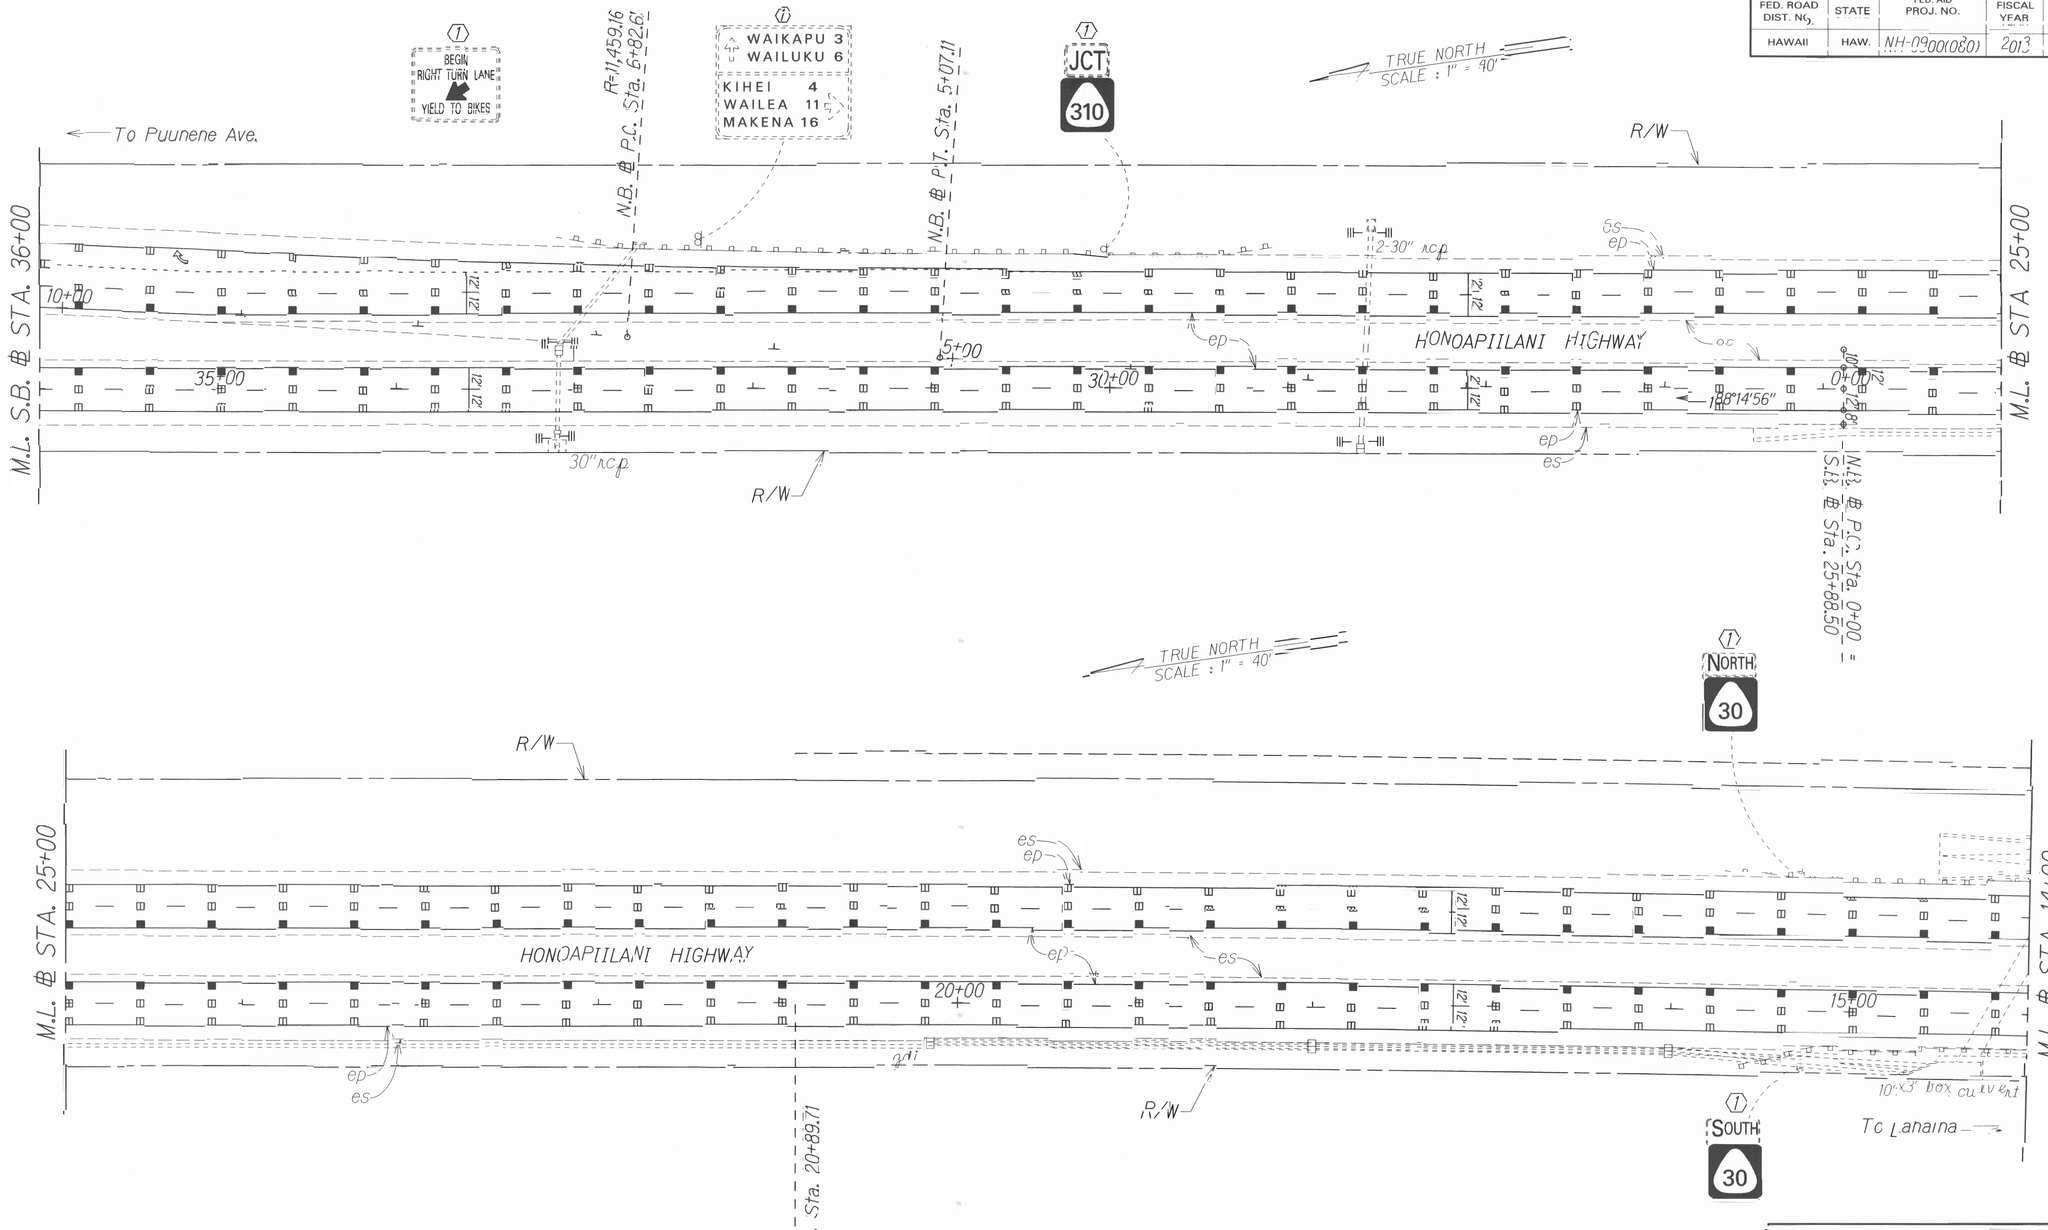

KEY:

1. Exist. Sign(s) & Post(s) to Remain
2. Remove Exist. Sign(s) & Post(s)
3. Remove Exist. & Install New Sign(s) & Post(s)
4. Install New Sign(s) & Post(s)

ORIGINAL PLAN	SURVEY PLOTTED BY	DATE 2/12
	DRAWN BY JT	
NOTE BOOK ref. to Plan	TRACED BY	
	DESIGNED BY Traffic D.	
	QUANTITIES BY	
	CHECKED BY	

STATE OF HAWAII
DEPARTMENT OF TRANSPORTATION
HIGHWAYS DIVISION

SIGNING & PAVEMENT MARKING PLAN

KUIHELANI HIGHWAY & HONOAPIILANI HIGHWAY
PAVEMENT PREVENTIVE MAINTENANCE
Puunene Avenue to Honoapiilani Highway
and Kuihelani Highway to Kapoli Street
Federal-Aid Project No. NH-0900(080)

Scale: 1" = 40' Date: May, 2012

SHEET No. 16 OF 18 SHEETS

FED. ROAD DIST. NO.	STATE	FED. AID PROJ. NO.	FISCAL YEAR	SHEET NO.	TOTAL SHEETS
HAWAII	HAW.	NH-0900(080)	2013	46	47

TRUE NORTH
SCALE : 1" = 40'

To Wailuku

Irrigation Valves

R/W

(1) SPEED LIMIT 45

M.L. @ STA. 14+00

es
ep

HONOAPIILANI HIGHWAY

10+00

5+00

mon.'s

gdi

M.L. @ STA. 3+00

R/W

@ P.C. Sta. 7+25.62 Ft. =
@ P.C. Sta. 7+34.71 Ah.
R=34,377.30'

EQ

(1) ADOPT-A-HWY LITTER CONTROL NEXT 2 MILES
VALLEY ISLE MARINE CTR

(1) MILE 6 30

TRUE NORTH
SCALE : 1" = 40'

(1)

(1) LANE ENDS MERGE LEFT

R/W

M.L. @ STA. 3+00

es
ep

HONOAPIILANI HIGHWAY

0+00

5+00

35+00

Ma'alaea Rd.

12'

12'

12'

190°30'15"

gdi

M.L. @ STA. 8+00

R/W

To Lahaina

@ P.C. Sta. 0+21.50 Ah. =
@ P.C. Sta. 0+00.00 Bk. =
R=5,715.97'

EQ

(1) ONLY

(1) NO U TURN

(1) ADOPT-A-HWY LITTER CONTROL NEXT 2 MILES

(1) MILE 6 30

(1) LANE ENDS MERGE LEFT

(1) MAALAEA HARBOR NEXT 3 LEFTS

(1) SHORELINE ACCESS

(1)

(1) MAALAEA VILLAGE

ORIGINAL PLAN

NOTE BOOK

SURVEY PLOTTED BY
DRAWN BY
TRACED BY
DESIGNED BY
QUANTITIES BY
CHECKED BY
DATE

KEY:

(1) Exist. Sign(s) & Post(s) to Remain
(2) Remove Exist. Sign(s) & Post(s)
(3) Remove Exist. & Install New Sign(s) & Post(s)
(4) Install New Sign(s) & Post(s)

STATE OF HAWAII
DEPARTMENT OF TRANSPORTATION
HIGHWAYS DIVISION

SIGNING & PAVEMENT MARKING PLAN

KUIHELANI HIGHWAY & HONOAPIILANI HIGHWAY
PAVEMENT PREVENTIVE MAINTENANCE
Puunene Avenue to Honoapiilani Highway
and Kuihelani Highway to Kapoli Street
Federal-Aid Project No. NH-0900(080)

Scale: 1" = 40' Date: May, 2012

SHEET No. 17 OF 18 SHEETS

FED. ROAD DIST. NO.	STATE	FED. AID PROJ. NO.	FISCAL YEAR	SHEET NO.	TOTAL SHEETS
HAWAII	HAW.	NH-0900(080)	2013	47	47

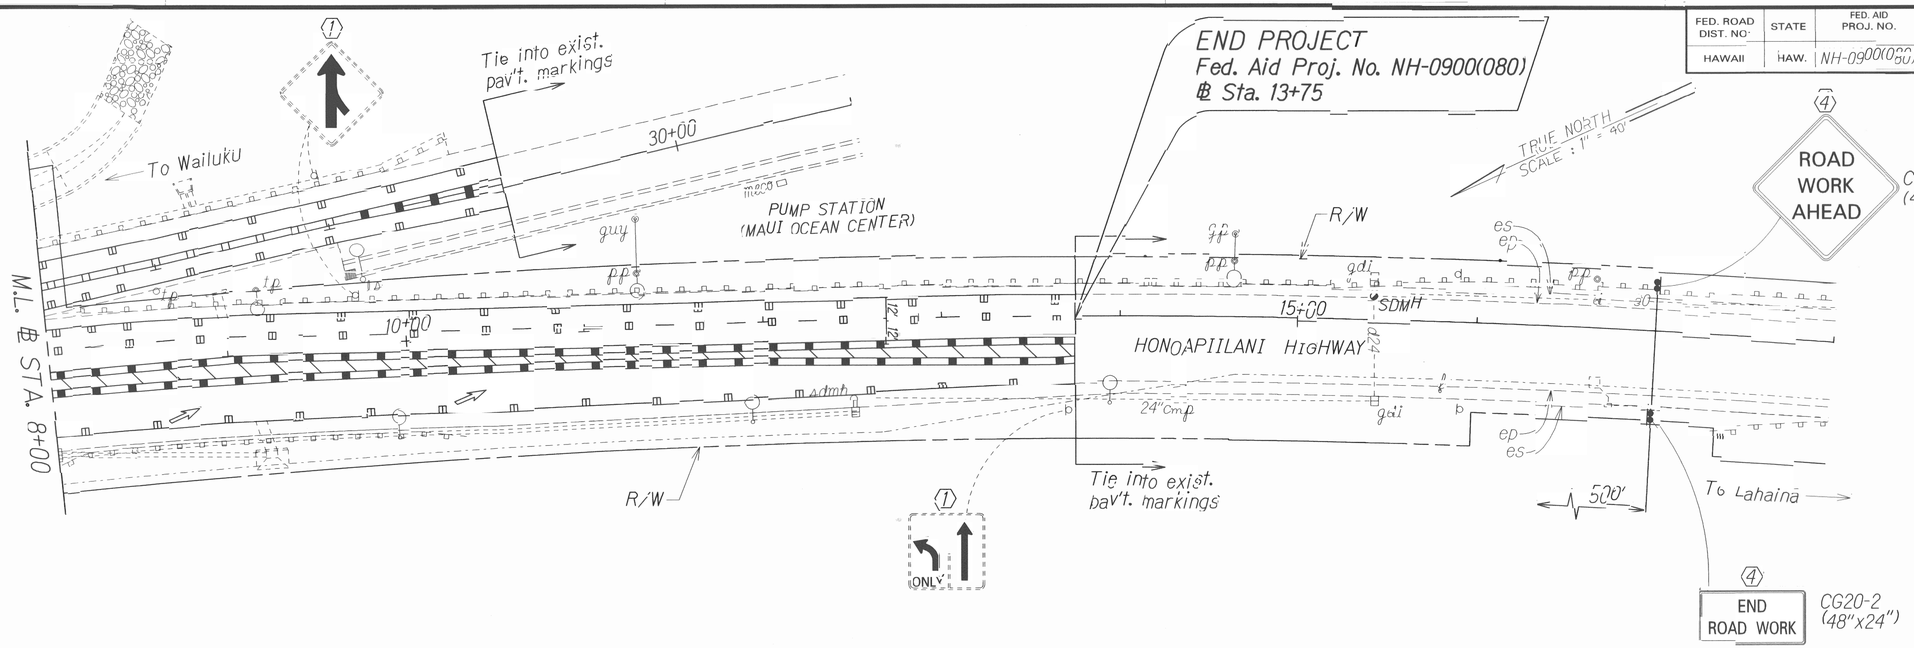

KEY:

1. Exist. Sign(s) & Post(s) to Remain
2. Remove Exist. Sign(s) & Post(s)
3. Remove Exist. & Install New Sign(s) & Post(s)
4. Install New Sign(s) & Post(s)

ORIGINAL PLAN	SURVEY PLOTTED BY	DATE
	DRAWN BY JT	
NOTE BOOK	TRACED BY	
	DESIGNED BY Tod H.	
	QUANTITIES By	
	CHECKED BY	

STATE OF HAWAII
DEPARTMENT OF TRANSPORTATION
HIGHWAYS DIVISION

SIGNING & PAVEMENT MARKING PLAN

KUIHELANI HIGHWAY & HONOAPIILANI HIGHWAY
PAVEMENT PREVENTIVE MAINTENANCE
Puunene Avenue to Honoapiilani Highway and Kuihelani Highway to Kapoli Street
Federal-Aid Project No. NH-0900(080)

Scale: 1" =40' Date: May. 2012

SHEET No. 18 OF 18 SHEETS