


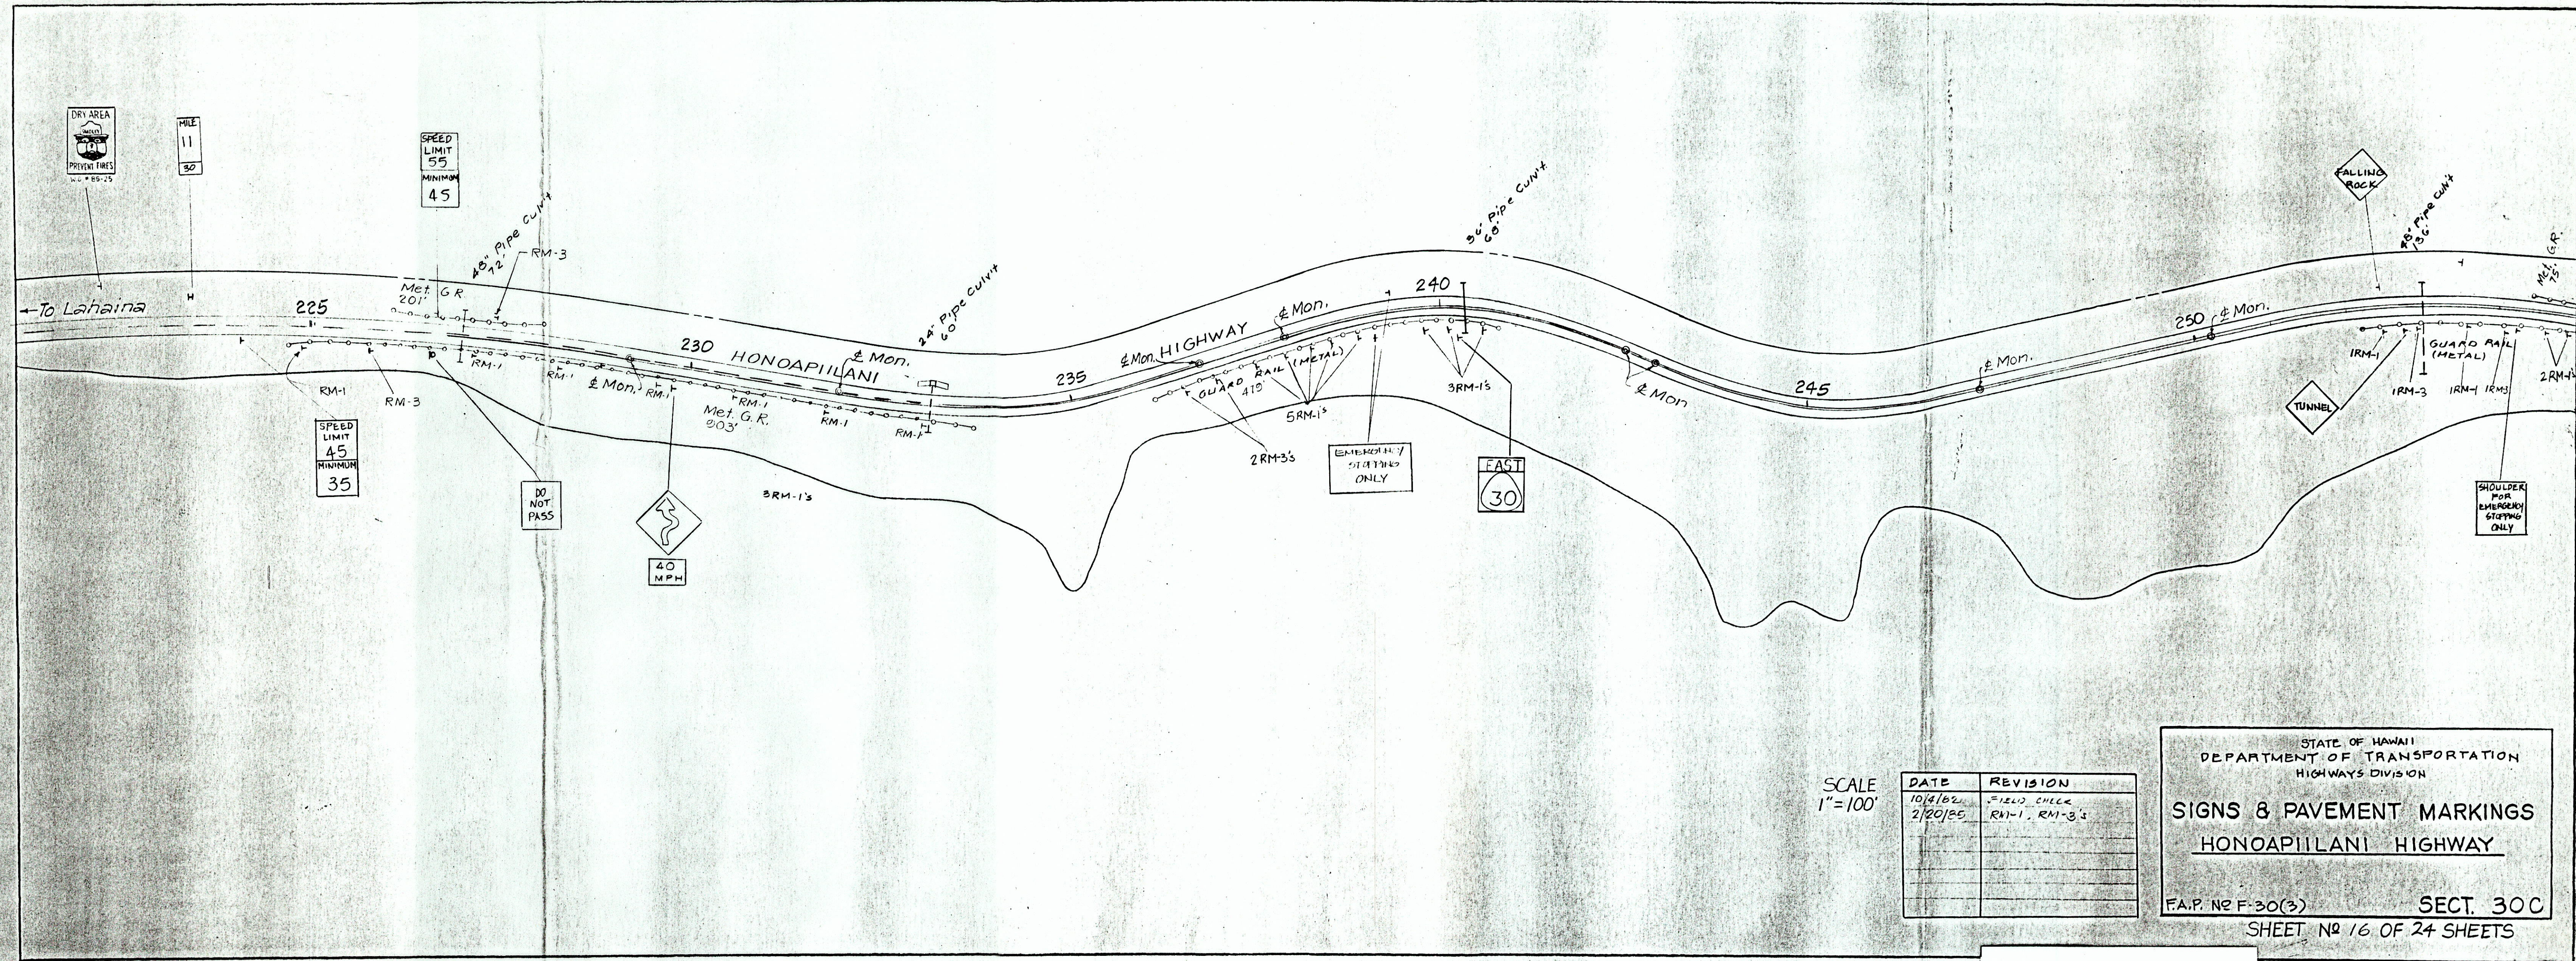


SCALE
1"=100'

DATE	REVISION
10/4/82	FIELD CHECK
2/20/85	RM-1, RM-3's

STATE OF HAWAII
DEPARTMENT OF TRANSPORTATION
HIGHWAYS DIVISION

SIGNS & PAVEMENT MARKINGS
HONOAPIILANI HIGHWAY

FA.P. NO F-30(3) SECT. 30C
SHEET NO 16 OF 24 SHEETS

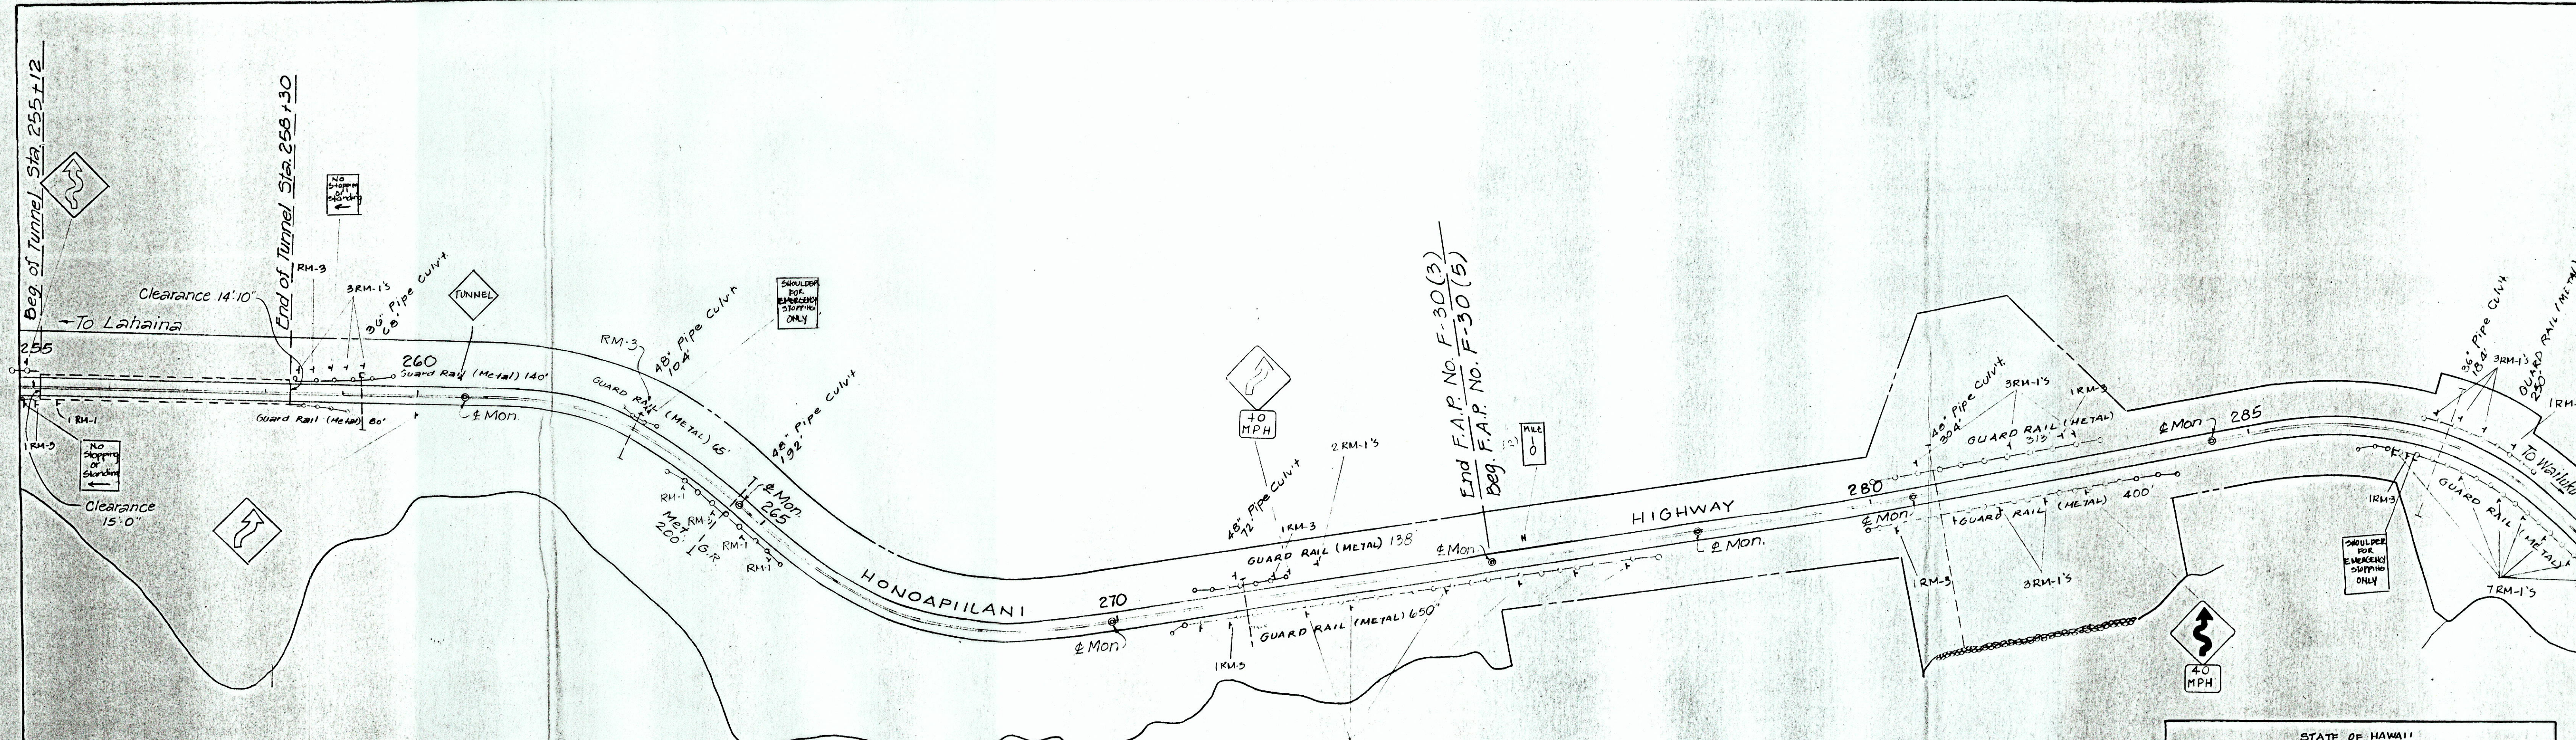

SCALE
1"=100'


DATE	REVISION
10/4/82	FIELD CHECK
9/21/83	TUNNEL CLEARANCE
2/20/85	RM-1

STATE OF HAWAII
DEPARTMENT OF TRANSPORTATION
HIGHWAYS DIVISION

SIGNS & PAVEMENT MARKINGS
HONOAPIILANI HIGHWAY

F.A.P. NO. F-30(3)
F.A.P. NO. F-30(5)

SECT. 30C
SHEET NO 17 OF 24 SHEETS

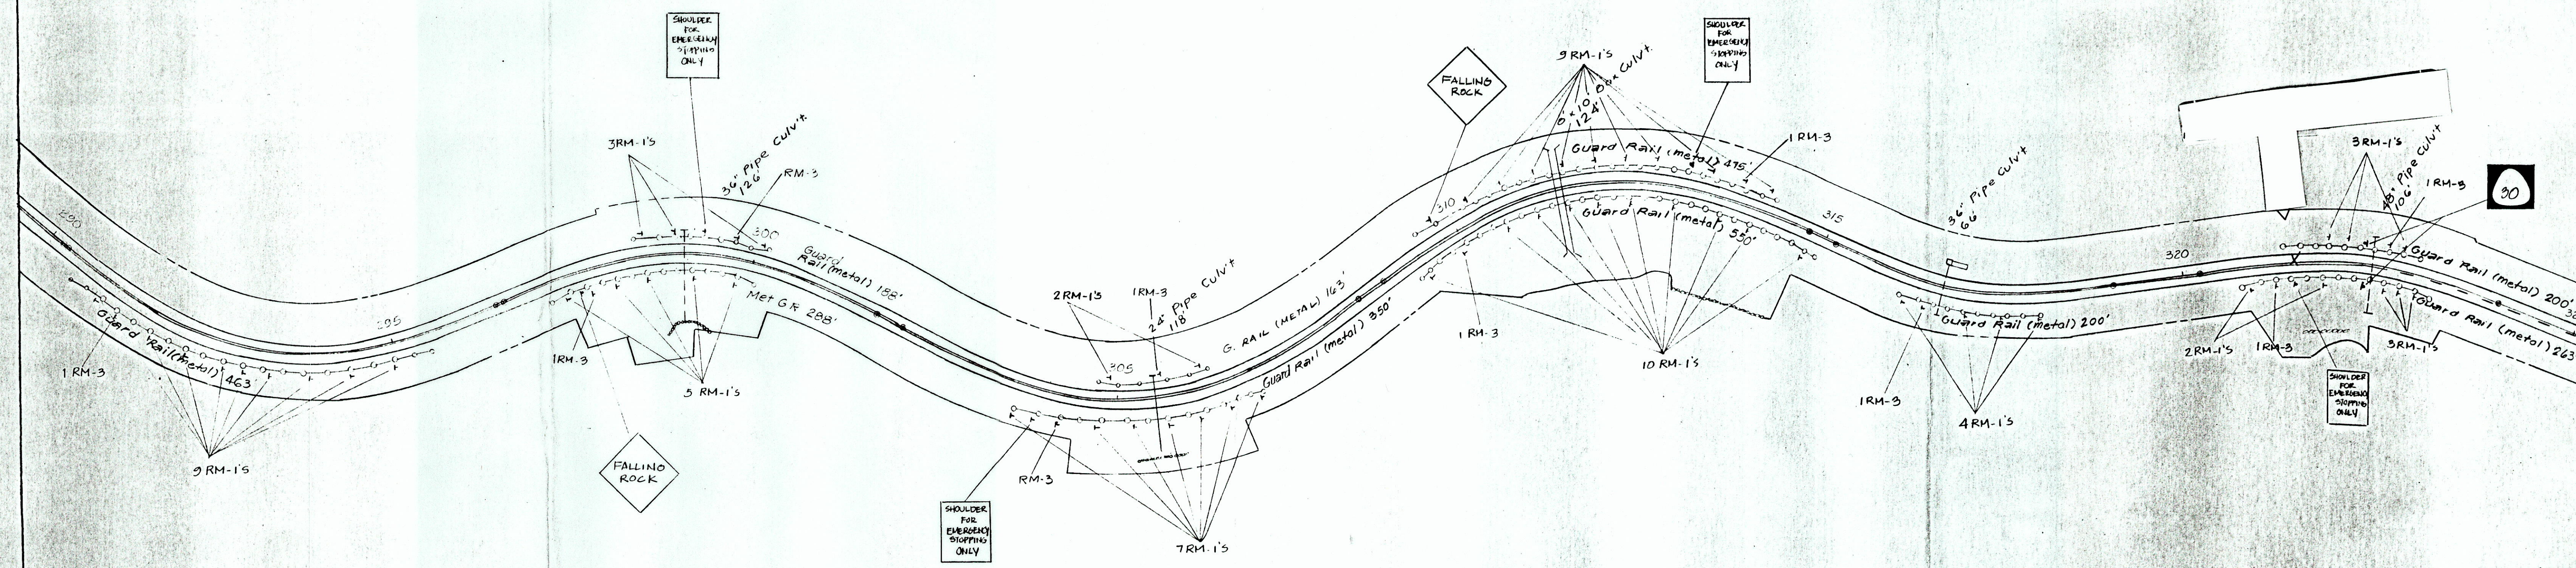


SCALE
1"=100'

DATE	REVISION
3/24/83	Field Check & Plotted

STATE OF HAWAII
DEPARTMENT OF TRANSPORTATION
HIGHWAYS DIVISION

SIGNS & PAVEMENT MARKINGS
HONOAPIILANI HIGHWAY

F.A.P. NO F-30(5) **SECT 30C**
SHEET NO 18 OF 24 SHEETS

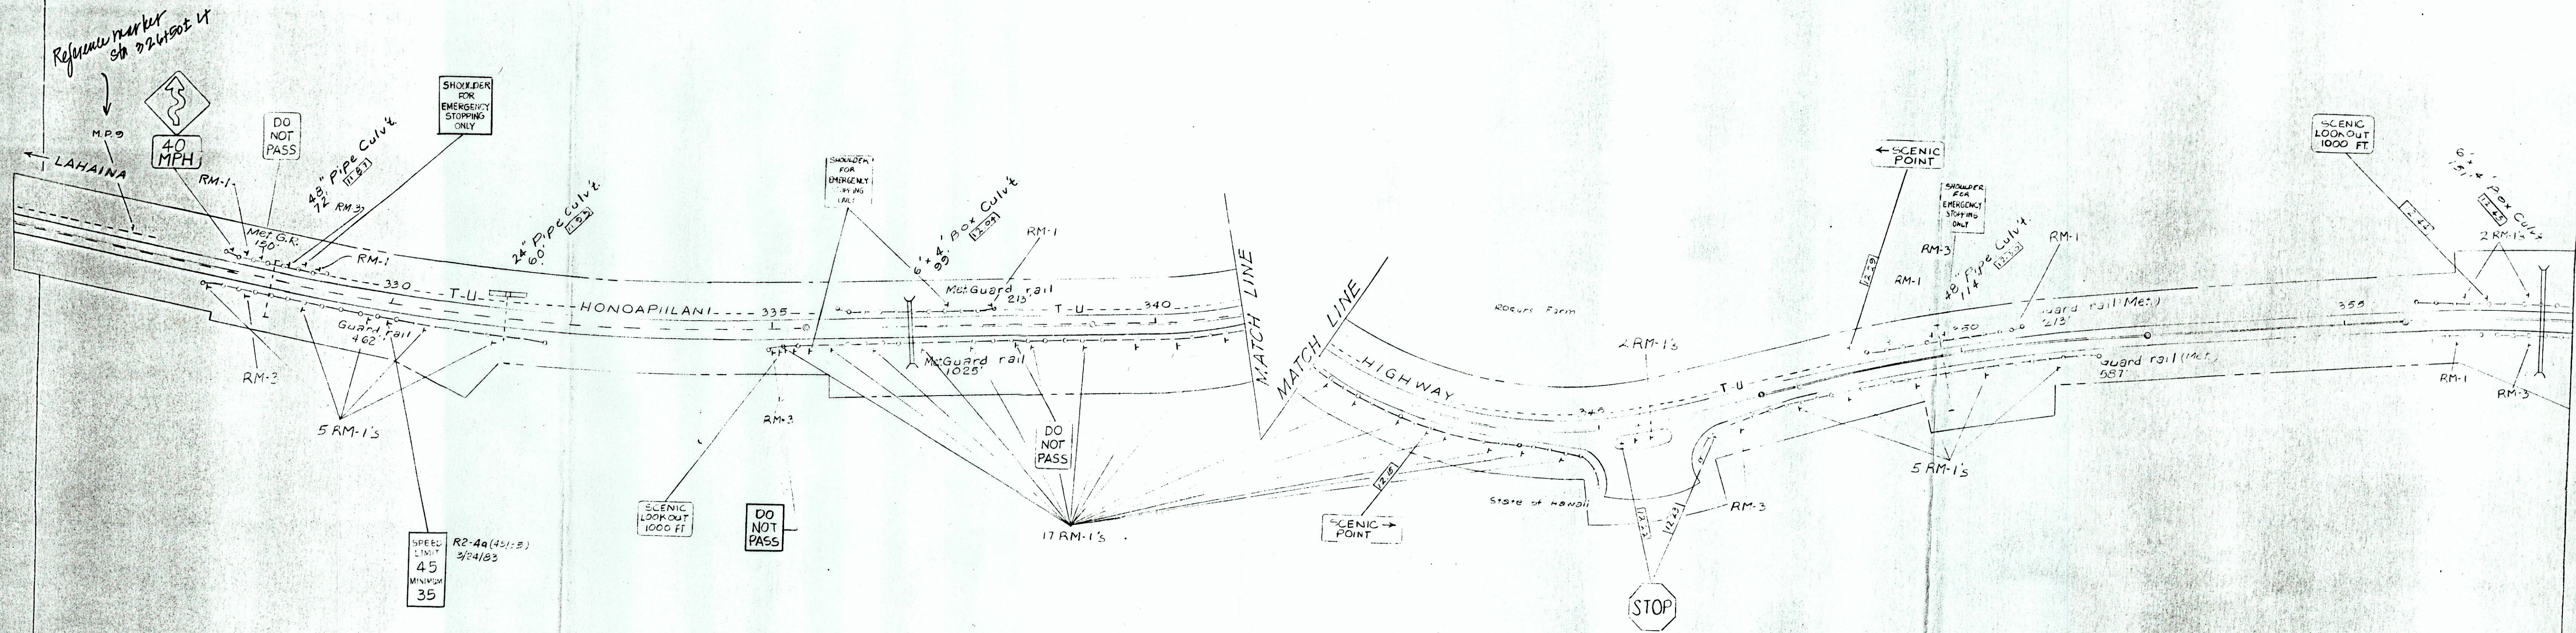

LEGEND
 --T-U-- TELEPHONE LINES, UNDERGROUND


SCALE
 1"=100'

DATE	REVISION
3/24/83	Field Check & Plotted
4/5/83	Posted w/o 24(45/35)
2/20/85	Do Not Pass

STATE HIGHWAY DEPARTMENT
 STATE OF HAWAII

SIGNS & PAVEMENT MARKINGS
HONOAPIILANI HIGHWAY

F.A.P. No F-30(5) **SECT. 30C**
 SHEET No 19 OF 24 SHEETS

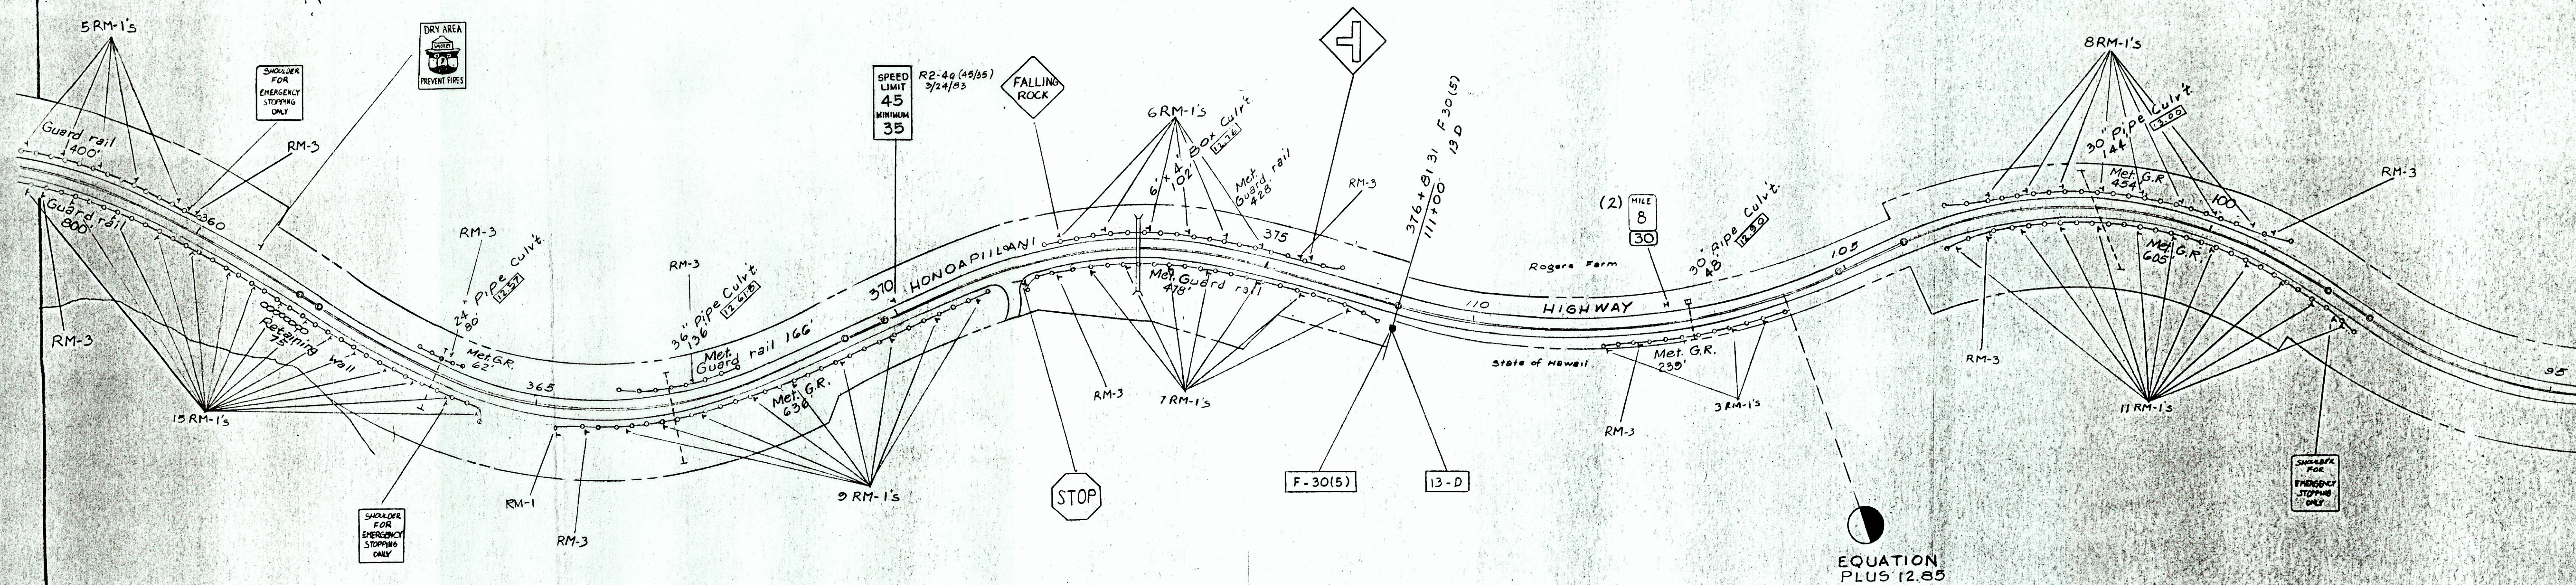

SCALE
1"=100'

DATE	REVISION
3/29/83	Field Check & Plotted
4/5/85	W.O. # 82-11, Posted R2-4a (45/35)
2/20/85	RM-1, RM-3

STATE OF HAWAII
DEPARTMENT OF TRANSPORTATION
HIGHWAYS DIVISION

SIGNS & PAVEMENT MARKINGS
HONOAPIʻILANI HIGHWAY

F.A.P. No. 13-D
F.A.P. No. F-30(5)

SECT. 30C
SHEET No. 20 OF 24 SHEETS