


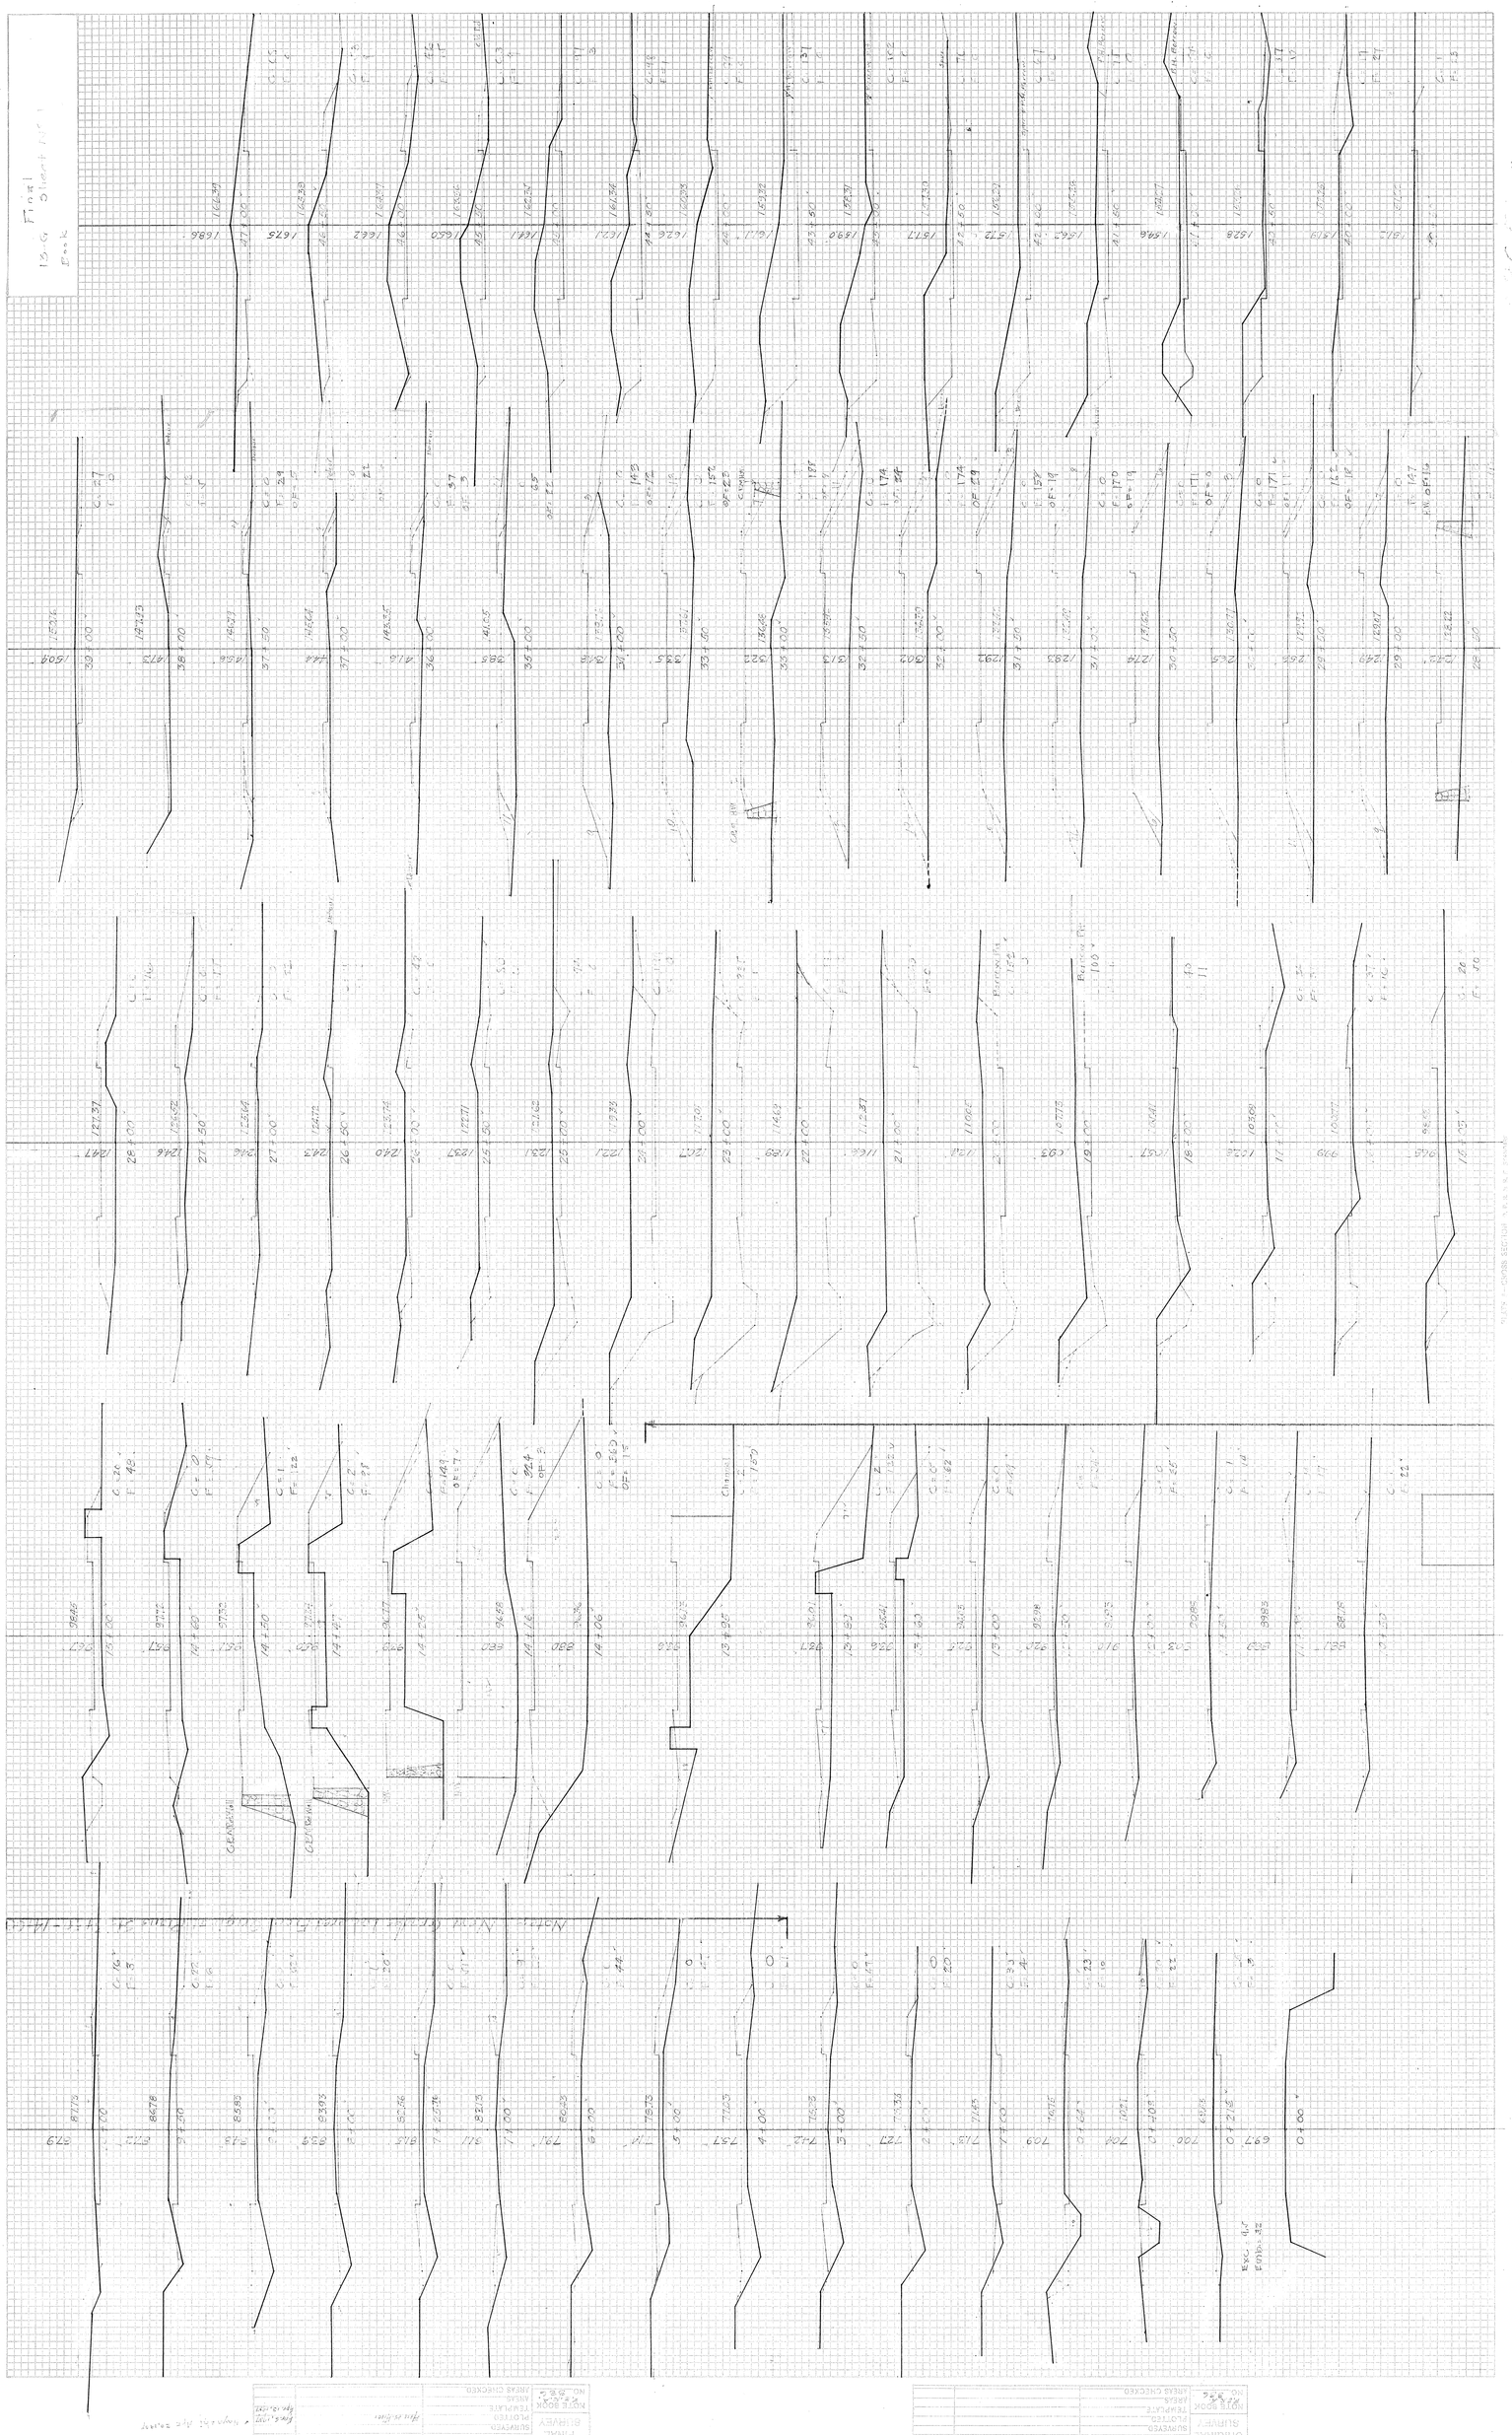


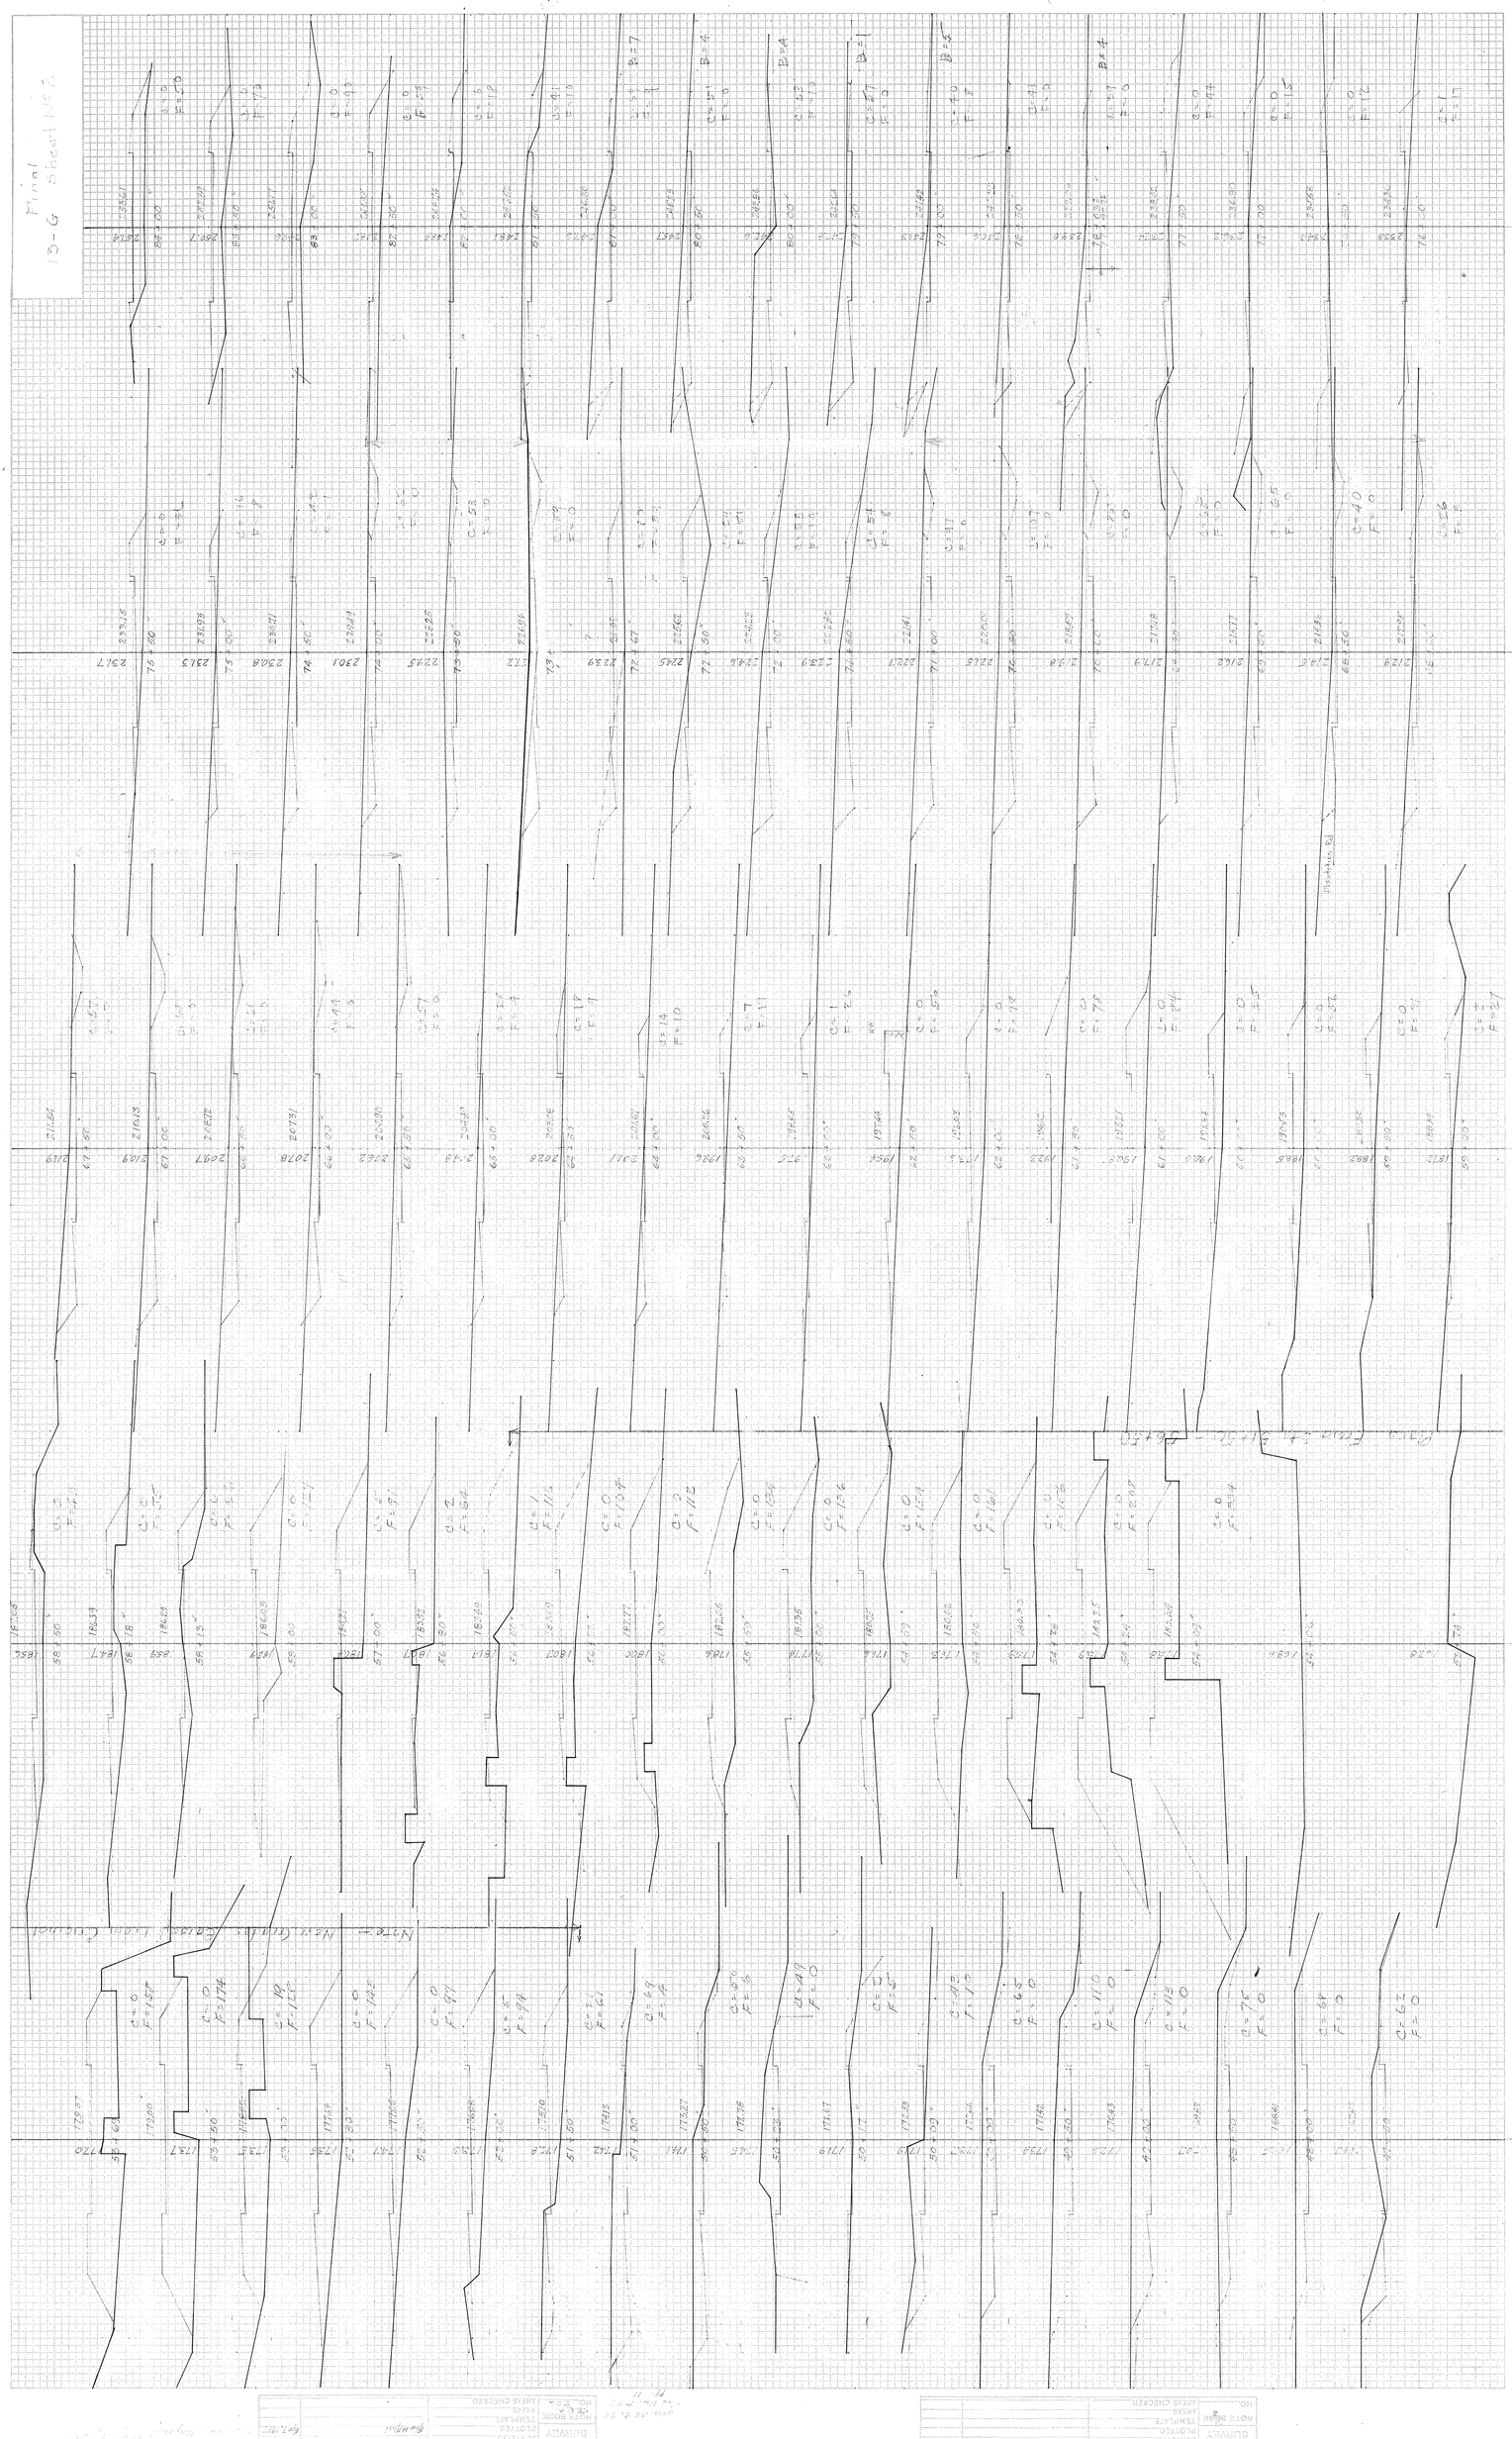

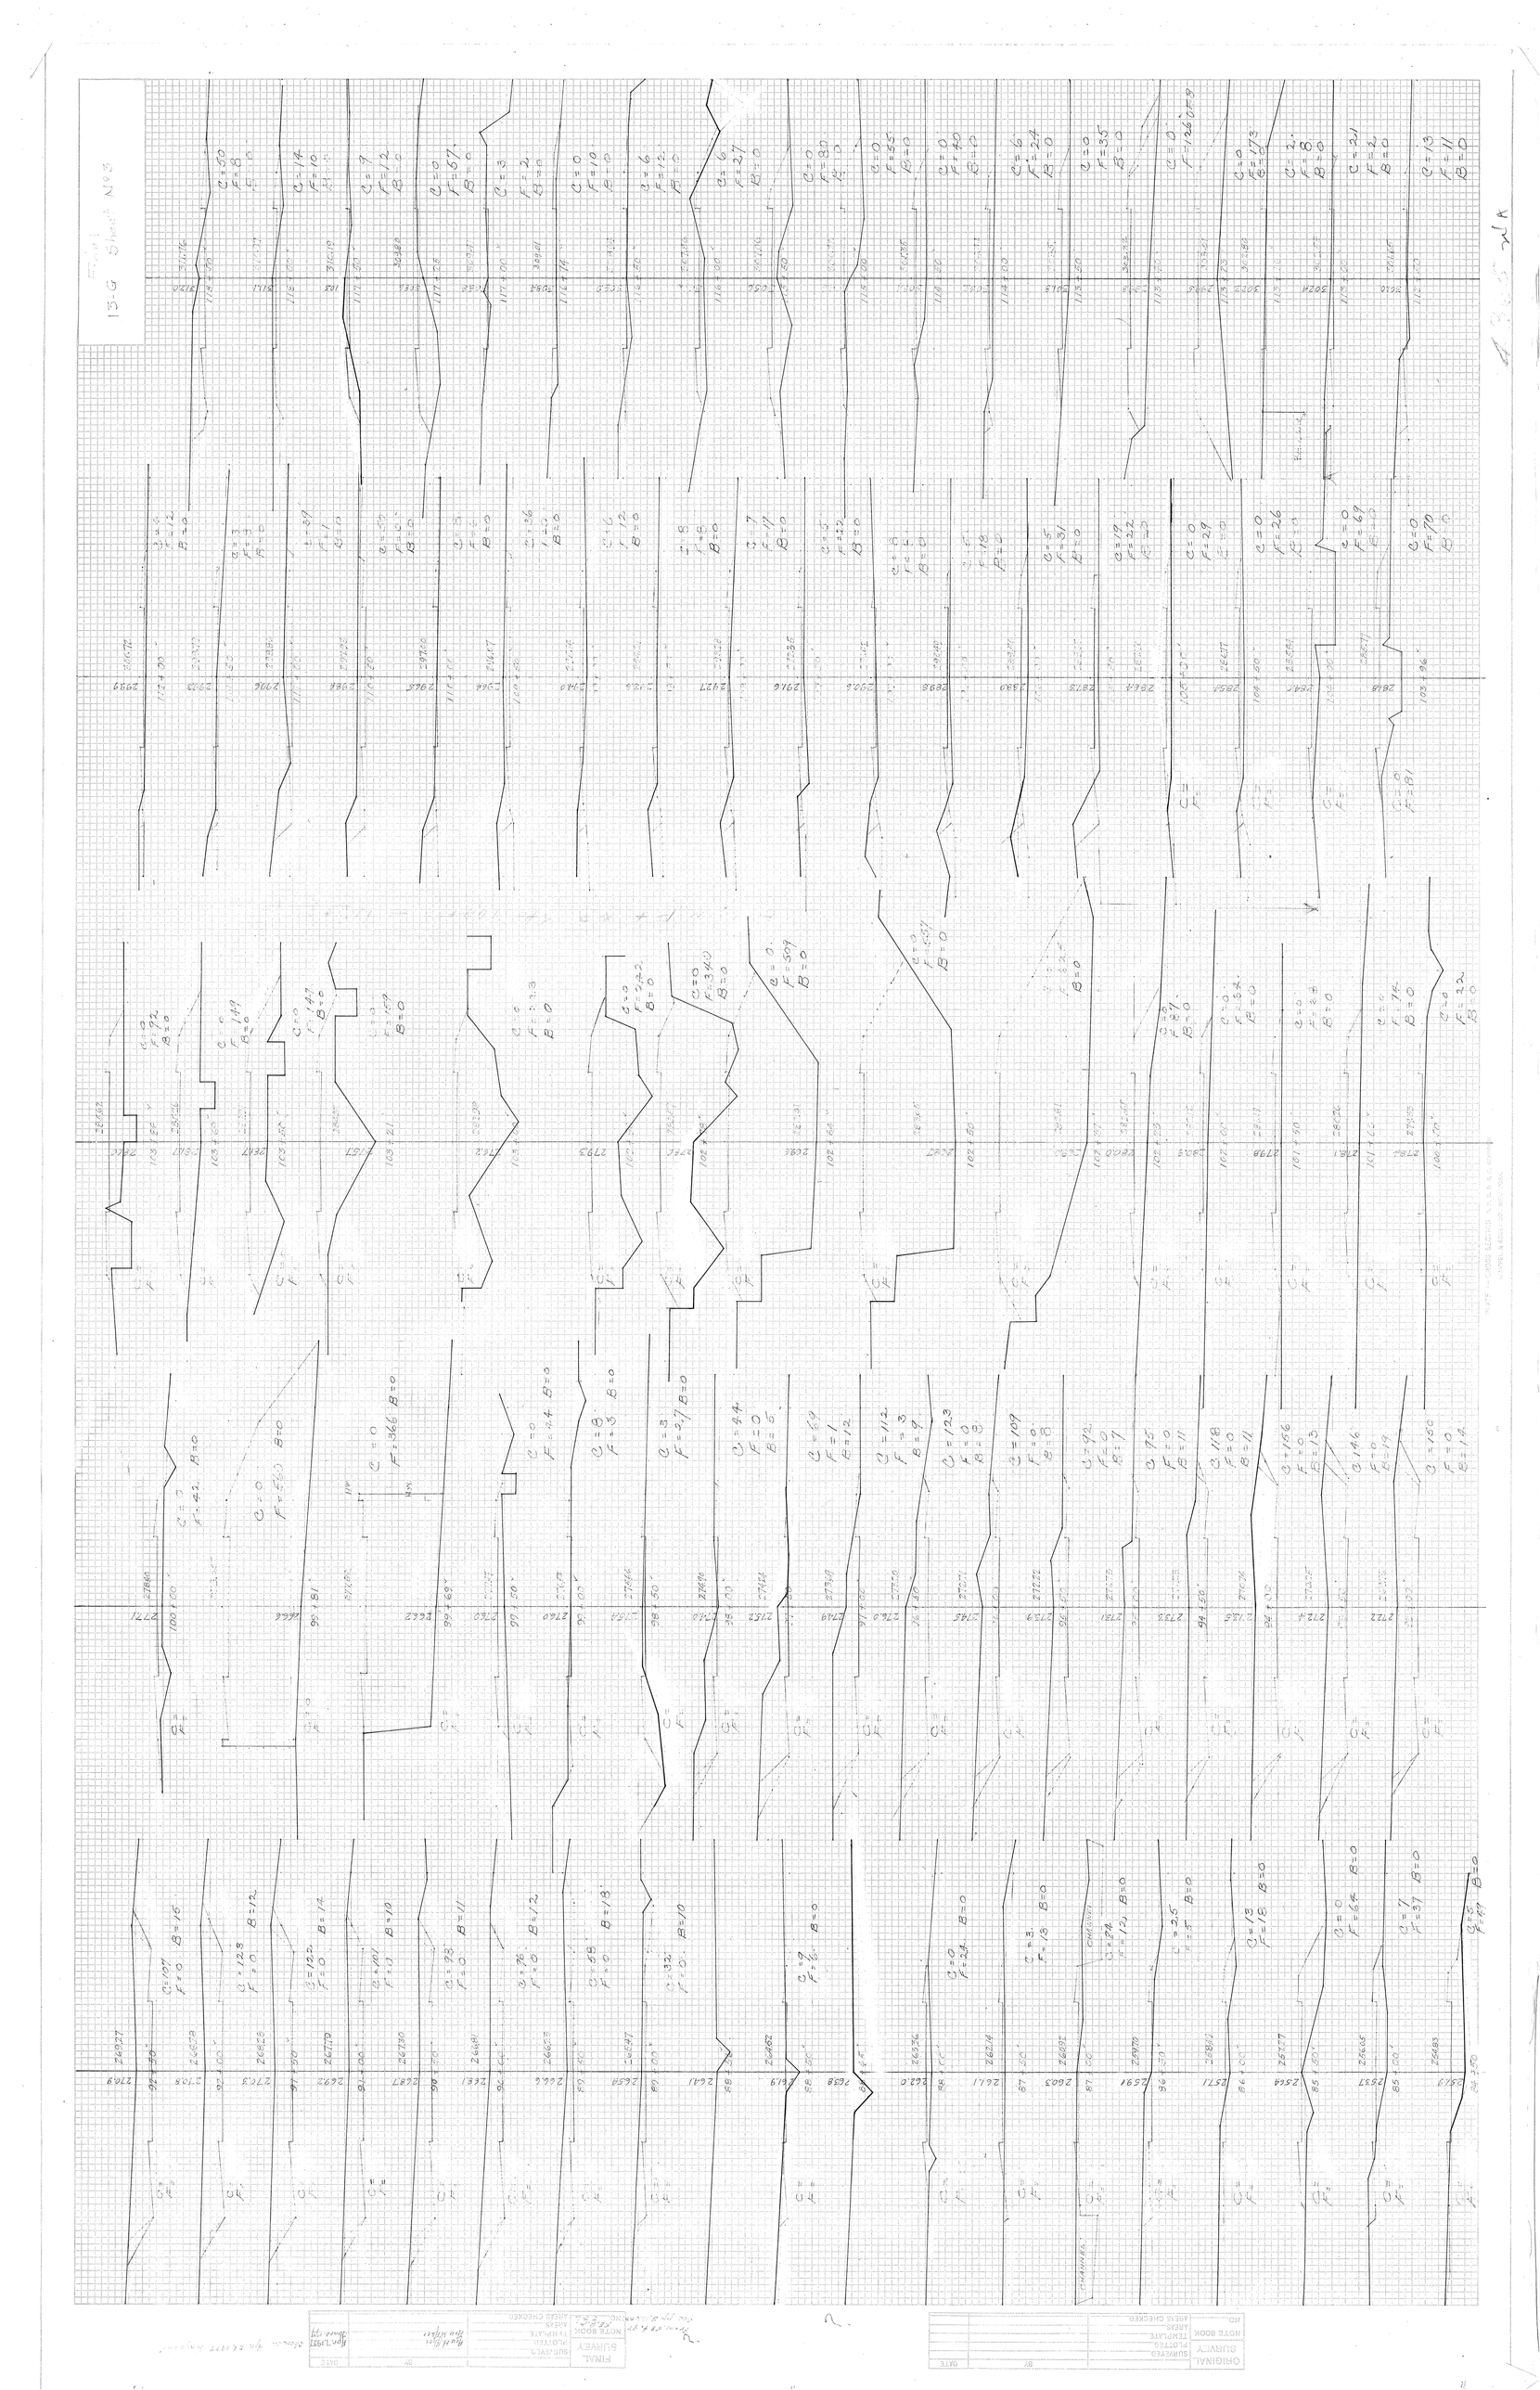


Final
13-G Sheet No.
Note - New Grades Located From Guided Plans

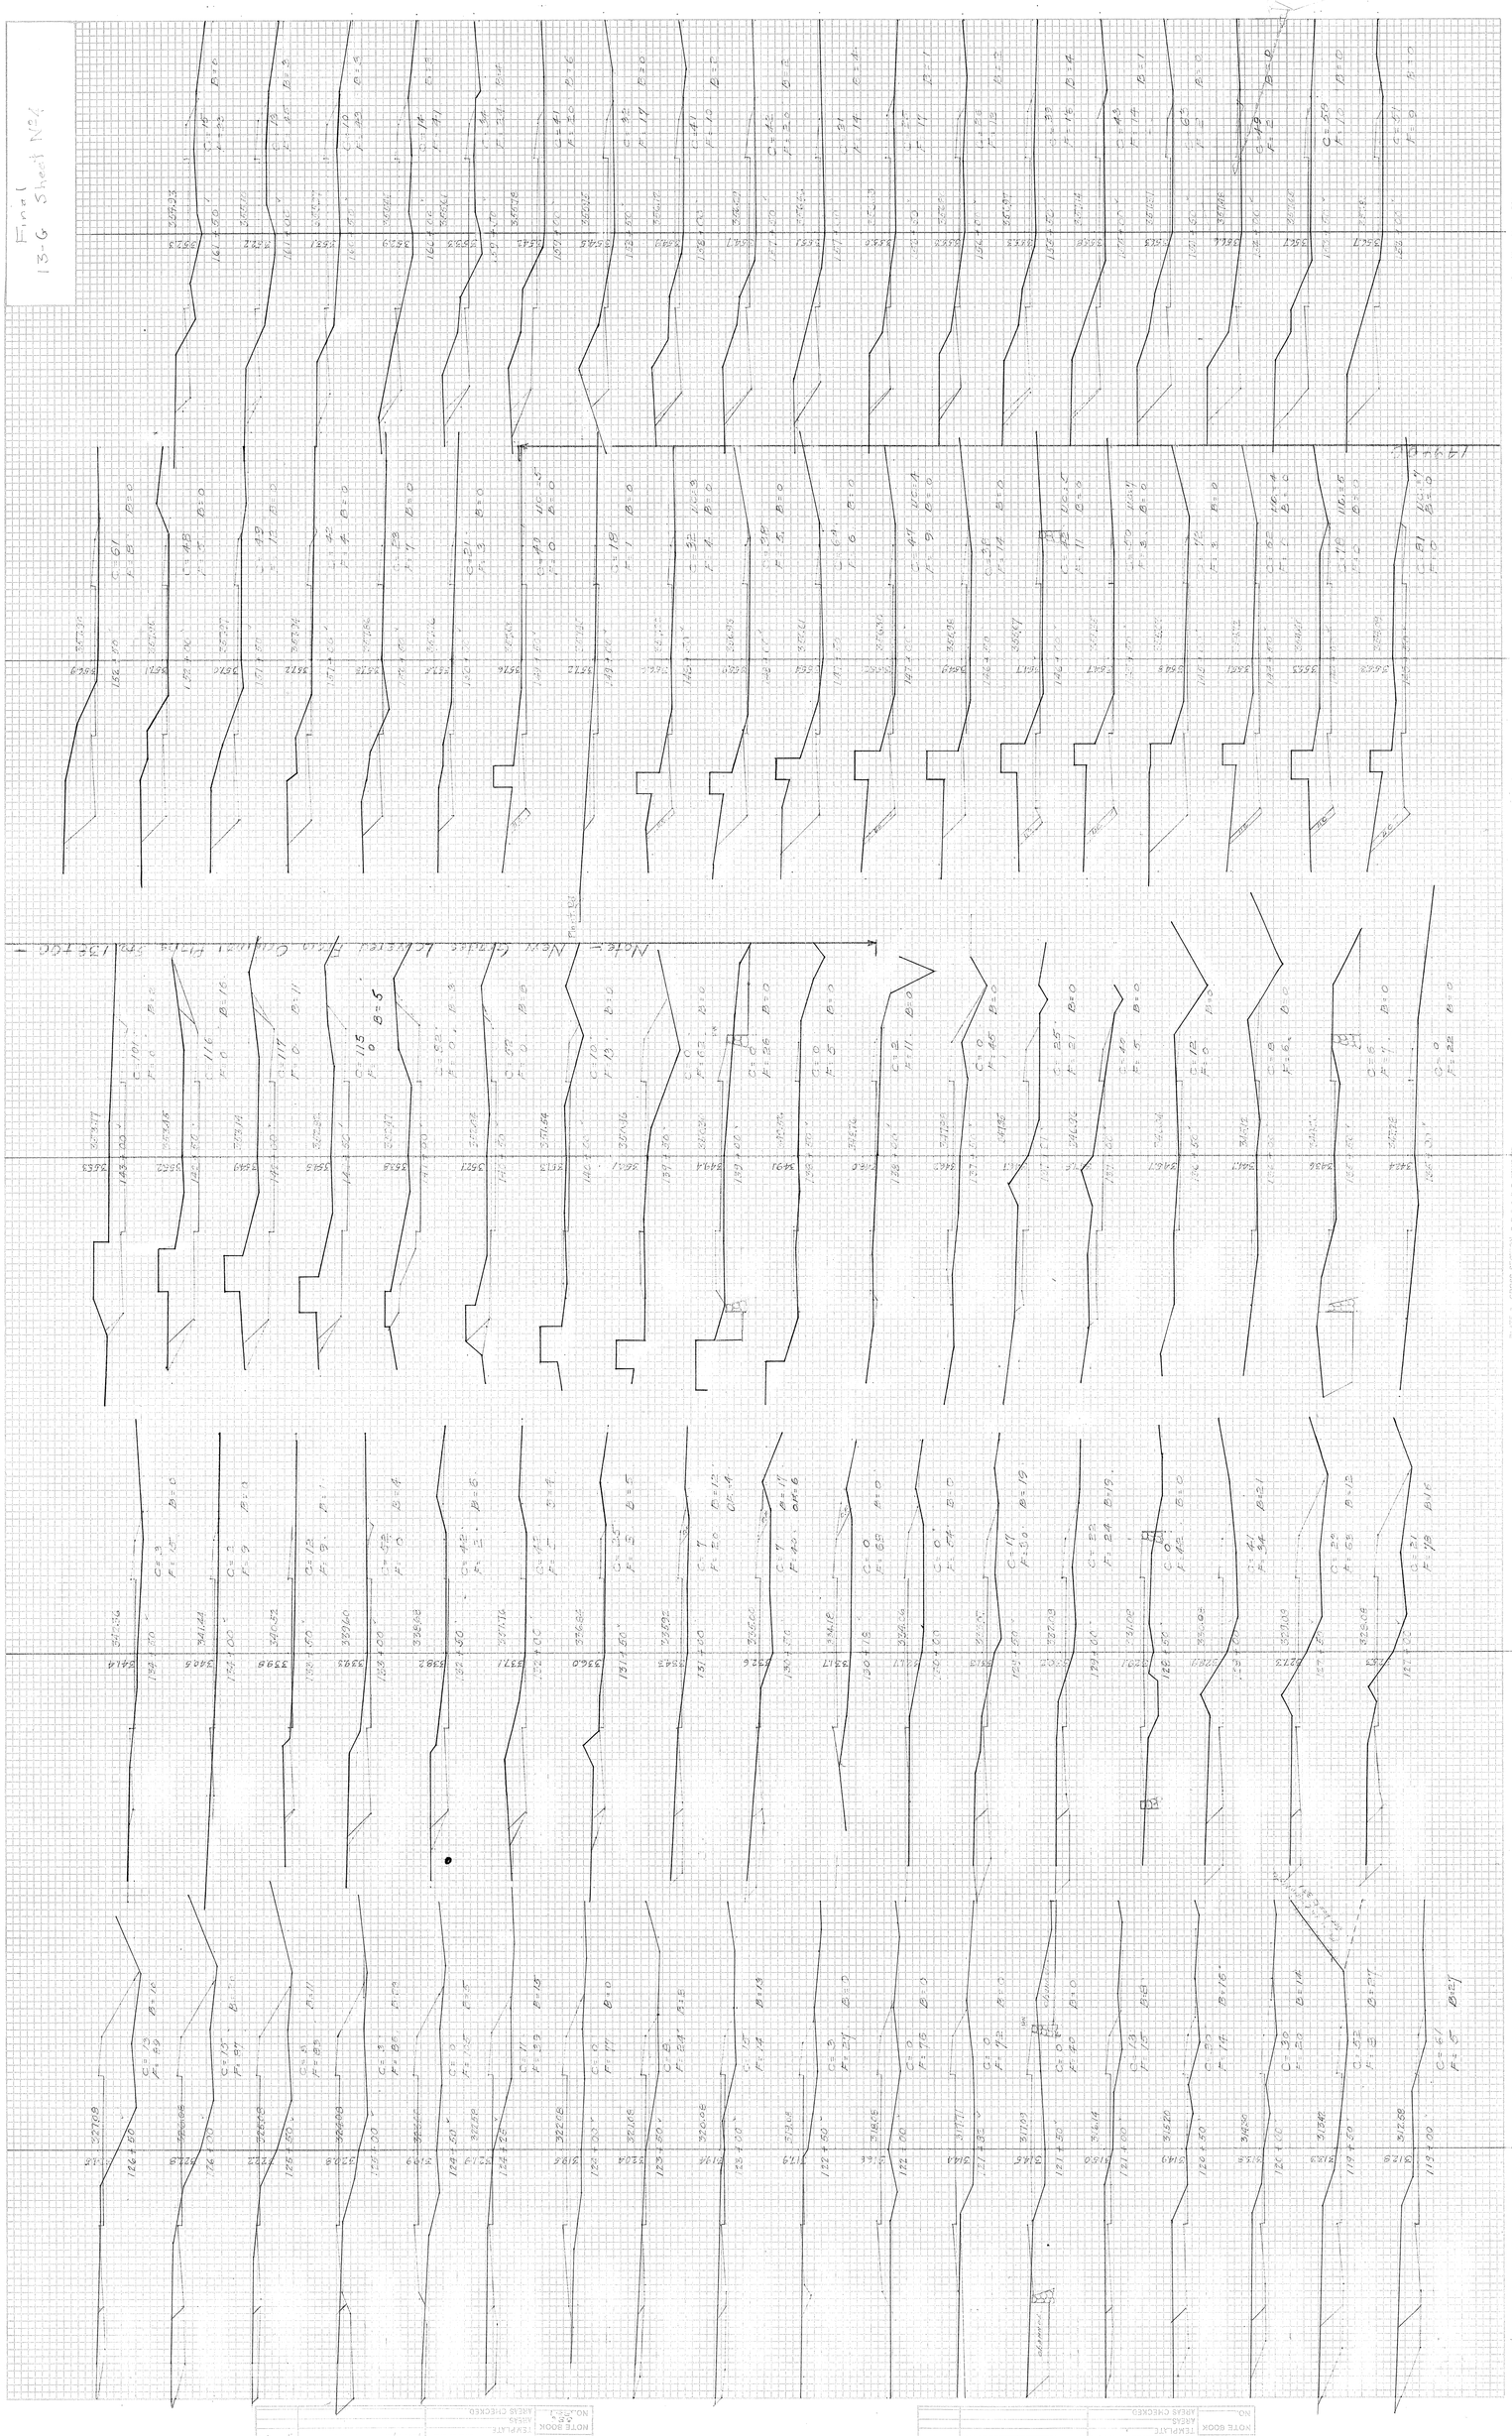