
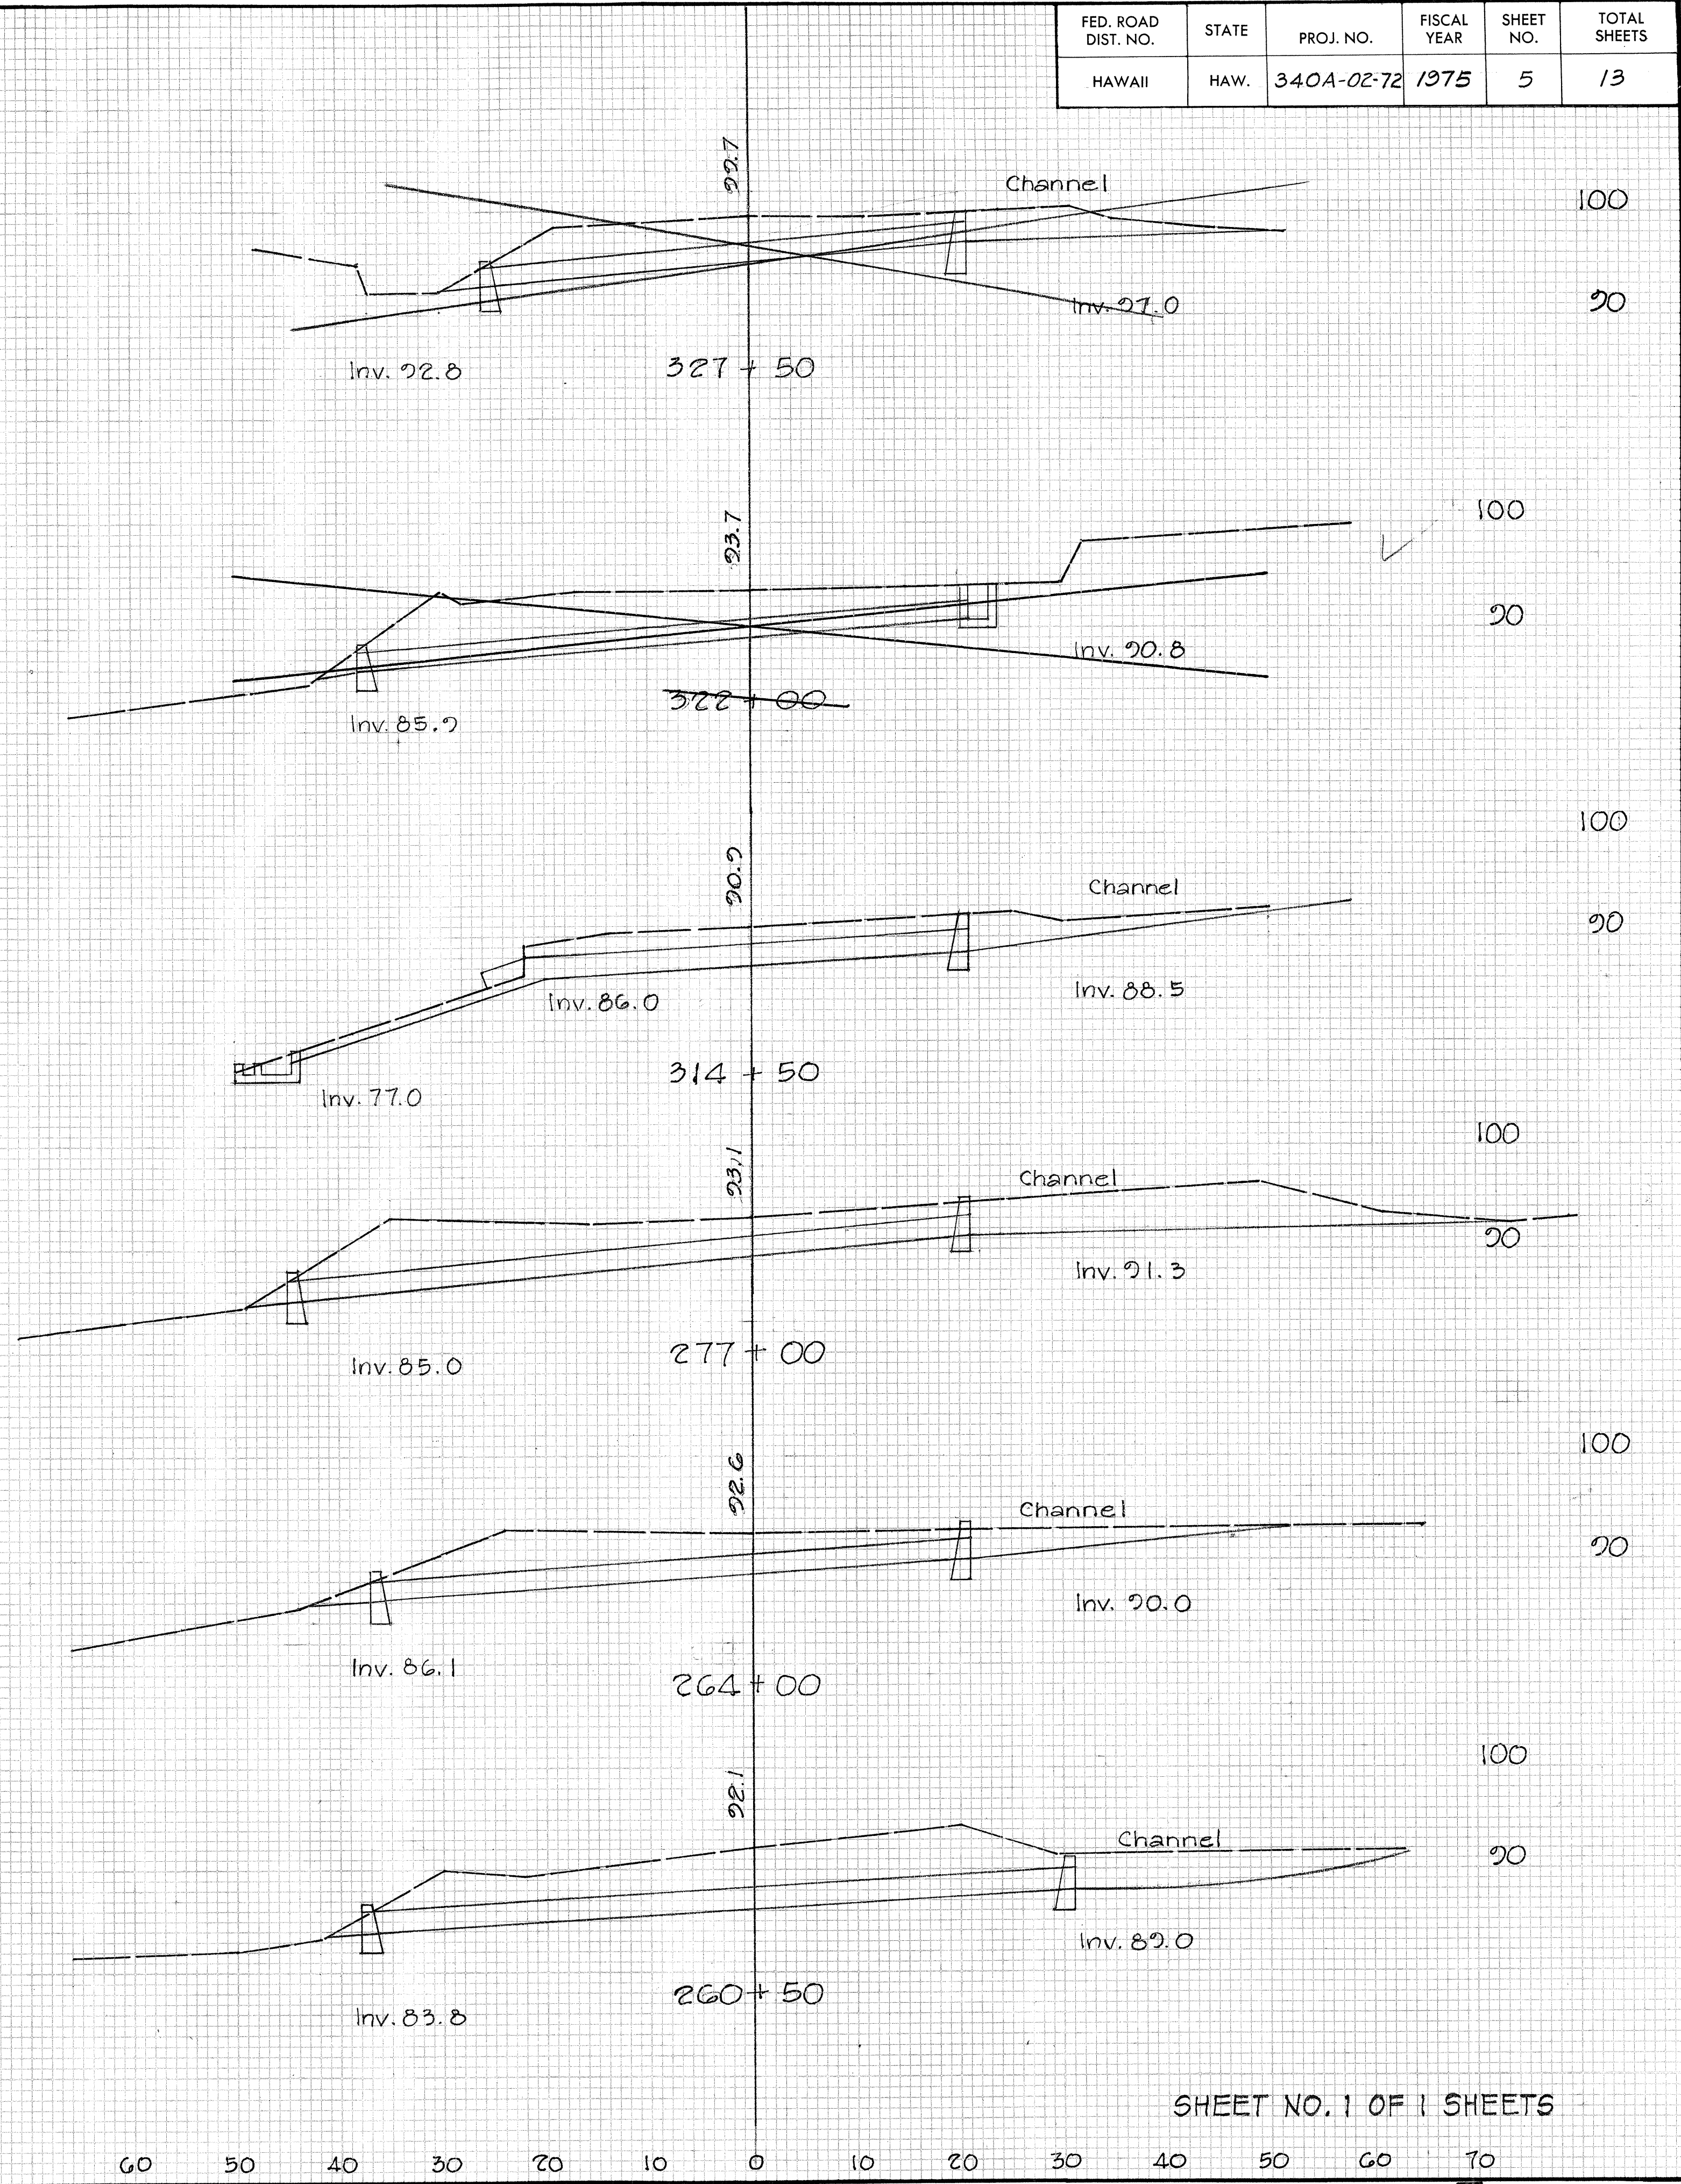


FED. ROAD DIST. NO.	STATE	PROJ. NO.	FISCAL YEAR	SHEET NO.	TOTAL SHEETS
HAWAII	HAW.	340A-02-72	1975	5	13

DATE	BY	SURVEYED	PLOTTED	NOTED	CHECKED

DATE	BY	SURVEYED	PLOTTED	NOTED	CHECKED

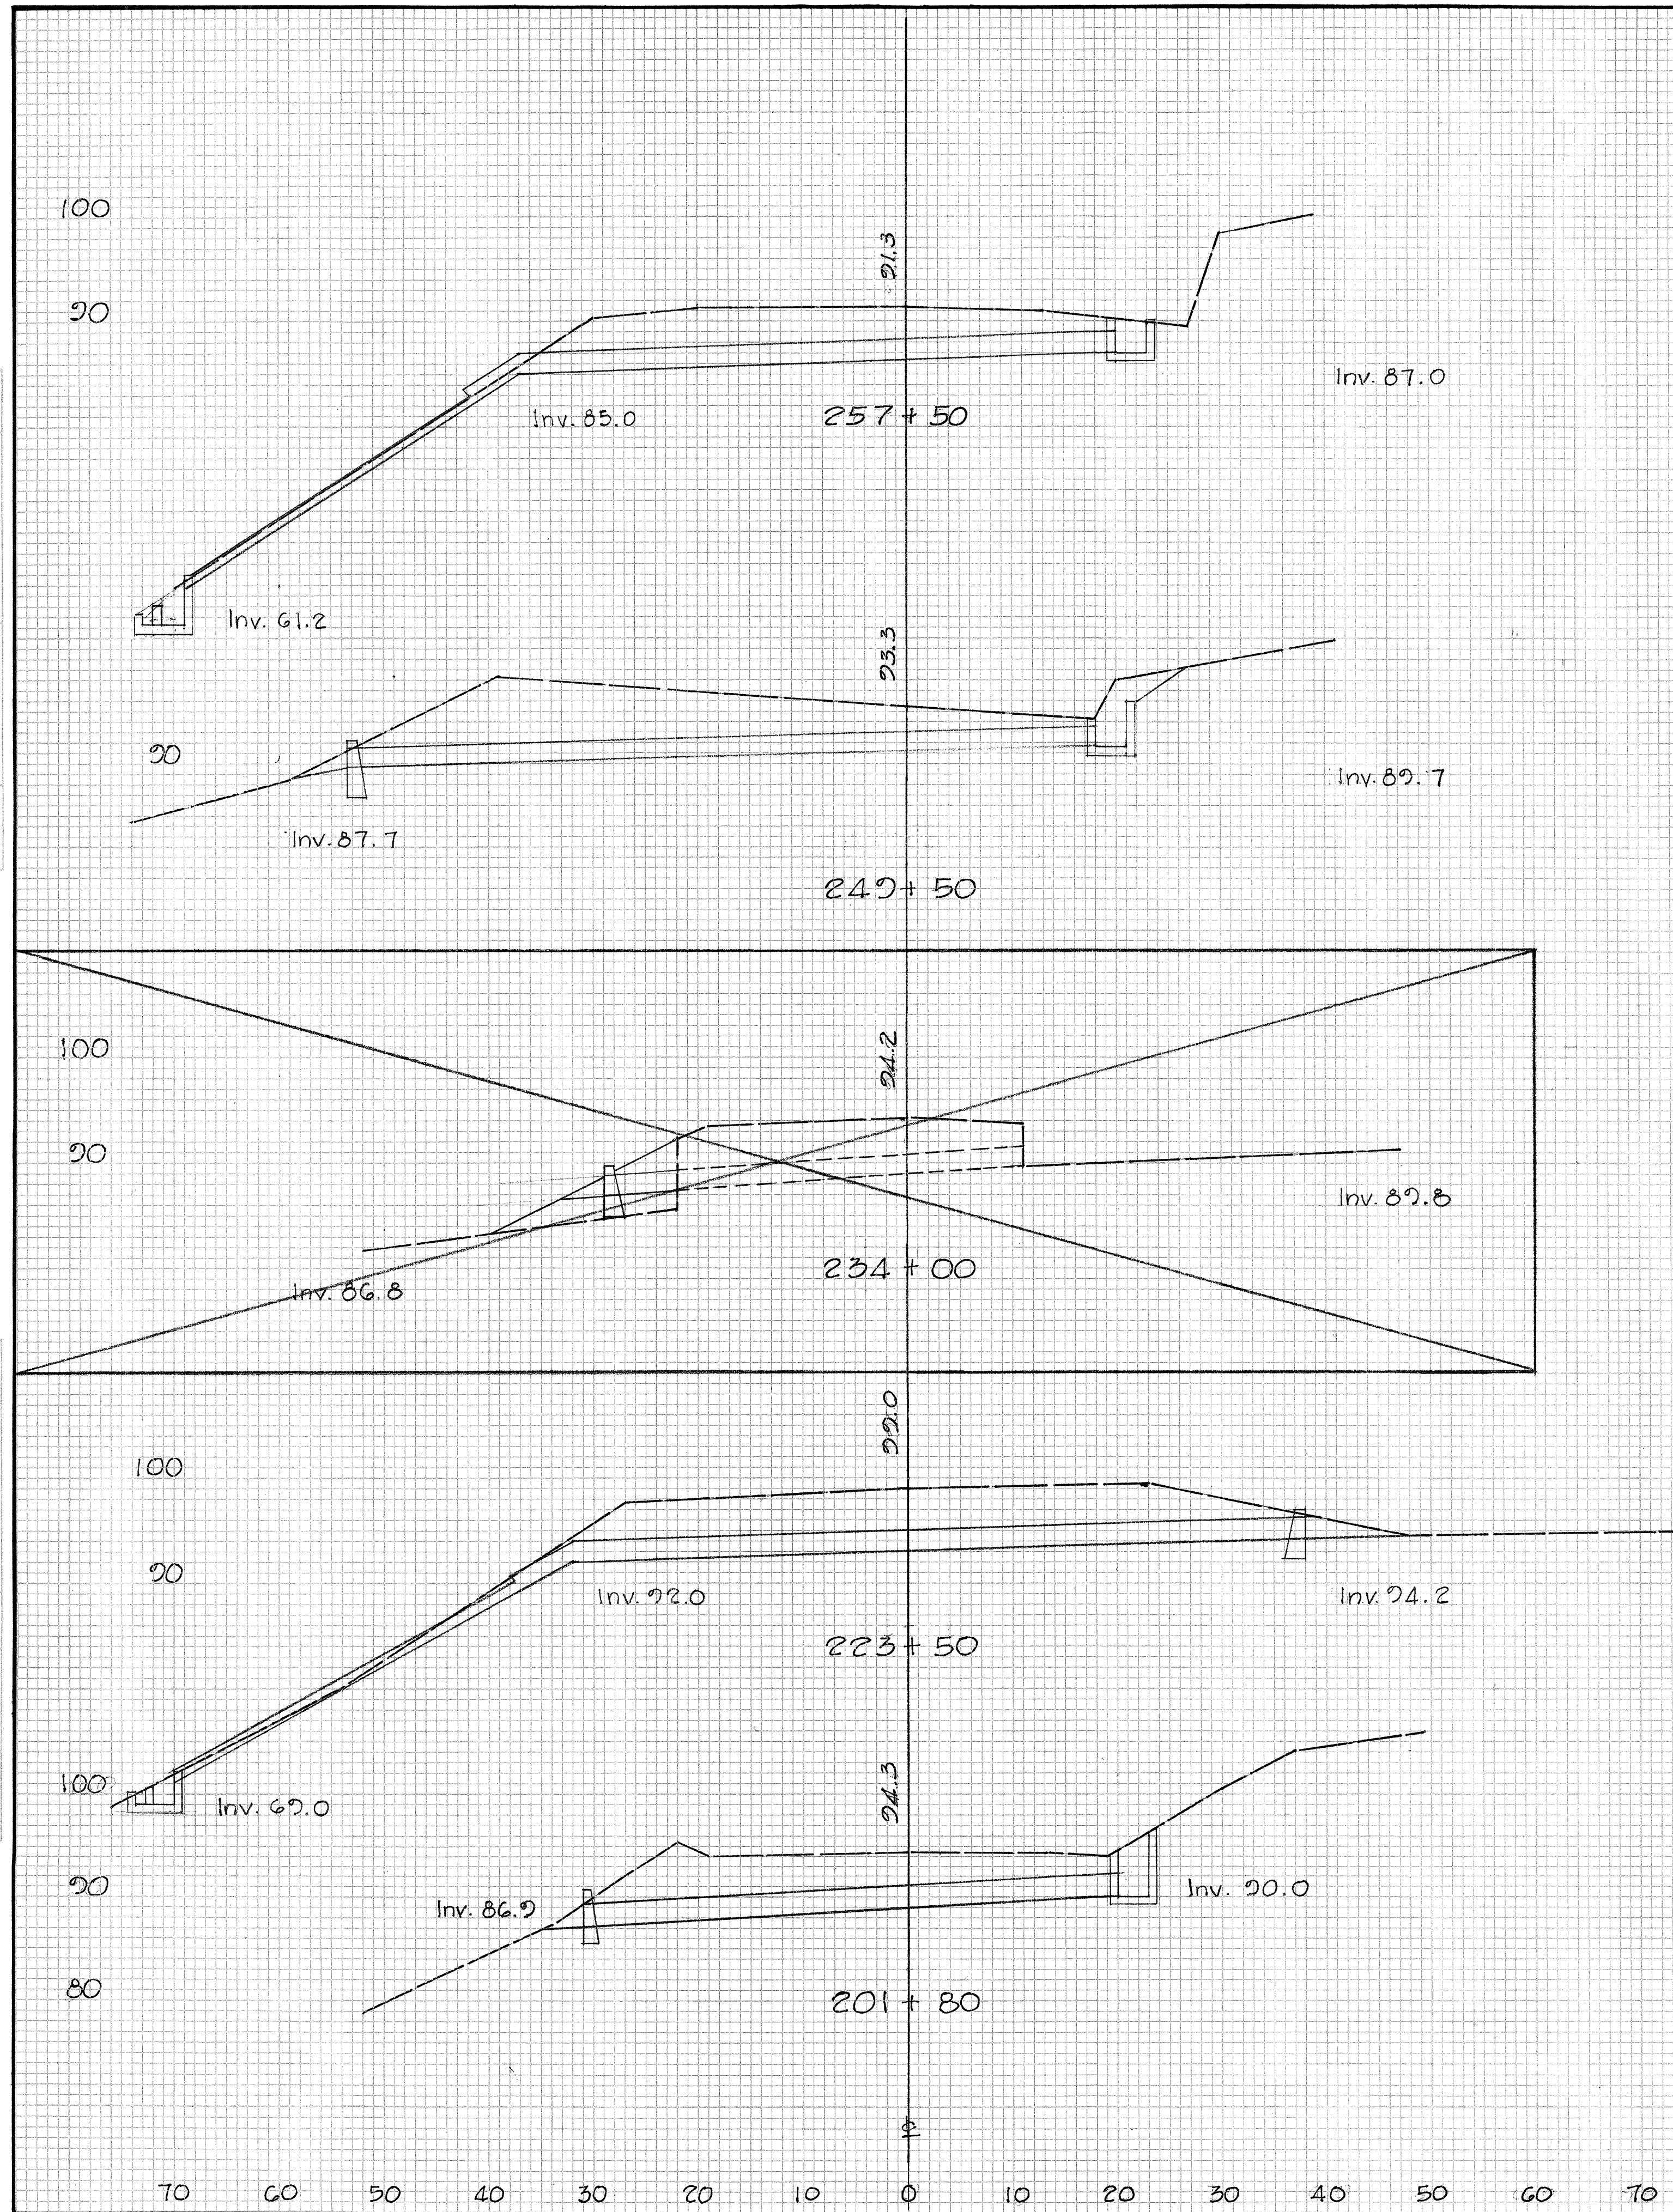

SHEET NO. 1 OF 1 SHEETS