



FED. ROAD DIST. NO.	STATE	FED. AID PROJ. NO.	FISCAL YEAR	SHEET NO.	TOTAL SHEETS
HAWAII	HAW.	HES-030-1(17)	1983	5	22

ORIGINAL PLAN	DATE
SURVEY PLOTTED BY	_____
DRAWN BY	_____
DESIGNED BY	_____
CHECKED BY	_____
NO.	_____

R	Y	G
A-1	B-2	A-4
A-2	C-2	D-4
A-3		E-3
B-1		F-2
C-1		G-4
D-2		
D-3		
E-1		
E-2		
* F-1		
* G-1		
* G-2		
G-3		

* PROGRAMMED VISIBILITY HEAD

SIGNAL INDICATIONS

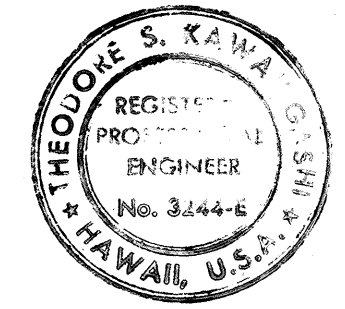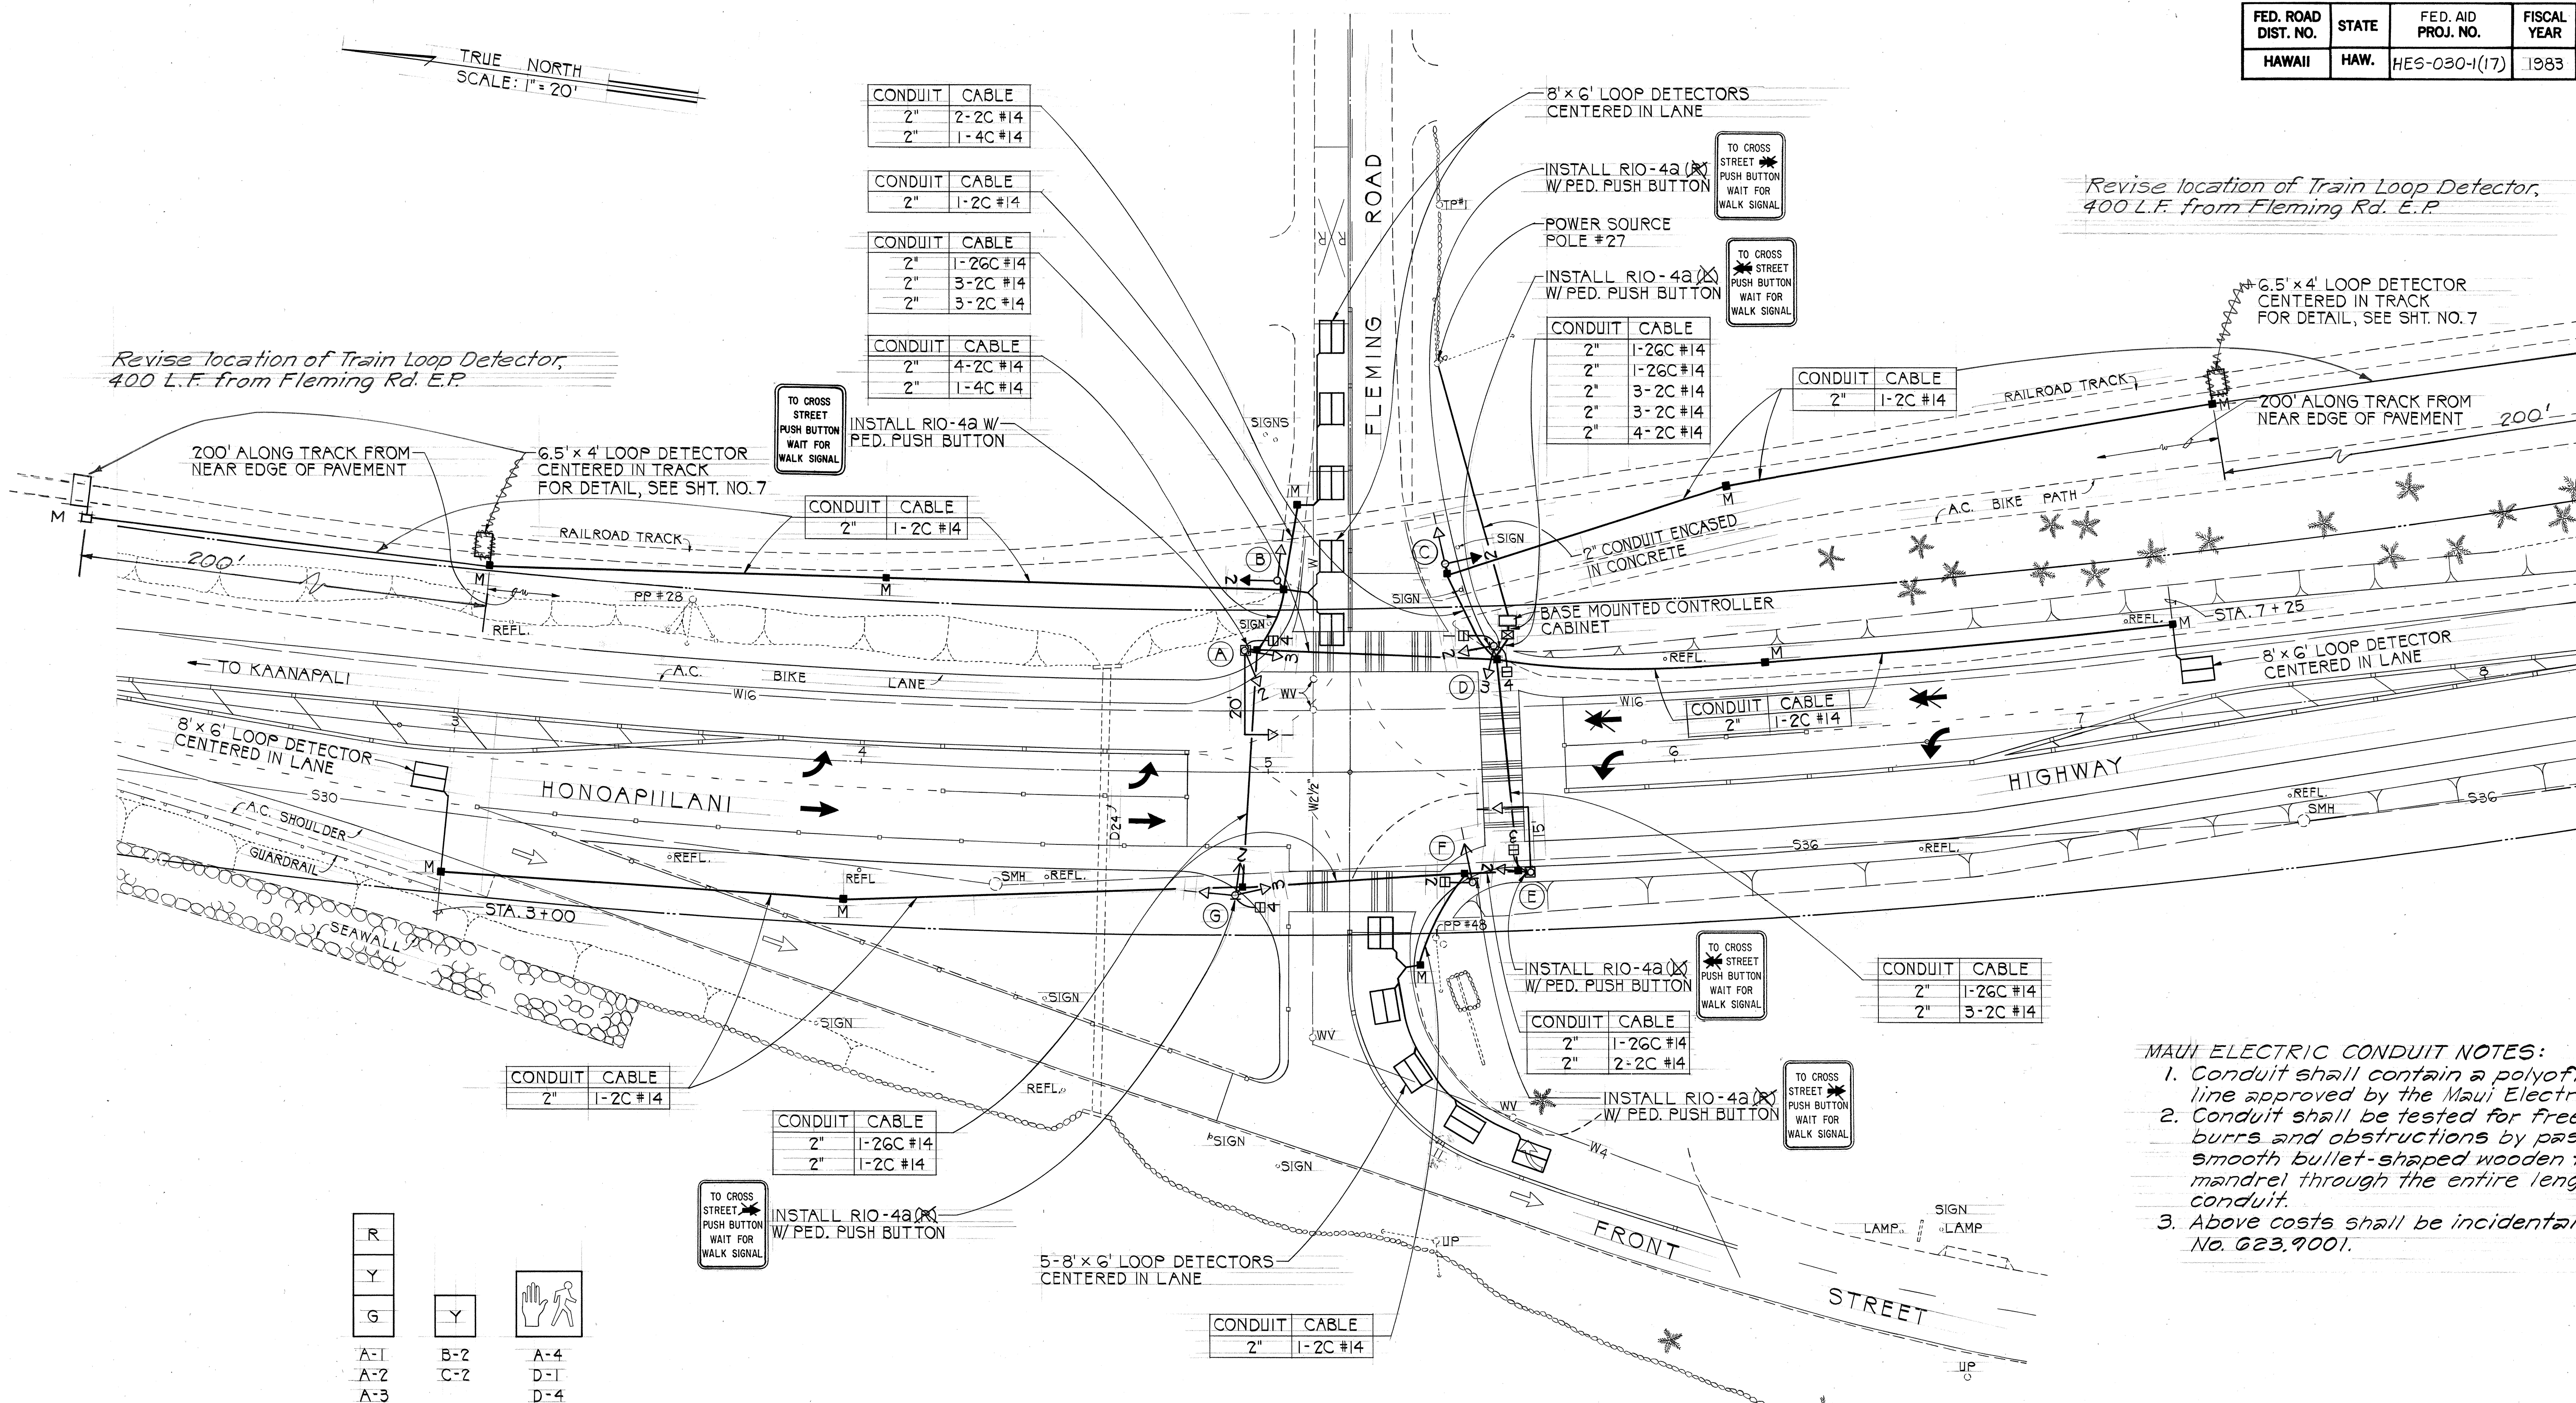

THIS WORK WAS PREPARED BY ME
OR UNDER MY SUPERVISION
Theodore S. Kawauchi
Signature

STATE OF HAWAII
DEPARTMENT OF TRANSPORTATION
HIGHWAYS DIVISION

TRAFFIC SIGNAL PLAN

HONOAPIILANI HIGHWAY
TRAFFIC SIGNALS AT
FLEMING ROAD

FED. AID PROJECT NO. HES-030-1(17)

SCALE: AS SHOWN DATE: 12-23-82

SHEET NO. 1 OF 1 SHEETS

5