INDEX TO DRAWINGS	
SHEET NO.	DESCRIPTION
1	TITLE SHEET
2	DRAINAGE PLAN AND DETAILS

FED. ROAD DIST. NO.	STATE	PROJ. NO.	FISCAL YEAR	SHEET NO.	TOTAL SHEETS
HAWAII	HAW.	30A - 01 - 83M	1983	1	2

30

STATE OF HAWAII

DEPARTMENT OF TRANSPORTATION

HIGHWAYS DIVISION

HONOLULU, HAWAII

"AS BUILT"
PLANS FOR

HONOAPIILANI HIGHWAY

STORM DAMAGE IN THE VICINITY OF LAHAINA INDUSTRIAL PARK

PROJECT NO. 30A-01-83M

DISTRICT OF LAHAINA
ISLAND OF MAUI

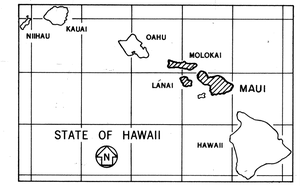

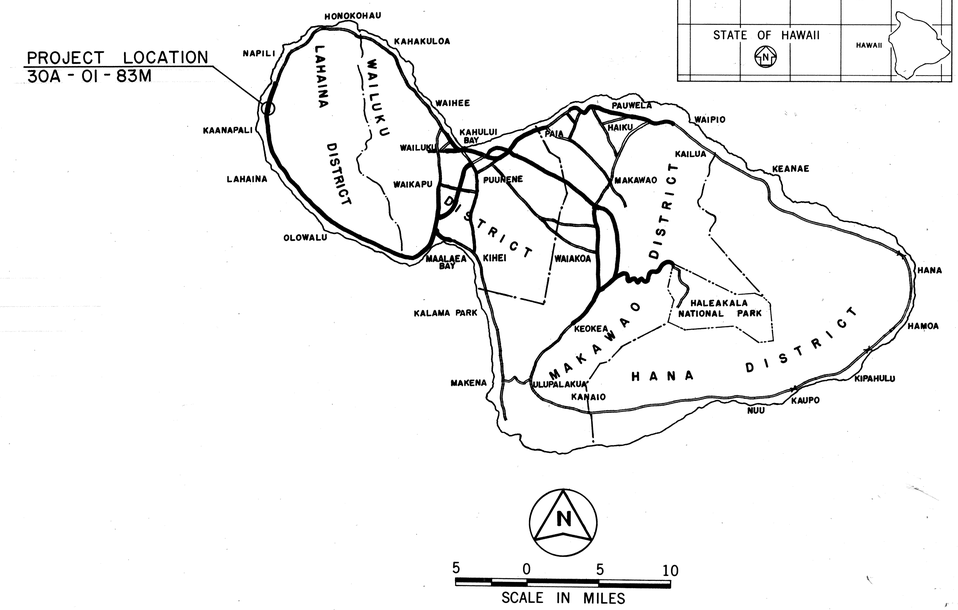

FEDERAL AID PROJECTS PREVIOUSLY CONSTRUCTED OR UNDER CONSTRUCTION

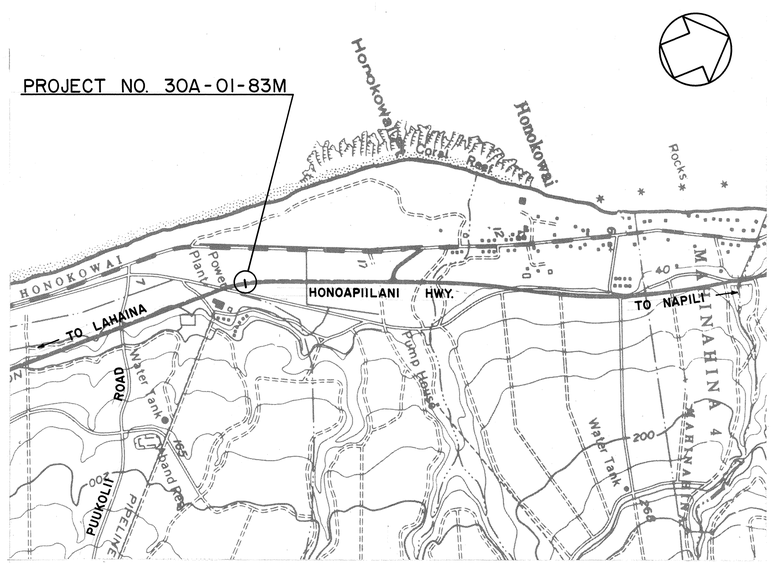

LAYOUT PLAN

1000 0 1000 2000 3000 4000
SCALE IN FEET

ALL CHANGES MADE DURING CONSTRUCTION HAVE BEEN INCORPORATED ON THESE PLANS IN RED EXCEPT CHANGES IN THE ORIGINAL THEORETICAL QUANTITIES, FOR ACTUAL QUANTITIES, REFER TO PROJECT LEDGER AND/OR COMPUTATION BOOK.

Ferdinand Cajigal — RESIDENT ENGINEER — 9/19/83 DATE

HWY-DH	R. Siarot	548-7537	Feb. 1983
DESIGNED BY	P. S. & E. BY	PHONE	DATE

DEPARTMENT OF TRANSPORTATION
STATE OF HAWAII
APPROVED:
DIR. OF TRANSPORTATION — 2/25/83 DATE

C-7-2