FED. ROAD DIST. NO.	STATE	FED. AID PROJ. NO.	FISCAL YEAR	SHEET NO.	TOTAL SHEETS
HAWAII	HAW.	30AC-01-87M 30A-01-87	1987	19	19

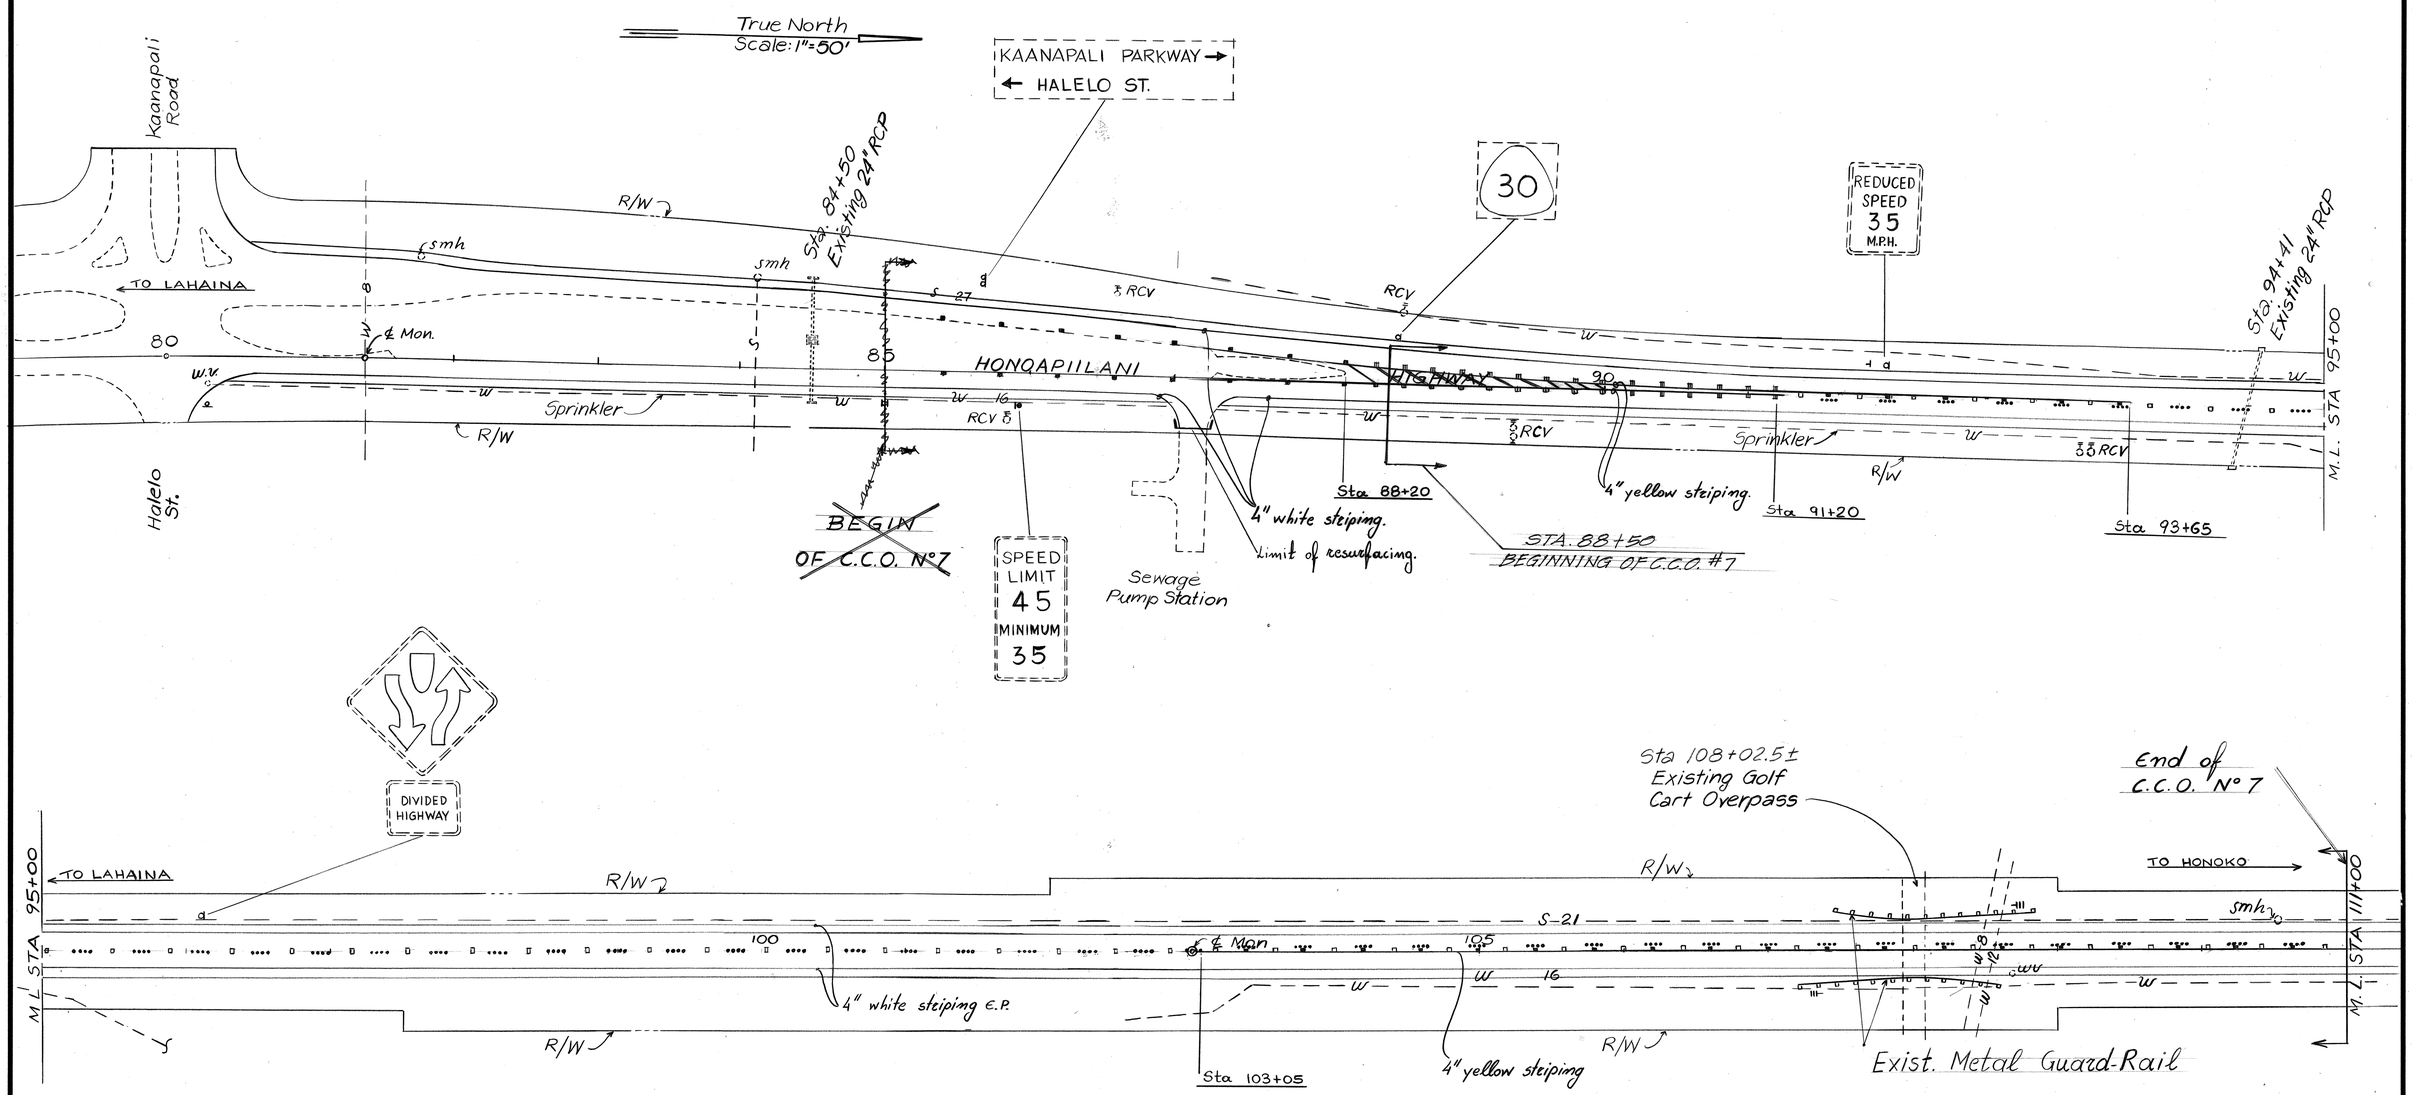

FROM – TO	CONDITION	STRIPING WHITE	STRIPING YELLOW	MARKER TYPE CL	DL	HL	J
~~85+00 — 88+20~~	~~NO PASS'G – MEDIAN~~	~~640~~	~~810~~			~~16~~	
~~88+20~~ 88+50 — 91+20	NO PASS'G PAV. ISLAND	600	600	~~30~~		30	
91+20 – 93+65	ONE WAY PASSING RT.	490	245		6	6	24
93+65 – 103+05	PASSING RT – LT	1880	—		23		92
103+05 – 111+00	ONE WAY PASSING RT.	1590	795		20	19	76
TOTAL		5,200	2,450	30	49	41	192

ORIGINAL PLAN	
NOTE BOOK	
No.	

	DATE
SURVEY PLOTTED BY	
DRAWN BY	
TRACED BY	
DESIGNED BY	
QUANTITIES BY	
CHECKED BY	

STATE OF HAWAII
DEPARTMENT OF TRANSPORTATION
HIGHWAYS DIVISION

HONOAPIILANI HWY RESURFACING
VICINITY OF OLOWALU AND KAANAPALI
AND
HONOAPIILANI HWY GUARDRAIL AND SHOULDER IMPROVEMENTS KEKAA DRIVE TOWARDS HONOKOWAI.
C.C.O. N° 7

SCALE: 1"=50' DATE: APRIL 4 1988

SHEET No. 19 OF SHEETS