



FED. ROAD DIST. NO.	STATE	FED. AID PROJ. NO.	FISCAL YEAR	SHEET NO.	TOTAL SHEETS
HAWAII	HAW.	NH-030-1(38)	2010	34	213

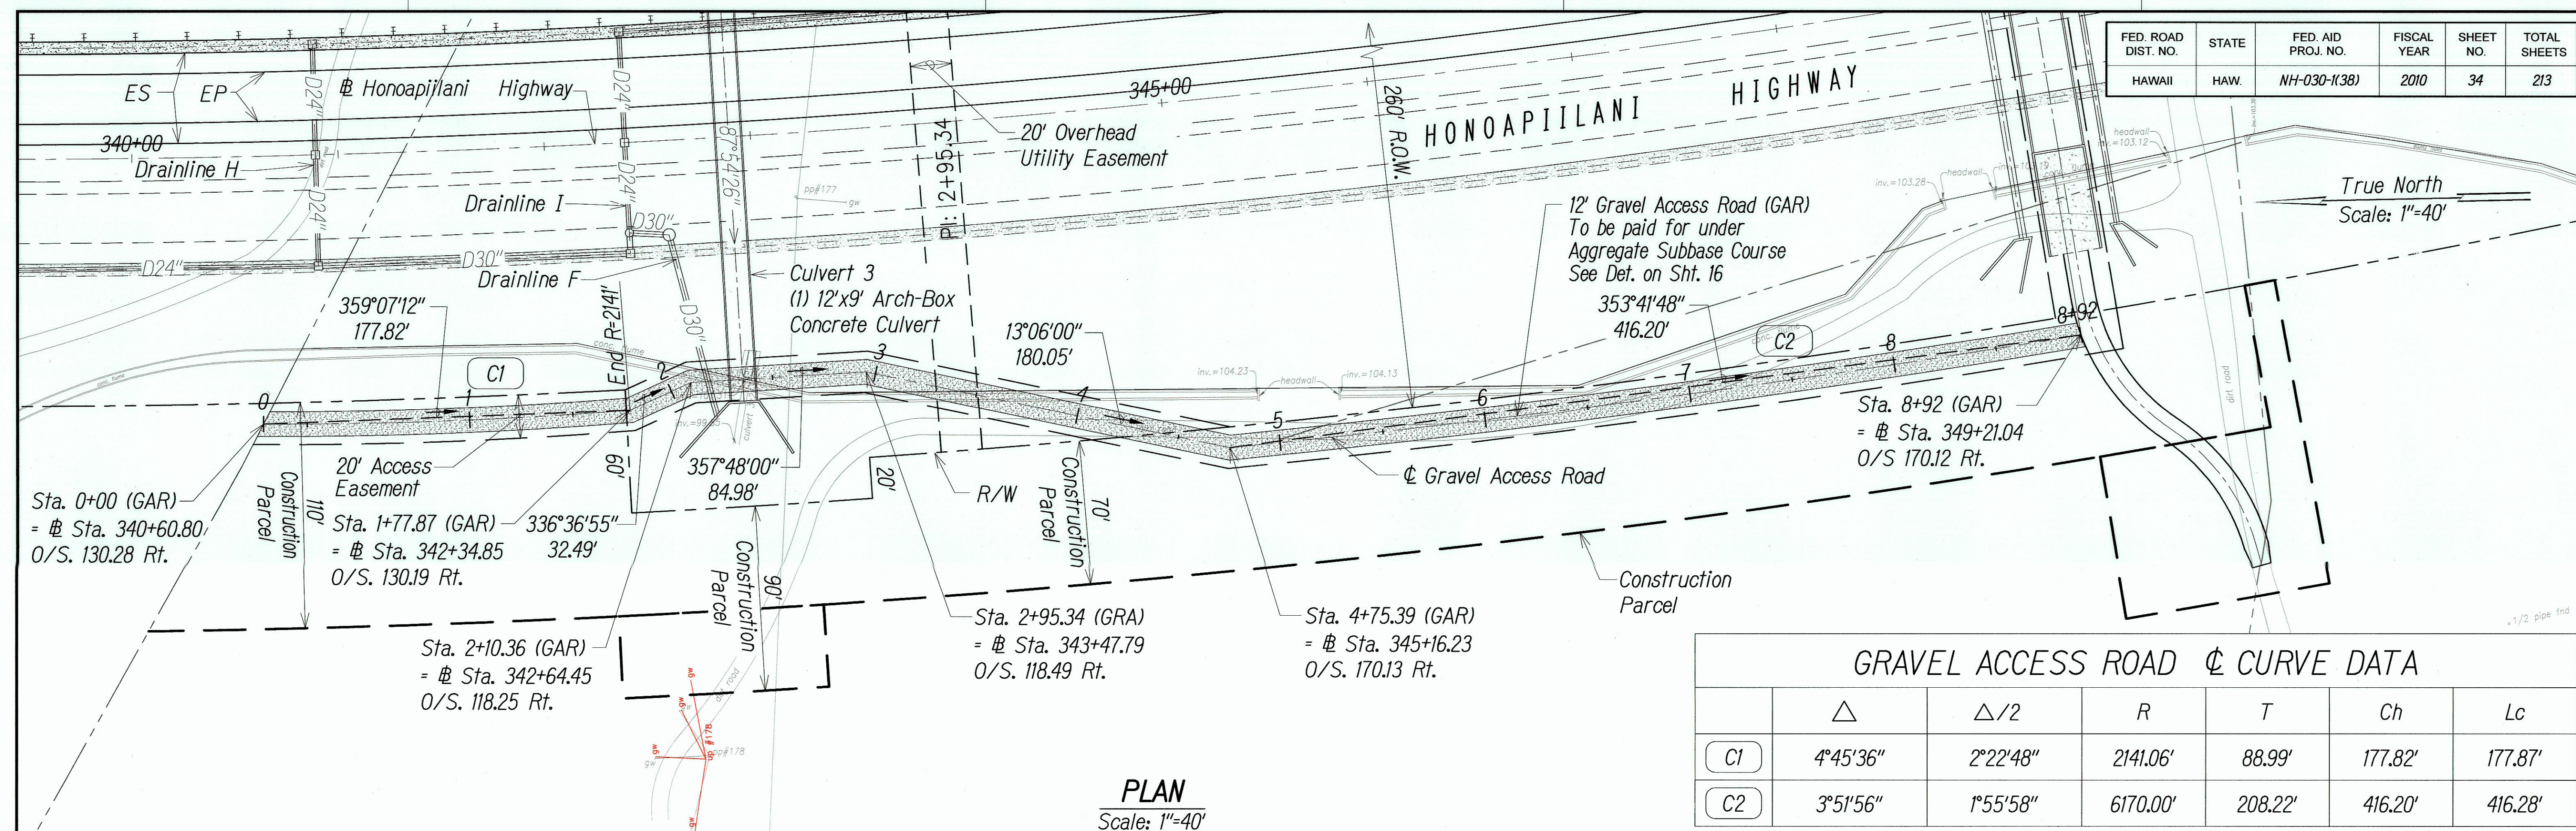

GRAVEL ACCESS ROAD ϕ CURVE DATA						
	Δ	$\Delta/2$	R	T	Ch	Lc
C1	4°45'36"	2°22'48"	2141.06'	88.99'	177.82'	177.87'
C2	3°51'56"	1°55'58"	6170.00'	208.22'	416.20'	416.28'

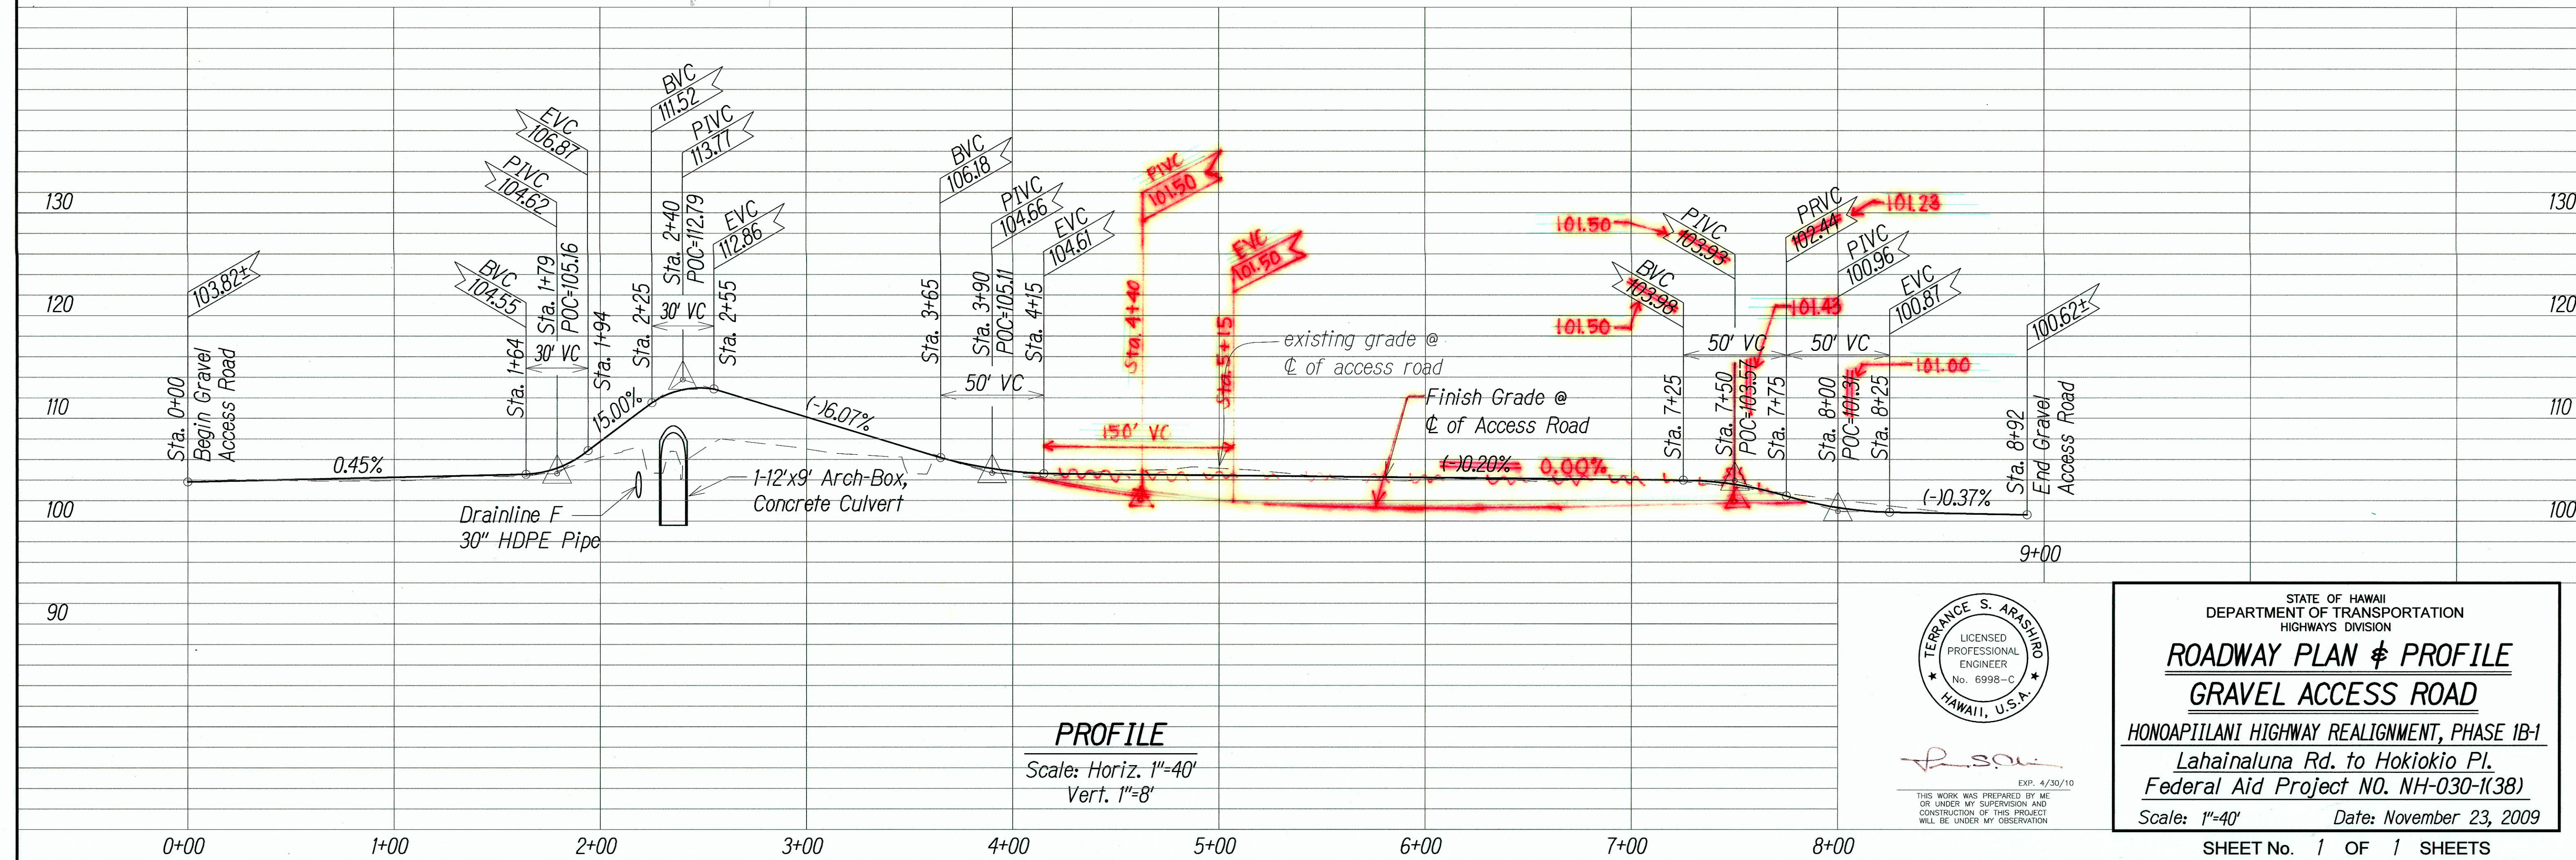

STATE OF HAWAII
DEPARTMENT OF TRANSPORTATION
HIGHWAYS DIVISION

ROADWAY PLAN & PROFILE
GRAVEL ACCESS ROAD

HONOAPIILANI HIGHWAY REALIGNMENT, PHASE 1B-1
Lahainaluna Rd. to Hokiokio Pl.
Federal Aid Project NO. NH-030-1(38)

Scale: 1"=40' Date: November 23, 2009

"AS-BUILT"