FED. ROAD DIST. NO.	STATE	FED. AID PROJ. NO.	FISCAL YEAR	SHEET NO.	TOTAL SHEETS
HAWAII	HAW.	STP-030-1(046)	2011	1	28

INDEX TO DRAWINGS

SHEET NO.	DESCRIPTION
1	TITLE SHEET
2	STANDARD PLANS SUMMARY
3	GENERAL NOTES AND LEGEND
4 – 5	WATER POLLUTION & EROSION CONTROL NOTES
6 – 7	TYPICAL SECTIONS AND DETAILS
8	GUARDRAIL DETAILS
9 – 13	ROADWAY PLANS
14	PAVEMENT MARKING LEGEND, DETAILS AND NOTES
15	CURB RAMP DETAILS
16 – 19	RUMBLE STRIP DETAILS & NOTES
20	WORK ZONE SIGNING PLAN, NOTES & DETAILS
21	SIGN PANEL LAYOUTS
22 – 26	SIGNING AND PAVEMENT MARKING PLANS
27 – 28	TRAFFIC SIGNAL PLANS

STATE OF HAWAII

DEPARTMENT OF TRANSPORTATION

HIGHWAYS DIVISION

HONOLULU, HAWAII

"AS-BUILT"

PLANS FOR

HONOAPIILANI HIGHWAY RESURFACING

HONOKOWAI TO KAHANA

FEDERAL-AID PROJECT NO. STP-030-1(046)

DISTRICT OF LAHAINA

ISLAND OF MAUI

PROJECT LOCATION

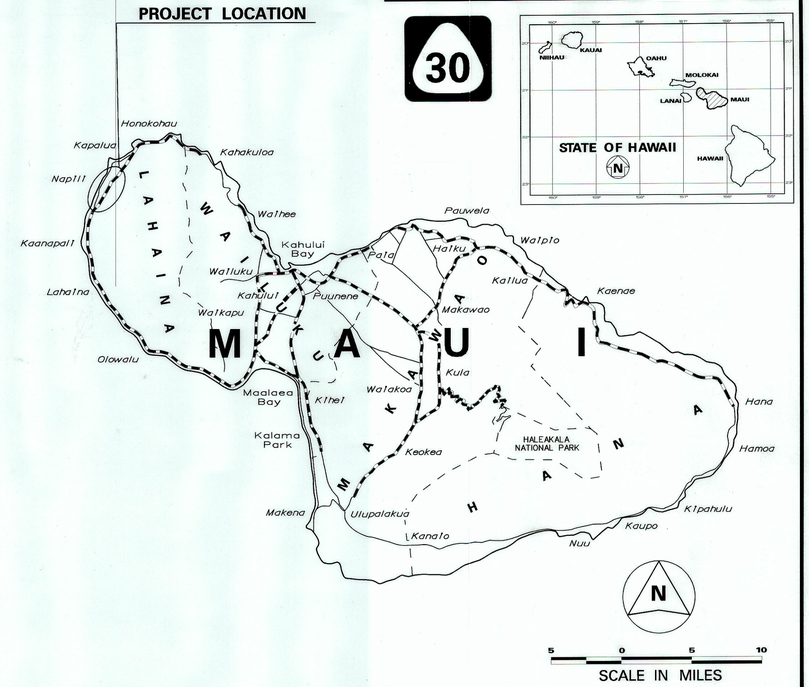

PROJECT LIMITS

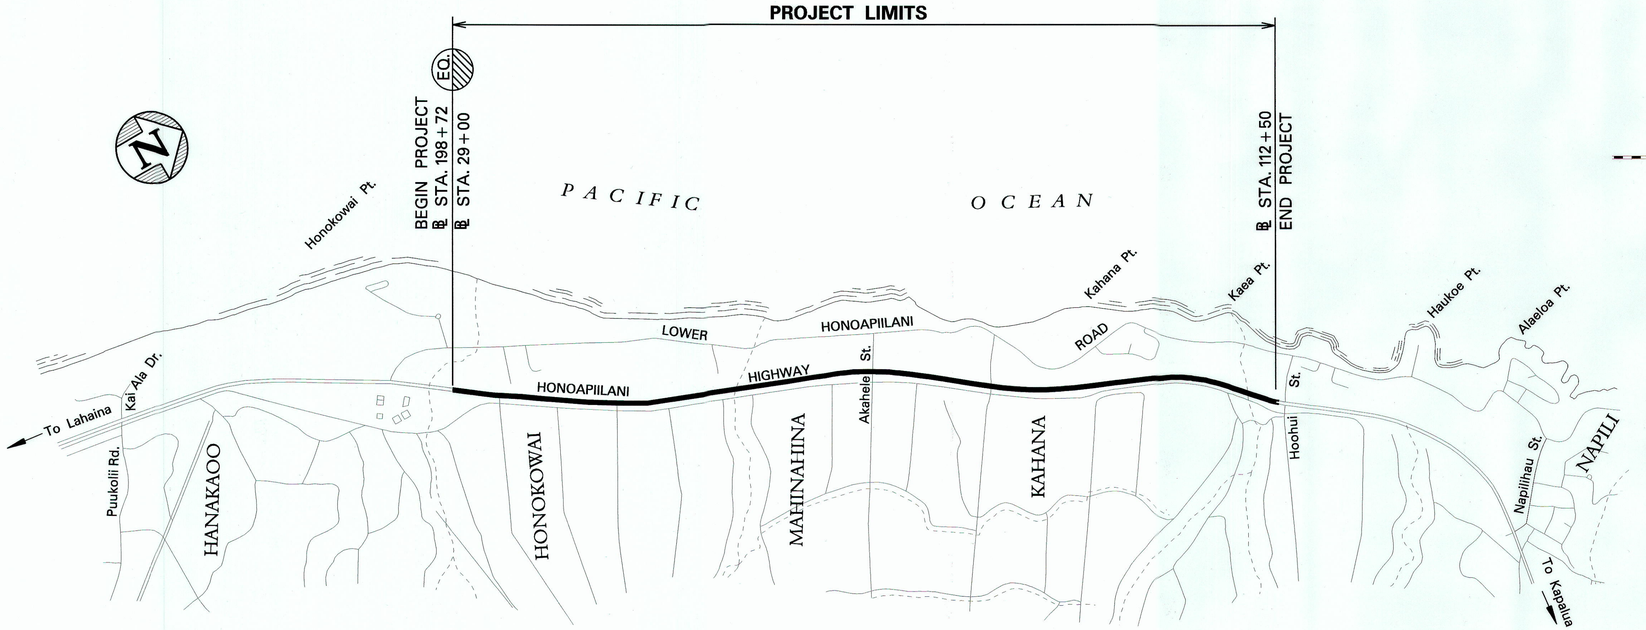

FEDERAL AID PROJECTS PREVIOUSLY CONSTRUCTED OR UNDER CONSTRUCTION

MILE POST 26.16 TO MILE POST 27.74

DESIGN DESIGNATION

ADT (2011)	20,800
ADT (2021)	23,700
DHV	2,010
DESIGN K	8.5
DESIGN D	55/45
DESIGN T	3.5
T_{24}	4.0

SCALE IN THOUSAND FEET

LAYOUT PLAN

GROSS LENGTH OF PROJECT..... 1.58 MILES

NET LENGTH OF PROJECT..... 1.58 MILES

CHANGES MADE DURING CONSTRUCTION HAVE BEEN INCORPORATED ON THESE PLANS EXCEPT CHANGES IN THE ORIGINAL THEORETICAL QUANTITIES. FOR ACTUAL QUANTITIES, REFER TO PROJECT LEDGER AND/OR COMPUTATION BOOK.

RESIDENT ENGINEER — DATE 10/9/15

DEPARTMENT OF TRANSPORTATION
STATE OF HAWAII

APPROVED: MAY 13 2011

DIR. OF TRANSPORTATION — DATE

HWY-M	HWY-ME	873-3535	DEC., 2010
DESIGNED BY	P. S. & E. BY	PHONE	DATE