FED. ROAD DIST. NO.	STATE	PROJ. NO.	FISCAL YEAR	SHEET NO.	TOTAL SHEETS
HAWAII	HAW.	30A-01-12M	2012	1	36

TITLE SHEET

STATE OF HAWAII

DEPARTMENT OF TRANSPORTATION

HIGHWAYS DIVISION

HONOLULU, HAWAII

"AS-BUILT"

PLANS FOR

KAHEKILI HIGHWAY RESURFACING

HONOKOHAU TO PAPANAHOA

PROJECT NO. 30A-01-12M

DISTRICTS OF LAHAINA AND WAILUKU

ISLAND OF MAUI

INDEX TO DRAWINGS

SHEET NO.	DESCRIPTION
1	TITLE SHEET
2	STANDARD PLANS SUMMARY
3	GENERAL NOTES AND LEGEND
4 – 5	WATER POLLUTION & EROSION CONTROL NOTES
6	TYPICAL SECTION AND DETAILS
7 – 9 (1)	DRAINAGE DETAILS
10 – 22	ROADWAY PLANS
23	PAVEMENT MARKING LEGEND, DETAILS & NOTES
24 – 36	SIGNING & PAVEMENT MARKING PLANS

Sheet No. (1) 9S-1 is a Supplementary Sheet to this Project. Total Sheet Count After "AS-BUILT" Posting 37 Sheets.

PROJECT LOCATION

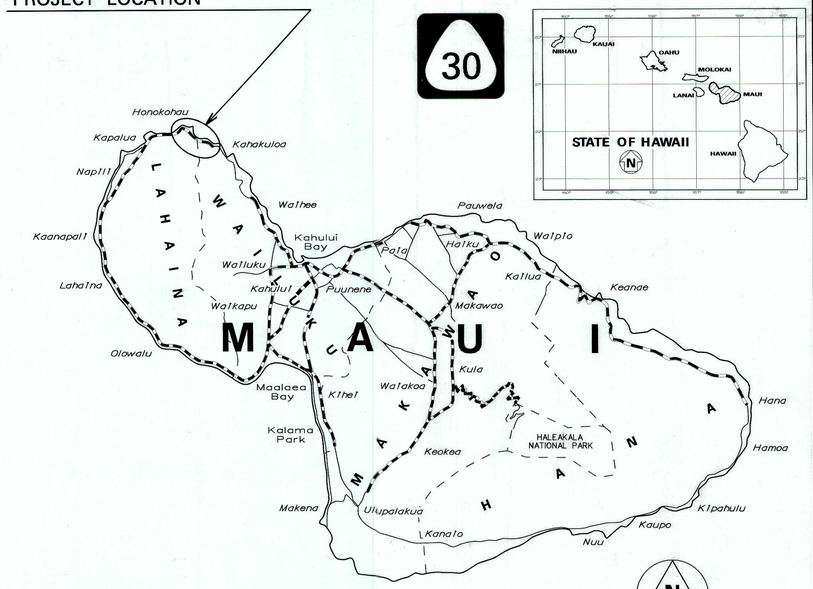

30

SCALE IN MILES

FEDERAL AID PROJECTS PREVIOUSLY CONSTRUCTED OR UNDER CONSTRUCTION

MILE POST 36.40 TO MILE POST 41.67

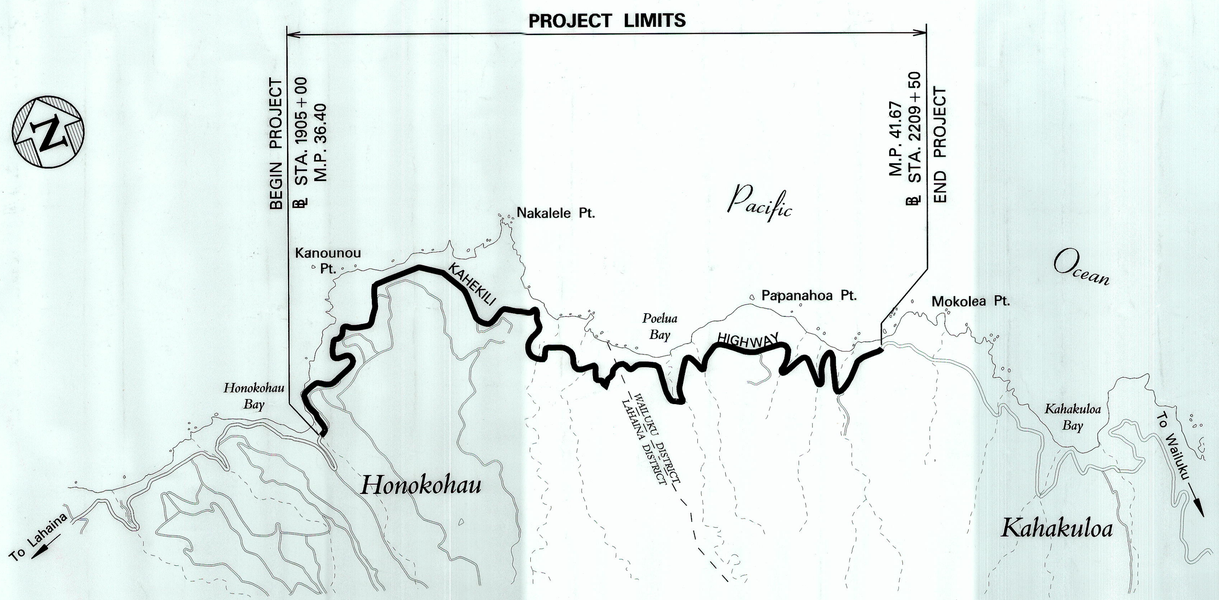

SCALE IN THOUSAND FEET

LAYOUT PLAN

GROSS LENGTH OF PROJECT..... 5.27± MILES

NET LENGTH OF PROJECT..... 5.27± MILES

CHANGES MADE DURING CONSTRUCTION HAVE BEEN INCORPORATED ON THESE PLANS EXCEPT CHANGES IN THE ORIGINAL THEORETICAL QUANTITIES. FOR ACTUAL QUANTITIES, REFER TO PROJECT LEDGER AND/OR COMPUTATION BOOK.

RESIDENT ENGINEER — DATE 10/9/13

DEPARTMENT OF TRANSPORTATION
STATE OF HAWAII

APPROVED:

for DIR. OF TRANSPORTATION — DATE 5/21/12

HYW-M DESIGNED BY | HWY-ME MANAGED BY | 873-3535 PHONE | MAY, 2012 DATE