FED. ROAD DIST. NO.	STATE	FED. AID PROJ. NO.	FISCAL YEAR	SHEET NO.	TOTAL SHEETS
HAWAII	HAW.	STP-030-1(22)	2000	3	4

NOTE:

1. All utilities, sidewalks, and curbings surrounding the demolition area are to remain. The Contractor shall repair any damages incurred to the existing facilities as a result of his work. This work shall be considered incidental to the various contract items and will not be paid for separately.
2. Upon completion of the demolition work, the area shall be kept at existing grade and gravel shall be placed on dirt areas to minimize dust.
3. The Contractor shall be responsible for the removal of the dust screen upon completion of the work. This work shall be considered incidental to the various contract items and will not be paid for separately.
4. The Contractor shall be responsible for field verifying all dimensions shown and not shown on the plans.
5. The Contractor shall only use Lahainaluna Road as access for heavy vehicles and equipment to the project site.
6. The Contractor shall be responsible for capping the existing sewer line within each lot after the removal of the existing structures. This work shall be considered incidental to the various contract items and will not be paid for separately.

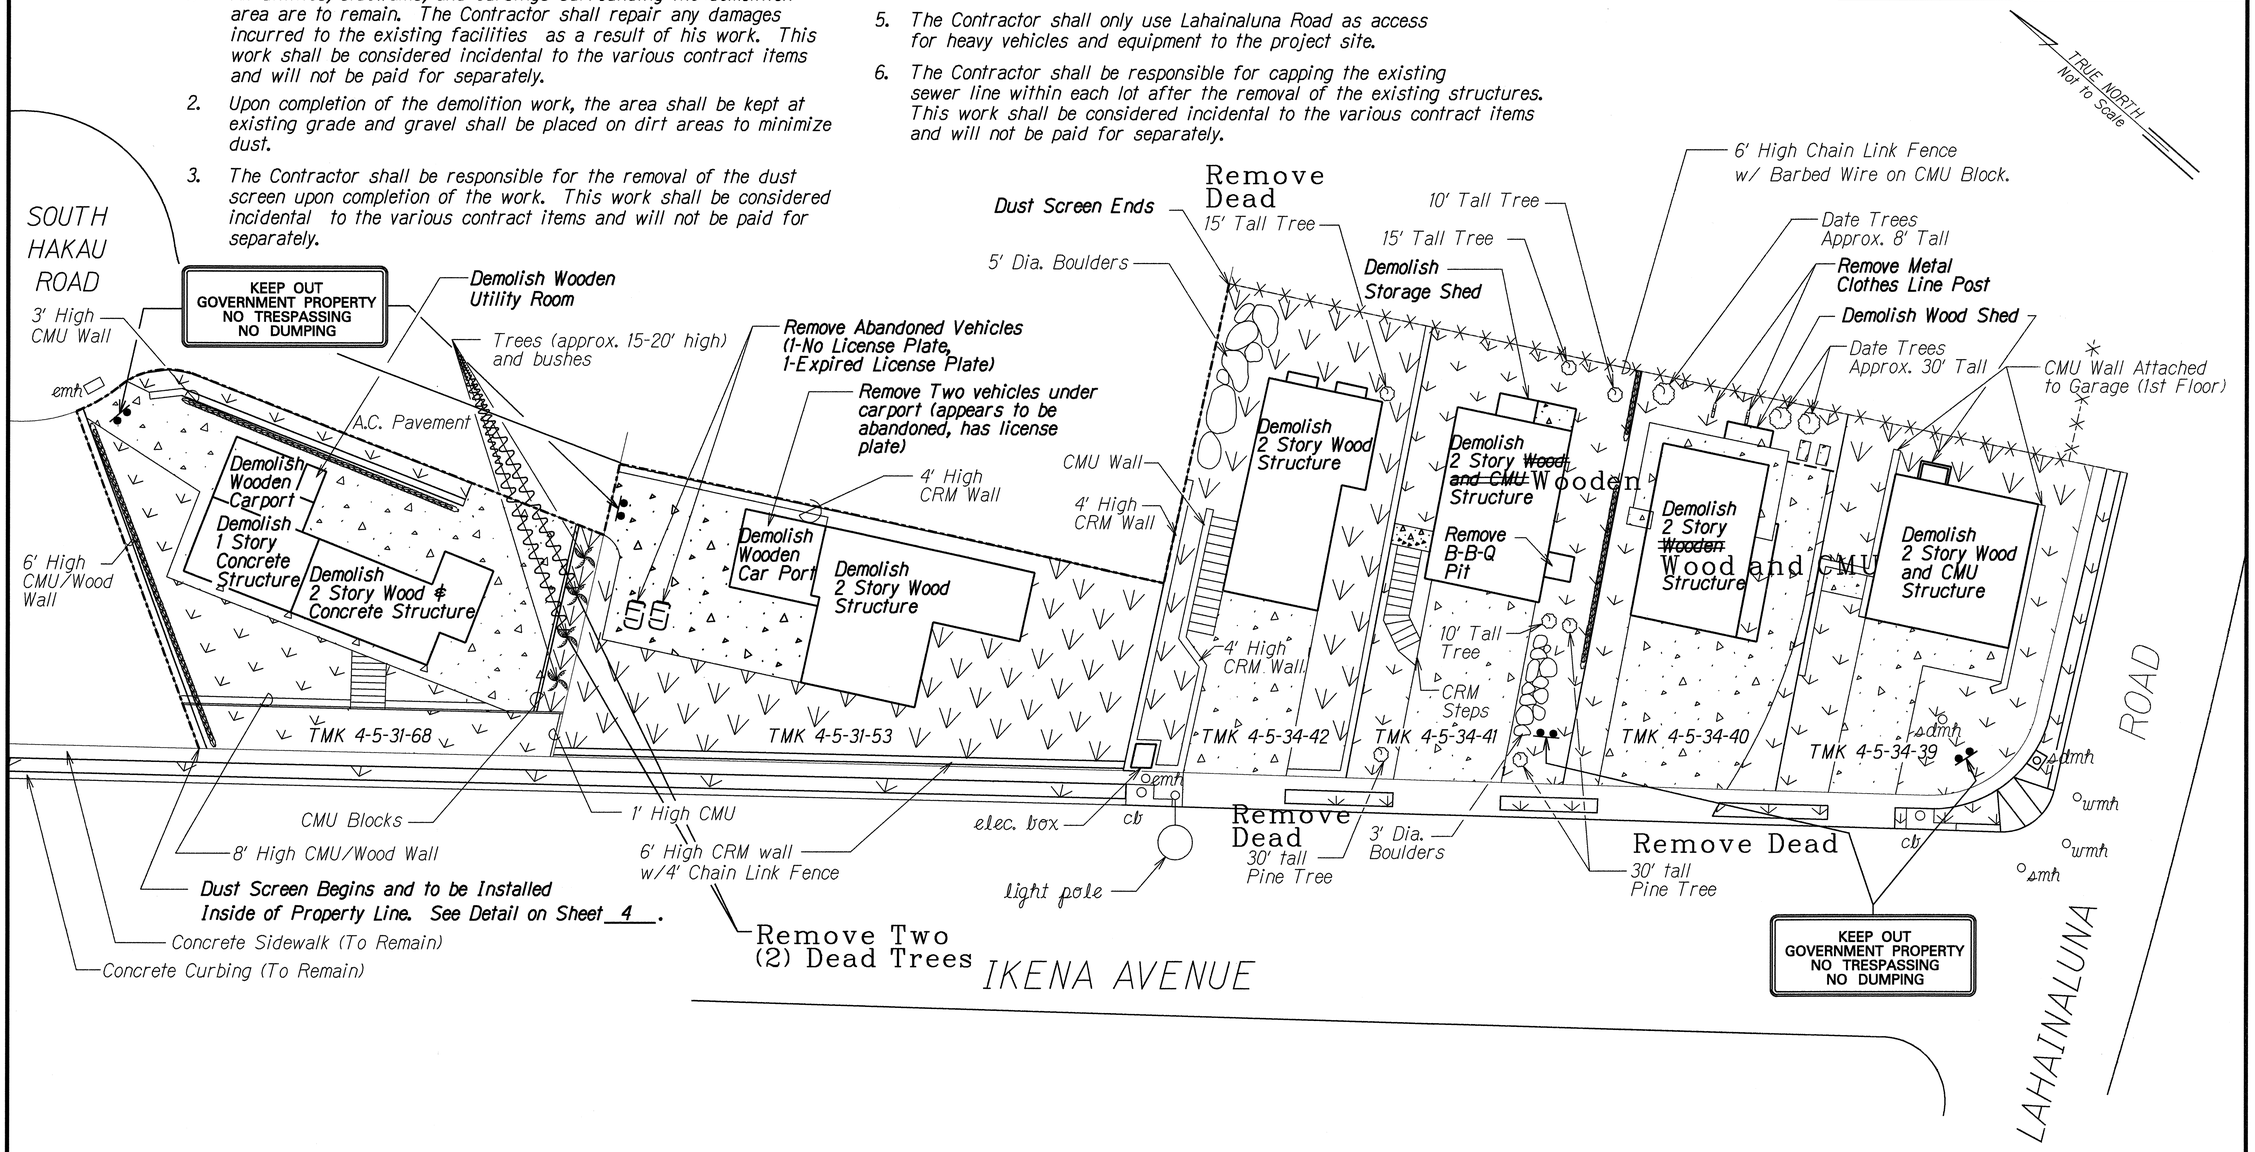

LEGEND FOR AS-BUILT POSTINGS	
~~^^^^~~	Squiggly line for as-built deletion
~~100.00~~	Double line for as-built deletion
Roadway	Text for as-built posting

STATE OF HAWAII
DEPARTMENT OF TRANSPORTATION
HIGHWAYS DIVISION

DEMOLITION PLAN

HONOAPIILANI HIGHWAY BYPASS
DEMOLITION OF IKENA AVENUE (PHASE I)
FEDERAL-AID PROJECT NO. STP-030-1(22)

Scale: Not to Scale Date: Aug., 1999

SHEET No. 1 OF 1 SHEETS

ORIGINAL PLAN
SURVEY PLOTTED BY
DRAWN BY
TRACED BY
DESIGNED BY
NOTE BOOK
QUANTITIES BY
CHECKED BY
DATE
No.