


FED. ROAD DIST. NO.	STATE	PROJ. NO.	FISCAL YEAR	SHEET NO.	TOTAL SHEETS
HAWAII	HAW.	31B-01-82	1981	2	12

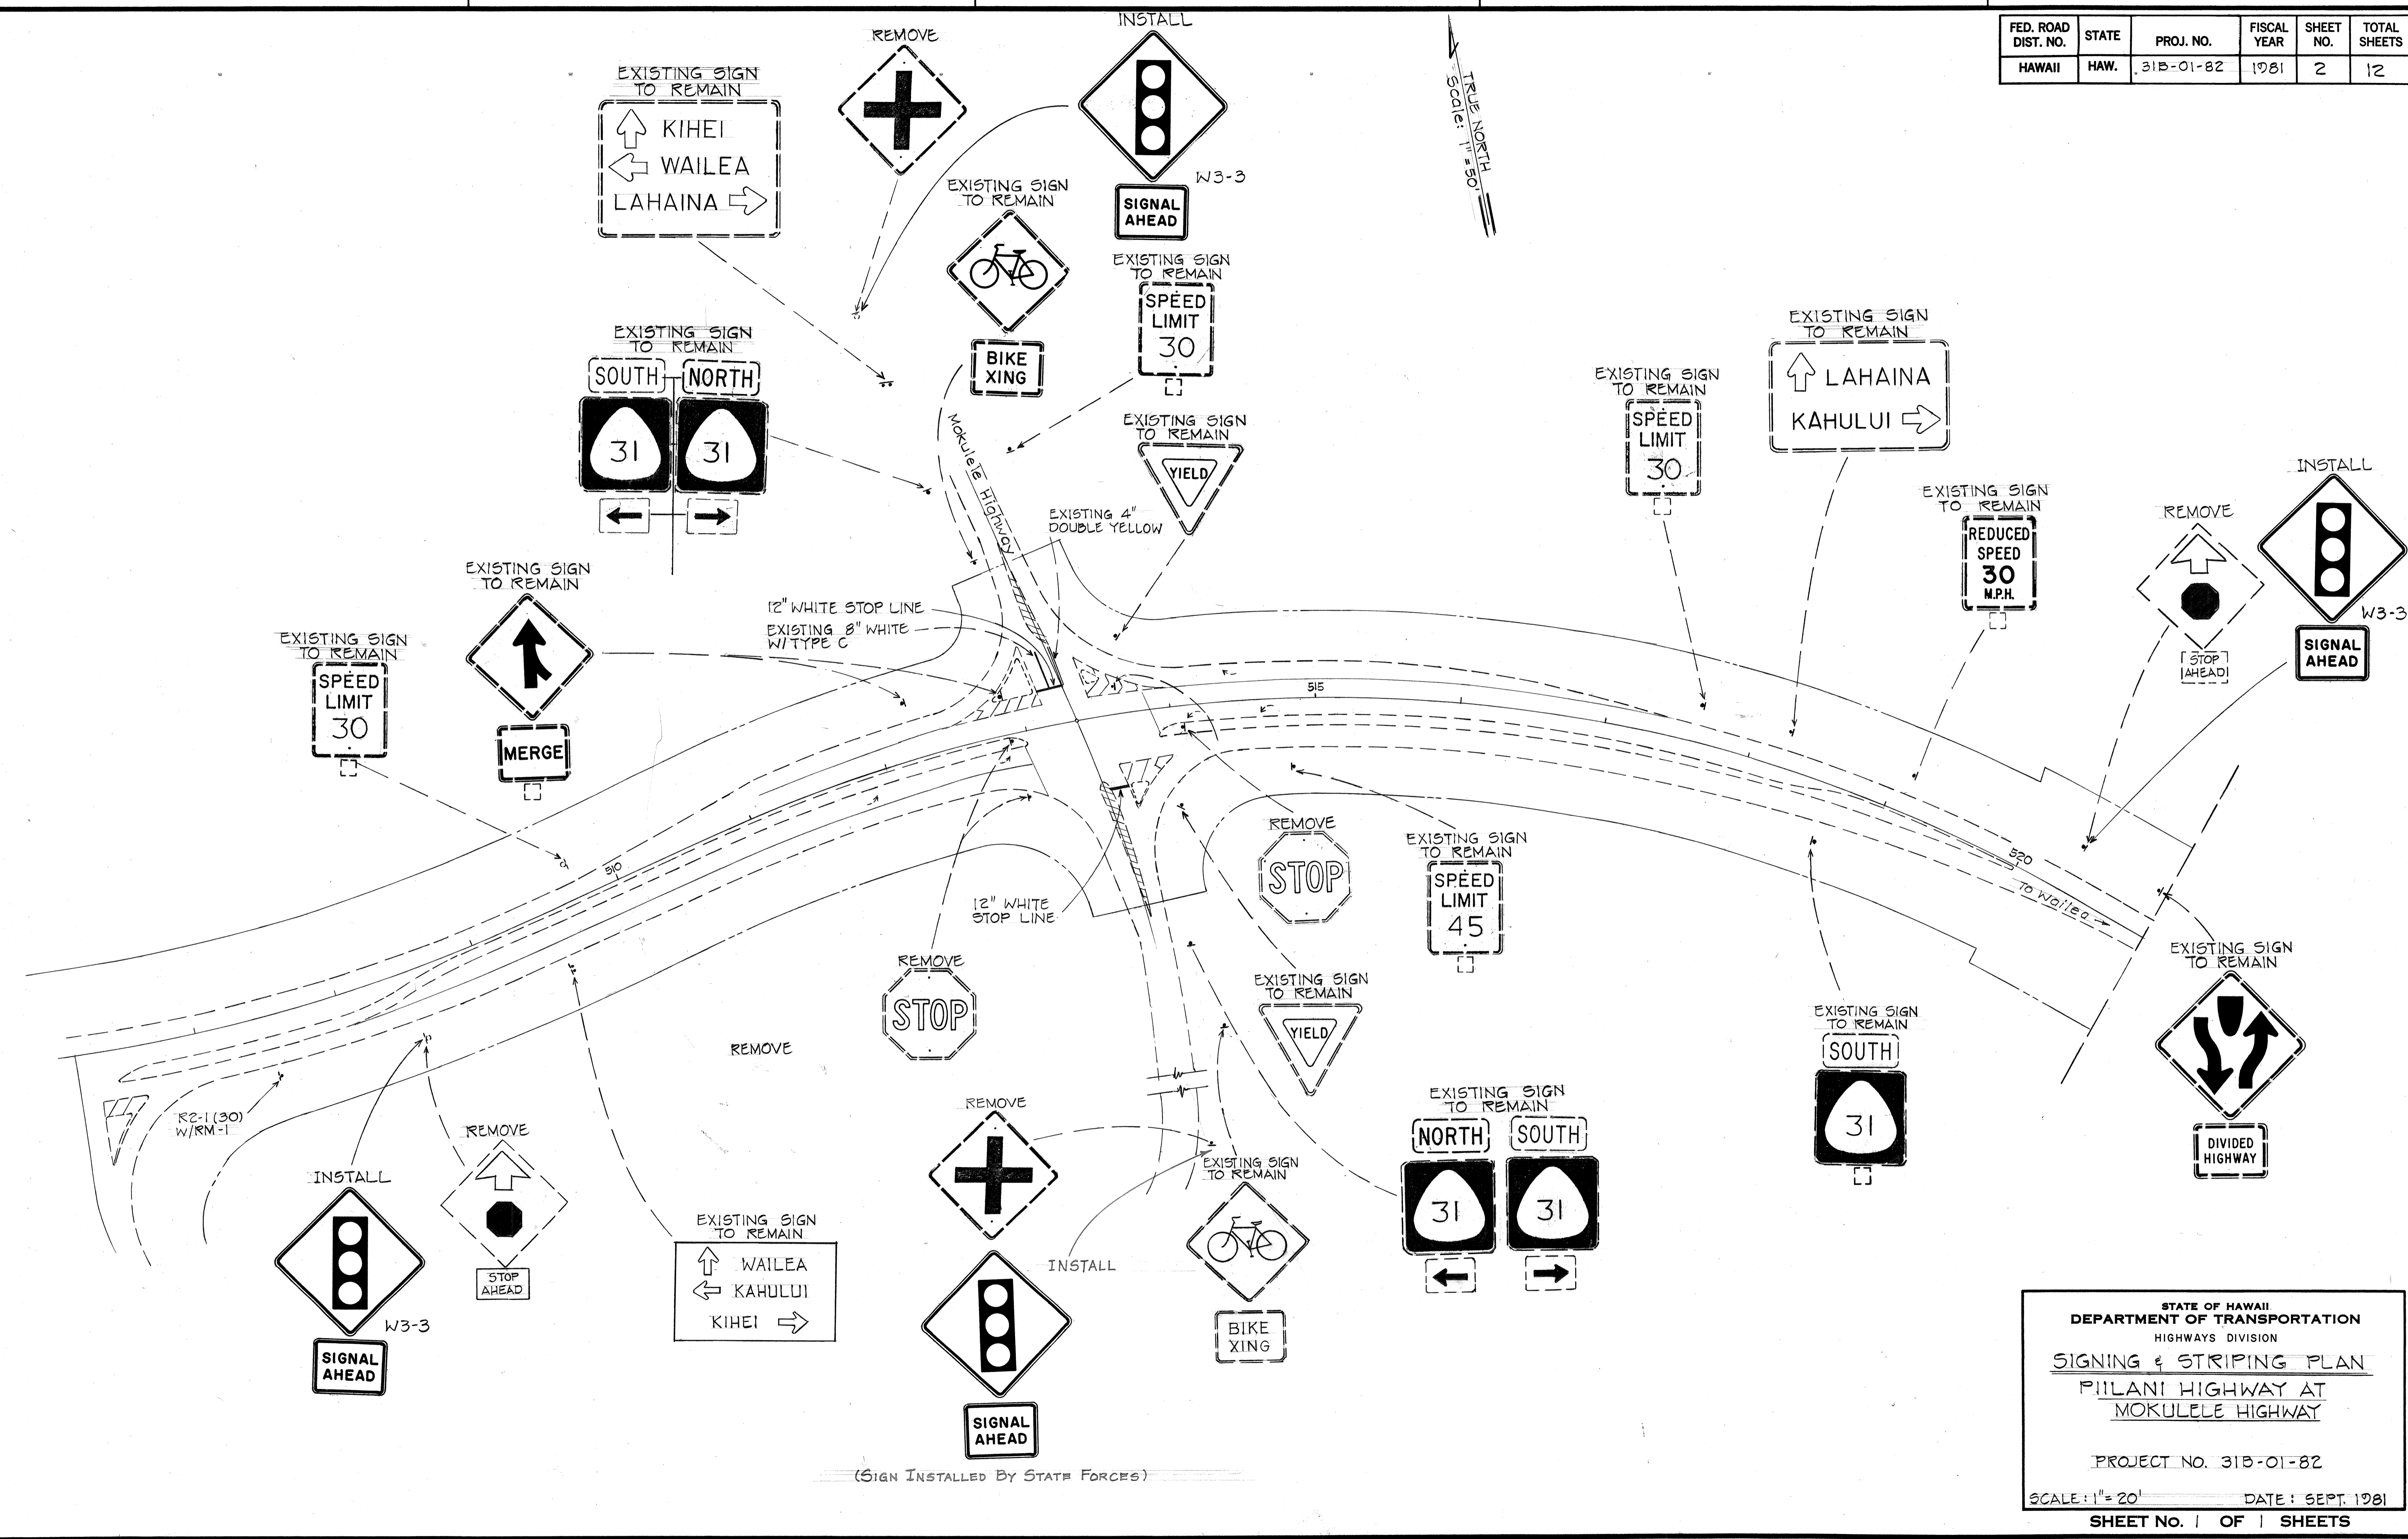

DATE
SURVEY PLOTTED BY
DRAWN BY
TRACED BY
DESIGNED BY
QUANTITIES BY
CHECKED BY
ORIGINAL PLAN	No.
NOTE BOOK	No.

(SIGN INSTALLED BY STATE FORCES)

STATE OF HAWAII
DEPARTMENT OF TRANSPORTATION
HIGHWAYS DIVISION
SIGNING & STRIPING PLAN
PIILANI HIGHWAY AT
MOKULELE HIGHWAY
PROJECT NO. 31B-01-82
SCALE: 1"=20' DATE: SEPT. 1981
SHEET No. 1 OF 1 SHEETS