FED. ROAD DIST. NO.	STATE	PROJ. NO.	FISCAL YEAR	SHEET NO.	TOTAL SHEETS
HAWAII	HAW.	32A-01-82	1982	1	20

INDEX TO DRAWINGS

SHEET NO.	DESCRIPTION
1	TITLE SHEET
2	DETAILS AND NOTES
3	TRAFFIC CONTROL PLAN
4-5	TRAFFIC SIGNAL PLANS
6-7	TYPICAL DETAILS OF WHEELCHAIR RAMPS
8-20	STANDARD DETAILS

STATE OF HAWAII

DEPARTMENT OF TRANSPORTATION

HIGHWAYS DIVISION

HONOLULU, HAWAII

"AS-BUILT"
PLANS FOR

MAIN STREET, TRAFFIC SIGNALS AT CENTRAL AVENUE AND AT MARKET STREET

PROJECT NO. 32A-01-82

DISTRICT OF WAILUKU
ISLAND OF MAUI

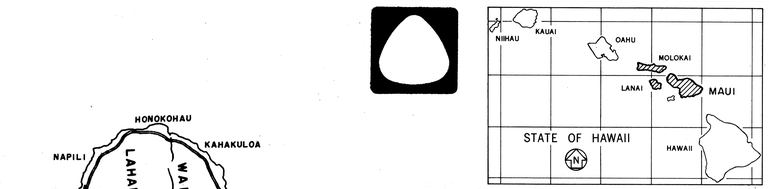

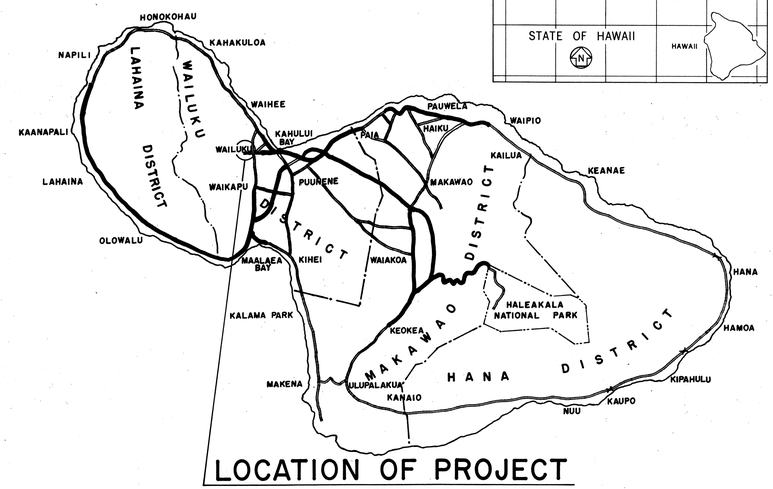

LOCATION OF PROJECT

N

5 0 5 10
SCALE IN MILES

FEDERAL AID PROJECTS PREVIOUSLY CONSTRUCTED OR UNDER CONSTRUCTION

ALL CHANGES MADE DURING CONSTRUCTION HAVE BEEN INCORPORATED ON THESE PLANS IN RED EXCEPT CHANGES IN THE ORIGINAL THEORETICAL QUANTITIES. FOR ACTUAL QUANTITIES, REFER TO PROJECT LEDGER AND/OR COMPUTATION BOOK.

Cary Yamashita — 5-27-83
RESIDENT ENGINEER — DATE

DEPARTMENT OF TRANSPORTATION
STATE OF HAWAII
APPROVED:
James K. Carras 2/17/82
DIR. OF TRANSPORTATION — DATE

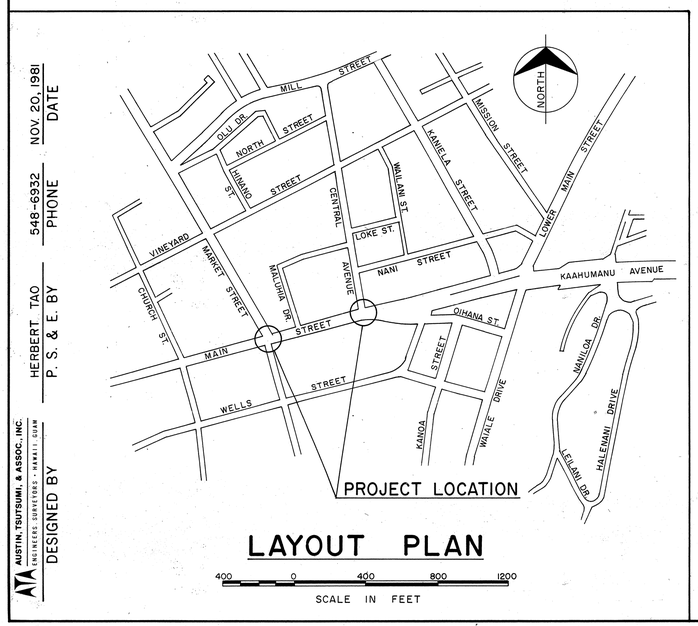

LAYOUT PLAN

400 0 400 800 1200
SCALE IN FEET

AUSTIN, TSUTSUMI, & ASSOC., INC.
ENGINEERS · SURVEYORS · HAWAII · GUAM

DESIGNED BY — HERBERT TAO — P. S. & E. BY
548-6932 — PHONE
NOV. 20, 1981 — DATE

DD-A-3-3