FED. ROAD DIST. NO.	STATE	PROJ. NO.	FISCAL YEAR	SHEET NO.	TOTAL SHEETS
HAWAII	HAW.	32A-01-12	2012	ADD.9	9

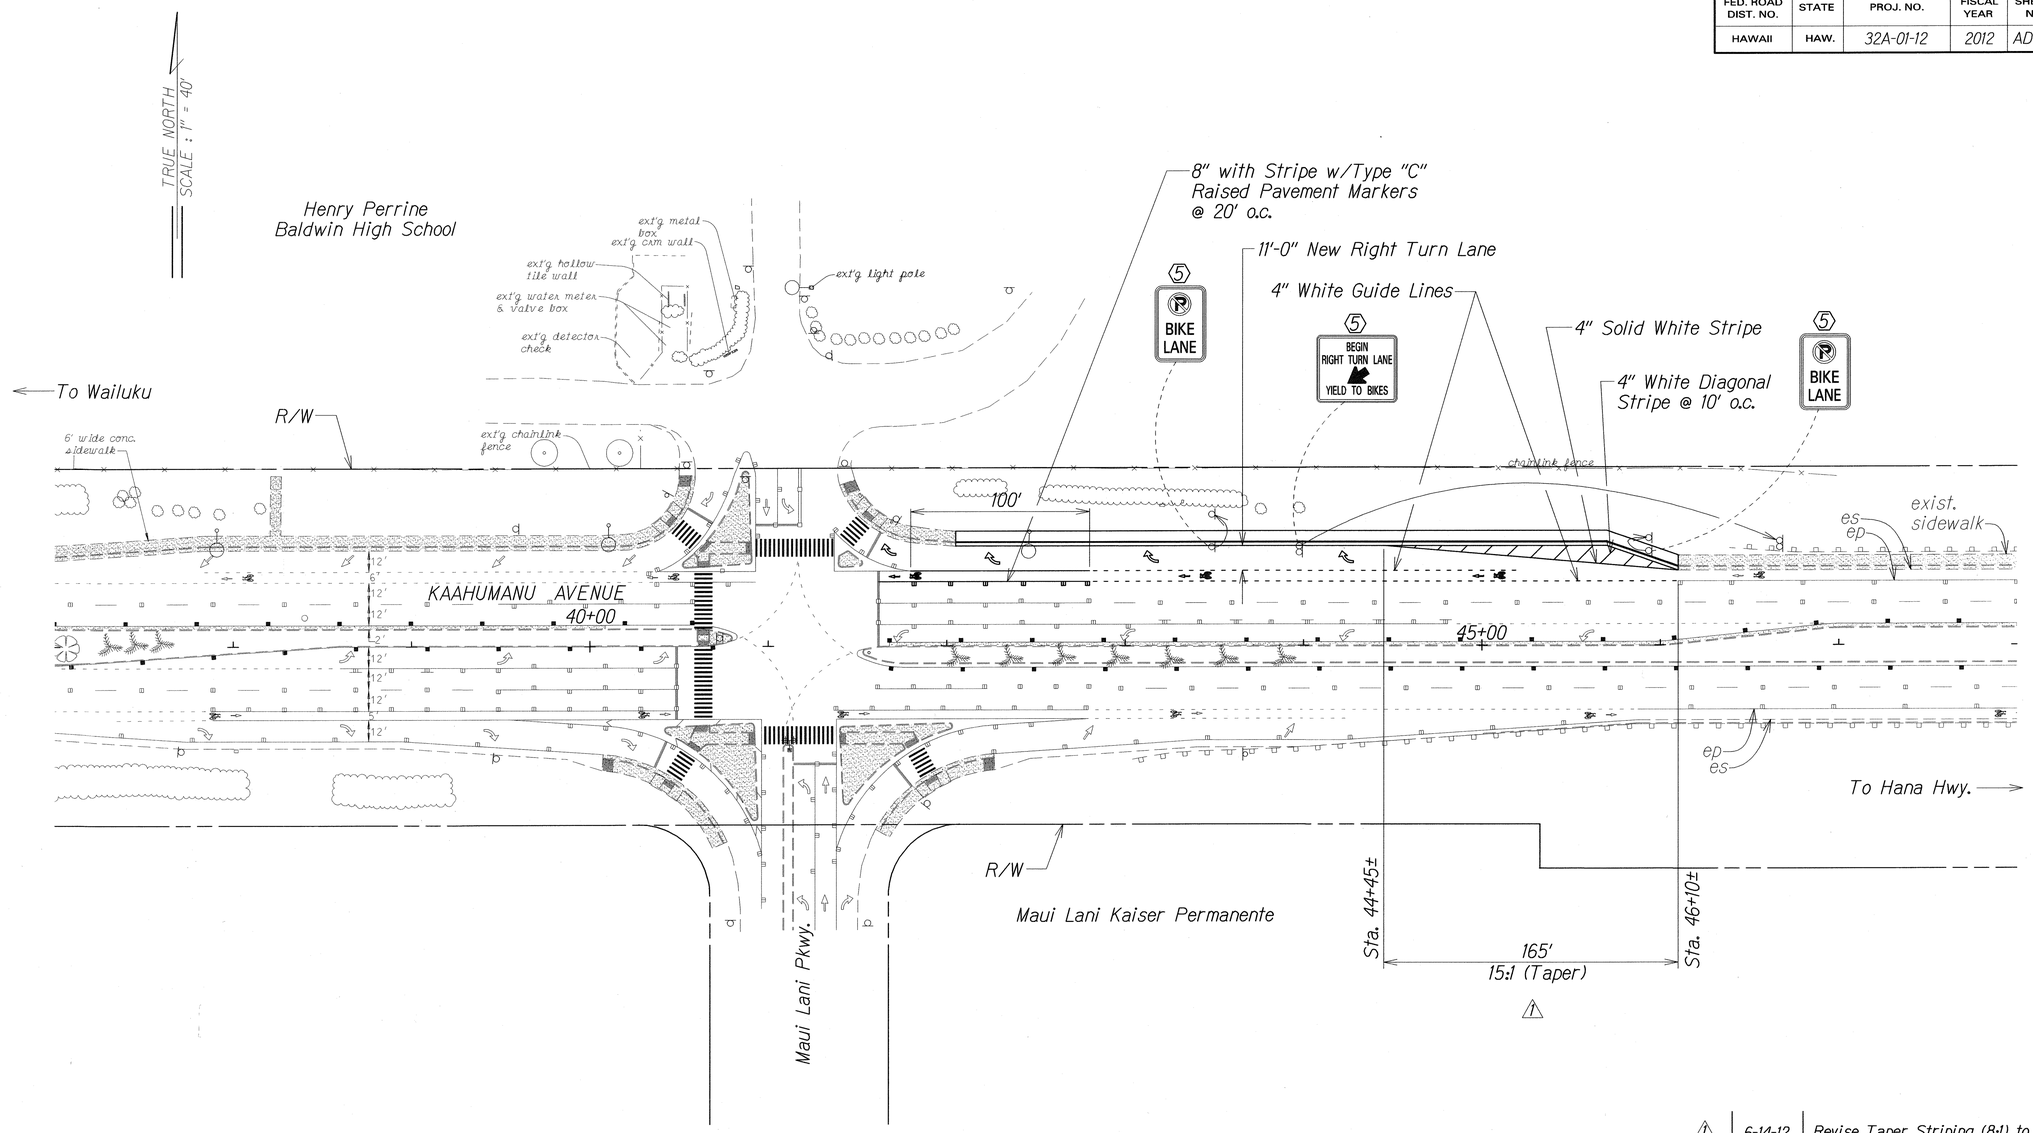

1	6-14-12	Revise Taper Striping (8:1) to (15:1).
1	6-14-12	Delete Key Nos. 1 to 4.
	DATE	REVISION

1 KEY:

5 Relocate Existing Sign(s)

STATE OF HAWAII
DEPARTMENT OF TRANSPORTATION
HIGHWAYS DIVISION

SIGNING & PAVEMENT MARKING PLAN

KAAHUMANU AVENUE IMPROVEMENTS
RIGHT TURN LANE INTO
BALDWIN HIGH SCHOOL
Project No. 32A-01-12

Scale: 1" =40' Date: May, 2012

SHEET No. 1 OF 1 SHEETS

ADD.9

ORIGINAL PLAN	SURVEY PLOTTED BY	DATE
	DRAWN BY X	
NOTE BOOK	TRACED BY	
	DESIGNED BY X	
No. dd.x Xdgn	QUANTITIES BY	
	CHECKED BY	