INDEX TO DRAWINGS	
SHEET NO.	DESCRIPTION
1	Title Sheet
2	Typical Sections
3-11	Plan and Profile
11-A	Plan Showing Exception
12-13	Standard Details
14-27	Cross Sections

All changes made during construction have been shown in red on these tracings and checked by -
J. K. Kauwailana
Resident Engineer
Date: 4/16/49

TERRITORY OF HAWAII
TERRITORIAL HIGHWAY DEPARTMENT
HONOLULU, T. H.

FED. ROAD DIST. NO.	STATE	FED. AID PROJ. NO.	FISCAL YEAR	SHEET NO.	TOTAL SHEETS
HAWAII	HAW.	F 32 (2)	1946	1	27

PLANS OF

HANA BELT ROAD
FEDERAL AID PROJECT NO. F. 32 (2)

MAKAWAO DISTRICT
ISLAND OF MAUI

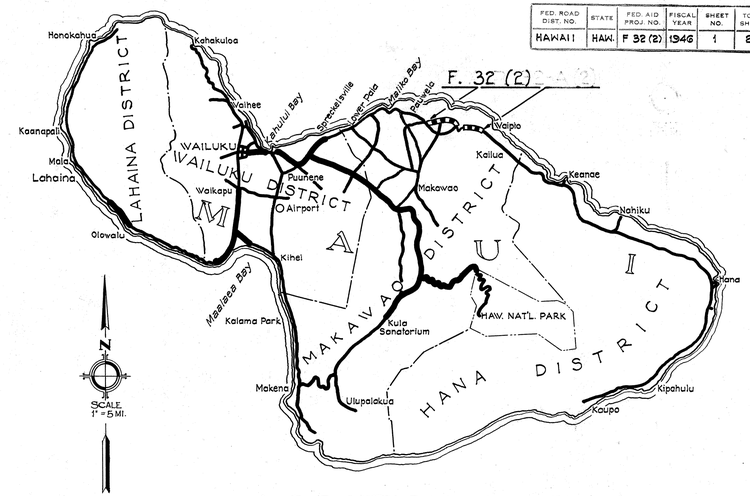

LOCATION MAP

Federal Aid Projects previously constructed or under construction.

CONVENTIONAL SIGNS

- Center Line
- Conc. Pipe Culvert
- Bridge
- Fence
- Existing Old Road
- Conc. Box Culvert

SCALE

PLAN	1 IN. = 100 FT.
PROFILE	HOR. 1 IN. = 100 FT.
	VER. 1 IN. = 10 FT
CROSS SECTION	HOR. 1 IN. = 10 FT.
	VER. 1 IN. = 10 FT.

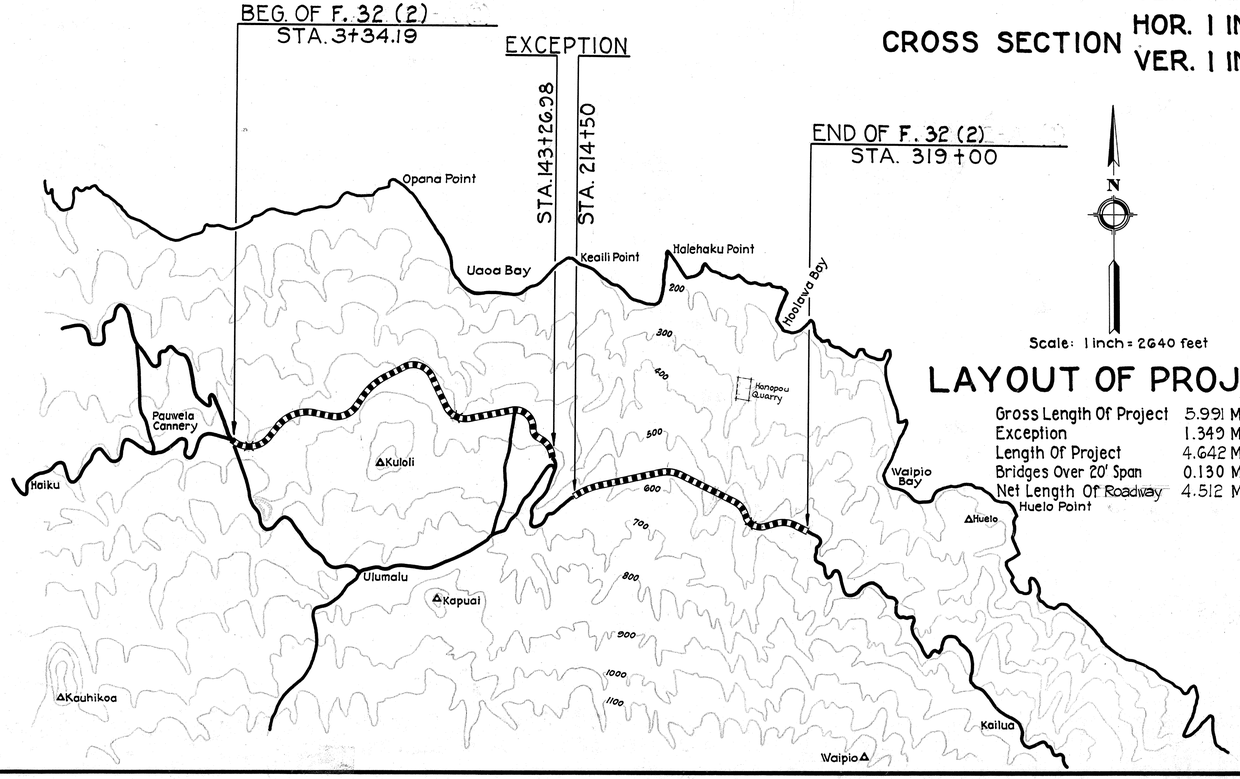

LAYOUT OF PROJECT

Gross Length Of Project	5.991 Mi.
Exception	1.349 Mi.
Length Of Project	4.642 Mi.
Bridges Over 20' Span	0.130 Mi.
Net Length Of Roadway	4.512 Mi.

APPROVED: DATE 7-3-46
B. F. Rush
TERRITORIAL HIGHWAY ENGINEER

RECOMMENDED FOR APPROVAL: DATE
DISTRICT ENGINEER
PUBLIC ROADS ADMINISTRATION
FEDERAL WORKS AGENCY

APPROVED: DATE
DIVISION ENGINEER
PUBLIC ROADS ADMINISTRATION
FEDERAL WORKS AGENCY

ORIGINAL	REVISIONS	DATE