FED. ROAD DIST. NO.	STATE	PROJ. AND PROJ. NO.	FISCAL YEAR	SHEET NO.	TOTAL SHEETS
HAWAII	HAW.	A-36-01-66	1966	3	3

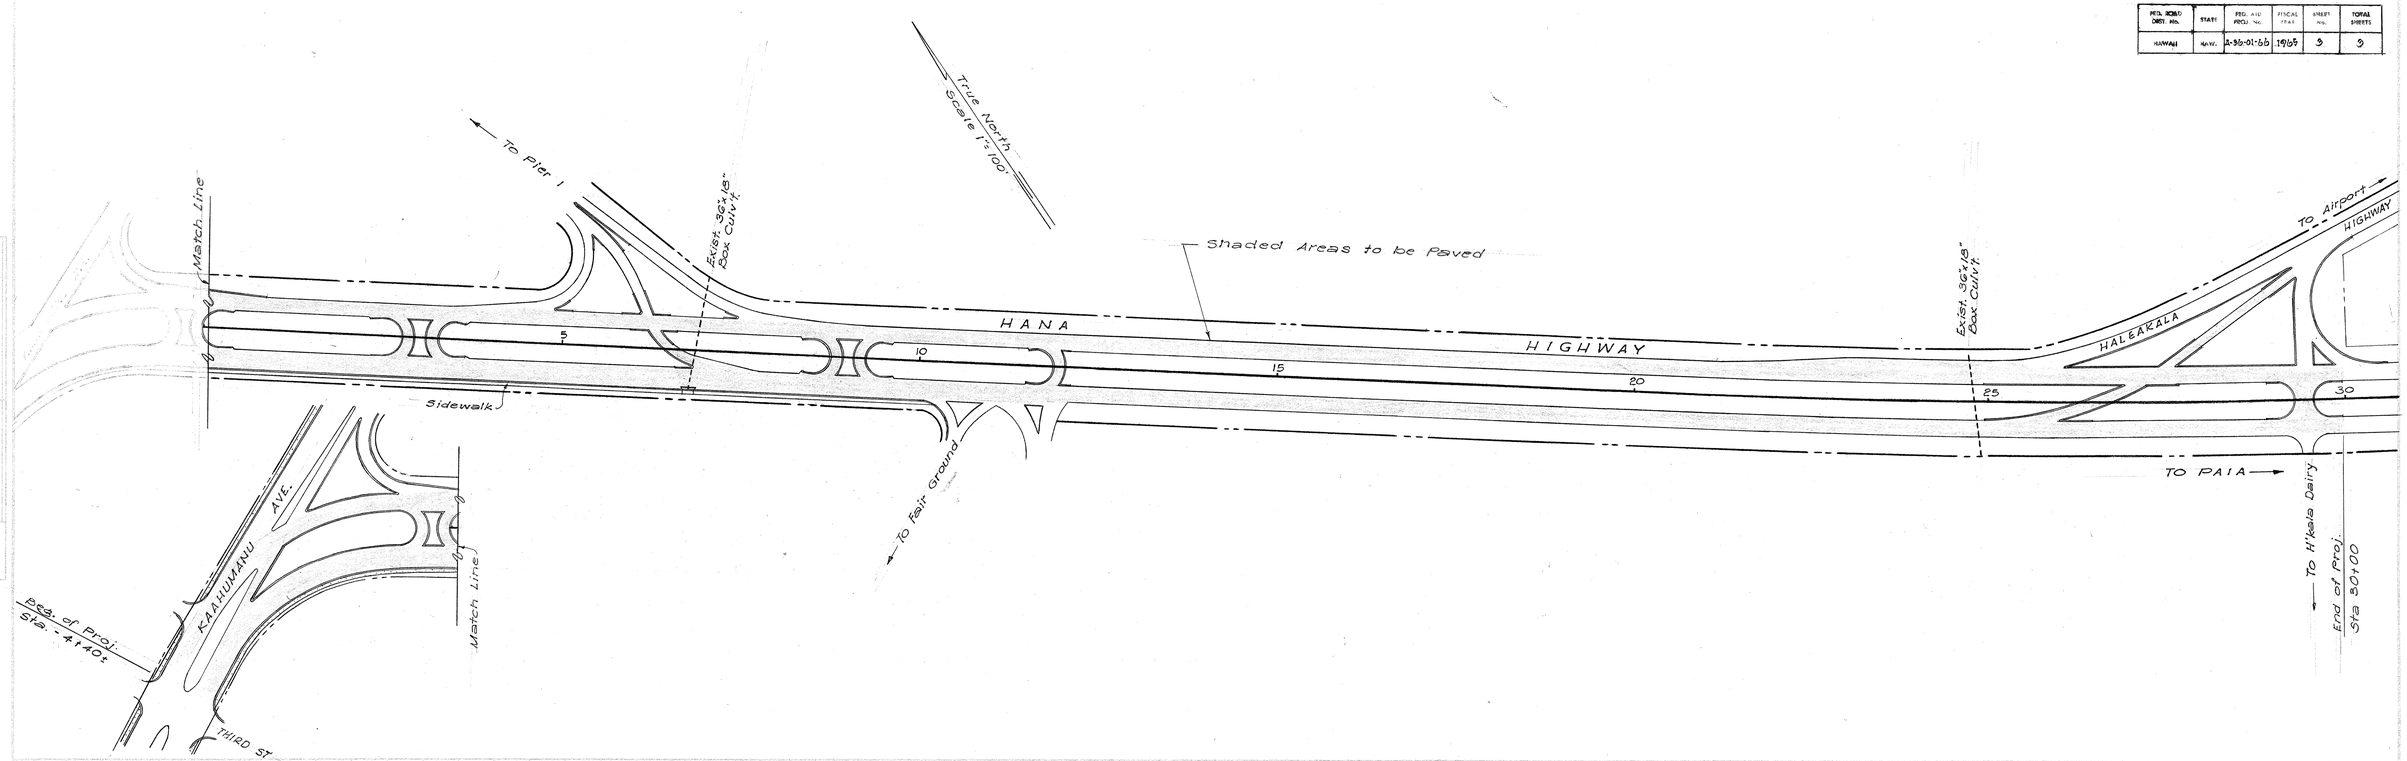

PROFILE
SUBMITTED
PLOTTED
DRAWN
NOTE SUPV.
CHECKED
NOTE BOOK
ALIGNMENT CHECKED
PT OF PVI. CHECKED
NO.
SCALE: INTERPOLATION OFFICE

DATE	BY	REVISIONS

F.A.H.
PLAN
PROFILE
NOTE BOOK
NO.

PLATE 1 - PLAN - PROFILE - F.A.S.
CLEARPRINT PAPER CO., S.F. CAL.
NO. 1022H-1

3