INDEX TO DRAWINGS	
SHEET NO	DESCRIPTION
1	TITLE SHEET – TYPICAL SECTION – PLAN
2	CROSS SECTION

FED. ROAD DIST. NO.	STATE	PROJ. NO.	FISCAL YEAR	SHEET NO.	TOTAL SHEETS
HAWAII	HAW.	36C-01-69	1968	1	2

PROJECT Nº 36C-01-69

STATE OF HAWAII
DEPARTMENT OF TRANSPORTATION
HIGHWAYS DIVISION
HONOLULU, HAWAII

AS-BUILT PLANS FOR
INTERSECTION IMPROVEMENTS
HANA HIGHWAY AT HASEROT ROAD
PROJECT Nº 36C-01-69

DISTRICT OF MAKAWAO
ISLAND OF MAUI

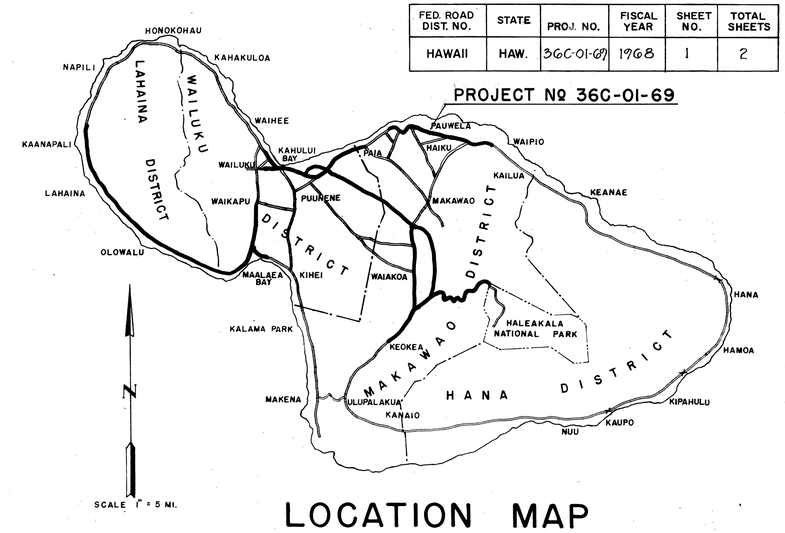

LOCATION MAP

FEDERAL AID PROJECTS PREVIOUSLY CONSTRUCTED OR UNDER CONSTRUCTION

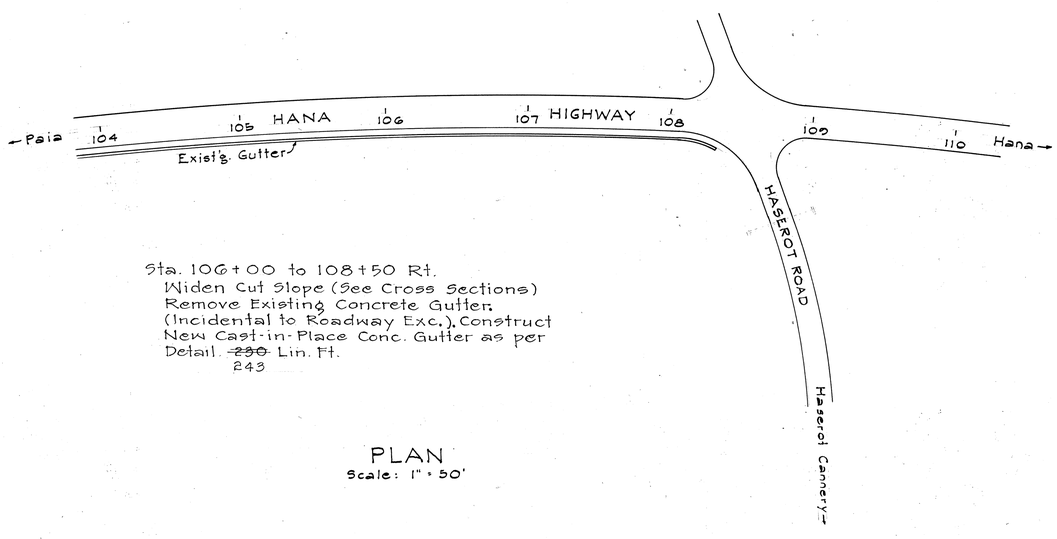

Sta. 106+00 to 108+50 Rt.
Widen Cut Slope (See Cross Sections)
Remove Existing Concrete Gutter.
(Incidental to Roadway Exc.). Construct
New Cast-in-Place Conc. Gutter as per
Detail. ~~230~~ 243 Lin. Ft.

PLAN
Scale: 1" = 50'

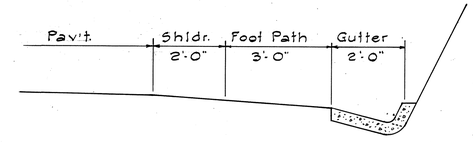

Construct Furrow Ditch at Top of Cut Slopes.
Payment Incidental to Roadway Exc.

EXIST'G. SECTION
Scale: ½" = 1'-0"

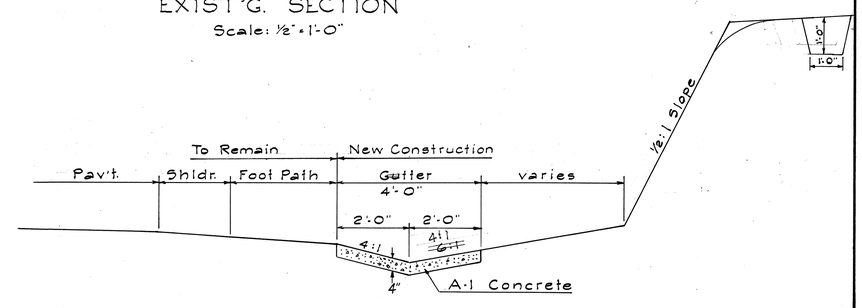

NEW SECTION
Scale: ½" = 1'-0"

NOTE:

ALL CHANGES MADE DURING CONSTRUCTION HAVE BEEN NOTED IN RED ON THESE TRACINGS AND CHECKED BY:

Sugio Ohashi
PROJECT ENGINEER

7-7-'71
DATE

DEPARTMENT OF TRANSPORTATION
STATE OF HAWAII

APPROVED:

for C. Olney Wright 12/27/68
DIRECTOR OF TRANSPORTATION DATE

R. TERADA NOV. 1968

C-4-7