INDEX TO DRAWINGS	
SHEET NO.	DESCRIPTION
1	TITLE SHEET
2	PLAN AND PROFILE

FED. ROAD DIST. NO.	STATE	PROJ. NO.	FISCAL YEAR	SHEET NO.	TOTAL SHEETS
HAWAII	HAW.	36B-01-70	1969	1	2

STATE OF HAWAII
DEPARTMENT OF TRANSPORTATION
HIGHWAYS DIVISION
HONOLULU, HAWAII

AS BUILT

PLANS OF

IMPROVING A PORTION OF HANA HIGHWAY

EAST OF HOOKIPA PARK

PROJECT NO. 36B-01-70

DISTRICT OF MAKAWAO
ISLAND OF MAUI

SCALES

PLAN		1 IN. =	100 FT.
PROFILE	HOR.	1 IN. =	10 & 20 FT.
	VER.	1 IN. =	1 FT.

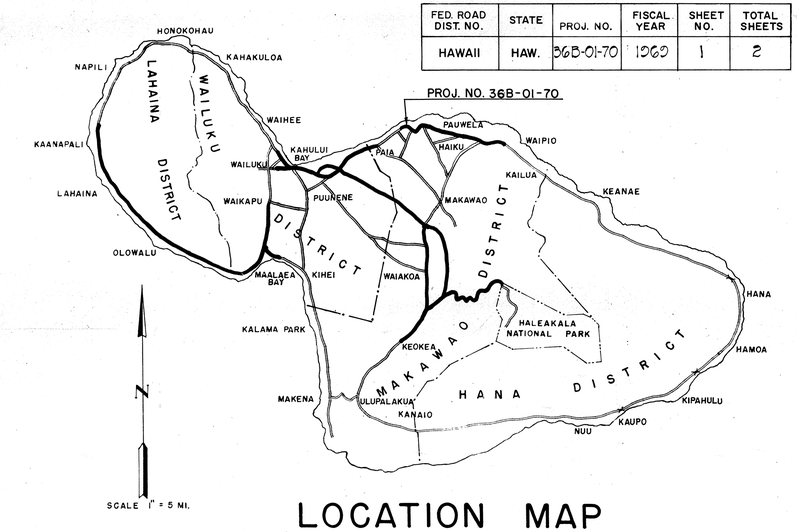

LOCATION MAP

FEDERAL AID PROJECTS PREVIOUSLY CONSTRUCTED OR UNDER CONSTRUCTION

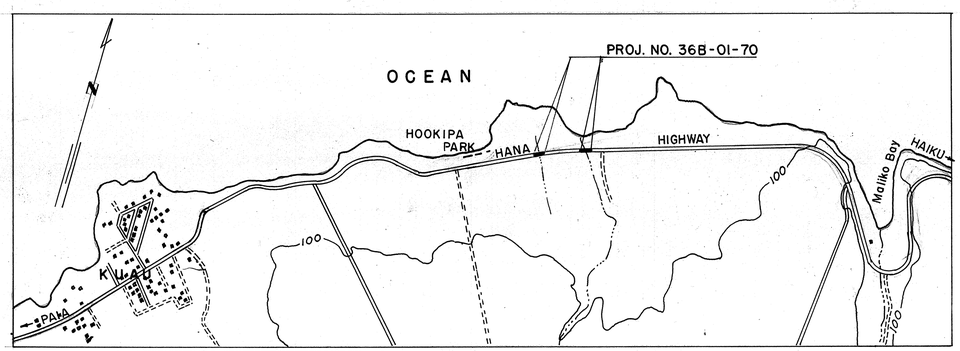

LAYOUT OF PROJECT
SCALE: 1" = 1000'

NOTE:
ALL CHANGES MADE DURING CONSTRUCTION HAVE BEEN NOTED IN RED ON THESE TRACINGS AND CHECKED BY Stanley S. Hirakio
RESIDENT ENGINEER
August 13, 1970
DATE

APPROVED: DATE 10/1/69
E. Alvey Wright
for DIRECTOR OF TRANSPORTATION

Maui District Office — Designed By
S. F. Yuen — P. S. & E. By
548-2211 - 301 — Phone - Local
Sept. 1969 — Date