FED. ROAD DIST. NO.	STATE	PROJ. NO.	FISCAL YEAR	SHEET NO.	TOTAL SHEETS
HAWAII	HAW.	378A-01-82M 36BC-01-82M	1982	1	11

INDEX TO DRAWINGS

SHEET NO.	DESCRIPTION
1	Title Sheet
2	Typical Sections & Gen. Notes
3 - 9	Plan Sheets
10	Summary of Pavement Marking & Striping
11	Standard Detail

STATE OF HAWAII

DEPARTMENT OF TRANSPORTATION
HIGHWAYS DIVISION
HONOLULU, HAWAII

"AS-BUILT"
PLANS FOR

HALEAKALA CRATER ROAD RESURFACING

KEKAULIKE HIGHWAY TOWARD CRATER

PROJECT NO. 378A-01-82M

AND

HANA HIGHWAY RESURFACING

HOLOMUA ROAD TOWARD HAIKU ROAD

PROJECT NO. 36BC-01-82M

DISTRICT OF MAKAWAO
ISLAND OF MAUI

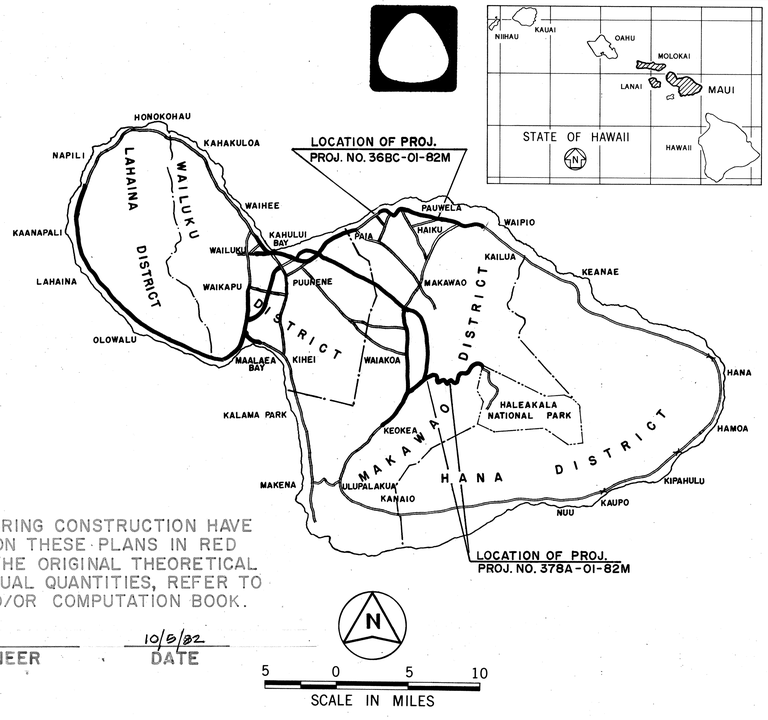

ALL CHANGES MADE DURING CONSTRUCTION HAVE BEEN INCORPORATED ON THESE PLANS IN RED EXCEPT CHANGES IN THE ORIGINAL THEORETICAL QUANTITIES. FOR ACTUAL QUANTITIES, REFER TO PROJECT LEDGER AND/OR COMPUTATION BOOK.

Glenn S. Sato — RESIDENT ENGINEER
10/8/82 — DATE

FEDERAL AID PROJECTS PREVIOUSLY CONSTRUCTED OR UNDER CONSTRUCTION

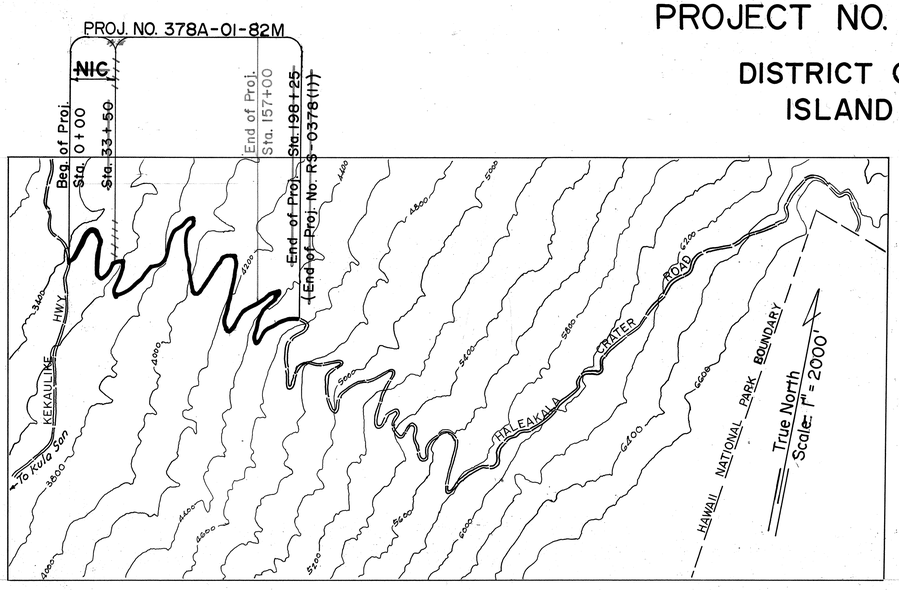

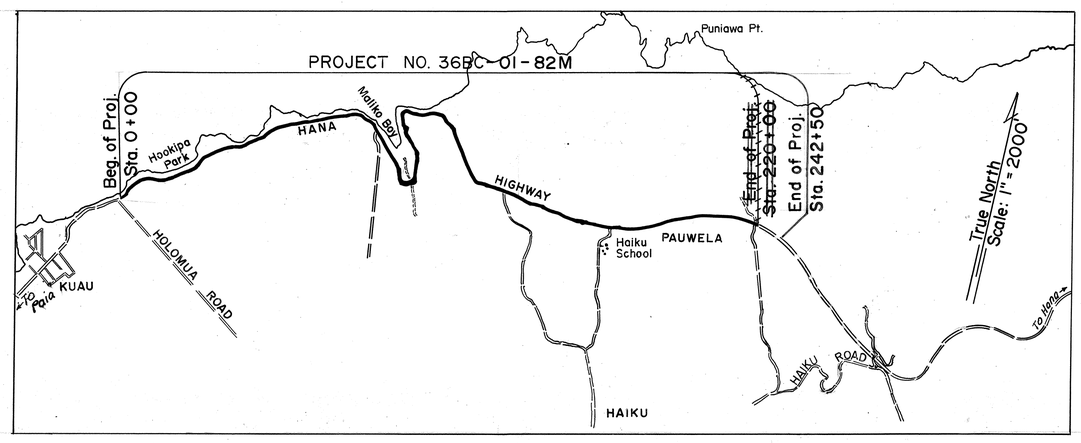

LAYOUT OF PROJECTS

LENGTH OF PROJECT = ~~3.12~~ 2.97 Miles

LENGTH OF PROJECT = ~~4.17~~ 4.59 Miles

HWY-M
DESIGNED BY

A. Nishimura
P. S. & E. BY

548-7490
PHONE

Dec., 1981
DATE

DEPARTMENT OF TRANSPORTATION
STATE OF HAWAII

APPROVED:
James R. Carras 1/7/82
DIR. OF TRANSPORTATION — DATE