FED. ROAD DIST. NO.	STATE	PROJ. NO.	FISCAL YEAR	SHEET NO.	TOTAL SHEETS
HAWAII	HAW.	36A-01-82	1982	1	23

INDEX TO DRAWINGS

SHEET NO.	DESCRIPTION
1	TITLE SHEET
2	LEGEND, NOTES AND TYP. PAV'T. SECTIONS
3	TRAFFIC CONTROL PLAN
4-5	GEOMETRICS AND STRIPING PLAN
6	TRAFFIC SIGNAL PLAN
7-23	STANDARD DETAILS

STATE OF HAWAII

DEPARTMENT OF TRANSPORTATION

HIGHWAYS DIVISION

HONOLULU, HAWAII

"AS - BUILT"

PLANS FOR

HANA HIGHWAY

TRAFFIC SIGNALS AT HALEAKALA HIGHWAY

PROJECT NO. 36A-01-82

DISTRICT OF WAILUKU

ISLAND OF MAUI

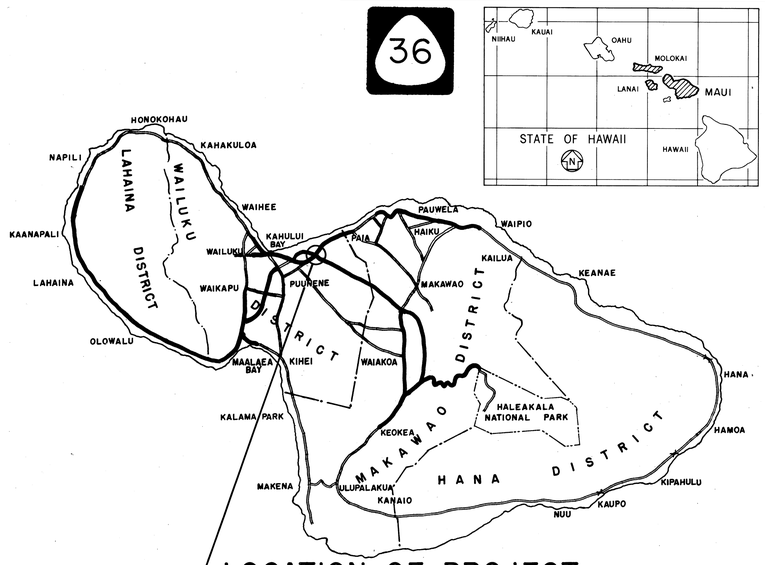

LOCATION OF PROJECT

N

5 0 5 10

SCALE IN MILES

FEDERAL AID PROJECTS PREVIOUSLY CONSTRUCTED OR UNDER CONSTRUCTION

CHANGES MADE DURING CONSTRUCTION HAVE BEEN INCORPORATED ON THESE PLANS EXCEPT CHANGES IN THE ORIGINAL THEORETICAL QUANTITIES. FOR ACTUAL QUANTITIES, REFER TO PROJECT LEDGER AND/OR COMPUTATION BOOK.

Cary Yamashita — RESIDENT ENGINEER — 10-24-83 DATE

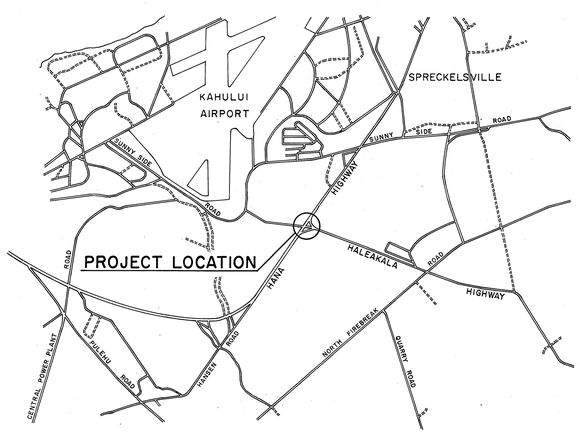

NORTH

LAYOUT PLAN

2000 0 2000 4000 6000

SCALE IN FEET

AUSTIN, TSUTSUMI, & ASSOC., INC.
ENGINEERS · SURVEYORS · HAWAII · GUAM

DESIGNED BY HERBERT TAO P. S. & E. BY 548-6932 PHONE APRIL 20, 1982 DATE

DEPARTMENT OF TRANSPORTATION
STATE OF HAWAII

APPROVED:

DIR. OF TRANSPORTATION — 10/25/83 DATE