FED. ROAD DIST. NO.	STATE	PROJ. NO.	FISCAL YEAR	SHEET NO.	TOTAL SHEETS
HAWAII	HAW.	36A-01-90	1990	4	5

NOTE:
SIGN R3-40 IS A VARIATION OF SIGN R3-8. PLATE AND ARROW DETAILS SHALL CONFORM TO SIGN R3-8.

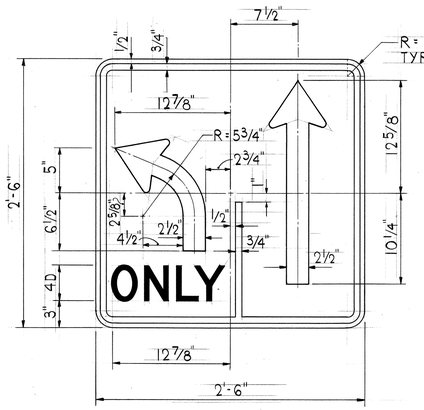

R3-40

TYPICAL SIGN DETAIL
NOT TO SCALE

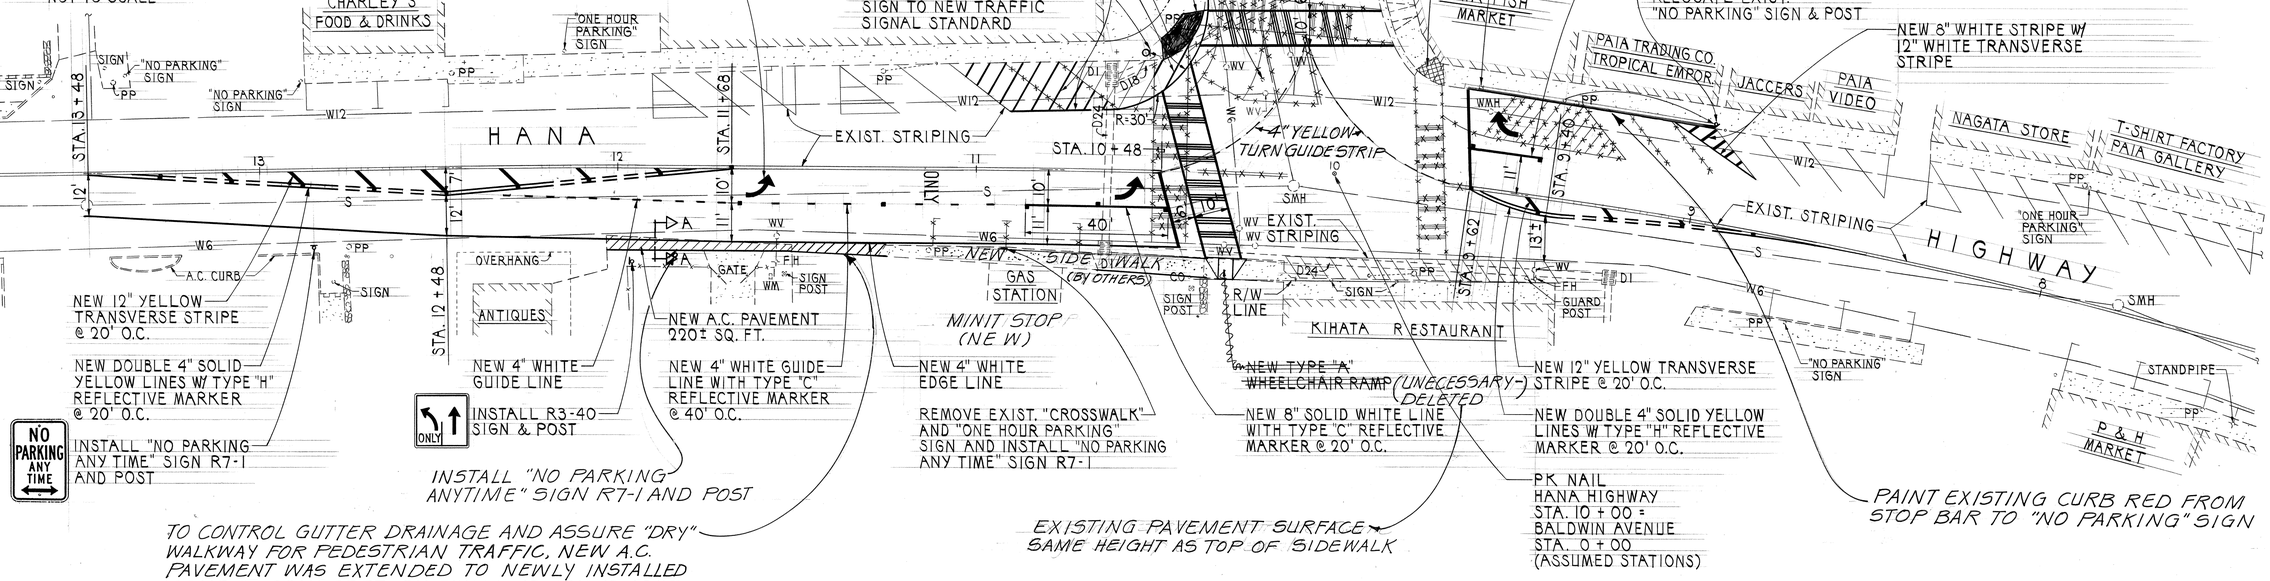

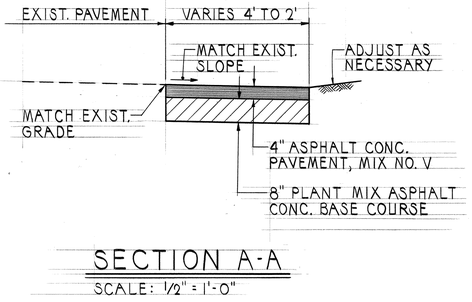

SECTION A-A
SCALE: 1/2" = 1'-0"

NOTES:
1. ~~ALL PAVEMENT MARKINGS SHALL BE OF THERMOPLASTIC EXTRUSION MATERIAL OR PREFORMED PAVEMENT MARKING TAPE.~~ DUE TO POOR CONDITION OF EXISTING PAVEMENT, PAINT WAS USED FOR ALL STRIPING.
2. RESTRIPE ALL EXISTING PAVEMENT MARKINGS BETWEEN STA. 8+00 AND STA. 13+50 ON HANA HIGHWAY AND BETWEEN STA. 0+00 AND STA. 1+00 ON BALDWIN AVENUE.

THEODORE S. KAWAHIGASHI REGISTERED PROFESSIONAL ENGINEER No. 3244-C HAWAII, U.S.A.

THIS WORK WAS PREPARED BY ME OR UNDER MY SUPERVISION
Theodore S. Kawahigashi

STATE OF HAWAII
DEPARTMENT OF TRANSPORTATION
HIGHWAYS DIVISION

STRIPING & SIGNING PLAN

HANA HIGHWAY
TRAFFIC SIGNALS AT
BALDWIN AVENUE
PROJECT NO. 36A-01-90

SCALE: AS NOTED DATE: FEB. 8, 1991

SHEET No. 1 OF 1 SHEETS

ORIGINAL PLANS	NOTE BOOK	No.	SURVEY PLOTTED BY	DRAWN BY	TRACED BY	DESIGNED BY	QUANTITIES BY	CHECKED BY	DATE