| FED. ROAD DIST. NO. | STATE | PROJ. NO. | FISCAL YEAR | SHEET NO. | TOTAL SHEETS |
|---|---|---|---|---|---|
| HAWAII | HAW. | 36A-01-90 | 1990 | 1 | 5 |

INDEX TO DRAWINGS


| SHEET NO. | DESCRIPTION |
|---|---|
| 1 | TITLE SHEET |
| 2 | STANDARD PLANS SUMMARY |
| 3 | LEGEND AND NOTES |
| 4 | STRIPING AND SIGNING PLAN |
| 5 | TRAFFIC SIGNAL PLAN |


STATE OF HAWAII

DEPARTMENT OF TRANSPORTATION

**HIGHWAYS DIVISION**

HONOLULU, HAWAII

"AS-BUILT"

**PLANS FOR**

# HANA HIGHWAY

# TRAFFIC SIGNALS AT BALDWIN AVENUE

# PROJECT NO. 36A-01-90

**DISTRICT OF MAKAWAO**

**ISLAND OF MAUI**

## LOCATION OF PROJECT

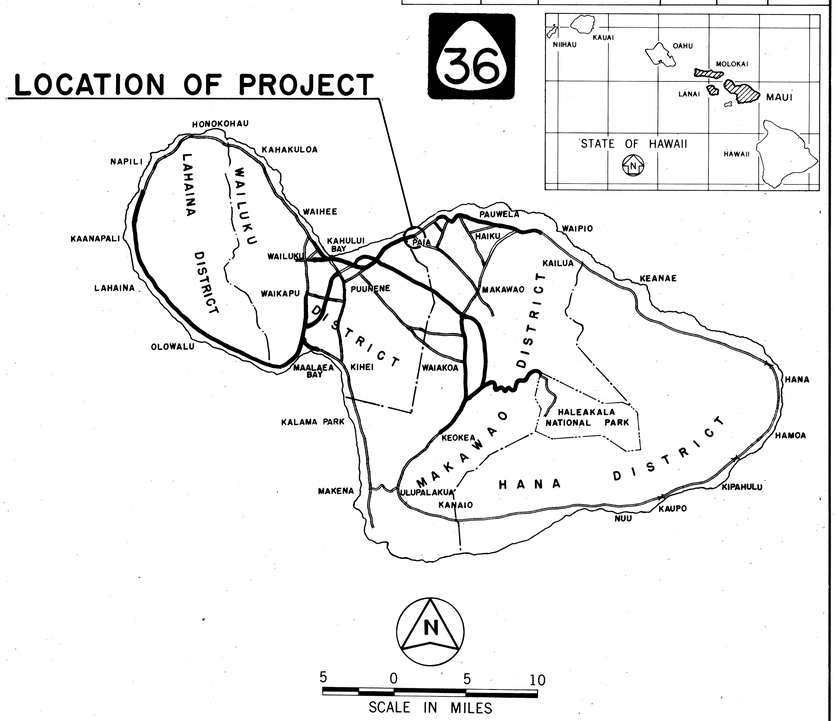


FEDERAL AID PROJECTS PREVIOUSLY CONSTRUCTED OR UNDER CONSTRUCTION

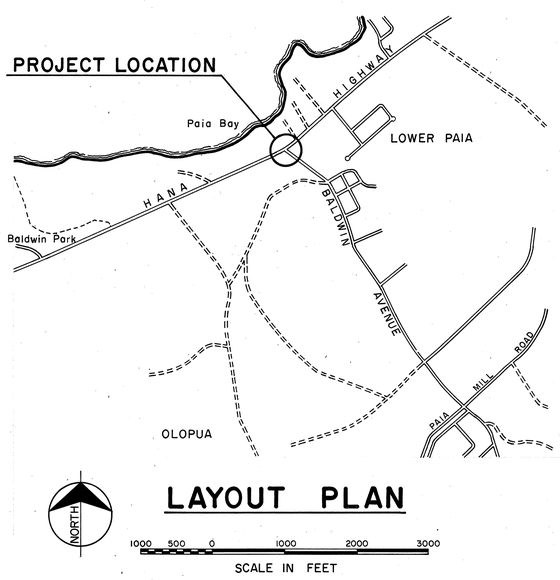


## LAYOUT PLAN

FEB. 8, 1991 DATE

PHONE

P. S. & E. BY

DESIGNED BY

AUSTIN, TSUTSUMI, & ASSOC., INC. ENGINEERS - SURVEYORS - HAWAII

CHANGES MADE DURING CONSTRUCTION HAVE BEEN INCORPORATED ON THESE PLANS EXCEPT CHANGES IN THE ORIGINAL THEORETICAL QUANTITIES. FOR ACTUAL QUANTITIES, REFER TO PROJECT LEDGER AND/OR COMPUTATION BOOK.

Spencer C. Kyland — RESIDENT ENGINEER — 8-5-92 DATE

DEPARTMENT OF TRANSPORTATION
STATE OF HAWAII

APPROVED:

DIR. OF TRANSPORTATION — 2/12/91 DATE