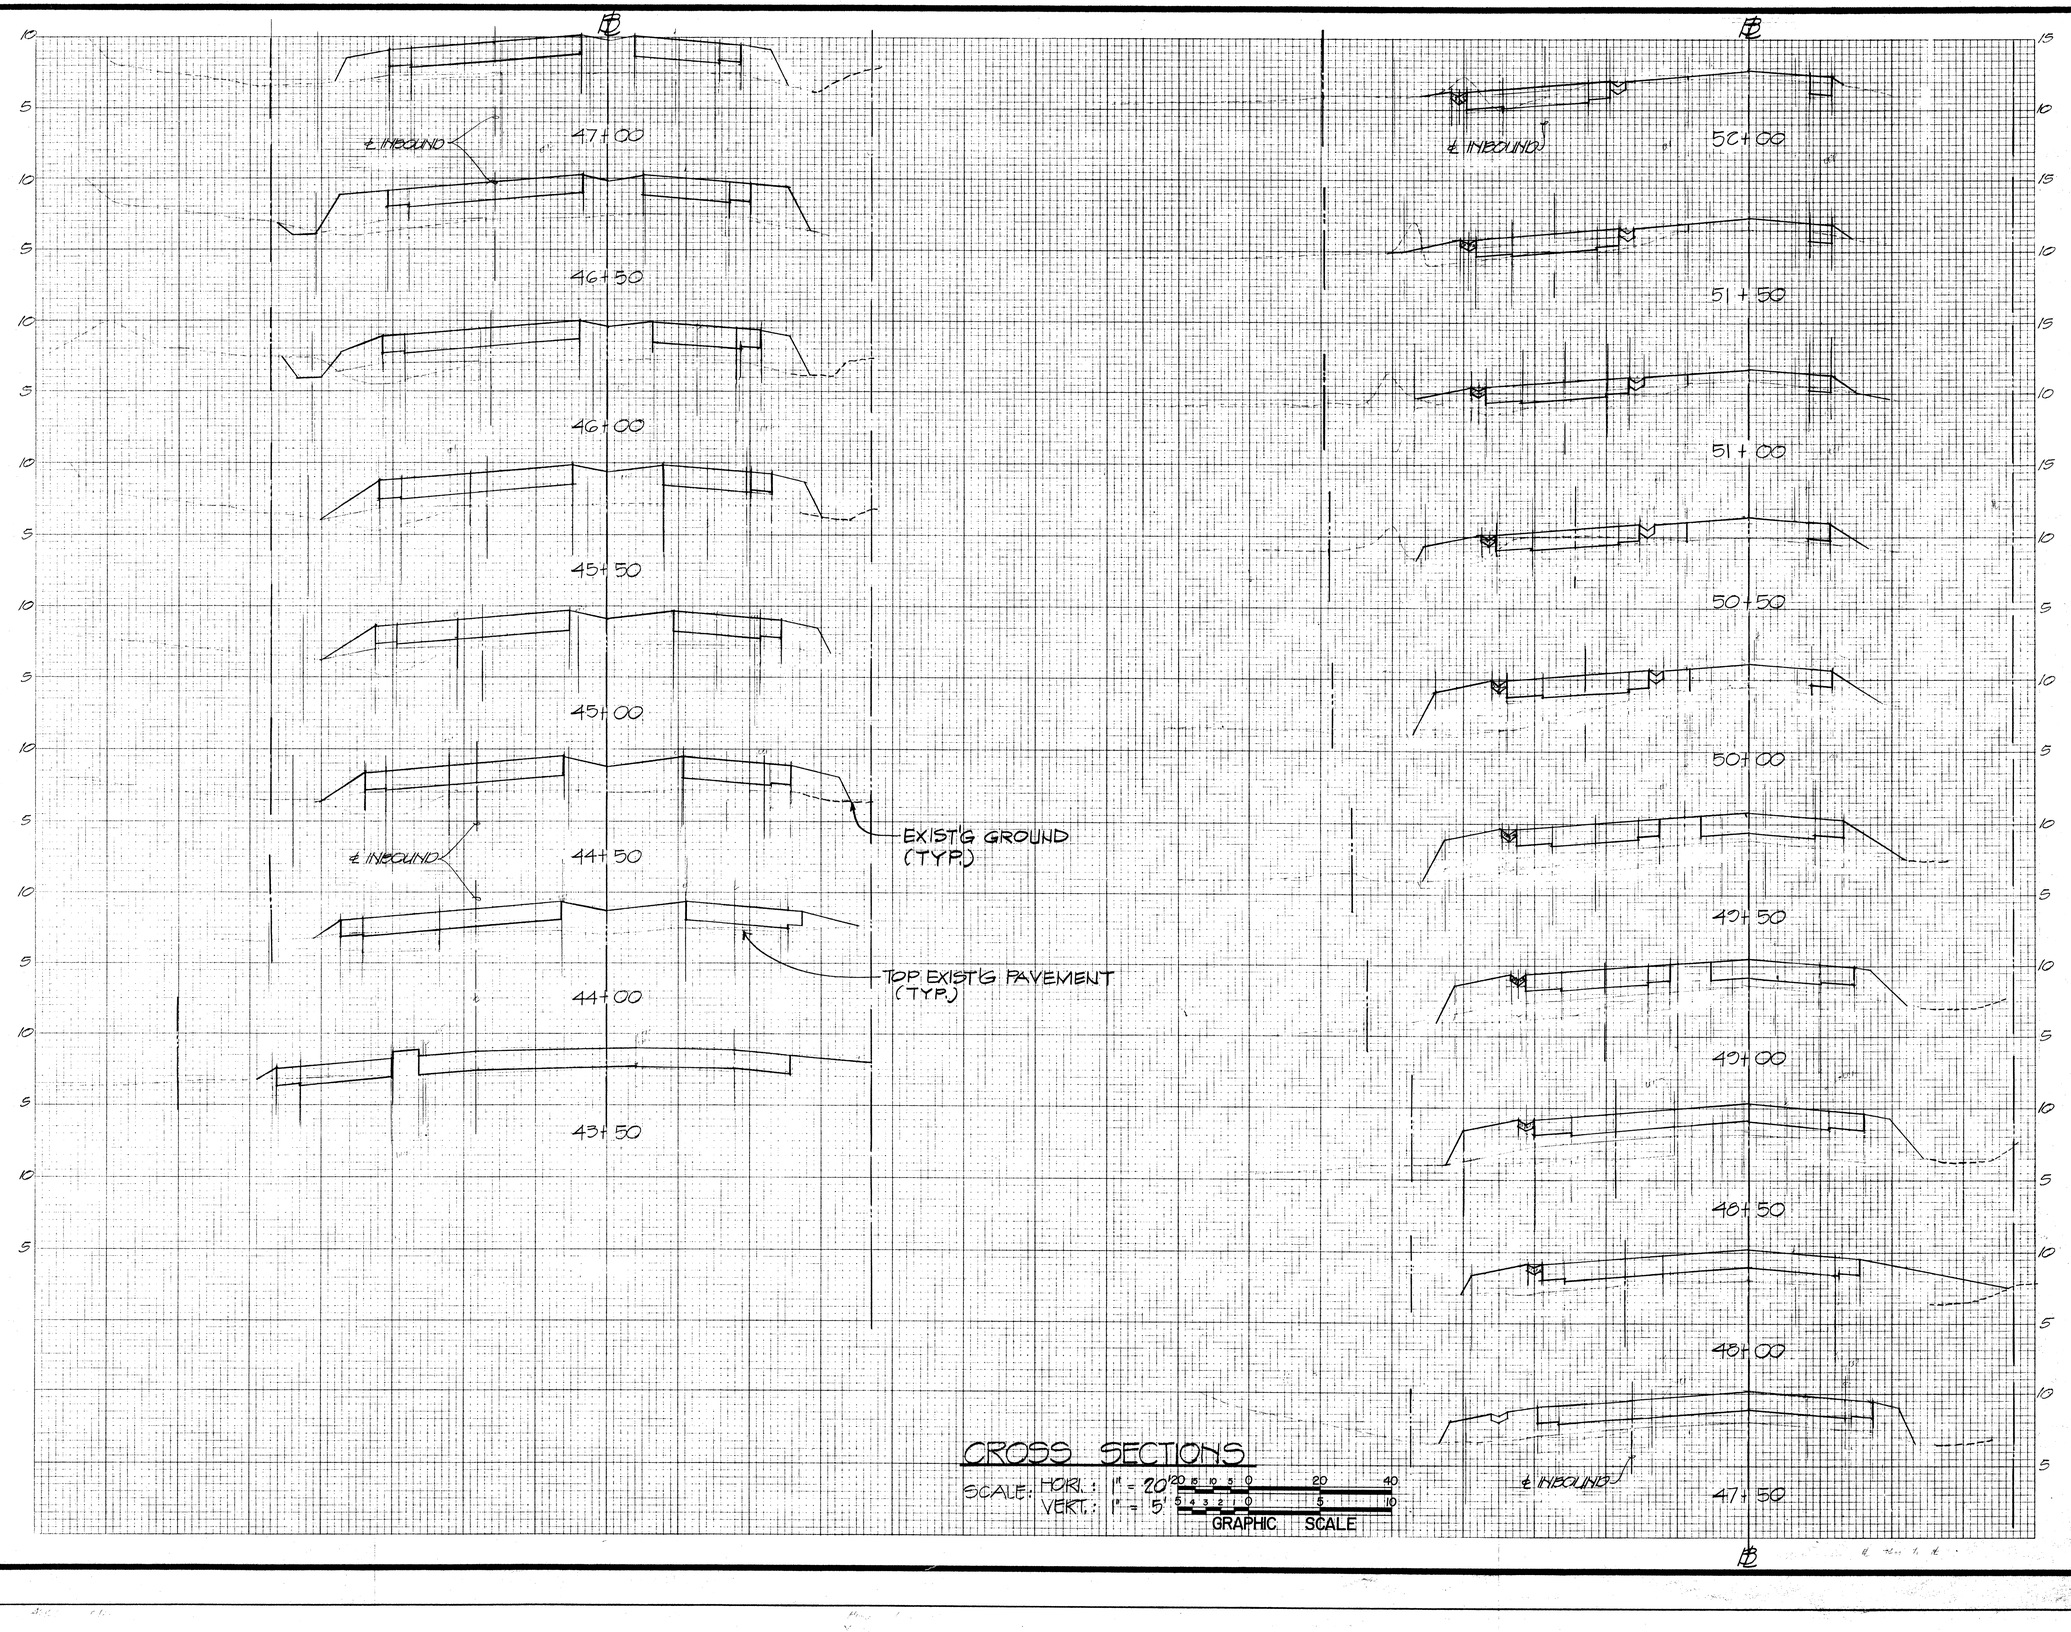


CROSS SECTIONS

SCALE: HORI.: 1" = 20'
VERT.: 1" = 5'

GRAPHIC SCALE

THIS WORK WAS PREPARED BY ME OR UNDER MY SUPERVISION.

10/3/89

ROBERT T. TANAKA REGISTERED PROFESSIONAL ENGINEER No. 1754-C HAWAII, U.S.A.

R. T. TANAKA ENGINEERS, INC.
871 KOLU STREET, SUITE 201
WAILUKU, MAUI, HAWAII 96793

DSGN	DRWN	CHKD	APPD
R.H.	C.T.	R.I.T.	

KEY PLAN / NOTES :

NO. DATE REVISIONS

AS-BUILT (Record Drawing)

DATE 7/12/91

This Drawing has been prepared, in part, based upon information furnished by others. While this information is believed to be reliable, the Design Professional cannot assure its accuracy of this As-Built drawing or for any errors or omissions which may have been incorporated into it as a result.

PROJECT TITLE :

HANA HIGHWAY IMPROVEMENTS

PROJECT NO. :


STATE NO. AM-1061-12
AIP NO. 3-15-0006-11

SHEET TITLE :

CROSS - SECTIONS

DATE 11-15-89

DWG NO C-48

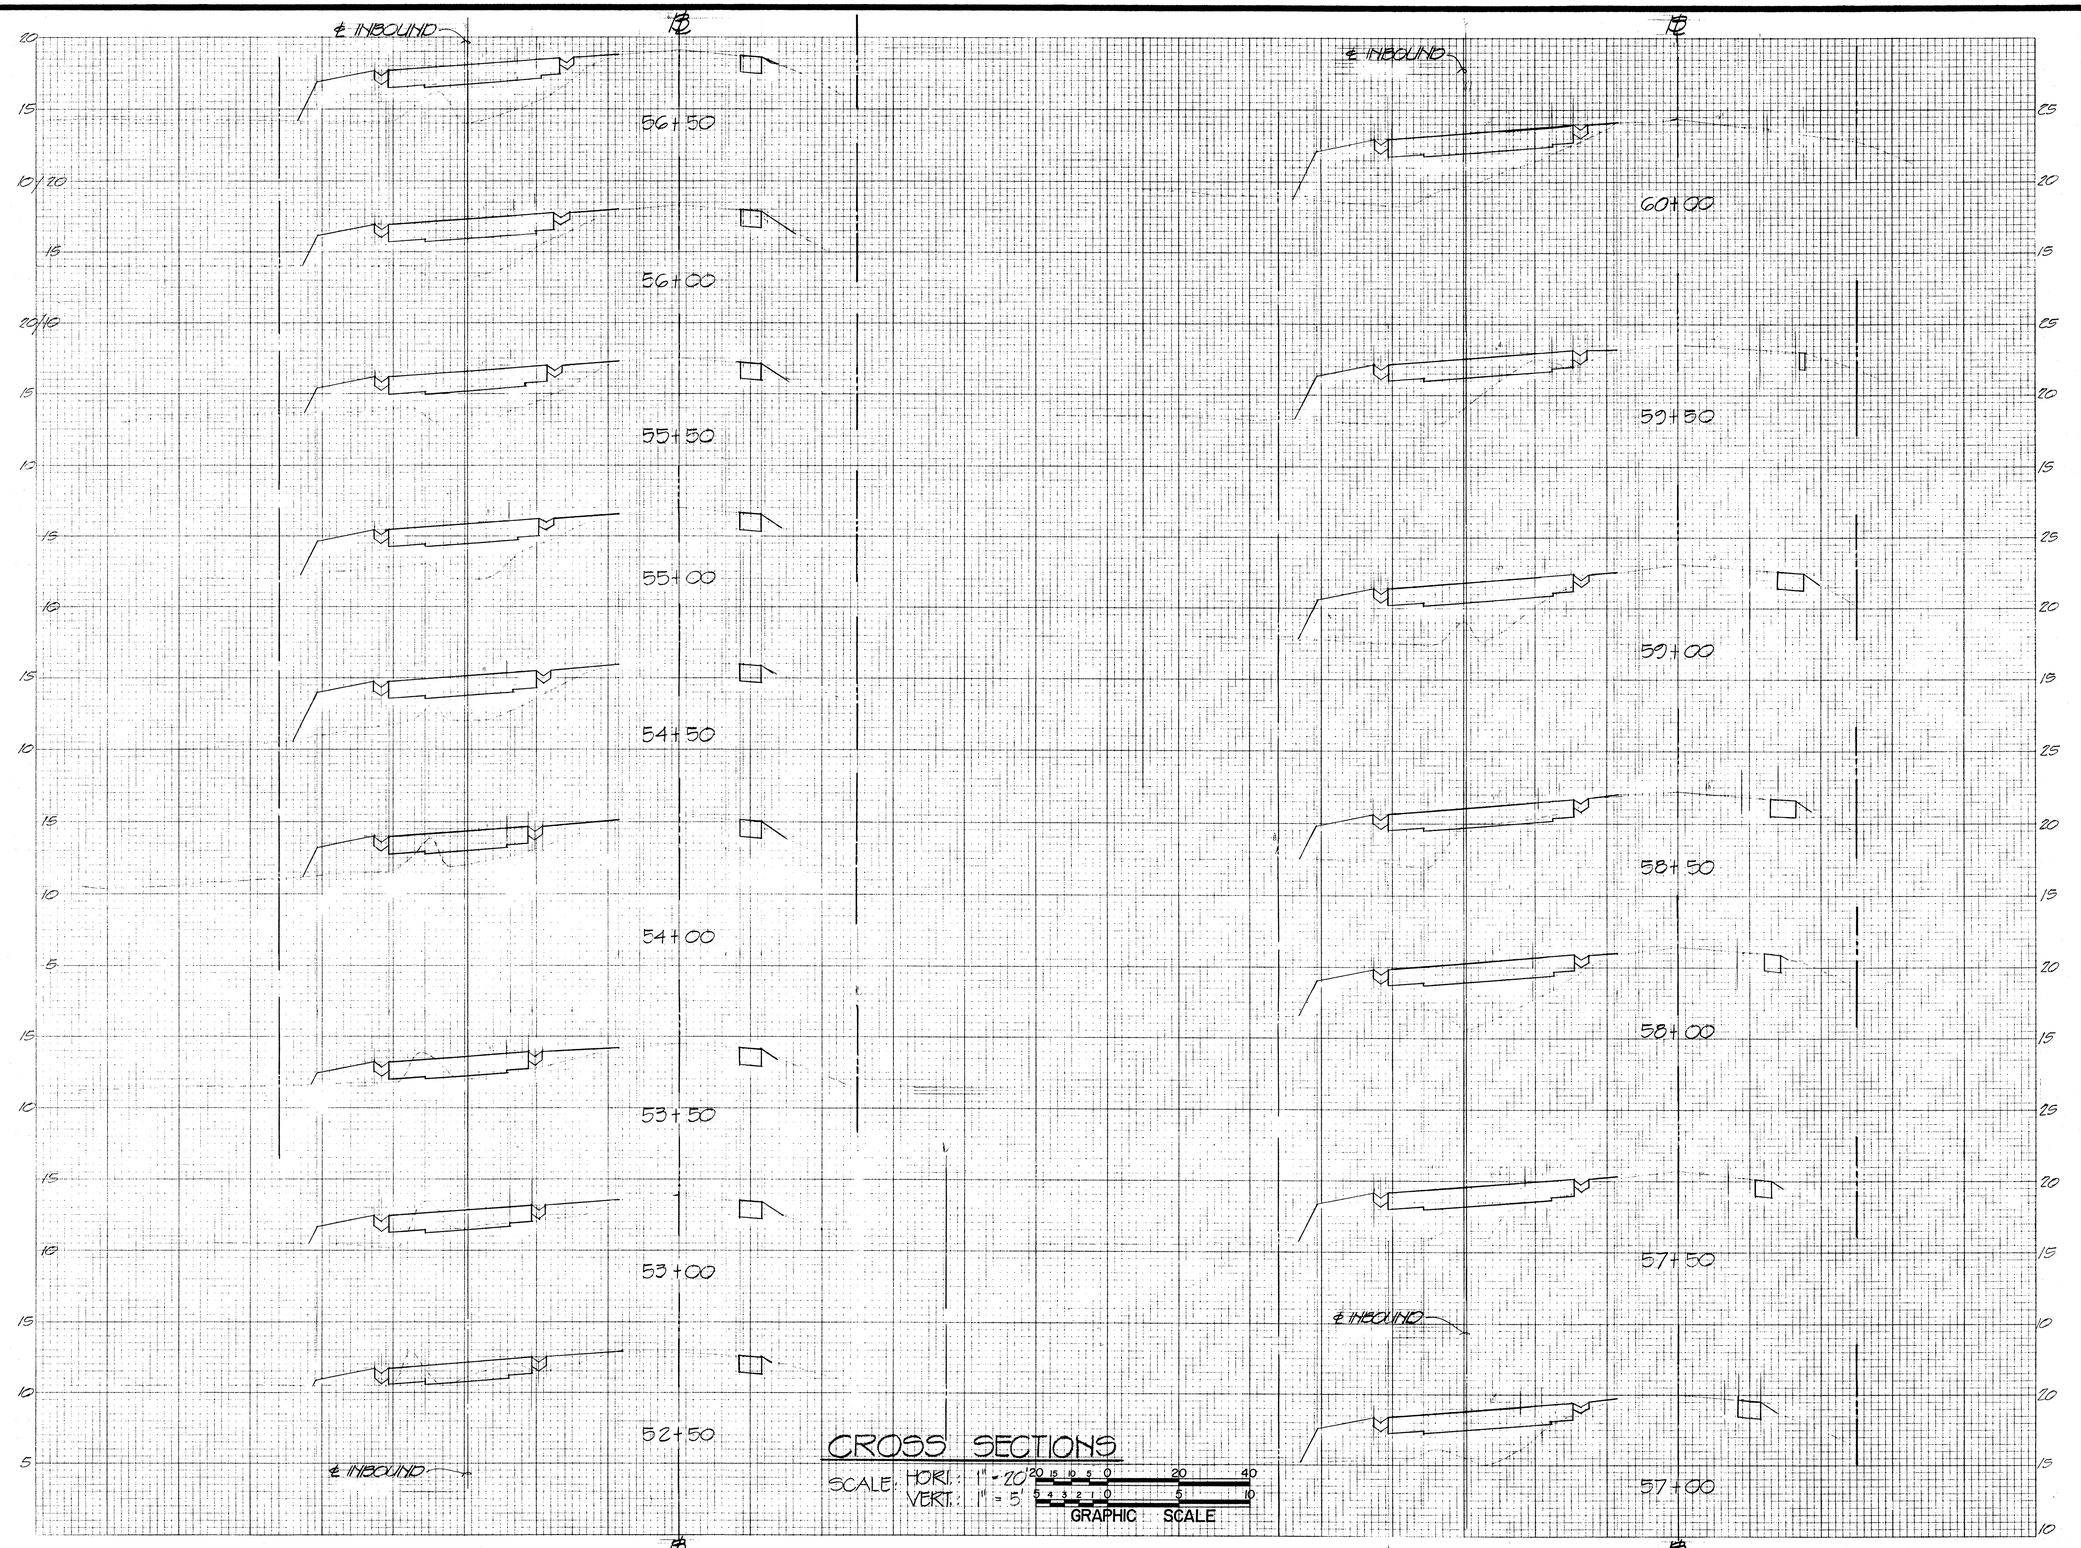

CROSS SECTIONS

SCALE: HORI.: 1" = 20'
VERT.: 1" = 5'

GRAPHIC SCALE

Airports Division

THIS WORK WAS PREPARED BY ME OR UNDER MY SUPERVISION.

10/3/89

ROBERT T. TANAKA REGISTERED PROFESSIONAL ENGINEER No. 1754-C HAWAII, U.S.A.

R. T. TANAKA ENGINEERS, INC.
871 KOLU STREET, SUITE 201
WAILUKU, MAUI, HAWAII 96793

DSGN	DRWN.	CHKD	APPD
R.H.	C.T.	R.T.T.	

KEY PLAN / NOTES :

NO DATE REVISIONS

AS-BUILT (Record Drawing)

DATE 7/12/91

This Drawing has been prepared, in part, based upon information furnished by others. While this information is believed to be reliable, the Design Professional cannot assure the accuracy of this As-Built drawing or for any errors or omissions which may have been incorporated into it as a result.

PROJECT TITLE :

HANA HIGHWAY IMPROVEMENTS

PROJECT NO. :


STATE NO. AM-1061-12
AIP NO. 3-15-0006-11

SHEET TITLE :

CROSS - SECTIONS.

DATE 11-15-89

DWG NO C-49

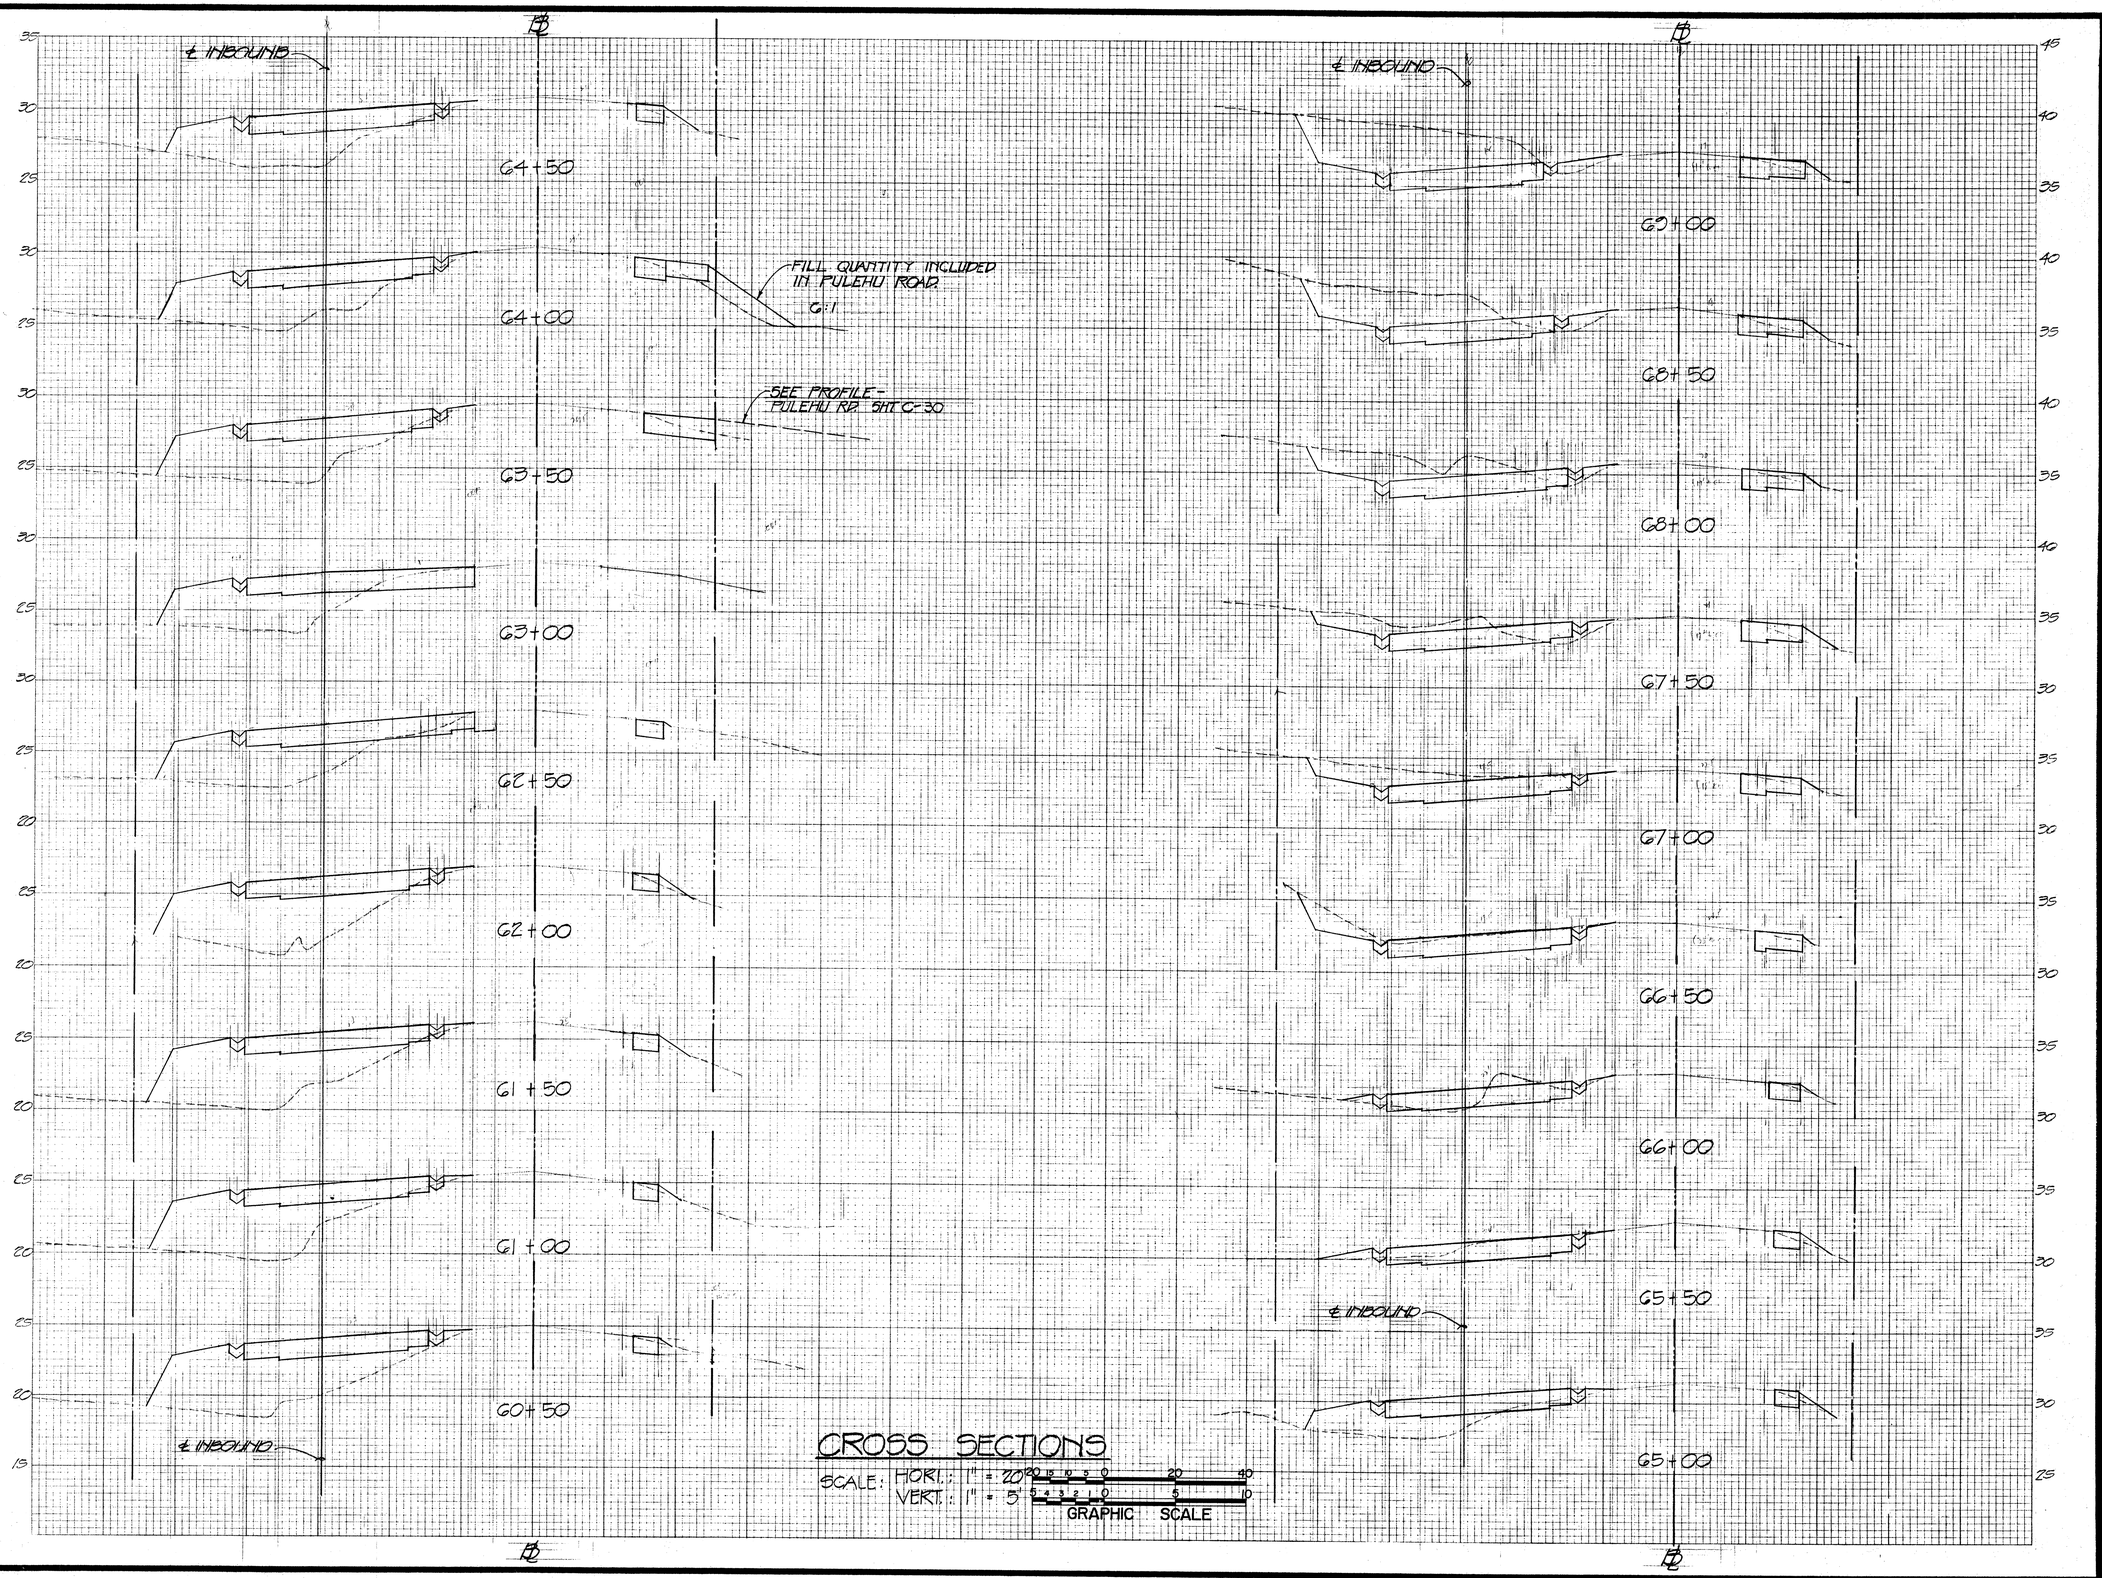

THIS WORK WAS PREPARED BY ME OR UNDER MY SUPERVISION.

10/3/89

ROBERT T. TANAKA REGISTERED PROFESSIONAL ENGINEER No. 1754-C HAWAII, U.S.A.

R. T. TANAKA ENGINEERS, INC.
871 KOLU STREET, SUITE 201
WAILUKU, MAUI, HAWAII 96793

DSGN.	DRWN.	CHKD	APPD
R.H.	C.T.	R.T.T.	

KEY PLAN / NOTES :

NO	DATE	REVISIONS

AS-BUILT (Record Drawing)

DATE 7/12/91

This Drawing has been prepared, in part, based upon information furnished by others. While this information is believed to be reliable, the Design Professional cannot assure the accuracy of this As-Built drawing or for any errors or omissions which may have been incorporated into it as a result.

PROJECT TITLE :

HANA HIGHWAY IMPROVEMENTS

PROJECT NO. :


STATE NO. AM-1061-12
AIP NO. 3-15-0006-11

SHEET TITLE :

CROSS - SECTIONS

DATE: 10-3-89

DWG NO: C-50

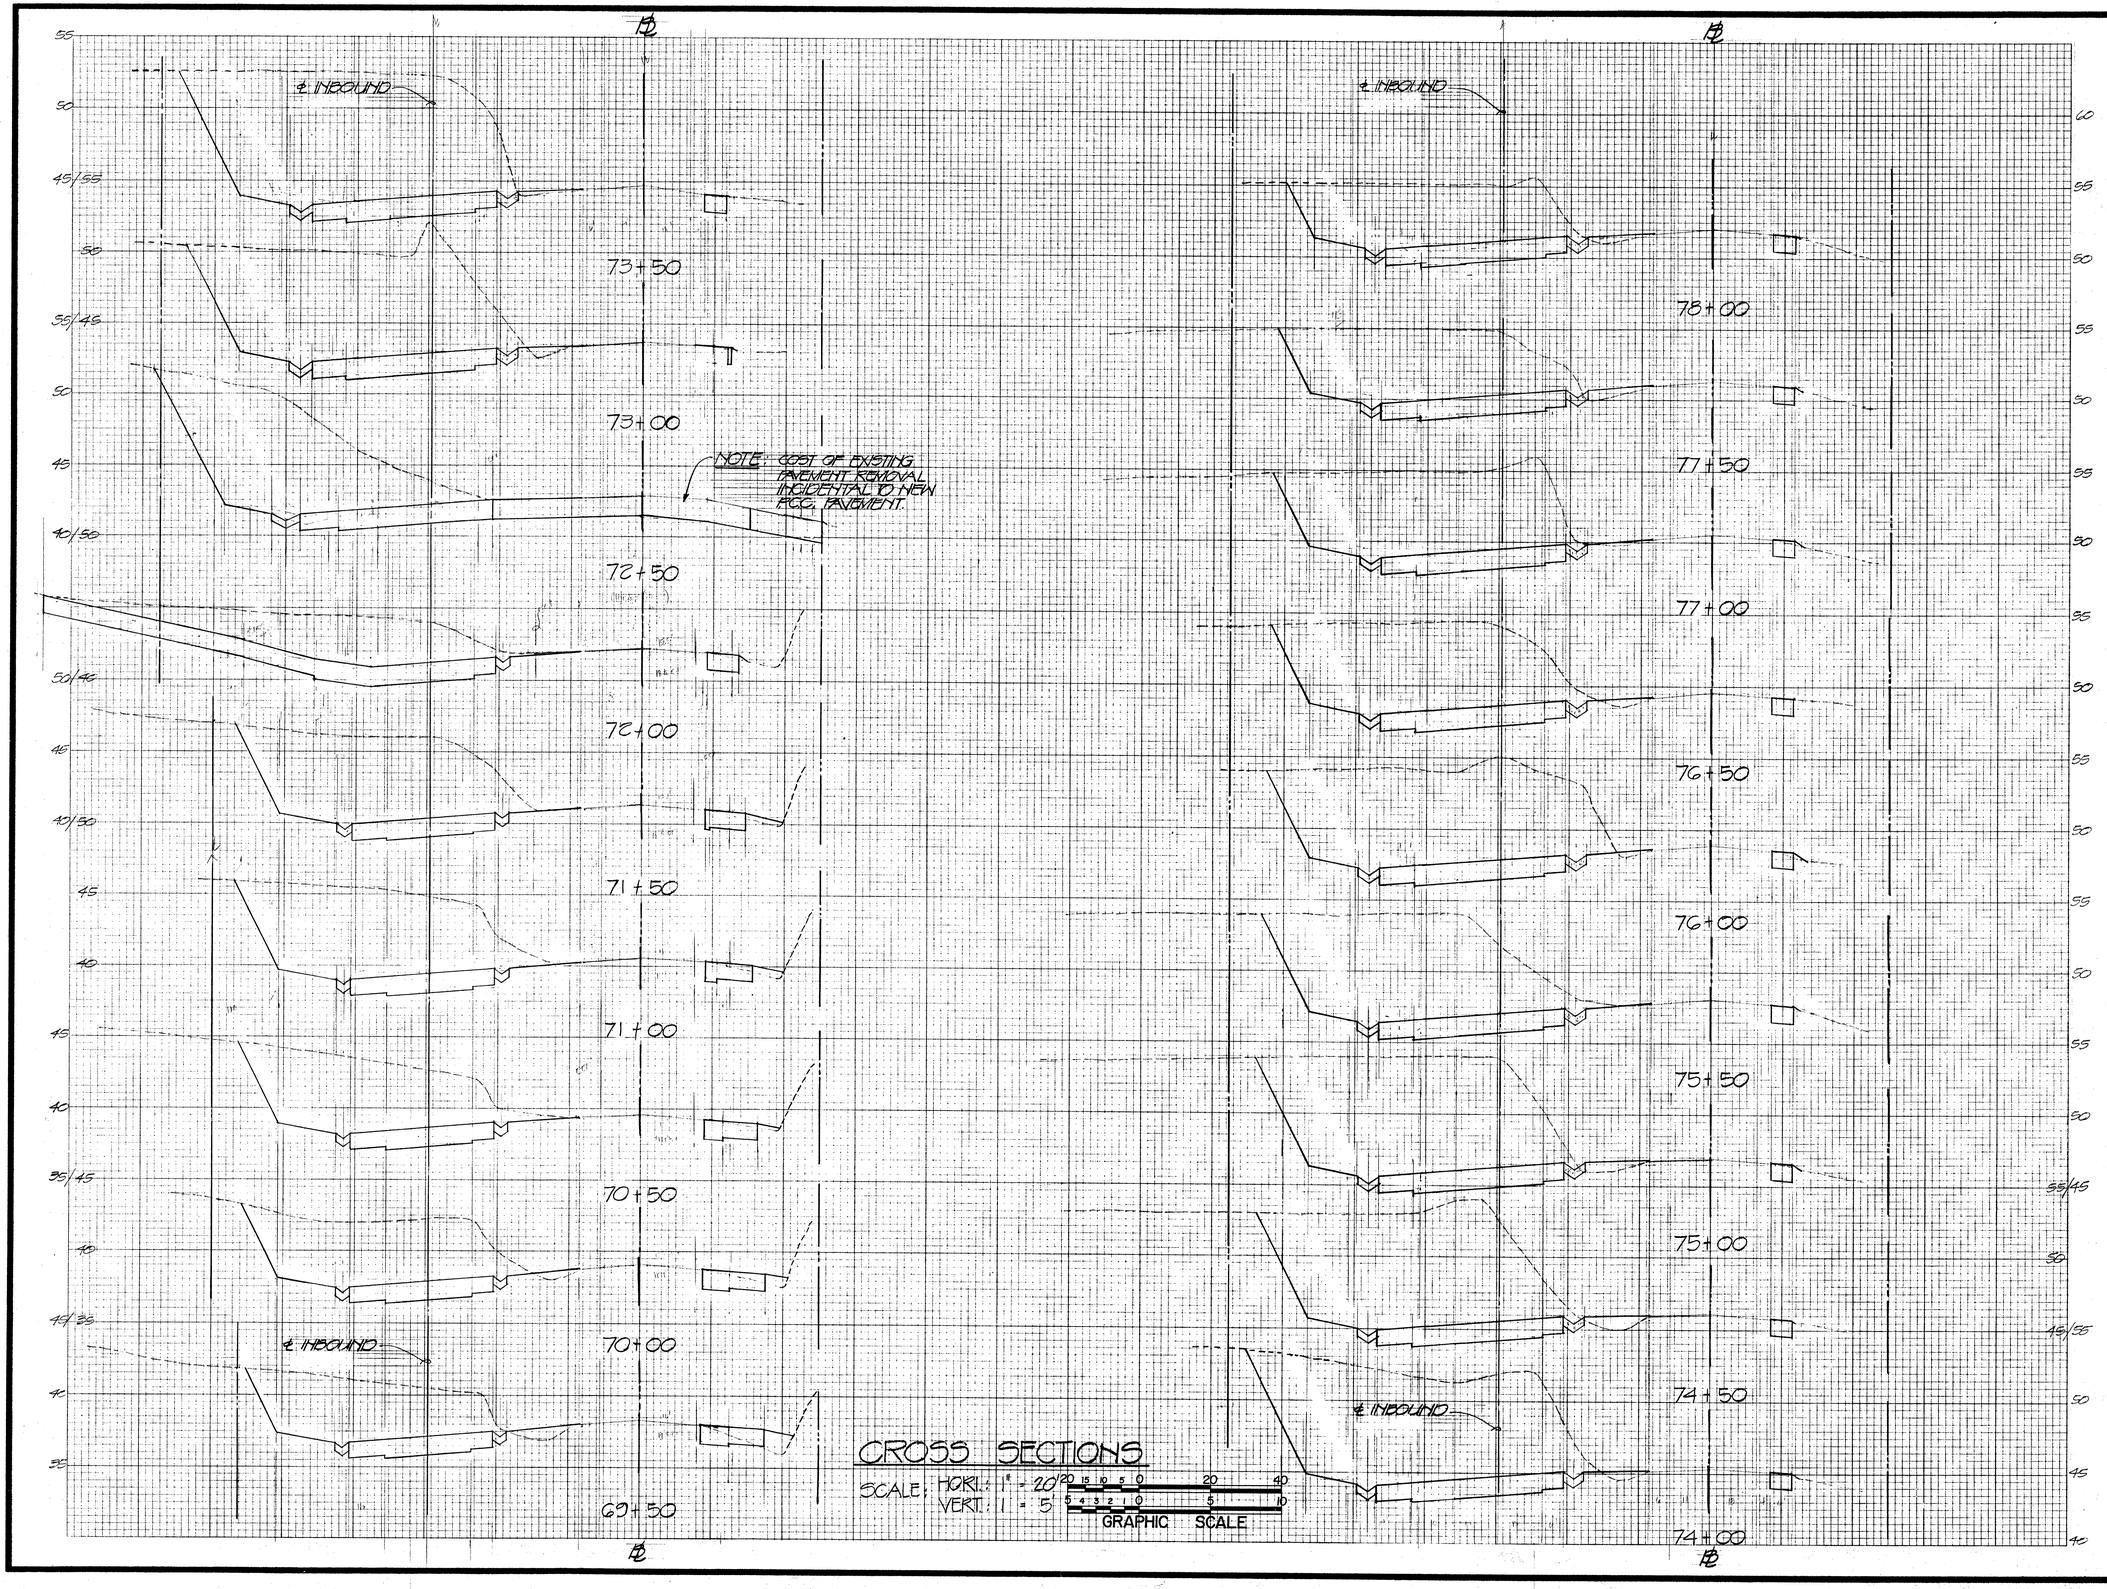

THIS WORK WAS PREPARED BY ME OR UNDER MY SUPERVISION.

ROBERT T. TANAKA REGISTERED PROFESSIONAL ENGINEER No. 1754-C HAWAII, U.S.A.

10/3/89

R. T. TANAKA ENGINEERS, INC.
871 KOLU STREET, SUITE 201
WAILUKU, MAUI, HAWAII 96793

DSGN	DRWN	CHK'D	APP'D
R.H.	C.T.	R.T.T	

KEY PLAN / NOTES :

NO. DATE REVISIONS

AS-BUILT (Record Drawing)

DATE 7/12/91

This Drawing has been prepared, in part, based upon information furnished by others. While this information is believed to be reliable, the Design Professional cannot assure its accuracy of this As-Built drawing or for any errors or omissions which may have been incorporated into it as a result.

PROJECT TITLE :

HANA HIGHWAY IMPROVEMENTS

PROJECT NO. :


STATE NO. AM-1061-12
AIP NO. 3-15-0006-11

SHEET TITLE :

CROSS - SECTIONS

DATE 11-15-89

DWG. NO. C-51

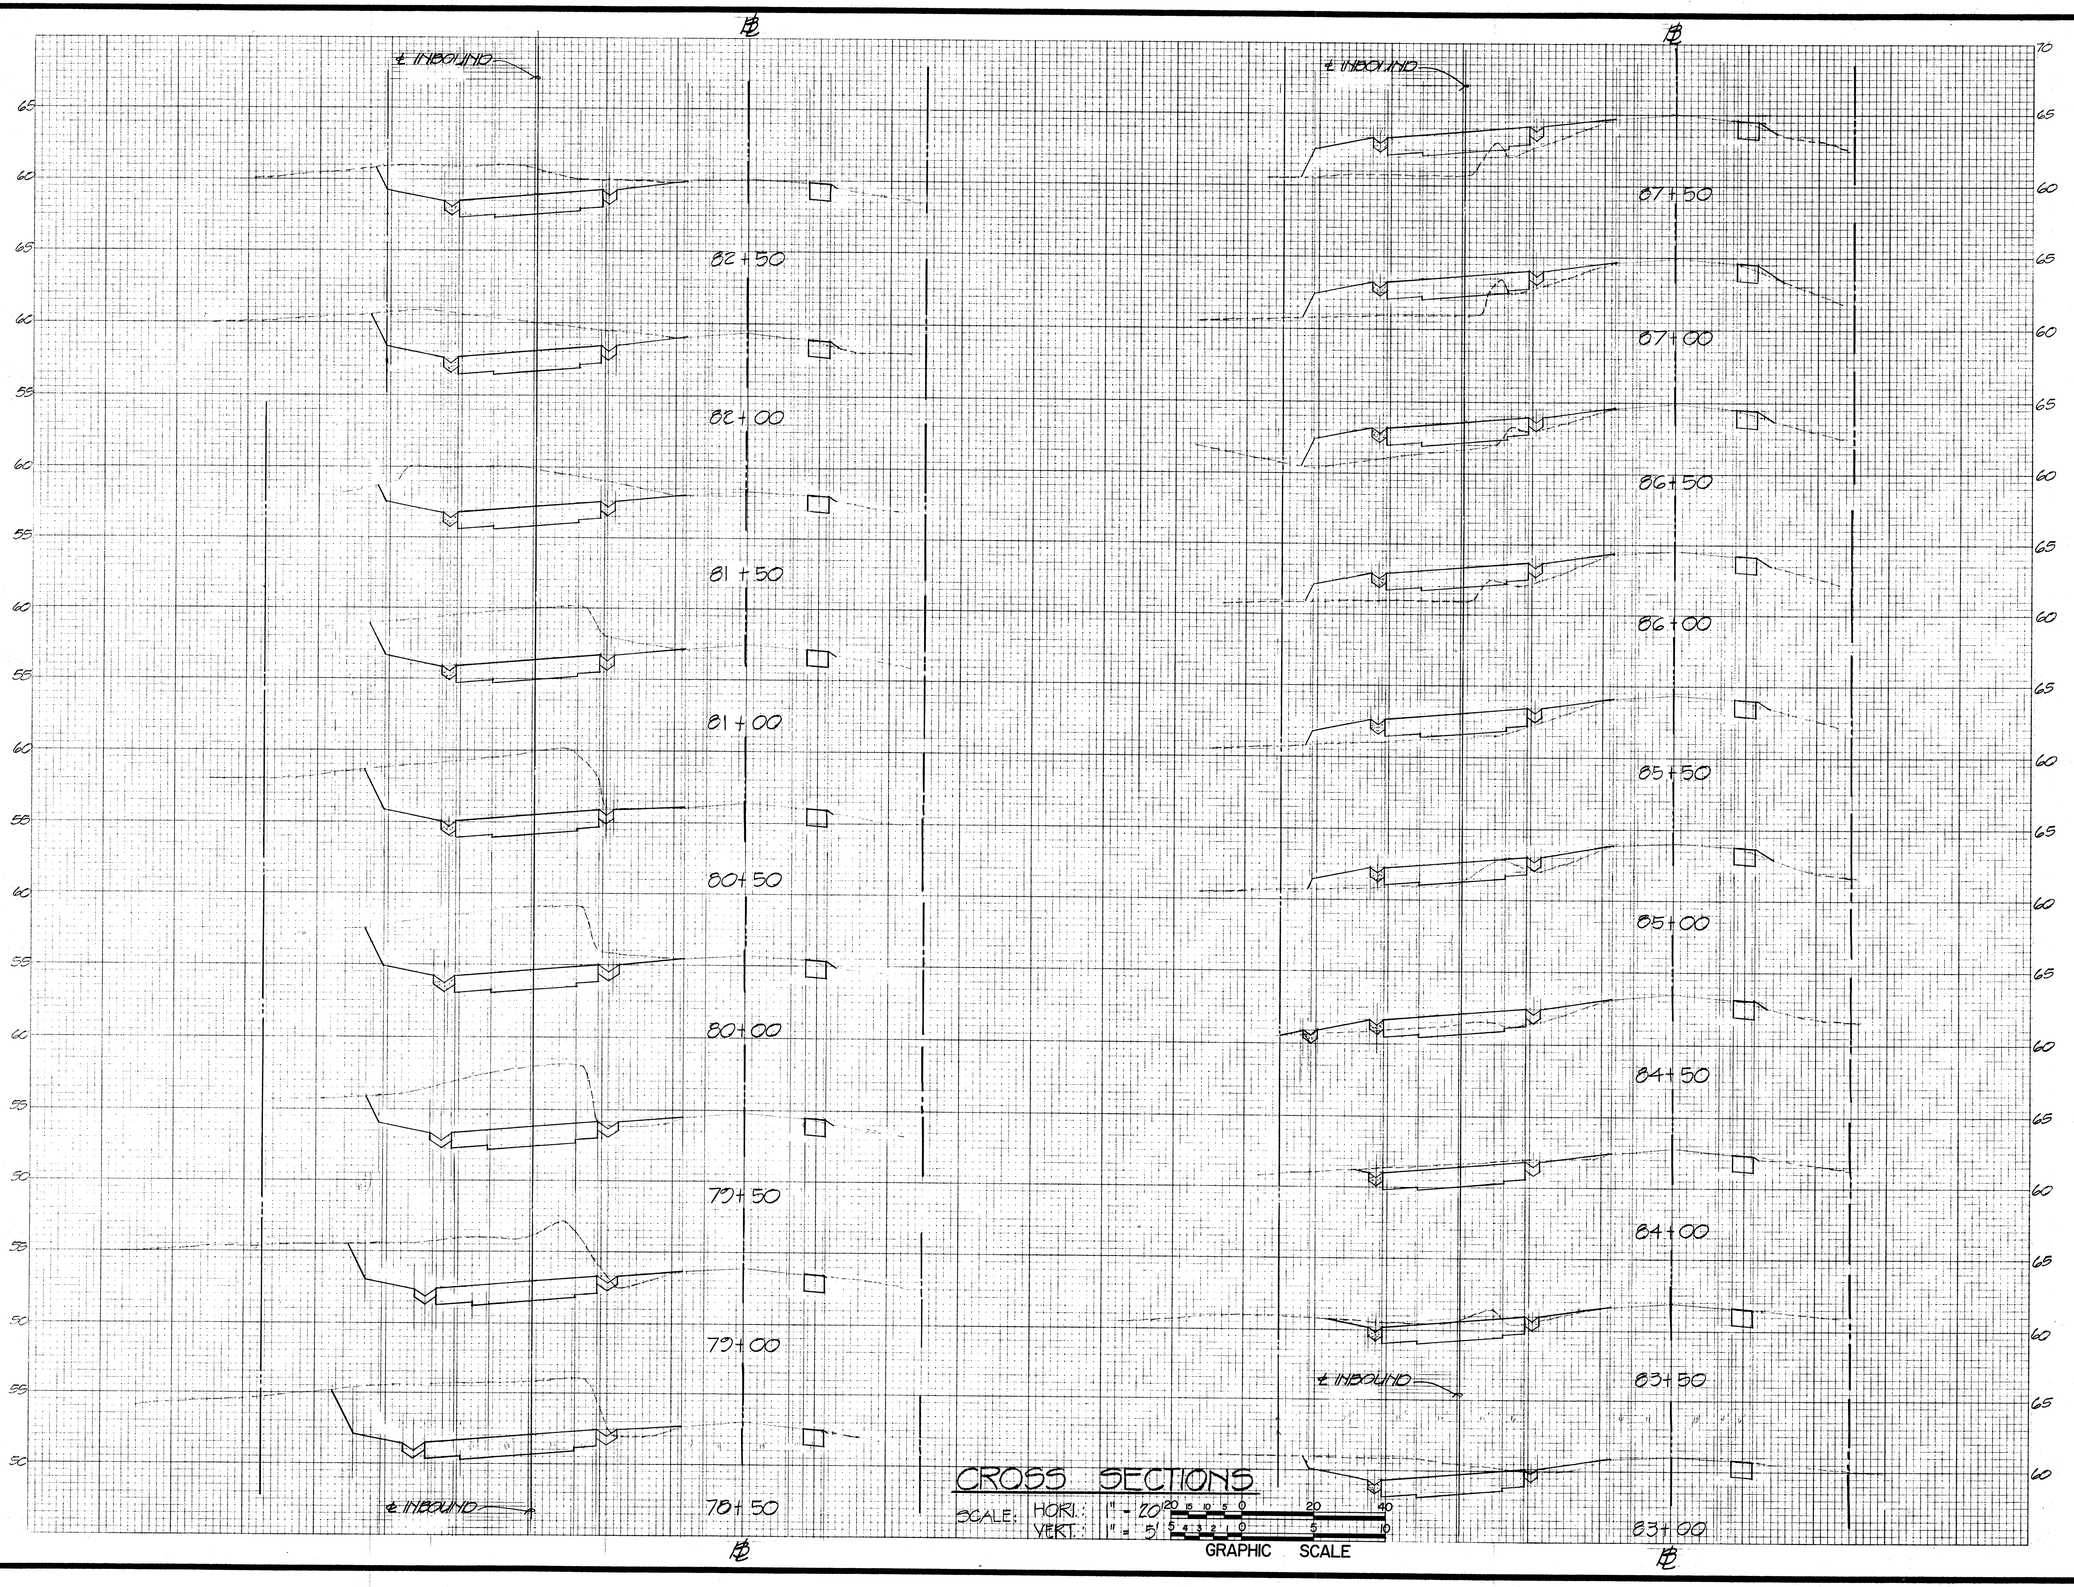

CROSS SECTIONS

SCALE: HORI.: 1" = 20'
VERT.: 1" = 5'

GRAPHIC SCALE

THIS WORK WAS PREPARED BY ME OR UNDER MY SUPERVISION.

10/3/89

ROBERT T. TANAKA REGISTERED PROFESSIONAL ENGINEER No. 1754-C HAWAII, U.S.A.

R. T. TANAKA ENGINEERS, INC.
871 KOLU STREET, SUITE 201
WAILUKU, MAUI, HAWAII 96793

DSGN.	DRWN.	CHK'D.	APP'D
R.H.	C.T.	R.T.T.	

KEY PLAN / NOTES :

NO. DATE REVISIONS

AS-BUILT (Record Drawing)

DATE 7/12/91

This Drawing has been prepared, in part, based upon information furnished by others. While this information is believed to be reliable, the Design Professional cannot assure the accuracy of this As-Built drawing or for any errors or omissions which may have been incorporated into it as a result.

PROJECT TITLE :

HANA HIGHWAY IMPROVEMENTS

PROJECT NO. :


STATE NO. AM-1061-12
AIP NO. 3-15-0006-11

SHEET TITLE :

CROSS - SECTIONS

DATE 10-3-89

DWG NO C-52

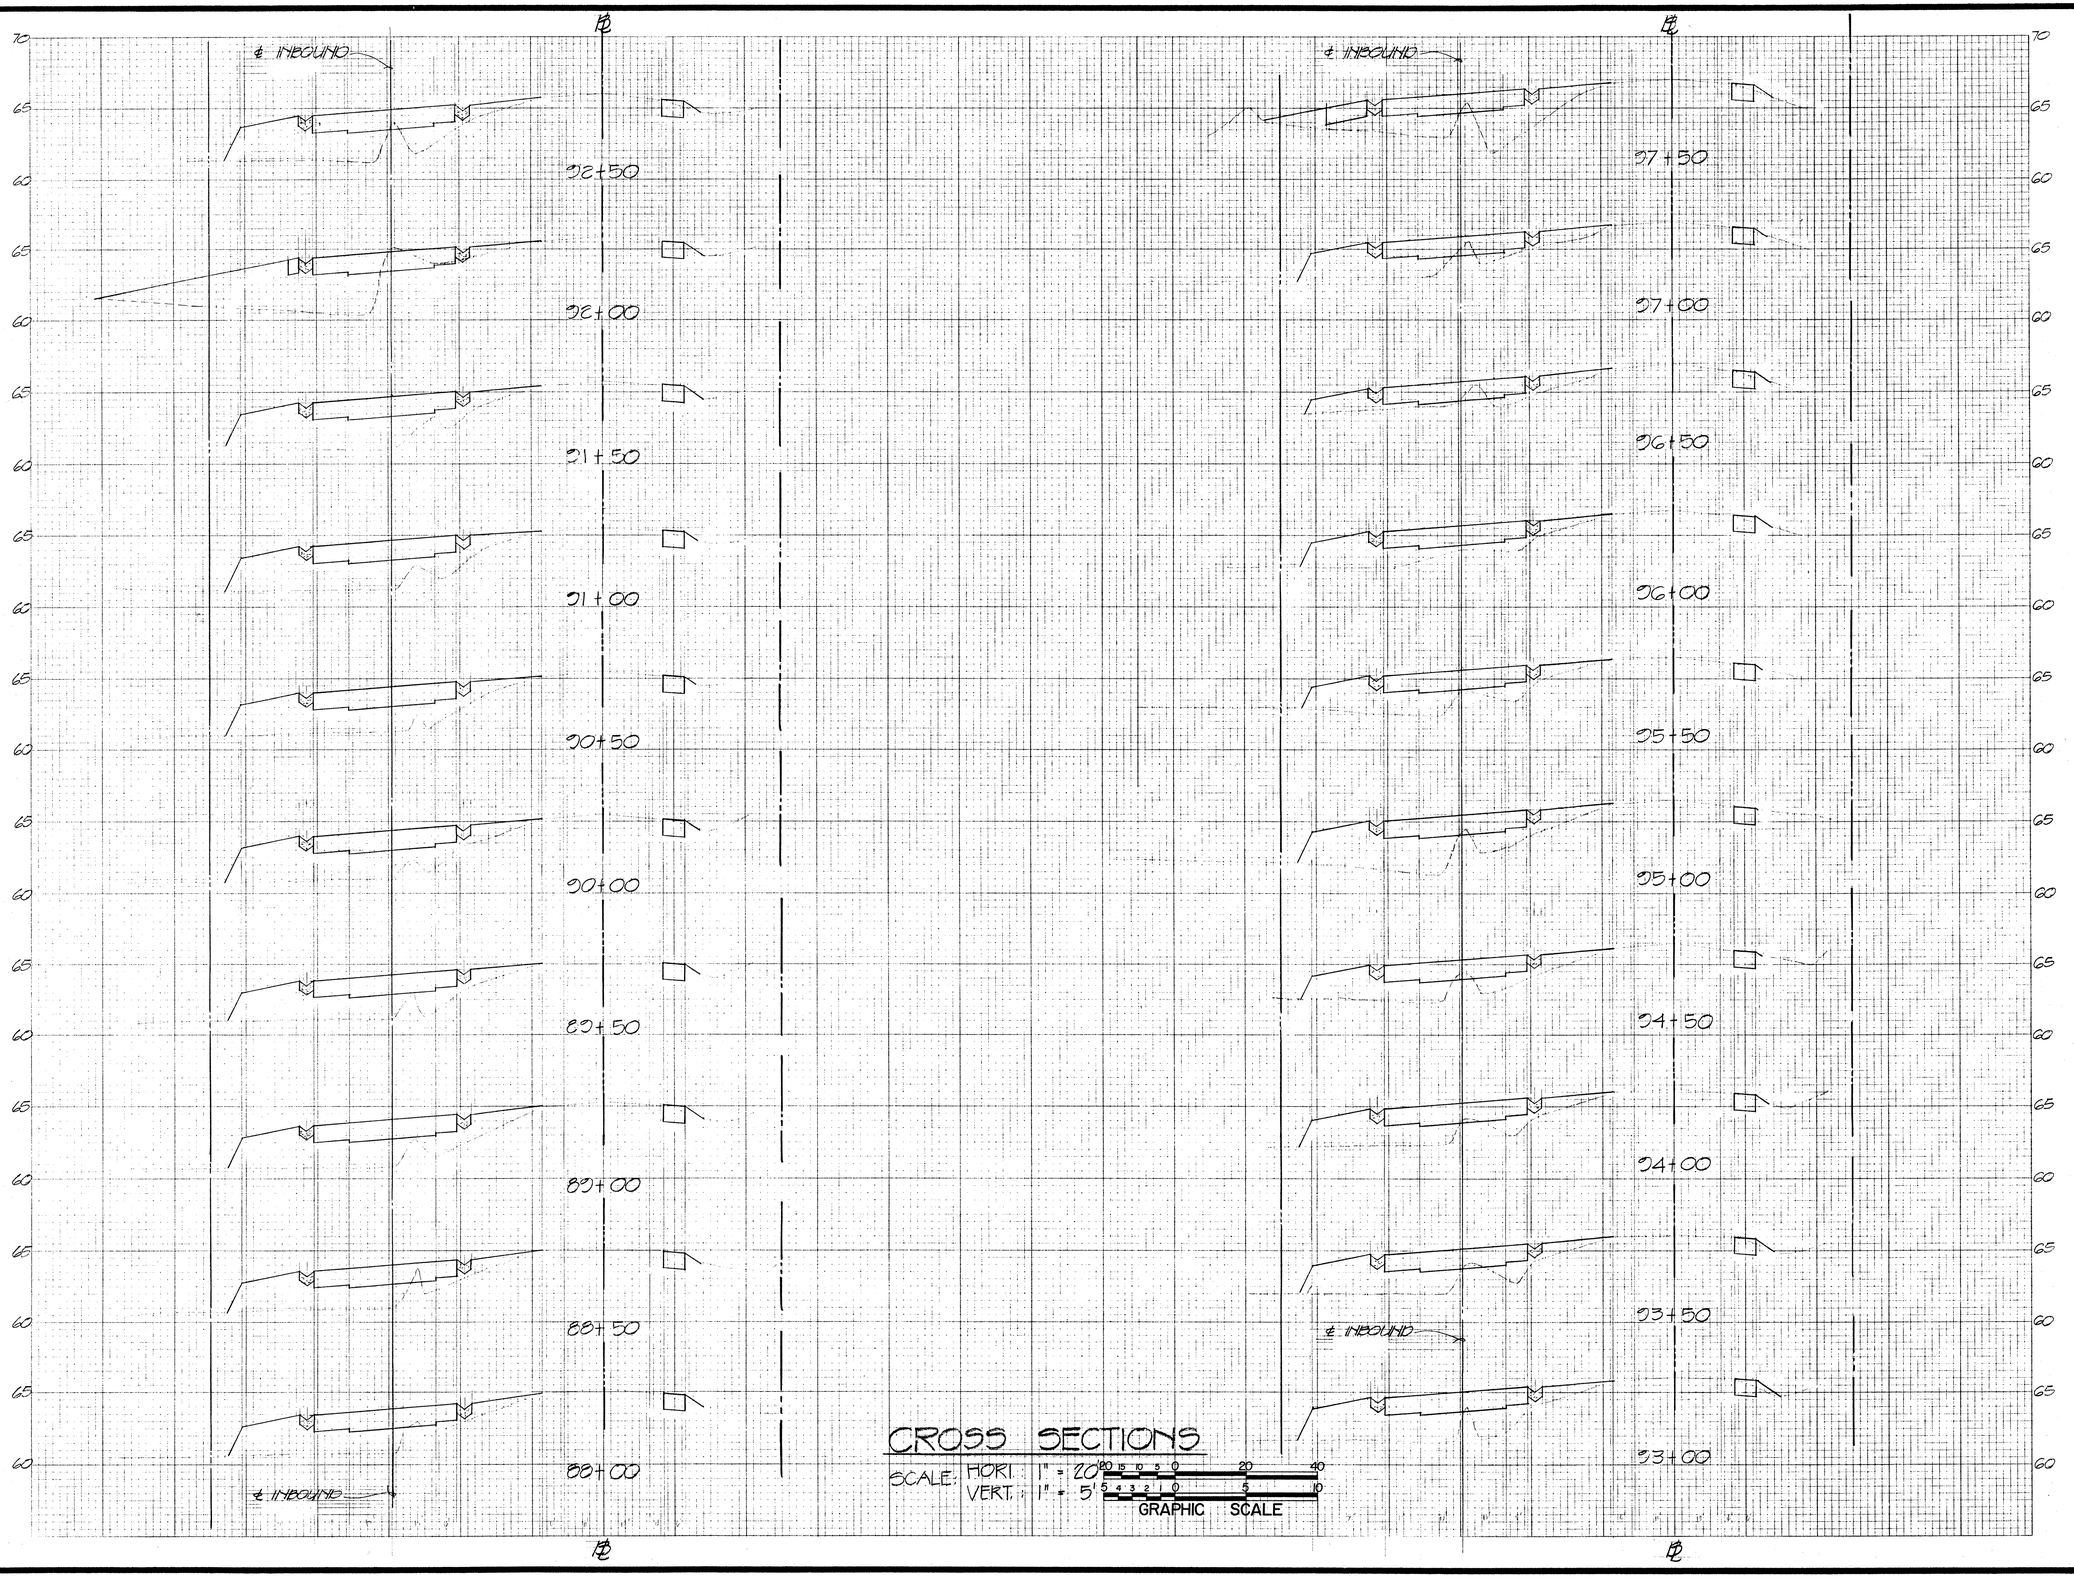

CROSS SECTIONS

SCALE: HORI. 1" = 20'
VERT. 1" = 5'

GRAPHIC SCALE

Airports Division

THIS WORK WAS PREPARED BY ME OR UNDER MY SUPERVISION.

10/3/89

ROBERT T. TANAKA REGISTERED PROFESSIONAL ENGINEER No. 1754-C HAWAII, U.S.A.

R. T. TANAKA ENGINEERS, INC.
871 KOLU STREET, SUITE 201
WAILUKU, MAUI, HAWAII 96793

DSGN.	DRWN.	CHKD	APPD.
R.H.	C.T.	R.T.T.	

KEY PLAN / NOTES :

NO. DATE REVISIONS

AS-BUILT (Record Drawing)

DATE 7/12/91

This Drawing has been prepared, in part, based upon information furnished by others. While this information is believed to be reliable, the Design Professional cannot assume accuracy of this As-Built drawing or for any errors or omissions which may have been incorporated into it as a result.

PROJECT TITLE :

HANA HIGHWAY IMPROVEMENTS

PROJECT NO. :


STATE NO. AM-1061-12
AIP NO. 3-15-0006-11

SHEET TITLE :

CROSS - SECTIONS

DATE : 10-3-89

DWG NO. C-53

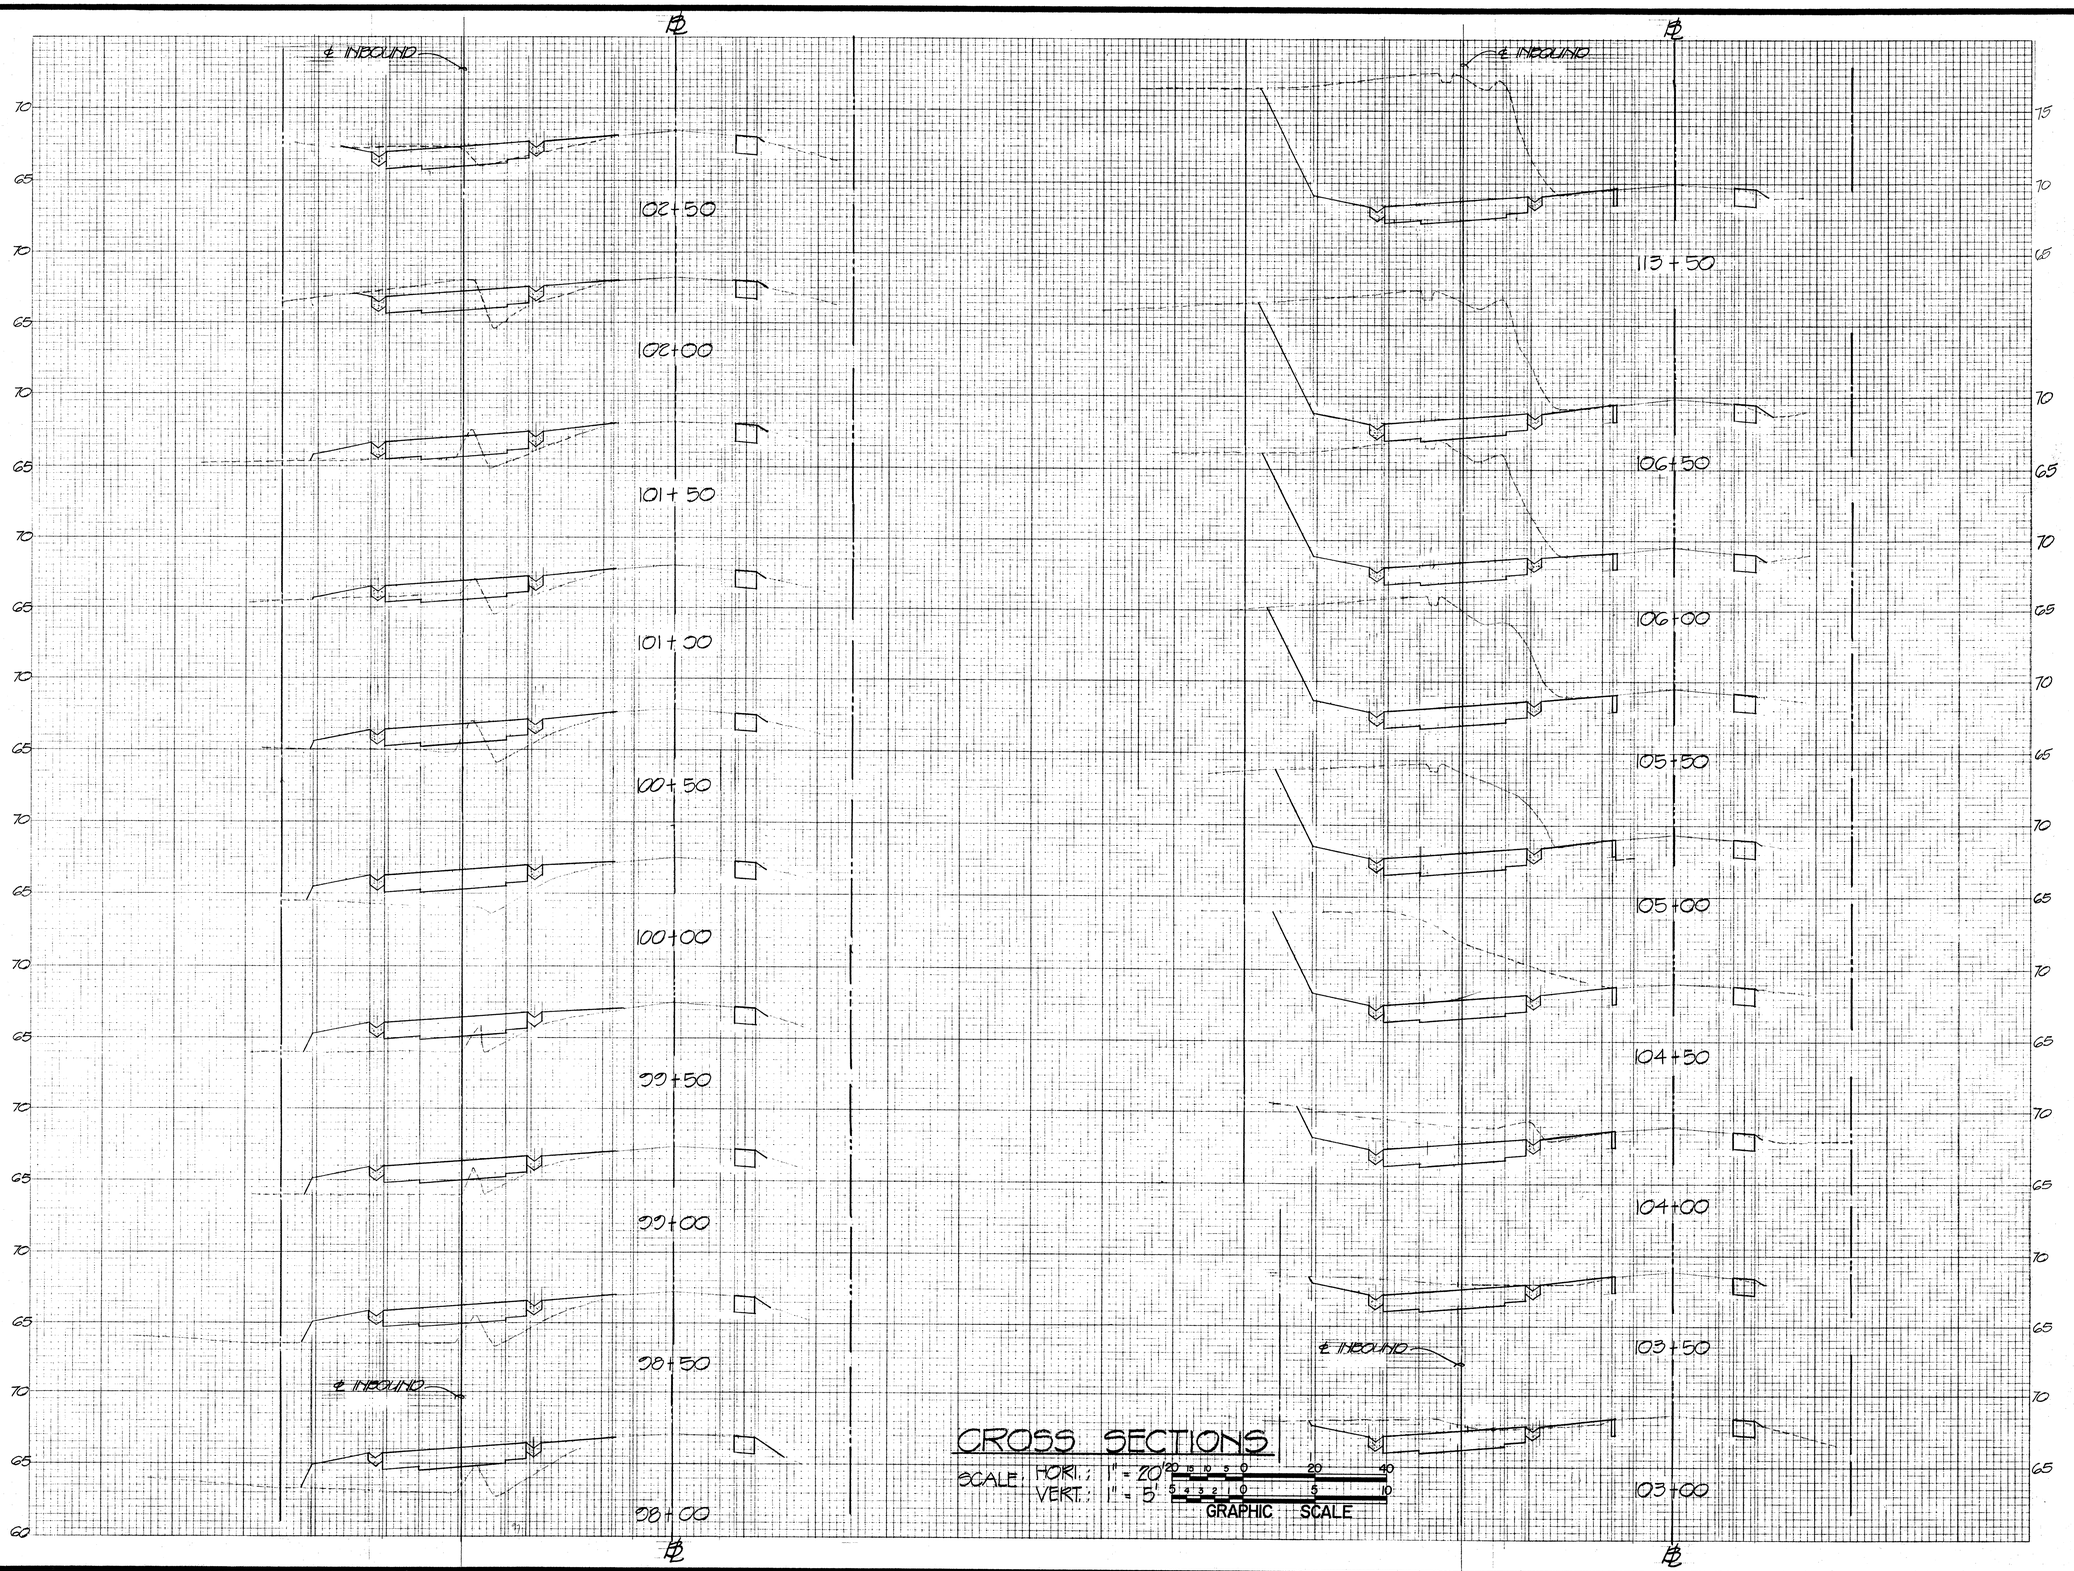

CROSS SECTIONS

SCALE: HORI.; 1" = 20'
VERT.; 1" = 5'

GRAPHIC SCALE

Airports Division

THIS WORK WAS PREPARED BY ME OR UNDER MY SUPERVISION.

10/2/89

ROBERT T. TANAKA REGISTERED PROFESSIONAL ENGINEER No. 1754-C HAWAII, U.S.A.

R. T. TANAKA ENGINEERS, INC.
871 KOLU STREET, SUITE 201
WAILUKU, MAUI, HAWAII 96793

DSGN	DRWN.	CHKD	APPD
R.H.	C.T.	R.T.T.	

KEY PLAN / NOTES :

NO. DATE REVISIONS

AS-BUILT (Record Drawing)

DATE 7/12/91

This Drawing has been prepared, in part, based on information furnished by others. While this information is believed to be reliable, the Design Professional assumes no responsibility for the accuracy of this As-Built drawing or for any errors or omissions which may have been incorporated into it as a result.

PROJECT TITLE :

HANA HIGHWAY IMPROVEMENTS

PROJECT NO. :


STATE NO. AM-1061-12
AIP NO. 3-15-0006-11

SHEET TITLE :

CROSS - SECTIONS

DATE 10-3-89

DWG NO. C-54

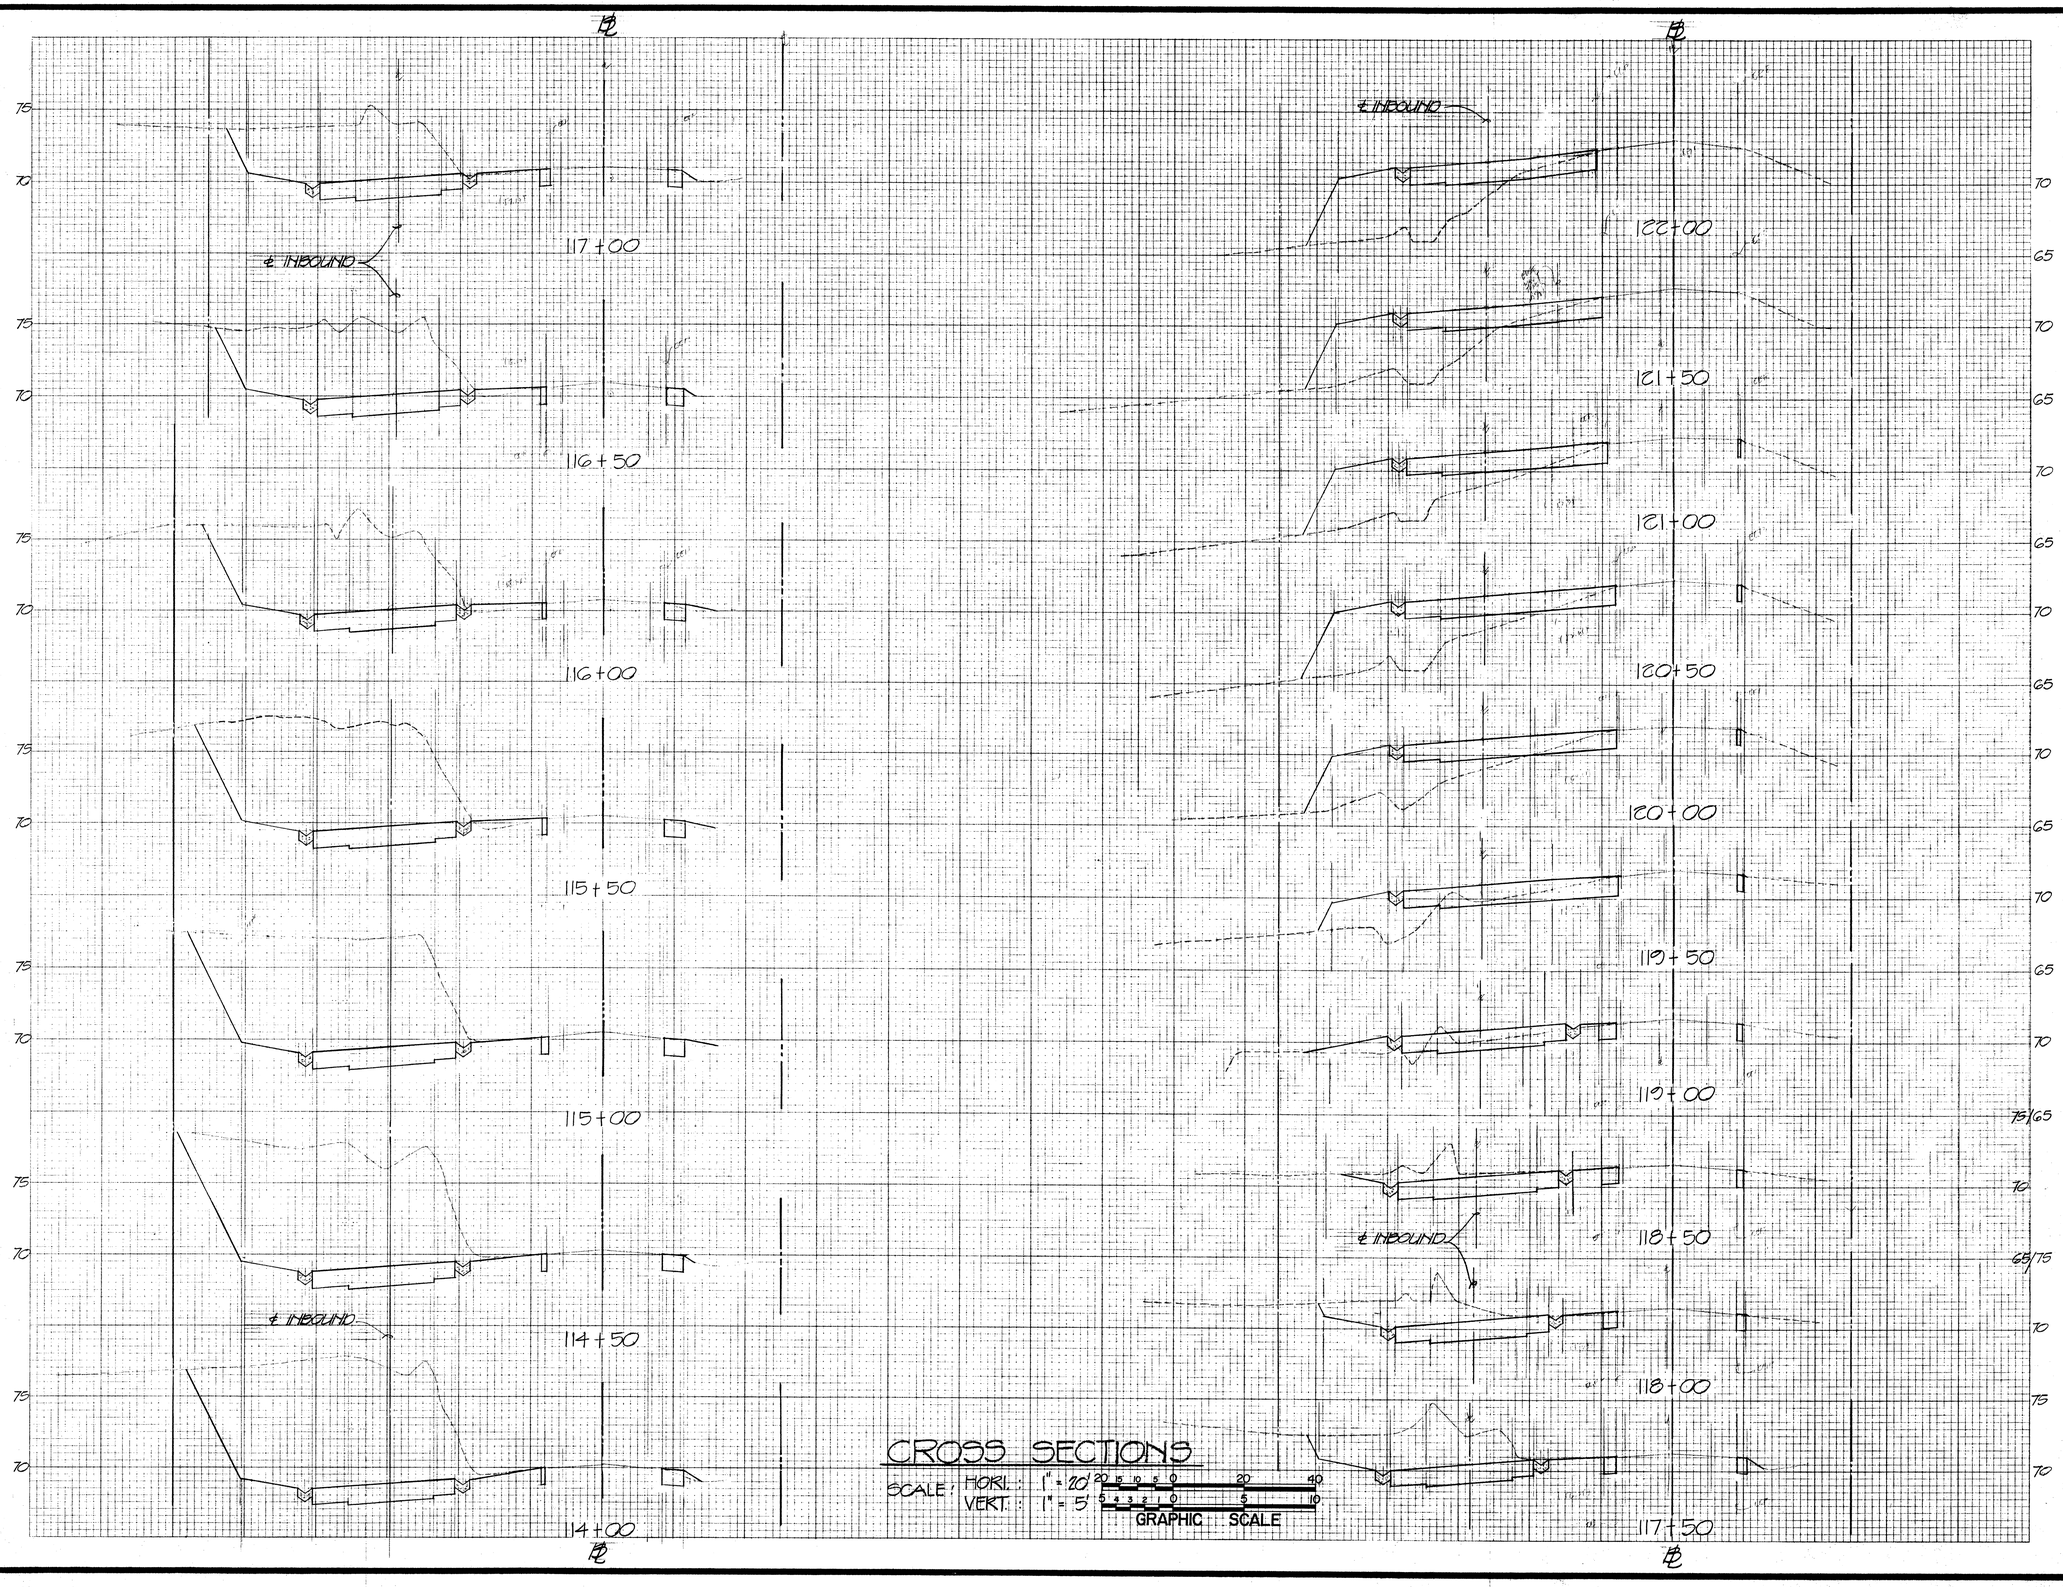

CROSS SECTIONS

SCALE: HORI.: 1" = 20'
VERT.: 1" = 5'

GRAPHIC SCALE

ROBERT T. TANAKA
PROFESSIONAL ENGINEER
No. 1754-C
HAWAII, U.S.A.

10/7/91

R. T. TANAKA ENGINEERS, INC.
871 KOLU STREET, SUITE 201
WAILUKU, MAUI, HAWAII 96793

DSGN.	DRWN.	CHKD.	APPD.
R.H.	C.T.	R.T.T.	

KEY PLAN / NOTES :

NO.	DATE	REVISIONS

AS-BUILT (Record Drawing)

DATE 7/12/91

This Drawing has been prepared, in part, based upon information furnished by others. While this information is believed to be reliable, the Design Professional cannot assure the accuracy of this As-Built drawing or for any errors or omissions which may have been incorporated into it as a result.

PROJECT TITLE :

HANA HIGHWAY IMPROVEMENTS

PROJECT NO. :


STATE NO. AM-1061-12
AIP NO. 3-15-0006-11

SHEET TITLE :

CROSS - SECTIONS

DATE 11-15-89

DWG NO. C-55

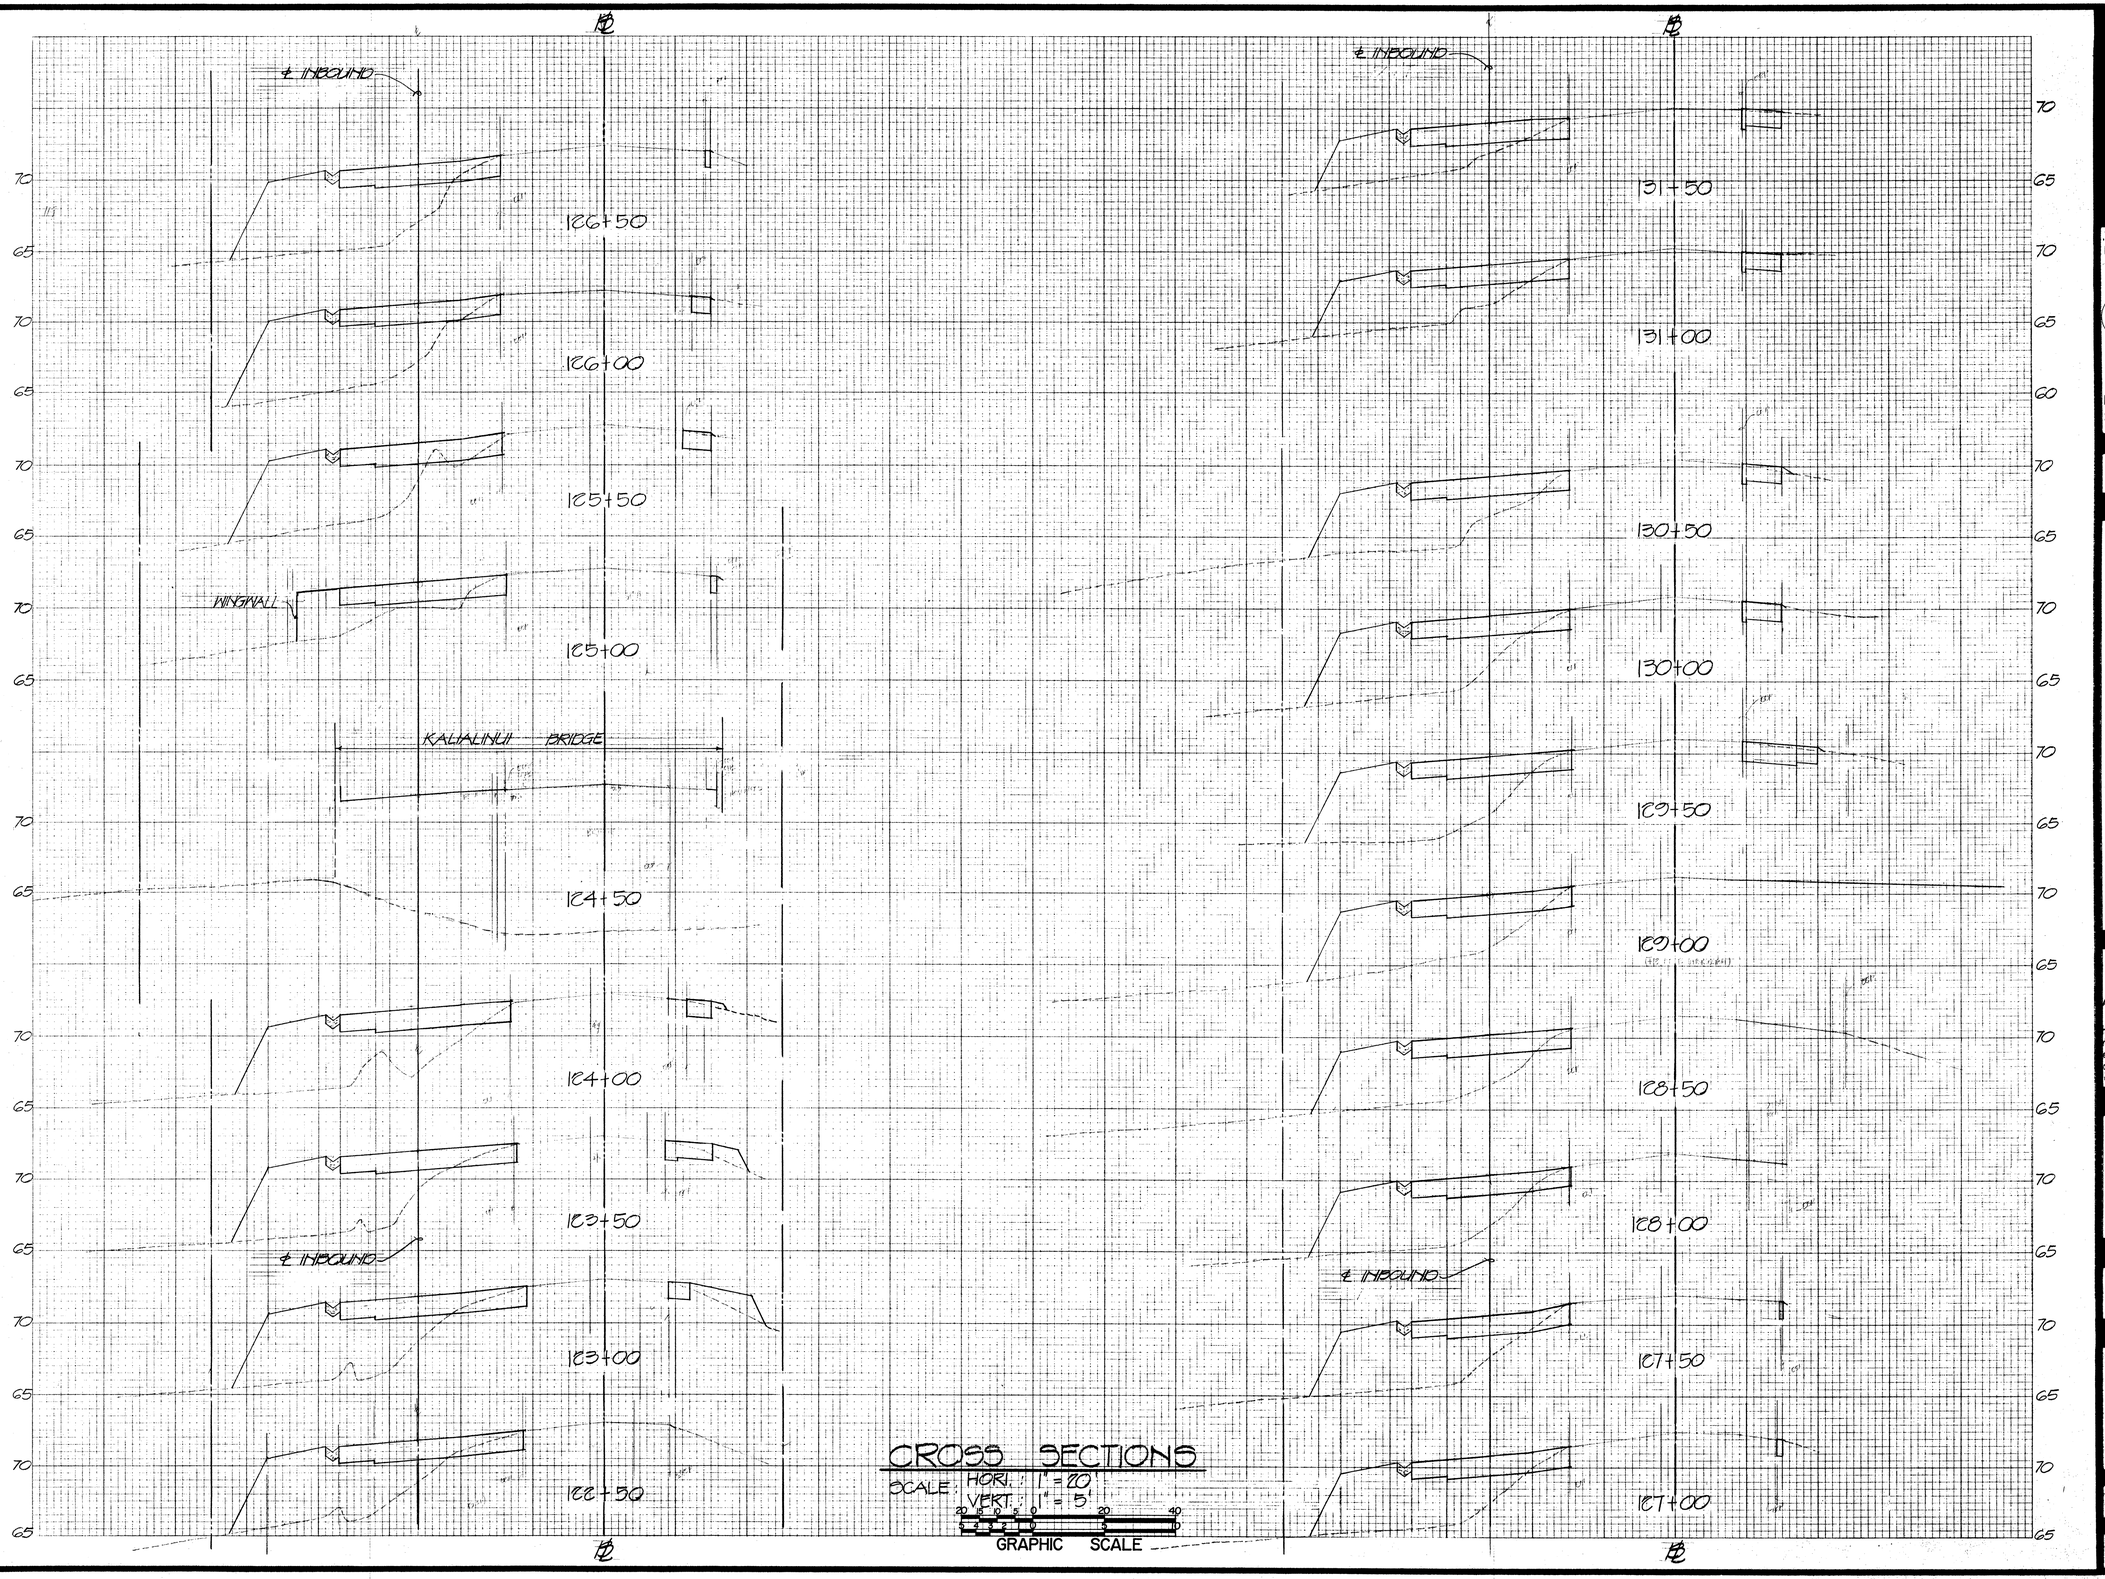

Airports Division

THIS WORK WAS PREPARED BY ME OR UNDER MY SUPERVISION.

8/2/91

ROBERT T. TANAKA REGISTERED PROFESSIONAL ENGINEER No. 1754-C HAWAII, U.S.A.

R. T. TANAKA ENGINEERS, INC.
871 KOLU STREET, SUITE 201
WAILUKU, MAUI, HAWAII 96793

DSGN.	DRWN.	CHK'D.	APP'D.
R.H.	C.T.	R.T.T.	

KEY PLAN / NOTES :

NO.	DATE	REVISIONS

AS-BUILT (Record Drawing)

DATE 7/12/91

This Drawing has been prepared, in part, based upon information furnished by others. While this information is believed to be reliable, the Design Professional cannot assure the accuracy of this As-Built drawing or for any errors or omissions which may have been incorporated into it as a result.

PROJECT TITLE :

HANA HIGHWAY IMPROVEMENTS

PROJECT NO. :


STATE NO. AM-1061-12
AIP NO. 3-15-0006-11

SHEET TITLE :

CROSS - SECTIONS

DATE 11-15-89

DWG. NO. C-56

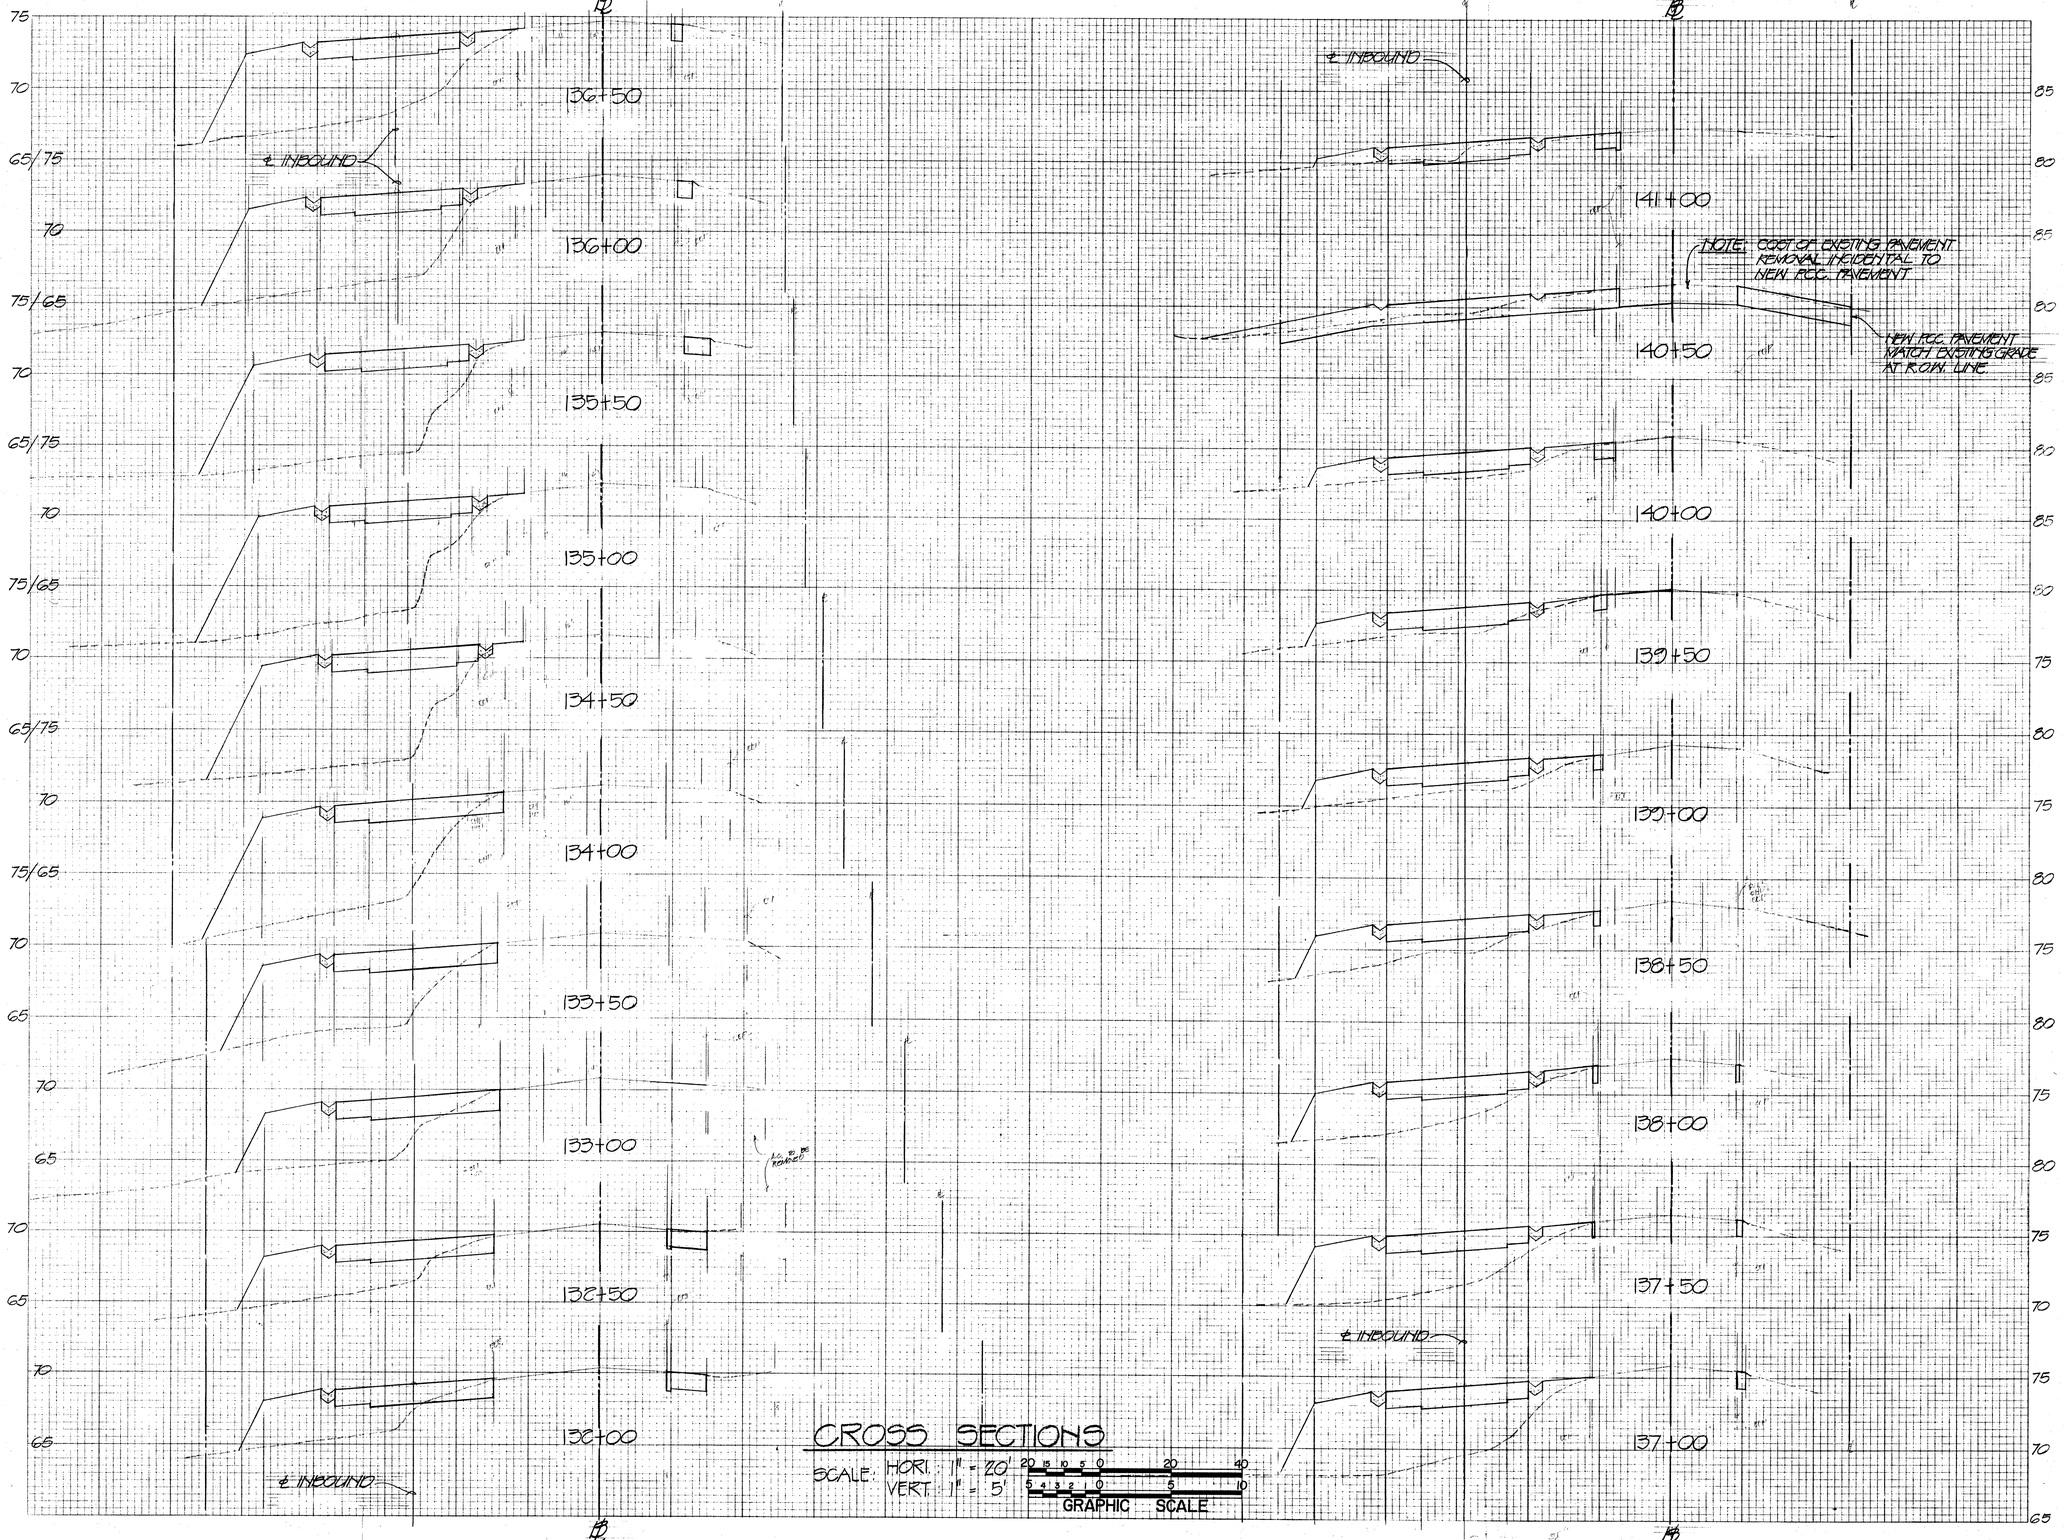

CROSS SECTIONS

SCALE: HORI. 1" = 20'
VERT. 1" = 5'

GRAPHIC SCALE

Airport's Division

THIS WORK WAS PREPARED BY ME OR UNDER MY SUPERVISION.

10/3/89

ROBERT T. TANAKA — REGISTERED PROFESSIONAL ENGINEER — No. 1754-C — HAWAII, U.S.A.

R. T. TANAKA ENGINEERS, INC.
871 KOLU STREET, SUITE 201
WAILUKU, MAUI, HAWAII 96793

DSGN.	DRWN.	CHKD.	APPD.
R.H.	C.T.	R.T.T.	

KEY PLAN / NOTES :

NO. DATE REVISIONS

AS-BUILT (Record Drawing)

DATE 7/12/91

This Drawing has been prepared, in part, based upon information furnished by others. While this information is believed to be reliable, the Design Professional cannot assure the accuracy of this As-Built drawing or for any errors or omissions which may have been incorporated into it as a result.

PROJECT TITLE :

HANA HIGHWAY IMPROVEMENTS

PROJECT NO. :


STATE NO. AM-1061-12
AIP NO. 3-15-0006-11

SHEET TITLE :

CROSS - SECTIONS

DATE 10-3-89

DWG. NO. C-57

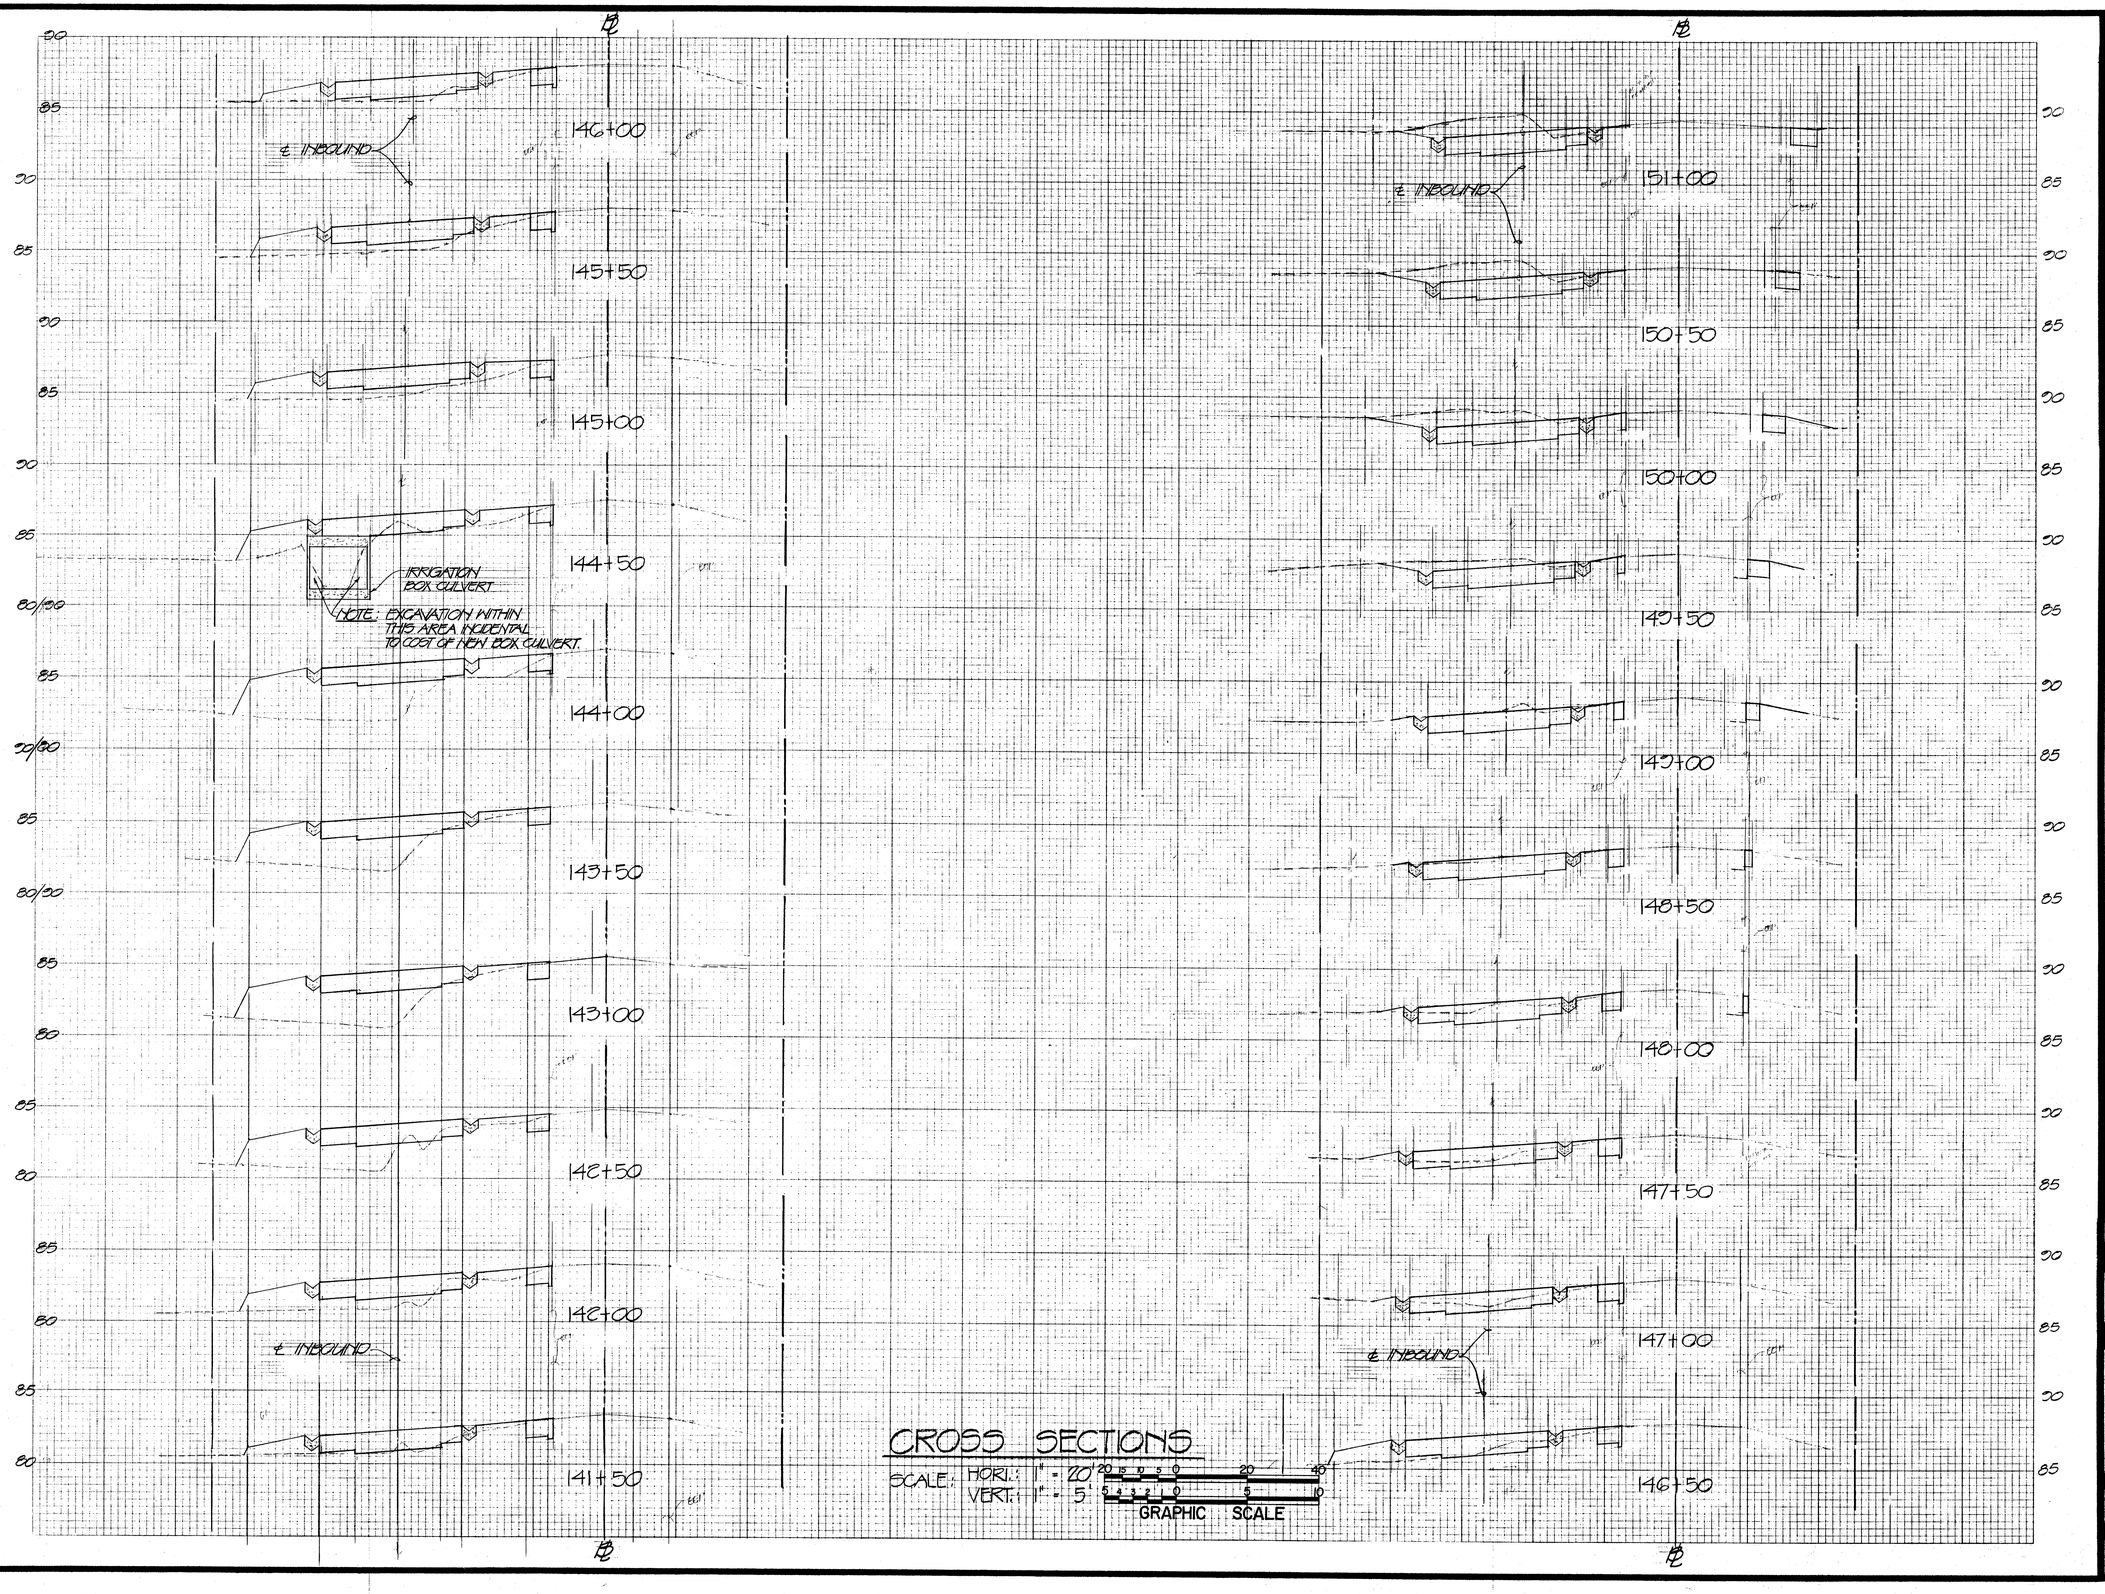

THIS WORK WAS PREPARED BY ME OR UNDER MY SUPERVISION.

12/3/91

ROBERT T. TANAKA REGISTERED PROFESSIONAL ENGINEER No. 1754-C HAWAII, U.S.A.

R. T. TANAKA ENGINEERS, INC.
871 KOLU STREET, SUITE 201
WAILUKU, MAUI, HAWAII 96793

DSGN.	DRWN.	CHKD	APPD
R.H.	C.T.	R.T.T.	

KEY PLAN / NOTES :

NO. DATE REVISIONS

AS-BUILT (Record Drawing)

DATE 7/12/91

This Drawing has been prepared, in part, based upon information furnished by others. While this information is believed to be reliable, the Design Professional cannot assure the accuracy of this As-Built drawing or for any errors or omissions which may have been incorporated into it as a result.

PROJECT TITLE :

HANA HIGHWAY IMPROVEMENTS

PROJECT NO. :


STATE NO. AM-1061-1 2
AIP NO. 3-15-0006-11

SHEET TITLE :

CROSS - SECTIONS

DATE 11-15-89

DWG NO C-58

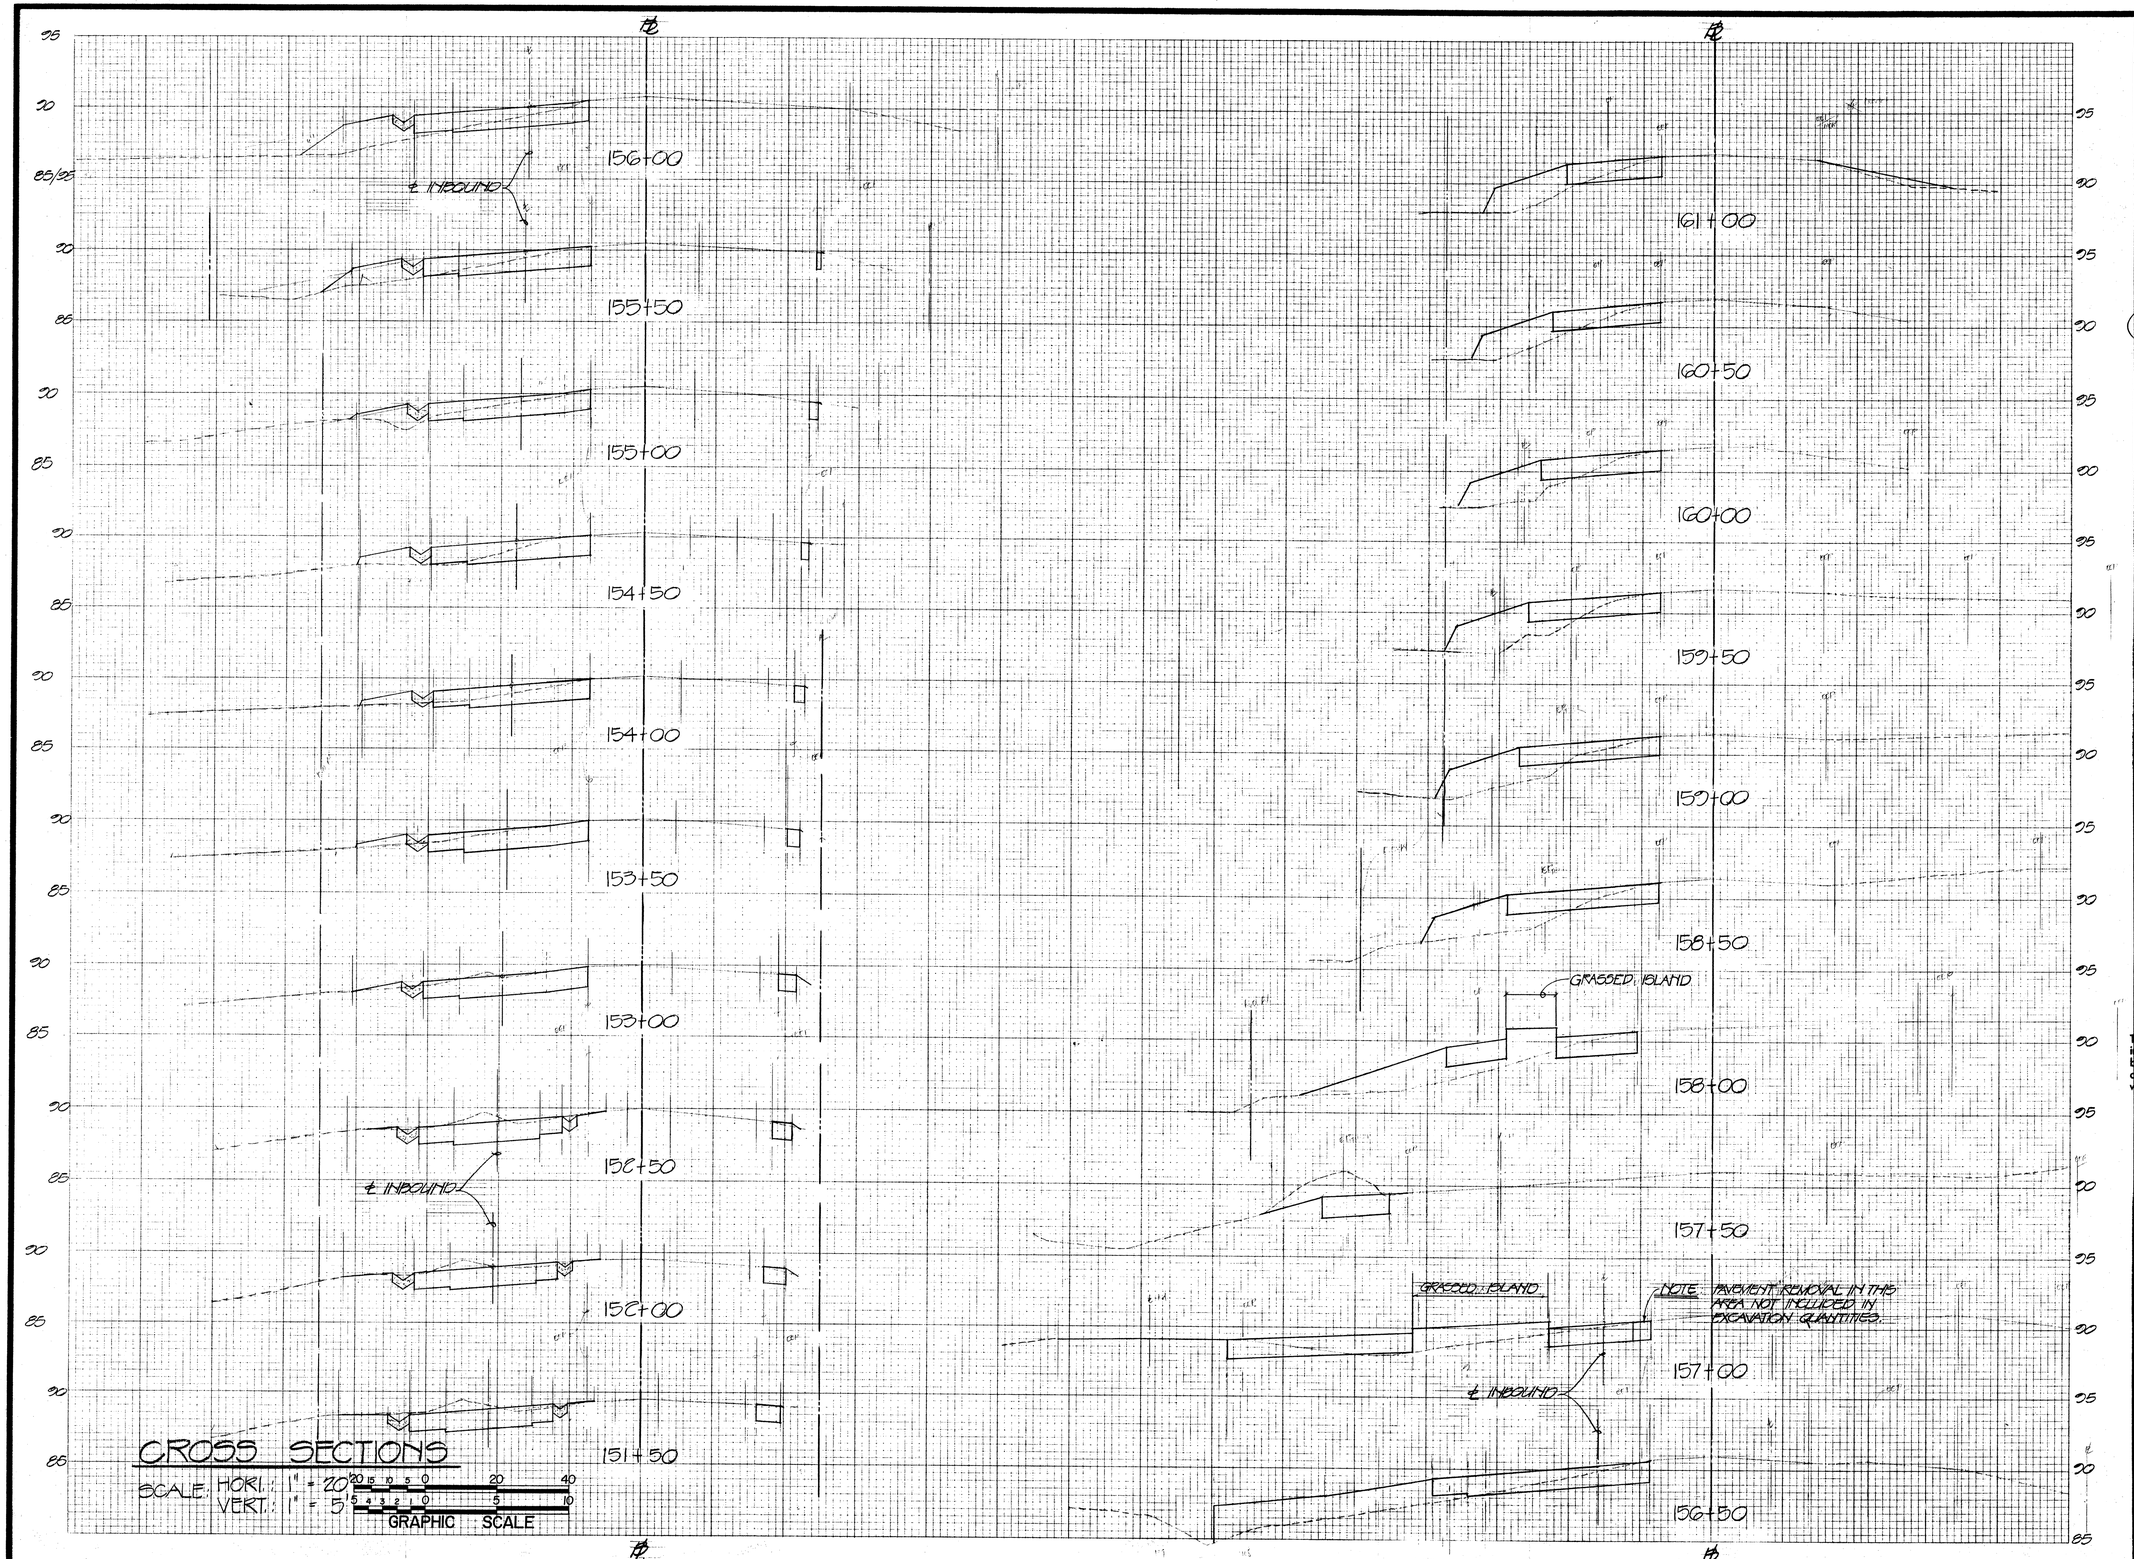

CROSS SECTIONS

SCALE: HORI.: 1" = 20'
VERT.: 1" = 5'

GRAPHIC SCALE

.THIS WORK WAS PREPARED BY ME OR UNDER MY SUPERVISION.

10/3/89

ROBERT T. TANAKA REGISTERED PROFESSIONAL ENGINEER No. 1754-C HAWAII, U.S.A.

R. T. TANAKA ENGINEERS, INC.
871 KOLU STREET, SUITE 201
WAILUKU, MAUI, HAWAII 96793

DSGN	DRWN.	CHKD	APPD
R.H.	C.T.	R.T.T.	

KEY PLAN / NOTES :

NO. DATE REVISIONS

AS-BUILT (Record Drawing)

DATE 7/12/91

This Drawing has been prepared, in part, based upo information furnished by others. While this information believed to be reliable, the Design Professional cannot assure t accuracy of this As-Built drawing or for any errors or omissio which may have been incorporated into it as a result.

PROJECT TITLE :

HANA HIGHWAY IMPROVEMENTS

PROJECT NO. :


STATE NO. AM-1061-12
AIP NO. 3-15-0006-11

SHEET TITLE :

CROSS - SECTIONS

DATE 11-15-89

DWG. NO. C-59

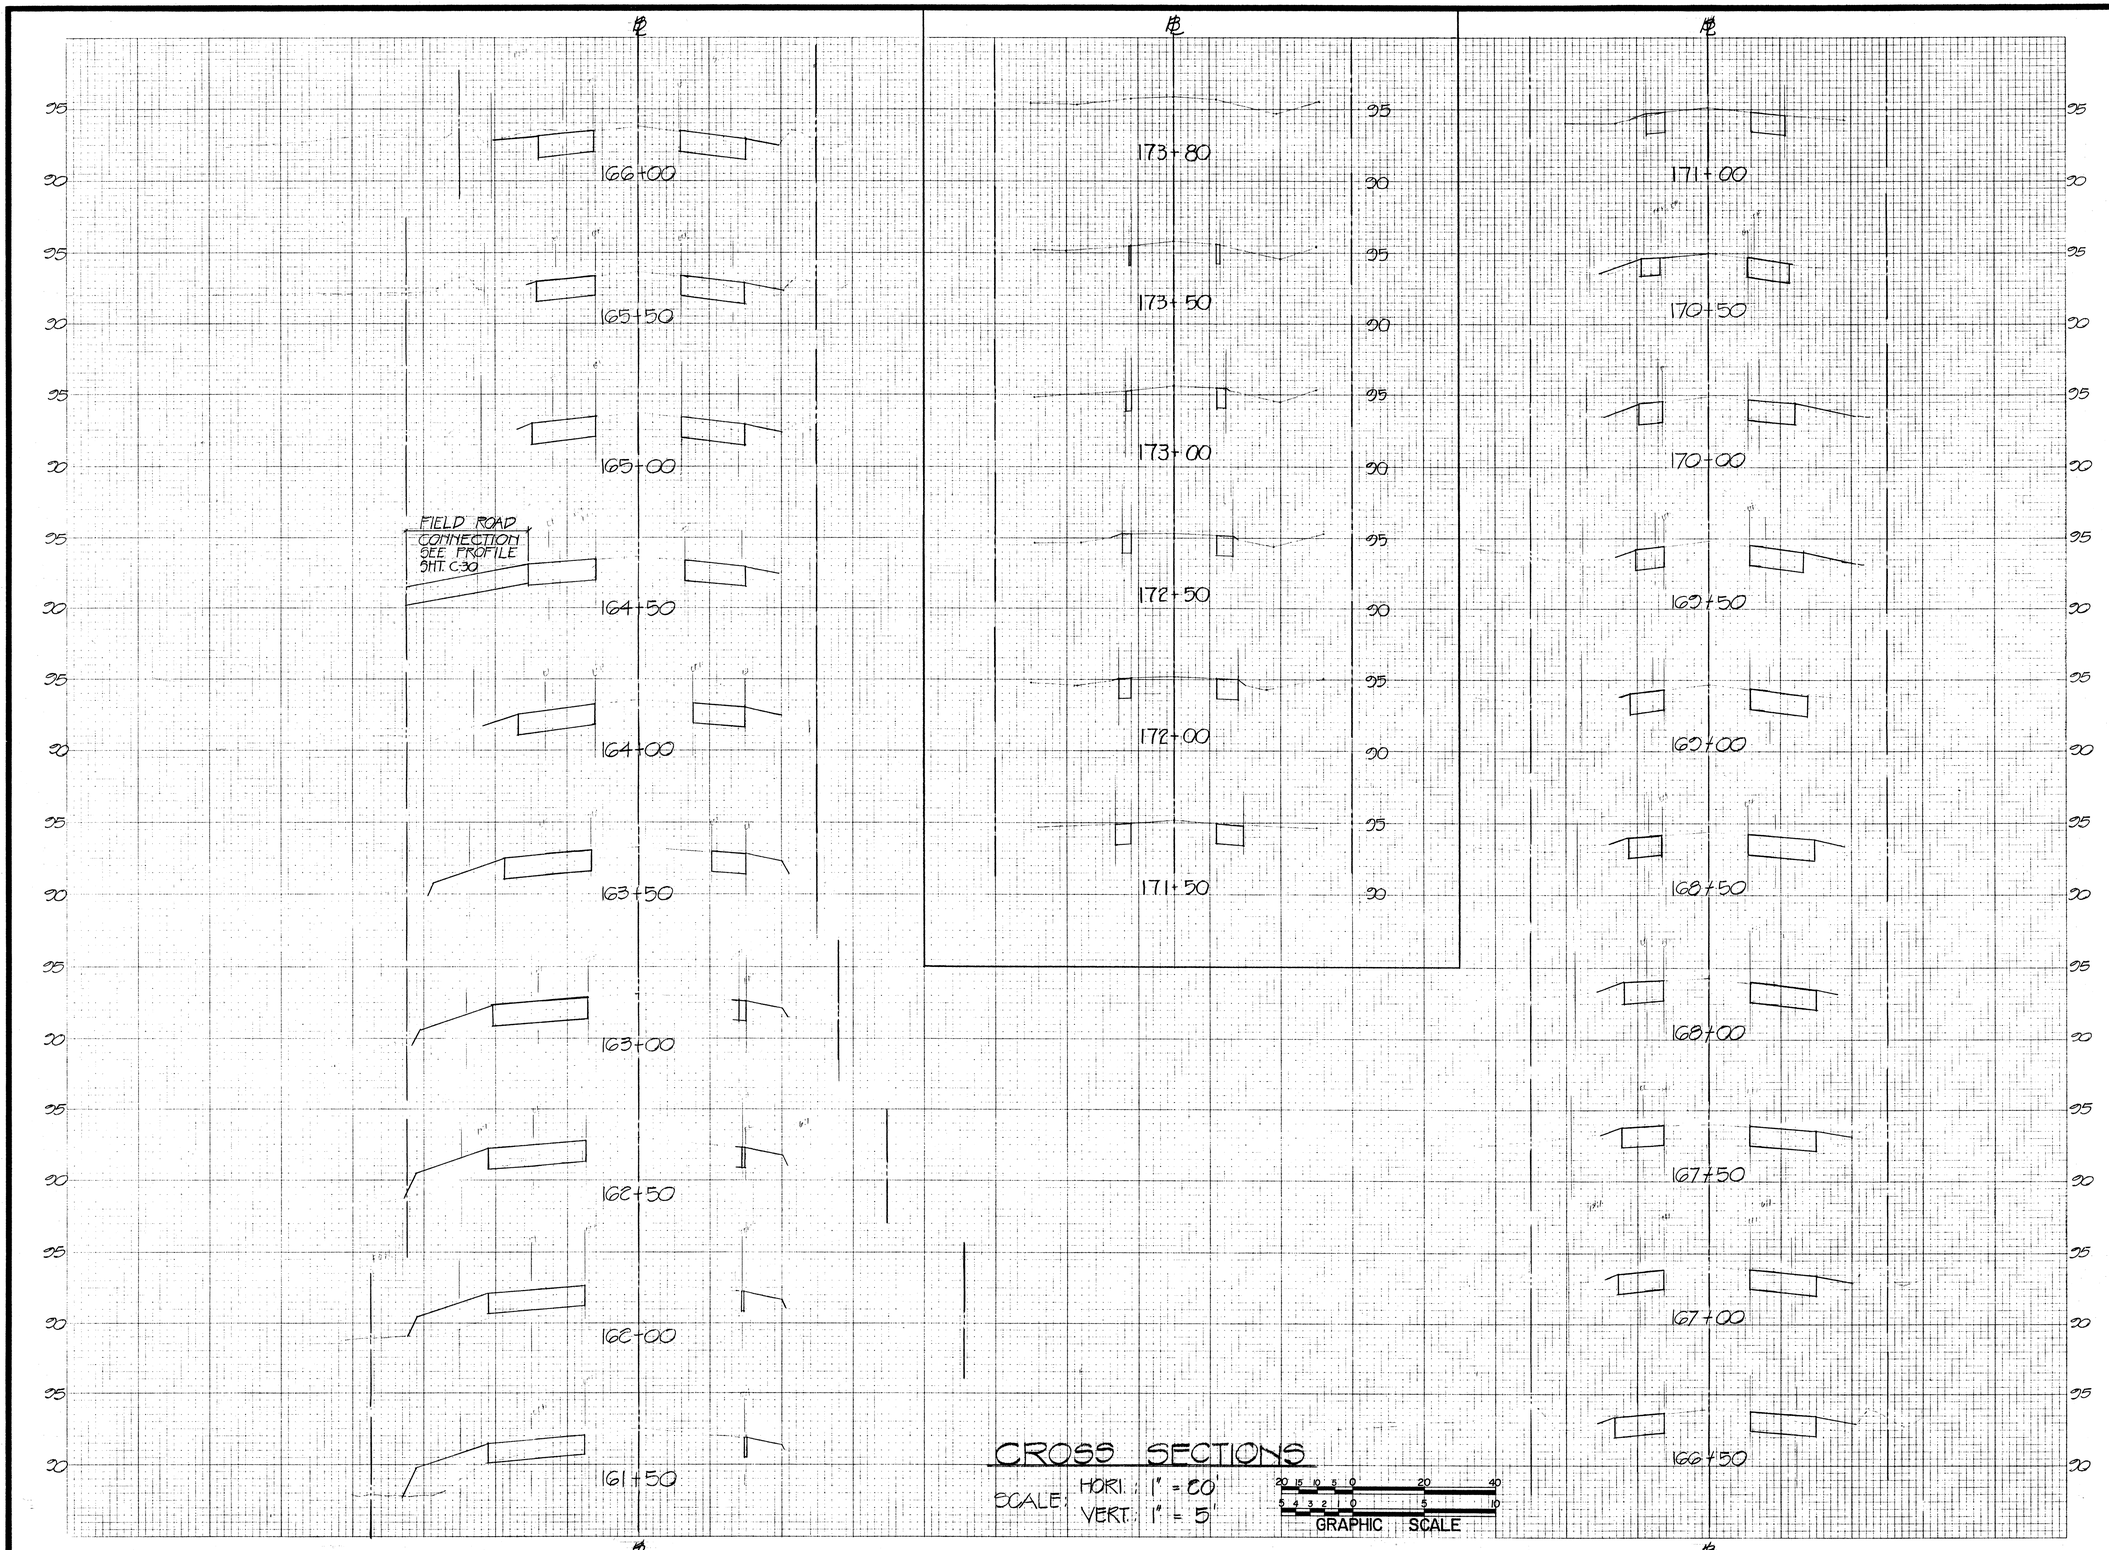

CROSS SECTIONS

SCALE: HORI.: 1" = 60'
VERT.: 1" = 5'

GRAPHIC SCALE

Airports Division

THIS WORK WAS PREPARED BY ME OR UNDER MY SUPERVISION.

10/3/89

ROBERT T. TANAKA REGISTERED PROFESSIONAL ENGINEER No. 1754-C HAWAII, U.S.A.

R. T. TANAKA ENGINEERS, INC.
871 KOLU STREET, SUITE 201
WAILUKU, MAUI, HAWAII 96793

DSGN.	DRWN	CHKD.	APPD
R.H.	C. T.	R.T.T.	

KEY PLAN / NOTES :

NO. DATE REVISIONS

AS-BUILT (Record Drawing)

DATE 7/12/91

This Drawing has been prepared, in part, based upon information furnished by others. While this information is believed to be reliable, the Design Professional cannot assure the accuracy of this As-Built drawing or for any errors or omissions which may have been incorporated into it as a result.

PROJECT TITLE :

HANA HIGHWAY IMPROVEMENTS

PROJECT NO. :

STATE NO. AM-1061-12
AIP NO. 3-15-0006-11

SHEET TITLE :

CROSS - SECTIONS

DATE 10-3-89

DWG NO C-60