FED. ROAD DIST. NO.	STATE	FED. AID PROJ. NO.	FISCAL YEAR	SHEET NO.	TOTAL SHEETS
HAWAII	HAW.	STP-036-1(8)	1997	1	30

INDEX TO DRAWINGS

SHEET NO.	DESCRIPTION
1	TITLE SHEET
2	STANDARD PLANS SUMMARY
3	GENERAL NOTES AND LEGEND
4 – 5	TYPICAL SECTIONS
6 – 16	ROADWAY PLANS
17	PAVEMENT MARKINGS LEGEND, DETAILS AND NOTES
18 – 28	SIGNING AND PAVEMENT MARKING PLANS
29 – 30	MISCELLANEOUS SUMMARIES

STATE OF HAWAII

DEPARTMENT OF TRANSPORTATION

HIGHWAYS DIVISION

HONOLULU, HAWAII

"AS-BUILT"

PLANS FOR

HANA HIGHWAY RESURFACING

HOOKIPA PARK TO VALLEY ISLE MEMORIAL CEMETERY

FEDERAL-AID PROJECT NO. STP-036-1(8)

DISTRICT OF MAKAWAO

ISLAND OF MAUI

LOCATION OF PROJECT

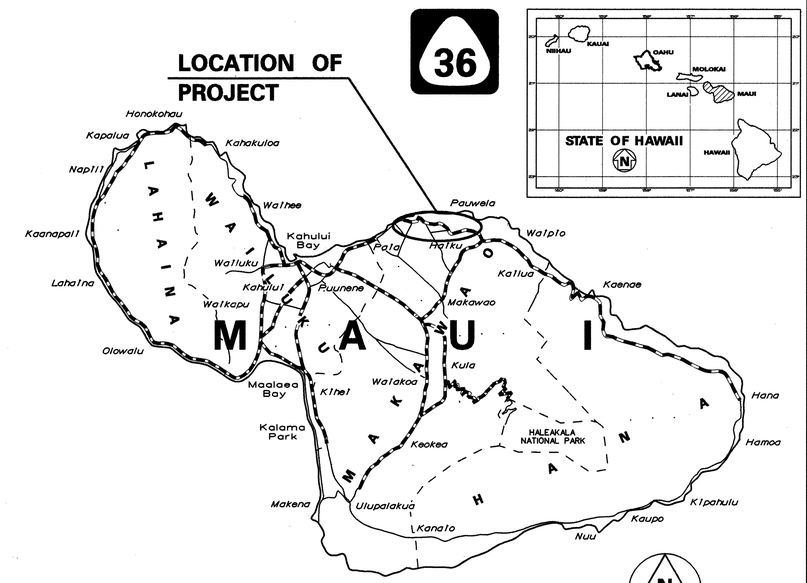

FEDERAL AID PROJECTS PREVIOUSLY CONSTRUCTED OR UNDER CONSTRUCTION

MILE POST 8.89± TO MILE POST 12.95±

PROJECT LIMITS

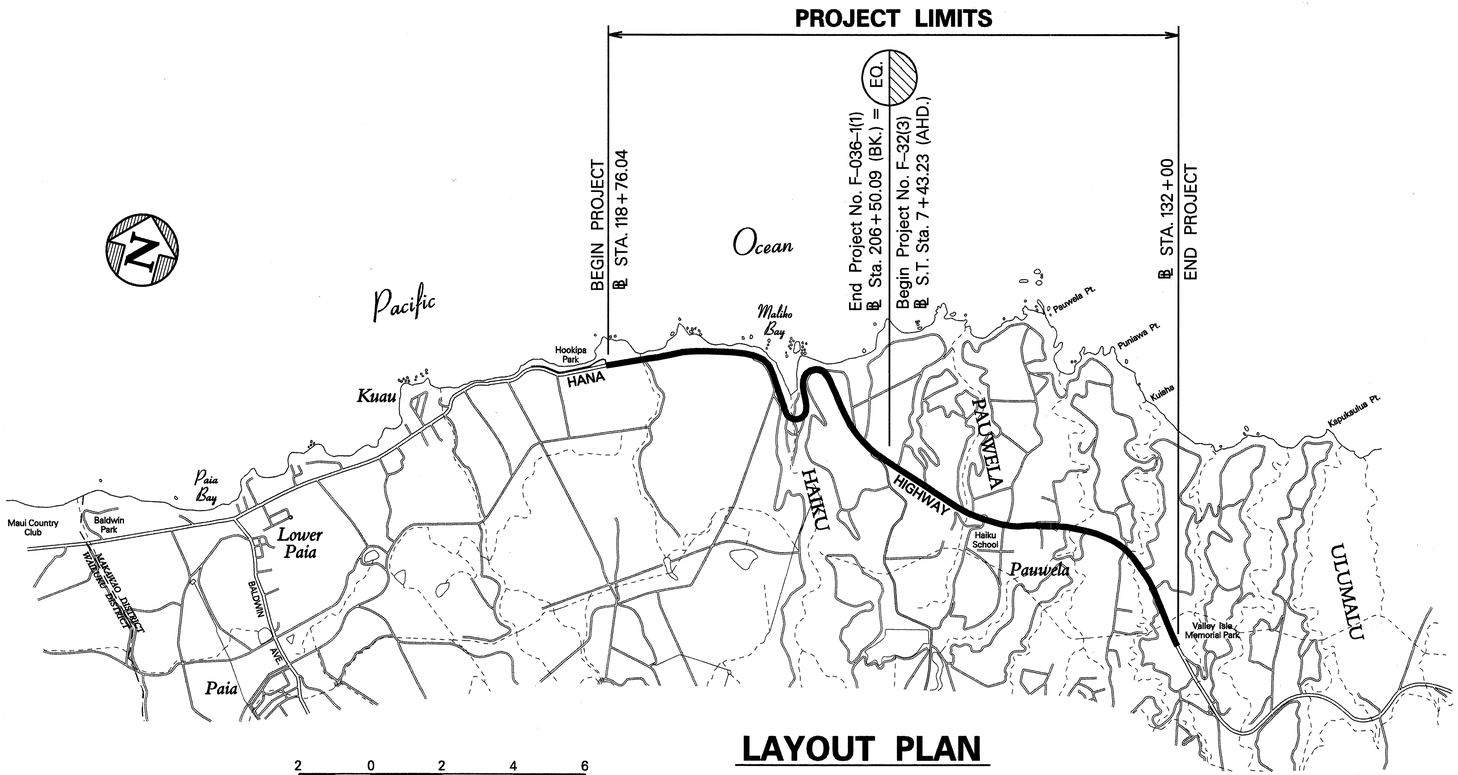

LAYOUT PLAN

GROSS LENGTH OF PROJECT..... 4.00 MILES

NET LENGTH OF PROJECT..... 4.00 MILES

DESIGN DESIGNATION

ADT (1995)	8,400
ADT (2005)	10,400
DHV	1,000
D (Design)	65/35
T (Design)	4.0 %
T_{24}	4.3 %
V	50 M.P.H.

CHANGES MADE DURING CONSTRUCTION HAVE BEEN INCORPORATED ON THESE PLANS EXCEPT CHANGES IN THE ORIGINAL THEORETICAL QUANTITIES. FOR ACTUAL QUANTITIES, REFER TO PROJECT LEDGER AND/OR COMPUTATION BOOK.

RESIDENT ENGINEER — DATE 3/25/99

DEPARTMENT OF TRANSPORTATION STATE OF HAWAII

APPROVED: DIR. OF TRANSPORTATION — DATE 11/13/96

HWY-M	J. FUJIMOTO	587-2249	SEPT. 1996
DESIGNED BY	P. S. & E. BY	PHONE	DATE

thanmtsht.dgn/jay