FED. ROAD DIST. NO.	STATE	FED. AID PROJ. NO.	FISCAL YEAR	SHEET NO.	TOTAL SHEETS
HAWAII	HAW.	STP-036-1(13)	1999	5	16

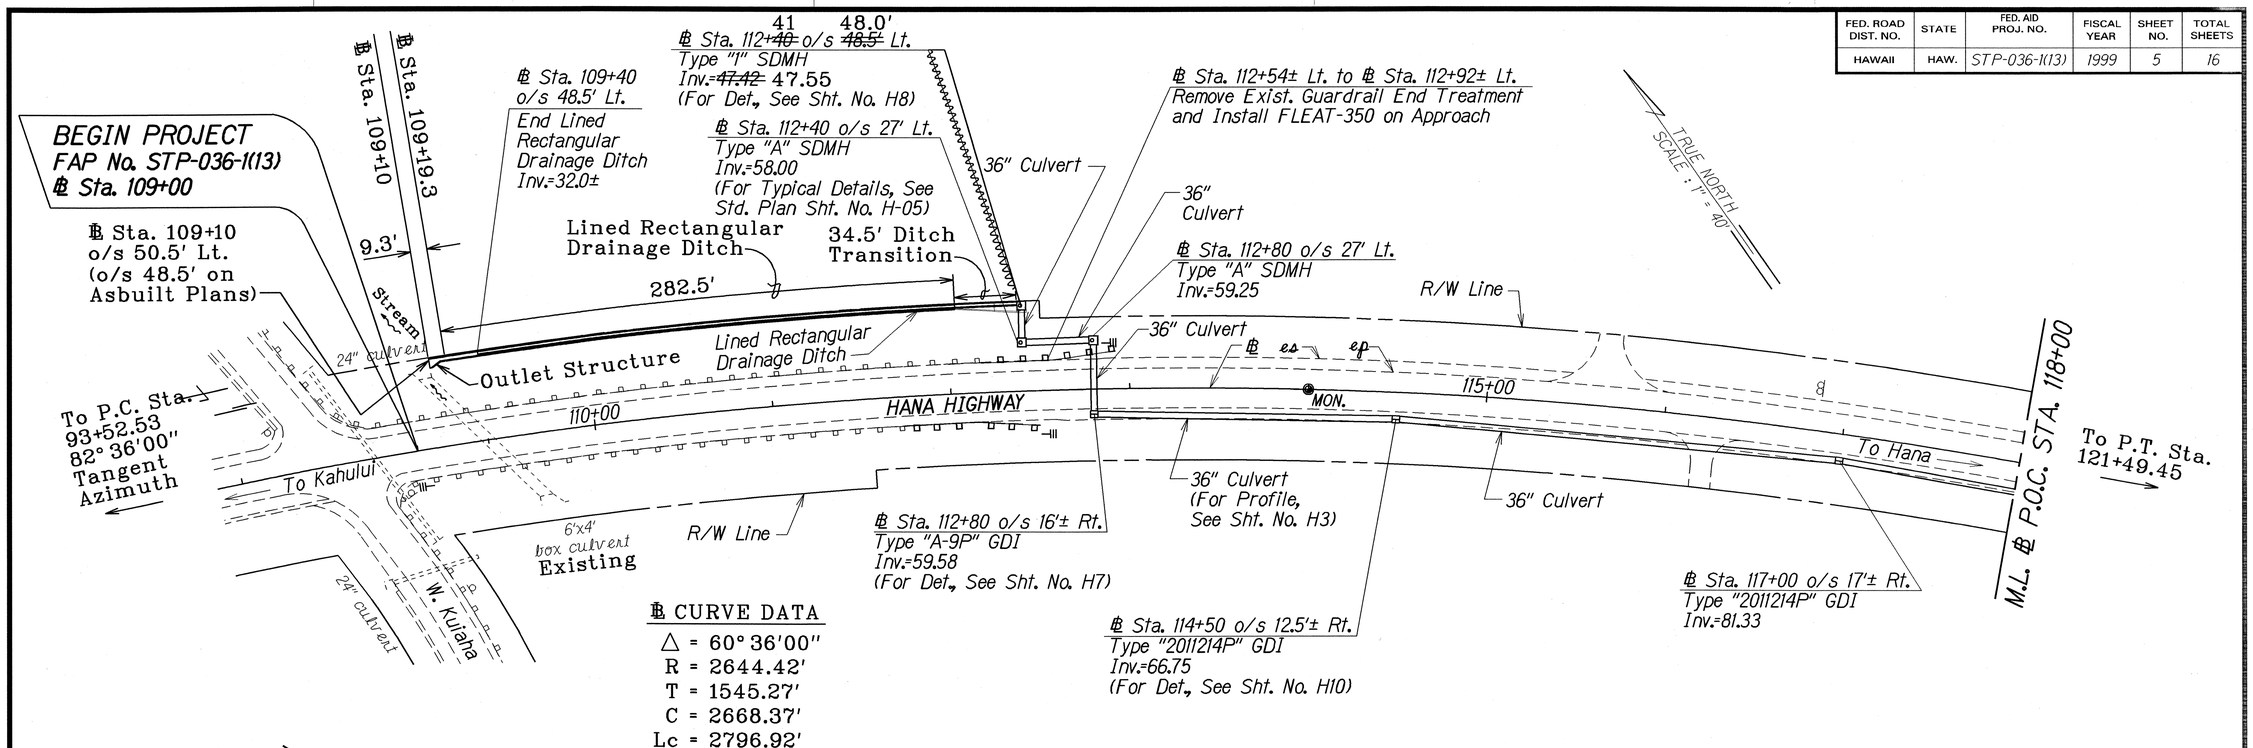

℄ CURVE DATA

△ = 60° 36'00"
R = 2644.42'
T = 1545.27'
C = 2668.37'
Lc = 2796.92'

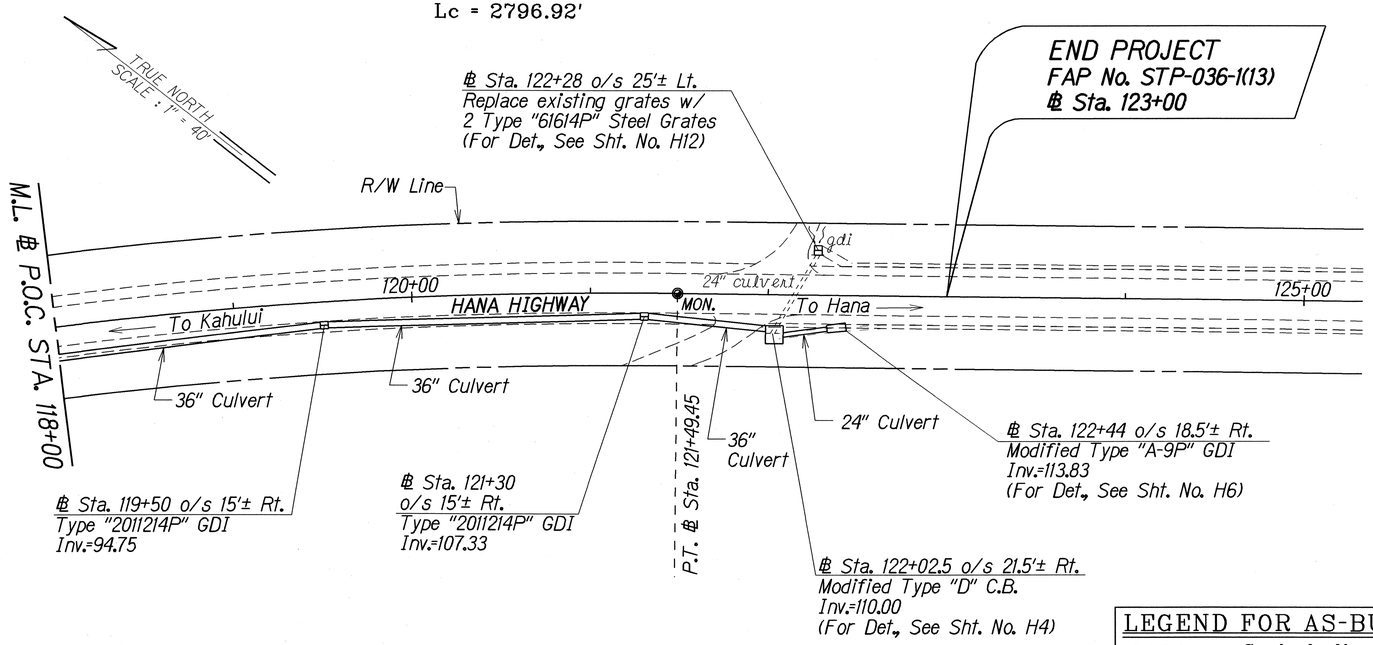

LEGEND FOR AS-BUILT POSTINGS	
~~	Squiggly line for as-built deletion
~~100.00~~	Double line for as-built deletion
Roadway	Text for as-built posting

DATE	REVISION
3/10/99	Revised end treatment to FLEAT-350

STATE OF HAWAII
DEPARTMENT OF TRANSPORTATION
HIGHWAYS DIVISION

DRAINAGE PLANS

HANA HIGHWAY
DRAINAGE IMPROVEMENTS
WEST KUIAHA ROAD TO VALLEY ISLE MEMORIAL PARK
Federal Aid Project No. STP-036-1(13)

Scale: 1" = 40' Date: AUGUST, 1998

SHEET No. H2 OF 12 SHEETS

ORIGINAL PLAN	SURVEY PLOTTED BY	DATE
	DRAWN BY K. Kasamoto & R. Sato	
	TRACED BY	
	DESIGNED BY K. Kasamoto	
NOTE BOOK 01/03-03/99	QUANTITIES BY	
09/03-09/99	CHECKED BY	
No.		

"AS-BUILT"

ADD. 5