FED. ROAD DIST. NO.	STATE	FED. AID PROJ. NO.	FISCAL YEAR	SHEET NO.	TOTAL SHEETS
HAWAII	HAW.	STP-036-1(13)	1999	1	16

INDEX TO DRAWINGS

SHEET NO.	DESCRIPTION
1	TITLE SHEET
2	STANDARD PLANS SUMMARY
3	GENERAL NOTES AND LEGEND
4	DRAINAGE SUMMARY
5	DRAINAGE PLANS
6	DRAINAGE PROFILE
7 – 15	DRAINAGE DETAILS
16	FLEAT-350 DETAILS

STATE OF HAWAII

DEPARTMENT OF TRANSPORTATION

HIGHWAYS DIVISION

HONOLULU, HAWAII

"AS-BUILT"

PLANS FOR

HANA HIGHWAY DRAINAGE IMPROVEMENTS

WEST KUIAHA ROAD TO VALLEY ISLE MEMORIAL PARK

FEDERAL-AID PROJECT NO. STP-036-1(13)

DISTRICT OF MAKAWAO

ISLAND OF MAUI

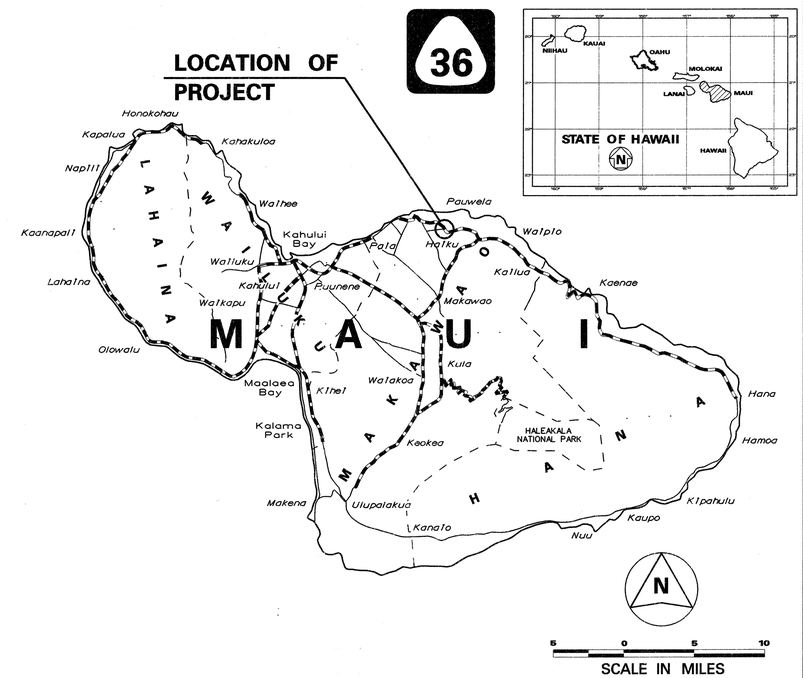

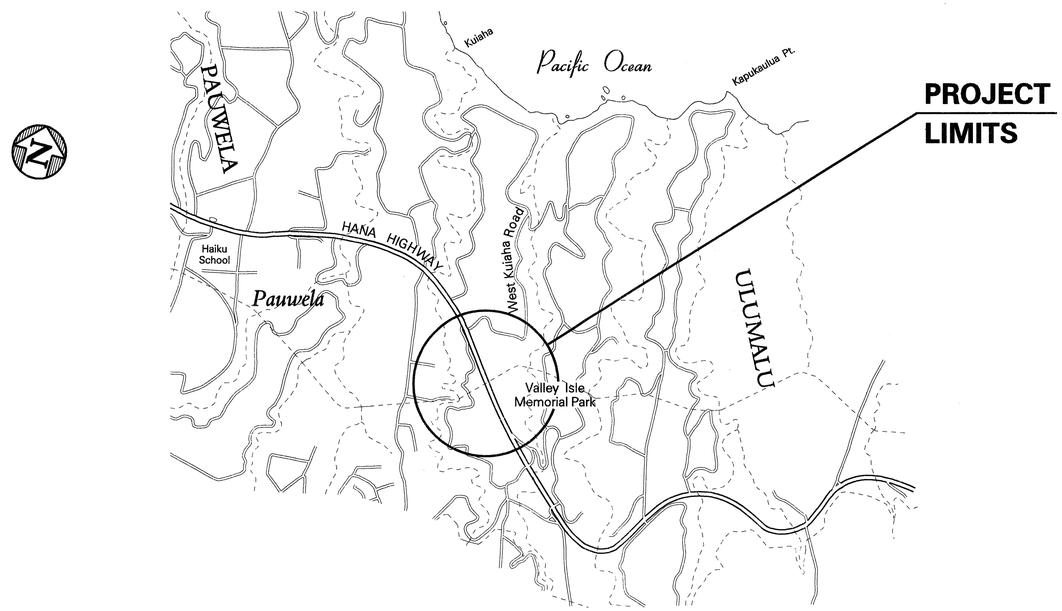

FEDERAL AID PROJECTS PREVIOUSLY CONSTRUCTED OR UNDER CONSTRUCTION

MILE POST 12.50 TO MILE POST 12.77

LAYOUT PLAN

GROSS LENGTH OF PROJECT. . . . . 0.27 MILES

NET LENGTH OF PROJECT. . . . . 0.27 MILES

CHANGES MADE DURING CONSTRUCTION HAVE BEEN INCORPORATED ON THESE PLANS EXCEPT CHANGES IN THE ORIGINAL THEORETICAL QUANTITIES. FOR ACTUAL QUANTITIES, REFER TO PROJECT LEDGER AND/OR COMPUTATION BOOK.

Pedro Fernandez — RESIDENT ENGINEER — June 9, 2003 — DATE

DEPARTMENT OF TRANSPORTATION
STATE OF HAWAII

APPROVED:

Kazu Hayashida — DIR. OF TRANSPORTATION — 1/21/99 — DATE

UNIT "C" — DESIGNED BY

R. HIRONAKA — P. S. & E. BY

587-2250 — PHONE

SEPT., 1998 — DATE

mhanmfsht.dgn